



40+50

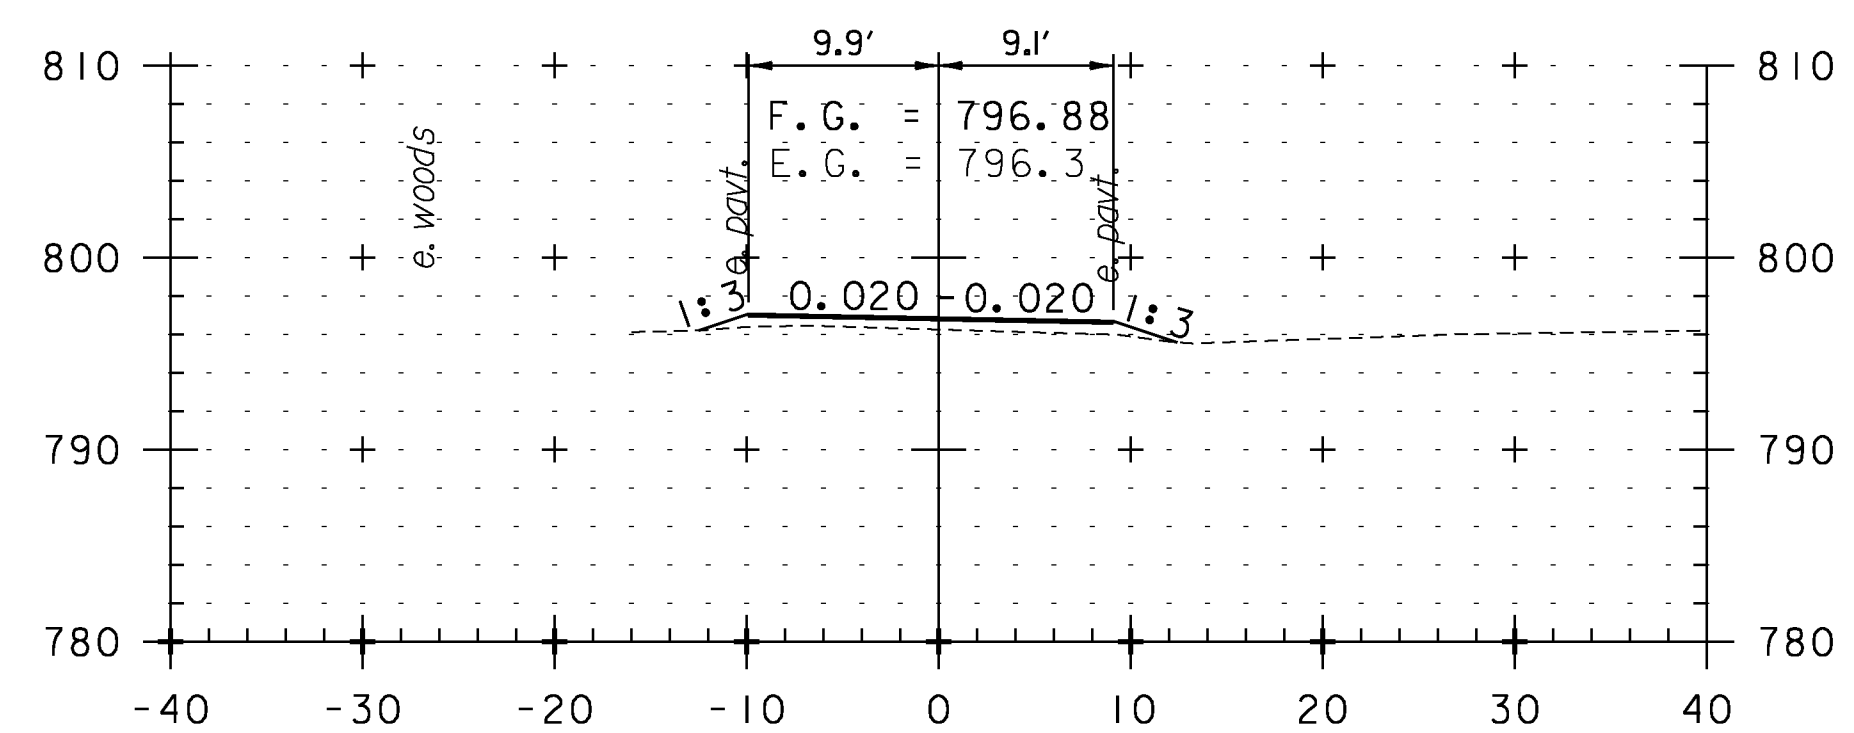

40+25

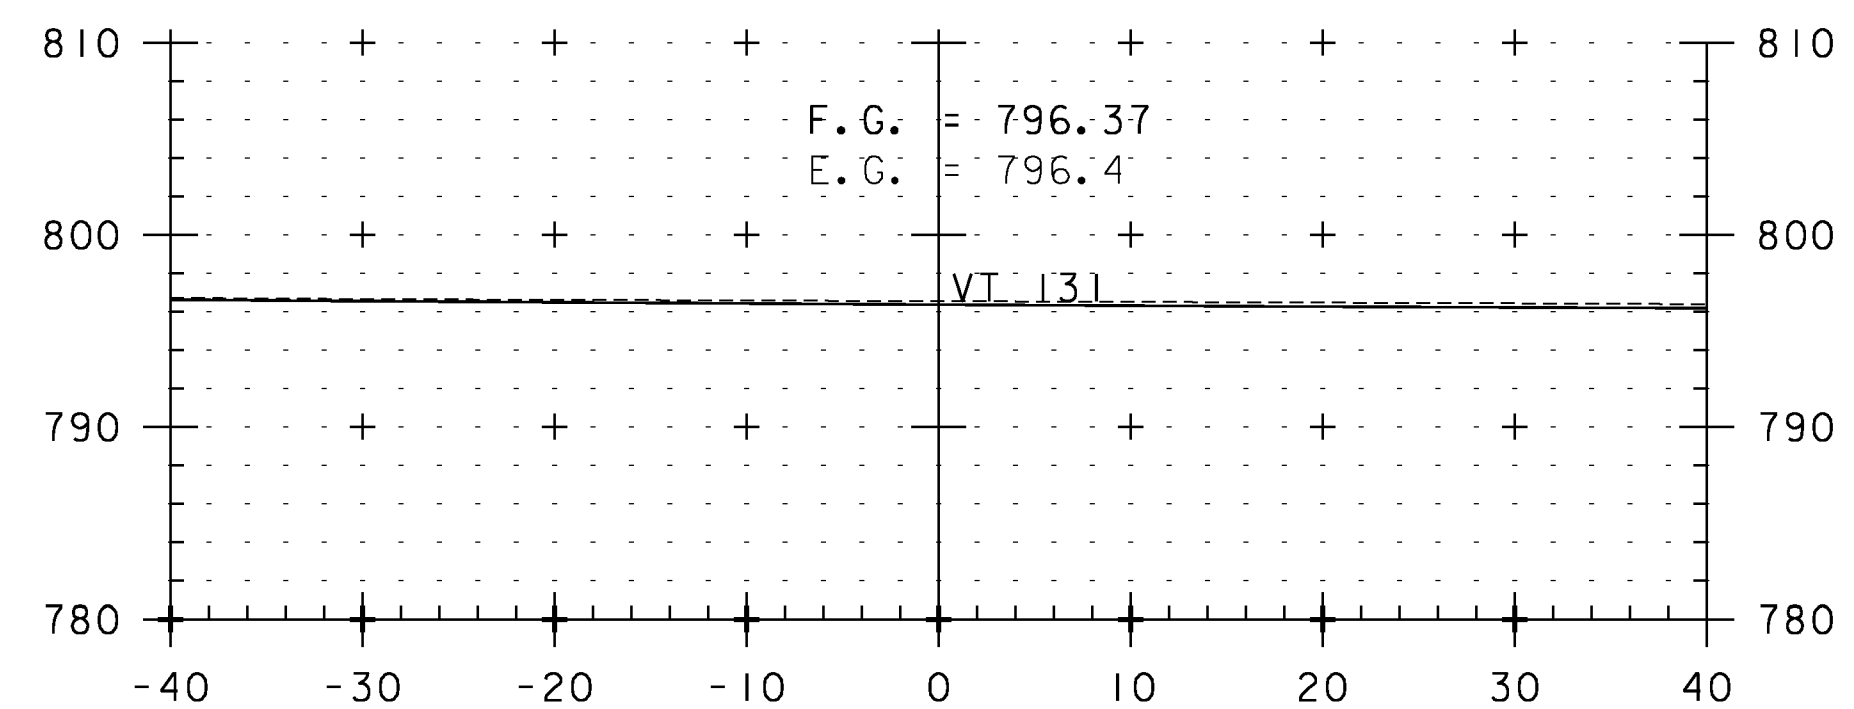

40+00



STA. 40+00 TO STA. 40+50

CROSS SECTION TH 65

PROJECT NAME: WEATHERSFIELD	PLOT DATE: 2/7/2013
PROJECT NUMBER: STP 2913(I)	DRAWN BY: JLS
FILE NAME: i0c228	CHECKED BY: PTS
PROJECT LEADER: PTS	SHEET 180 OF 234
DESIGNED BY: JLS	
IPARM FILE NAME: p10c228.l80	