




50+46

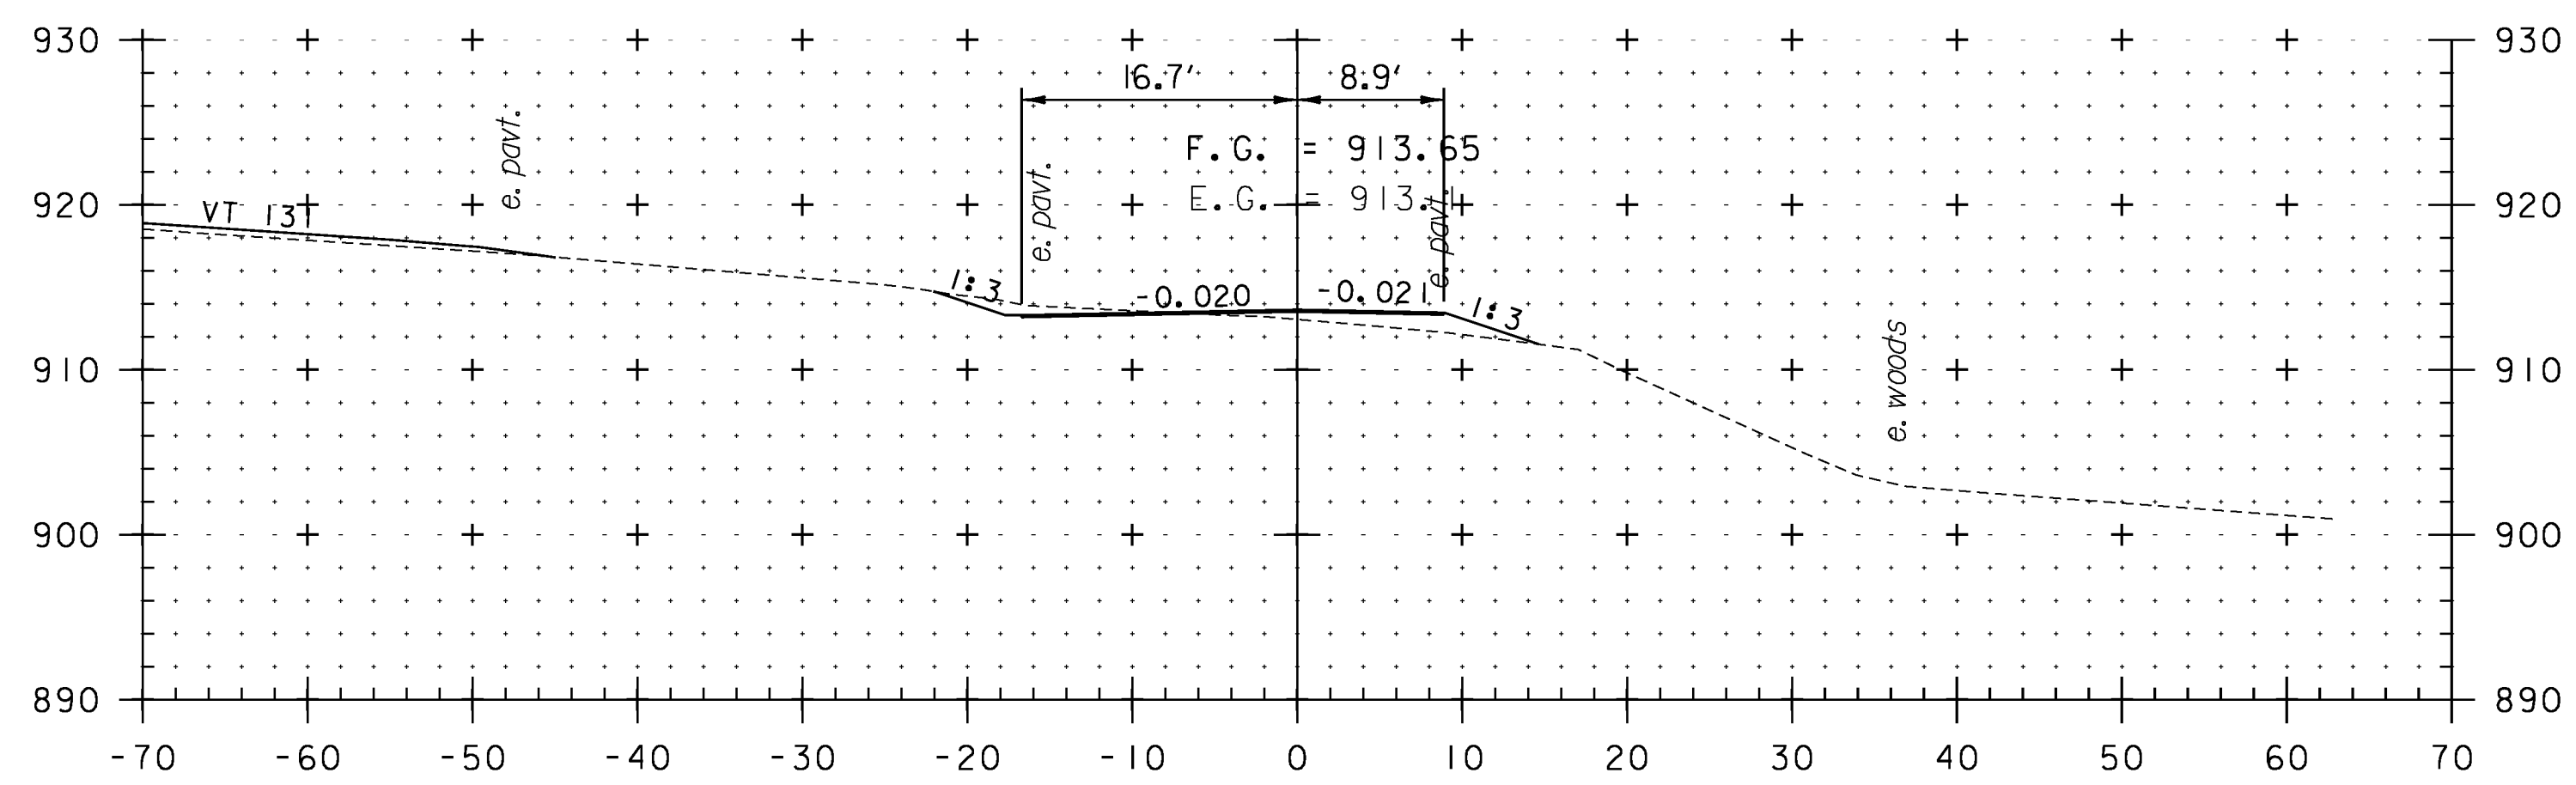


50+25

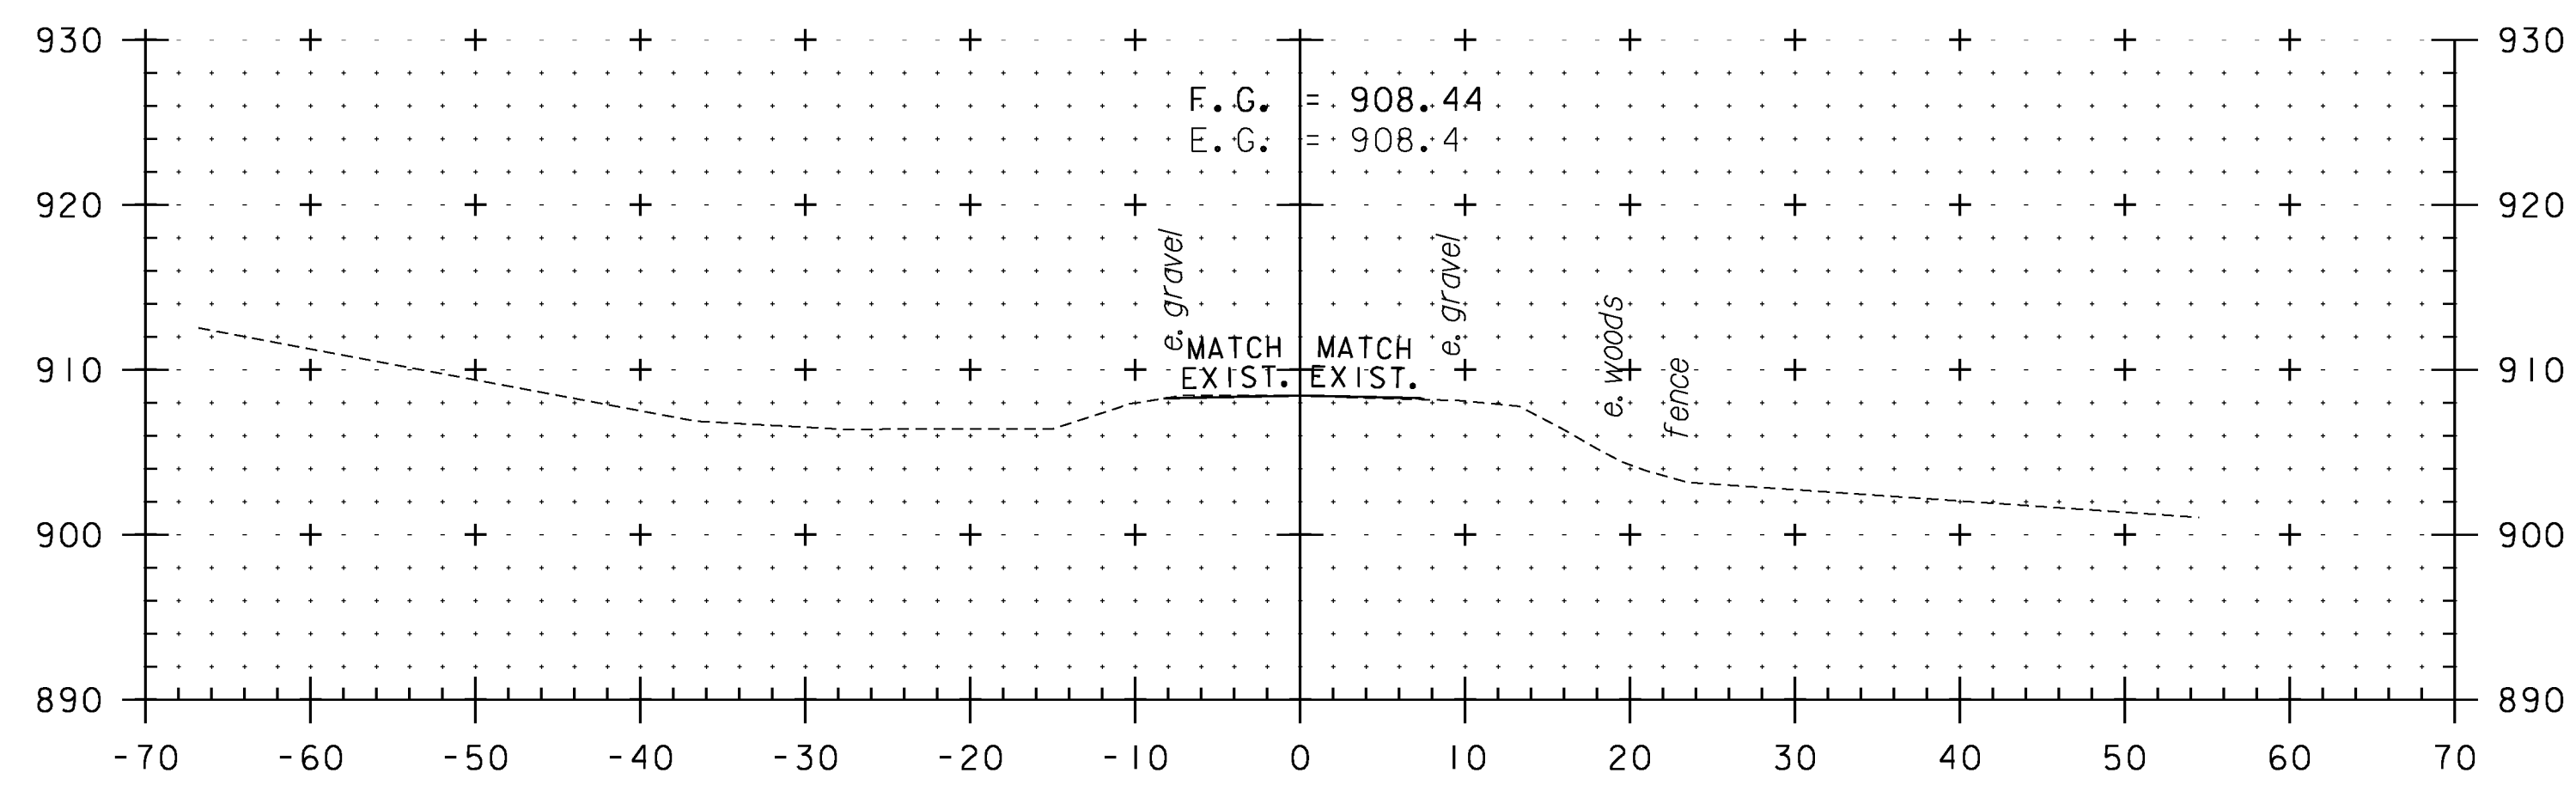

50+75

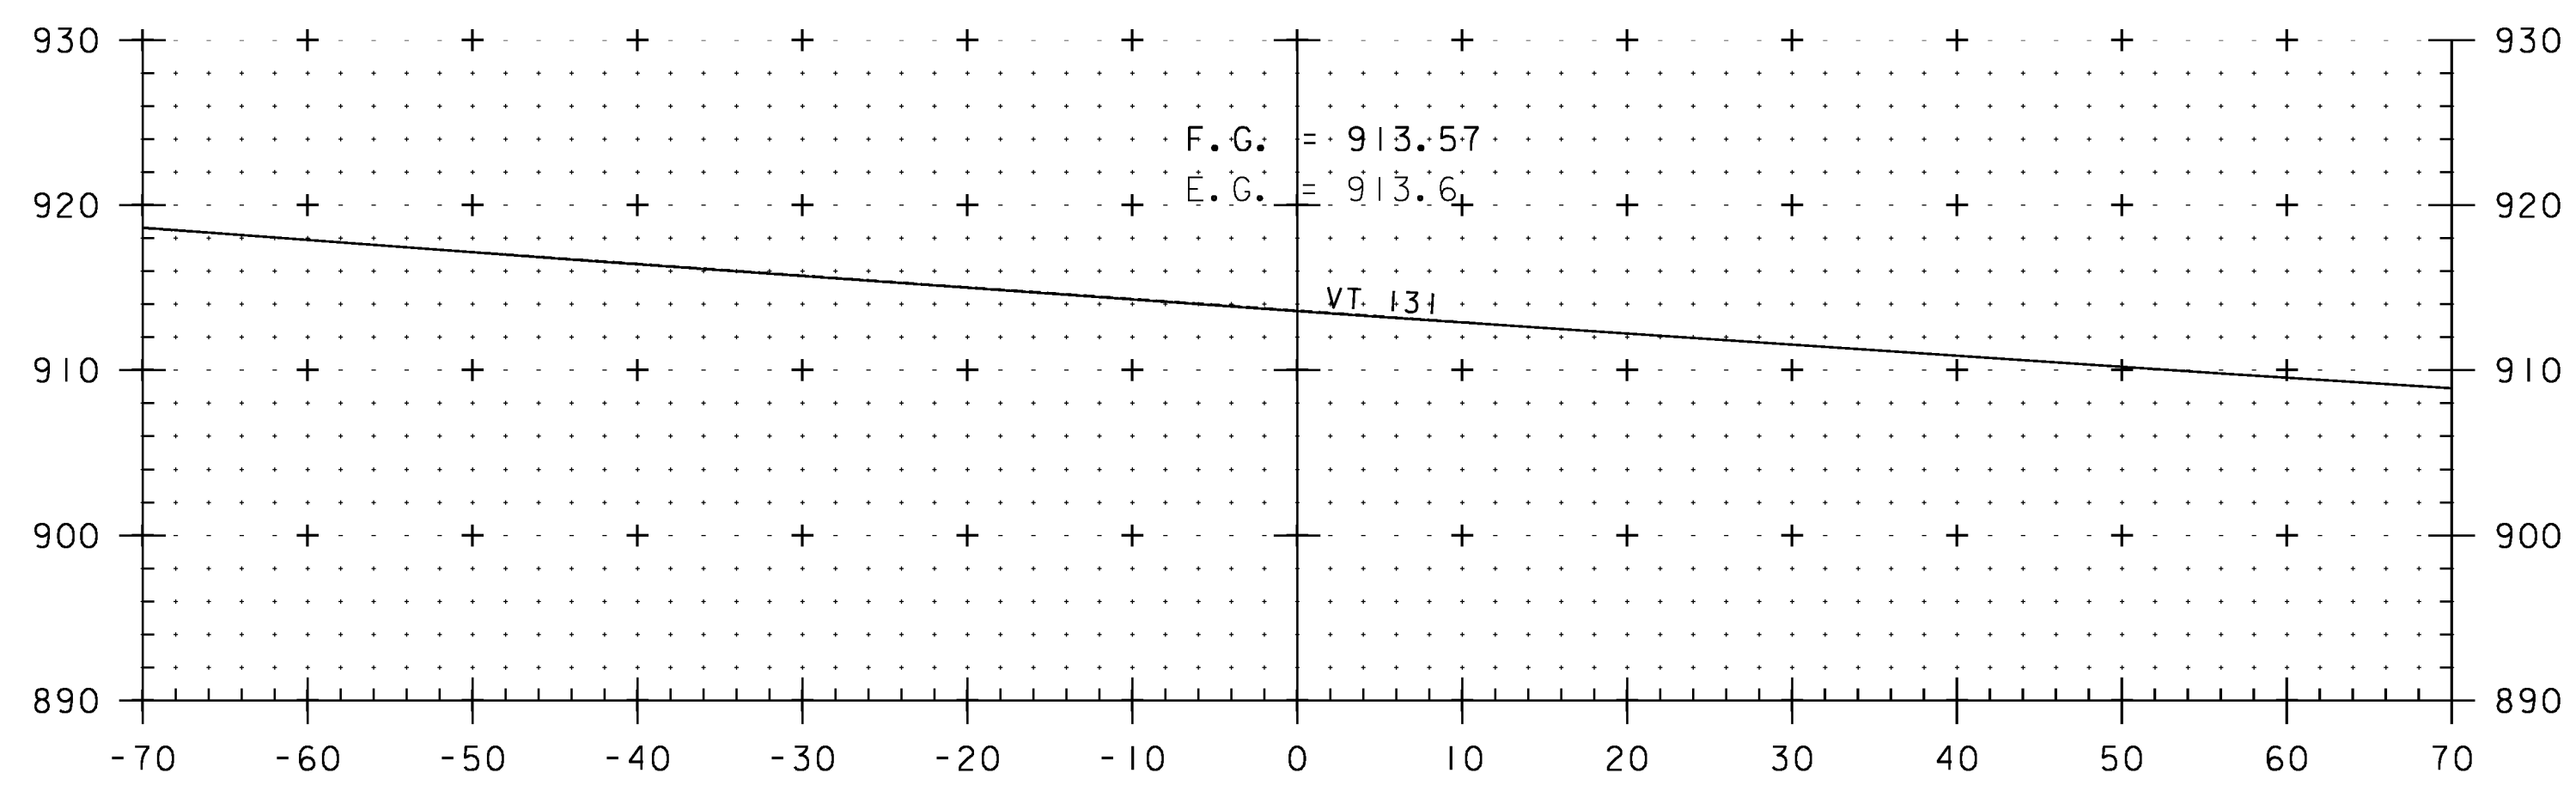


50+00

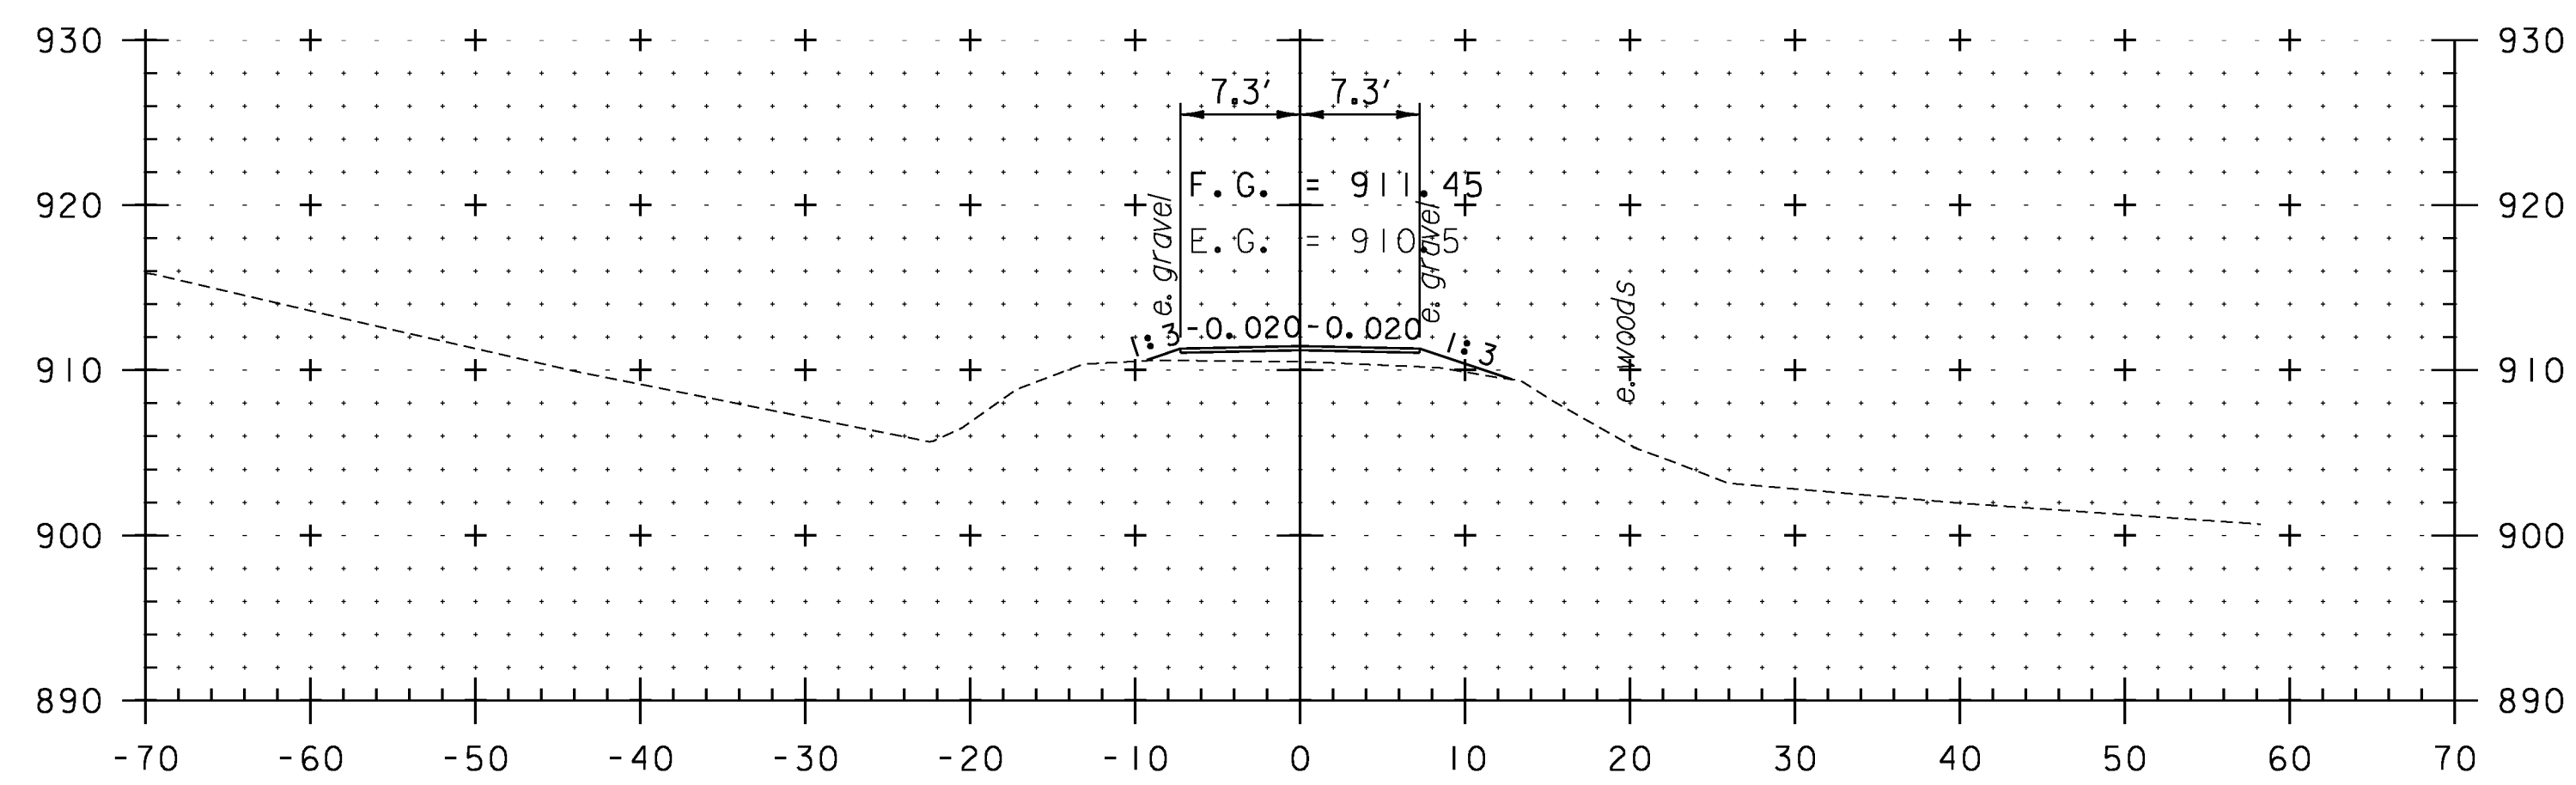

50+50

**CROSS SECTION TH 79**

PROJECT NAME:	WEATHERSFIELD
PROJECT NUMBER:	STP 2913(I)
FILE NAME:	I0c228
PROJECT LEADER:	PTS
DESIGNED BY:	JLS
IPARM FILE NAME:	pI0C228.I81
PLOT DATE:	2/7/2013
DRAWN BY:	JLS
CHECKED BY:	PTS
SHEET	181 OF 234

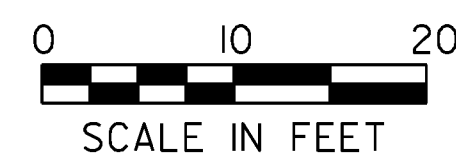

STA. 50+00 TO STA. 50+75