




104+18

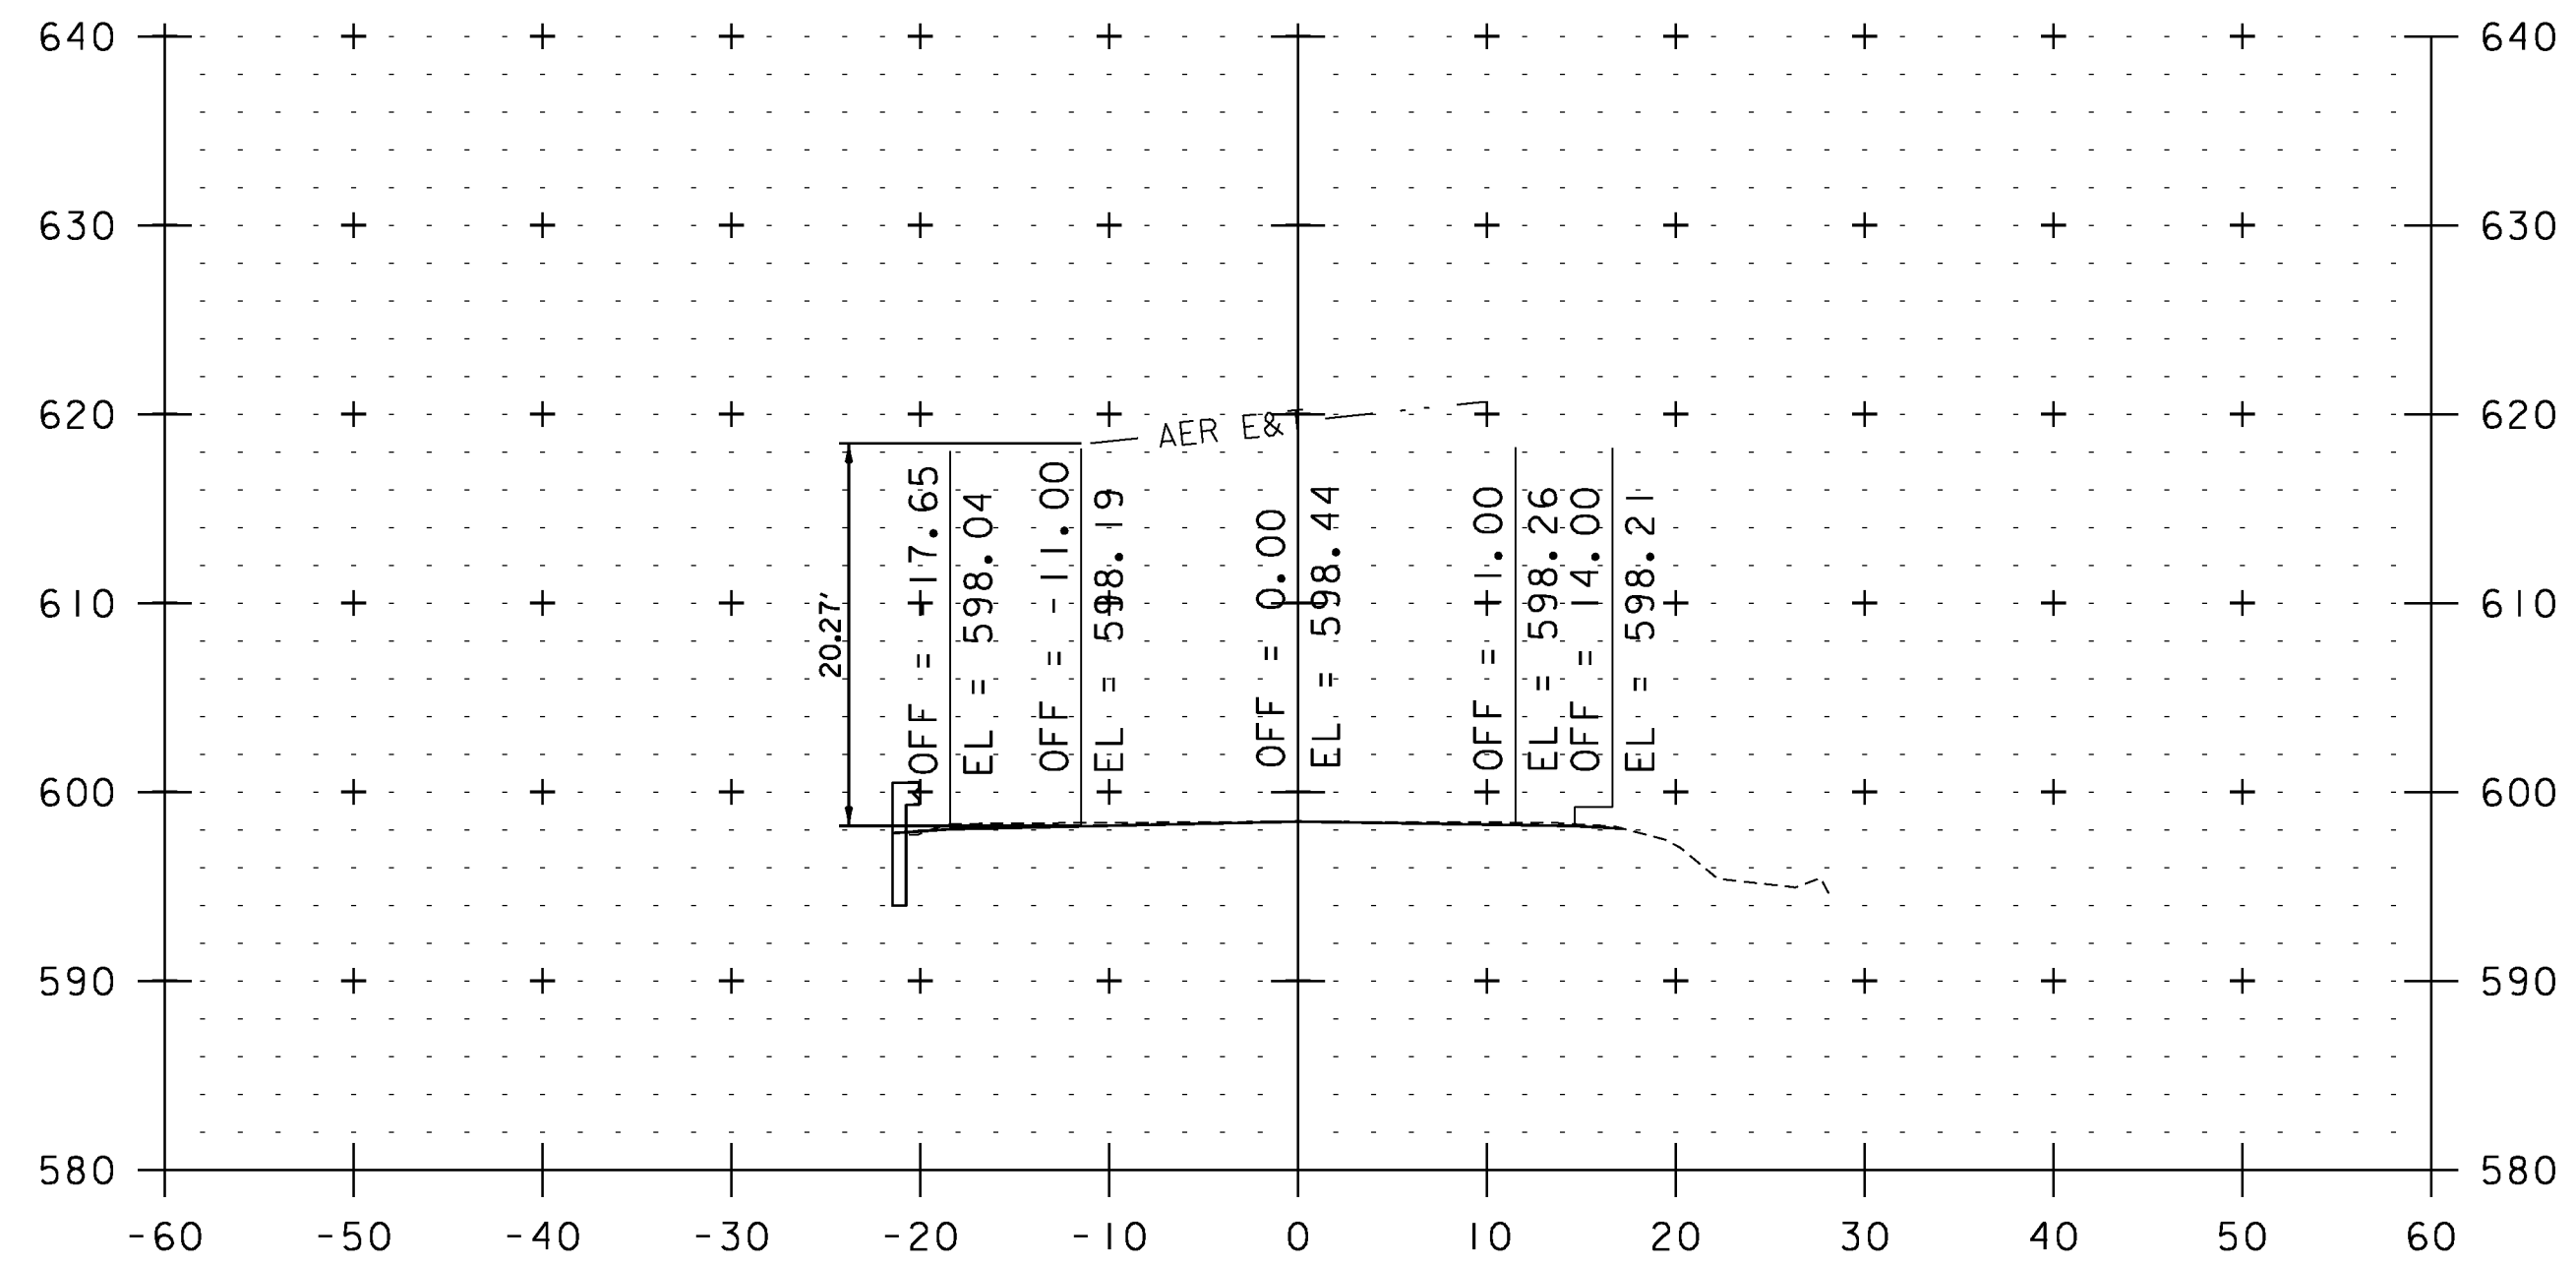

107+79

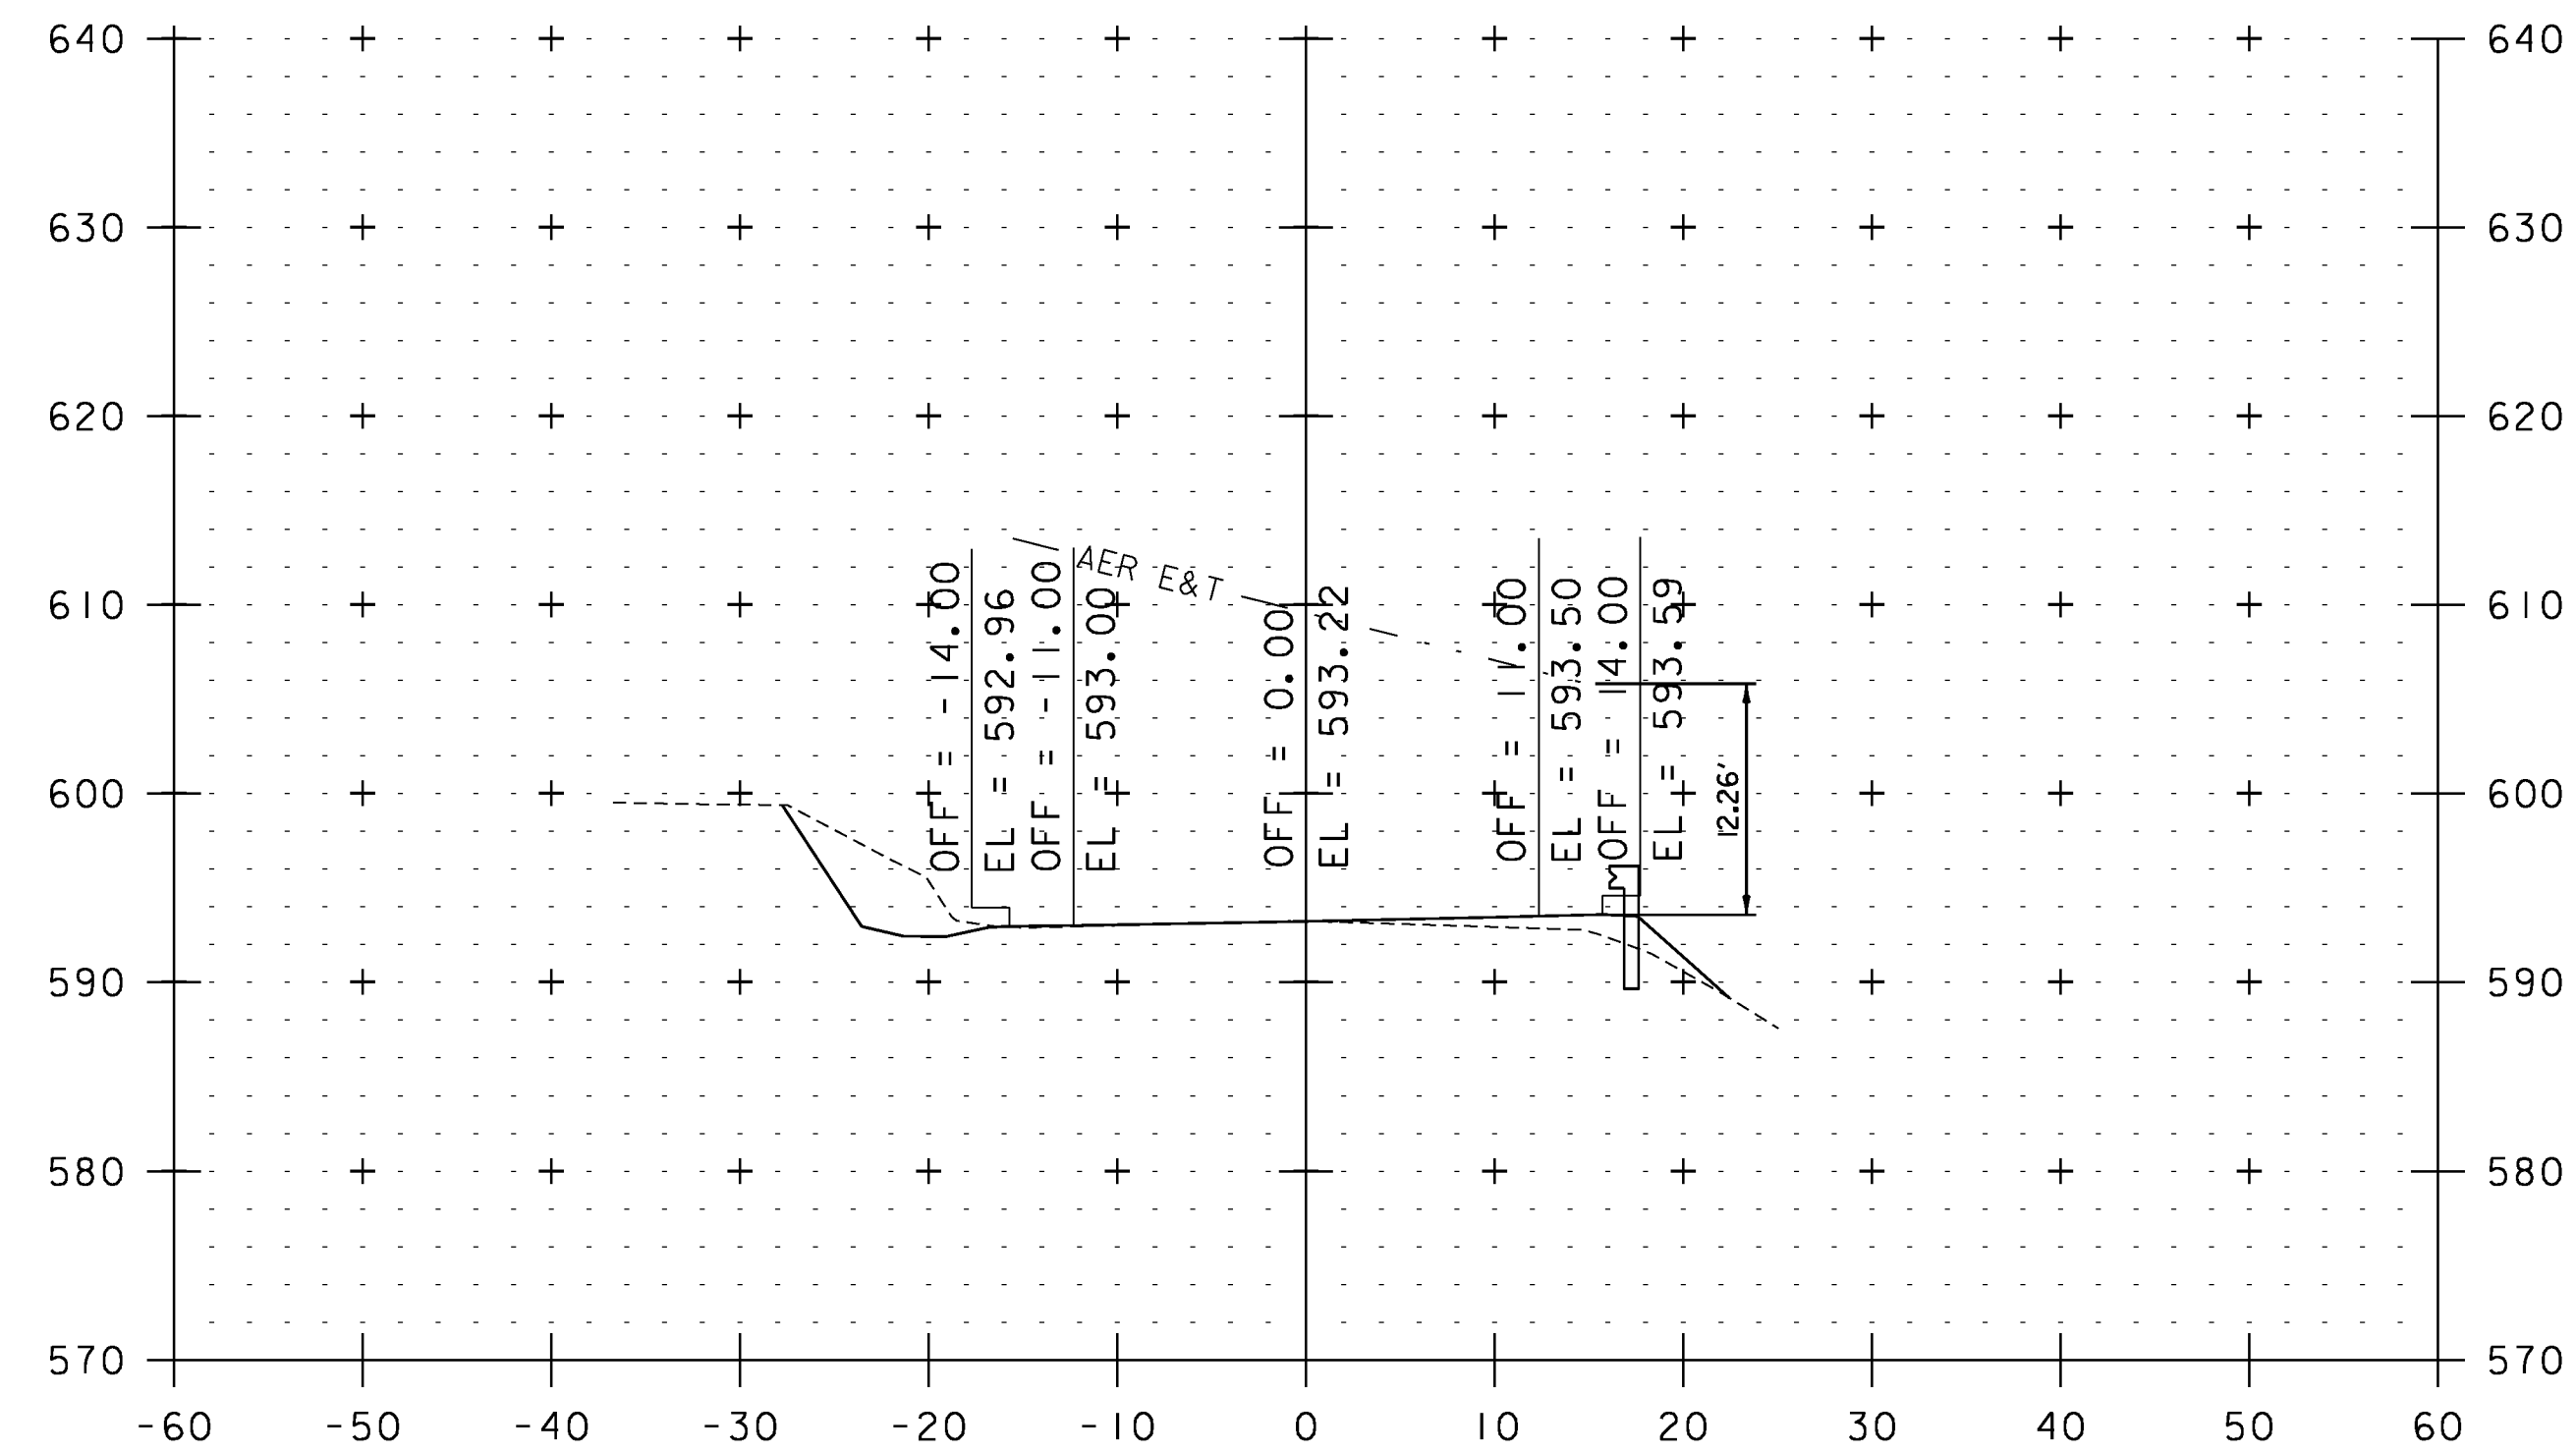

101+41

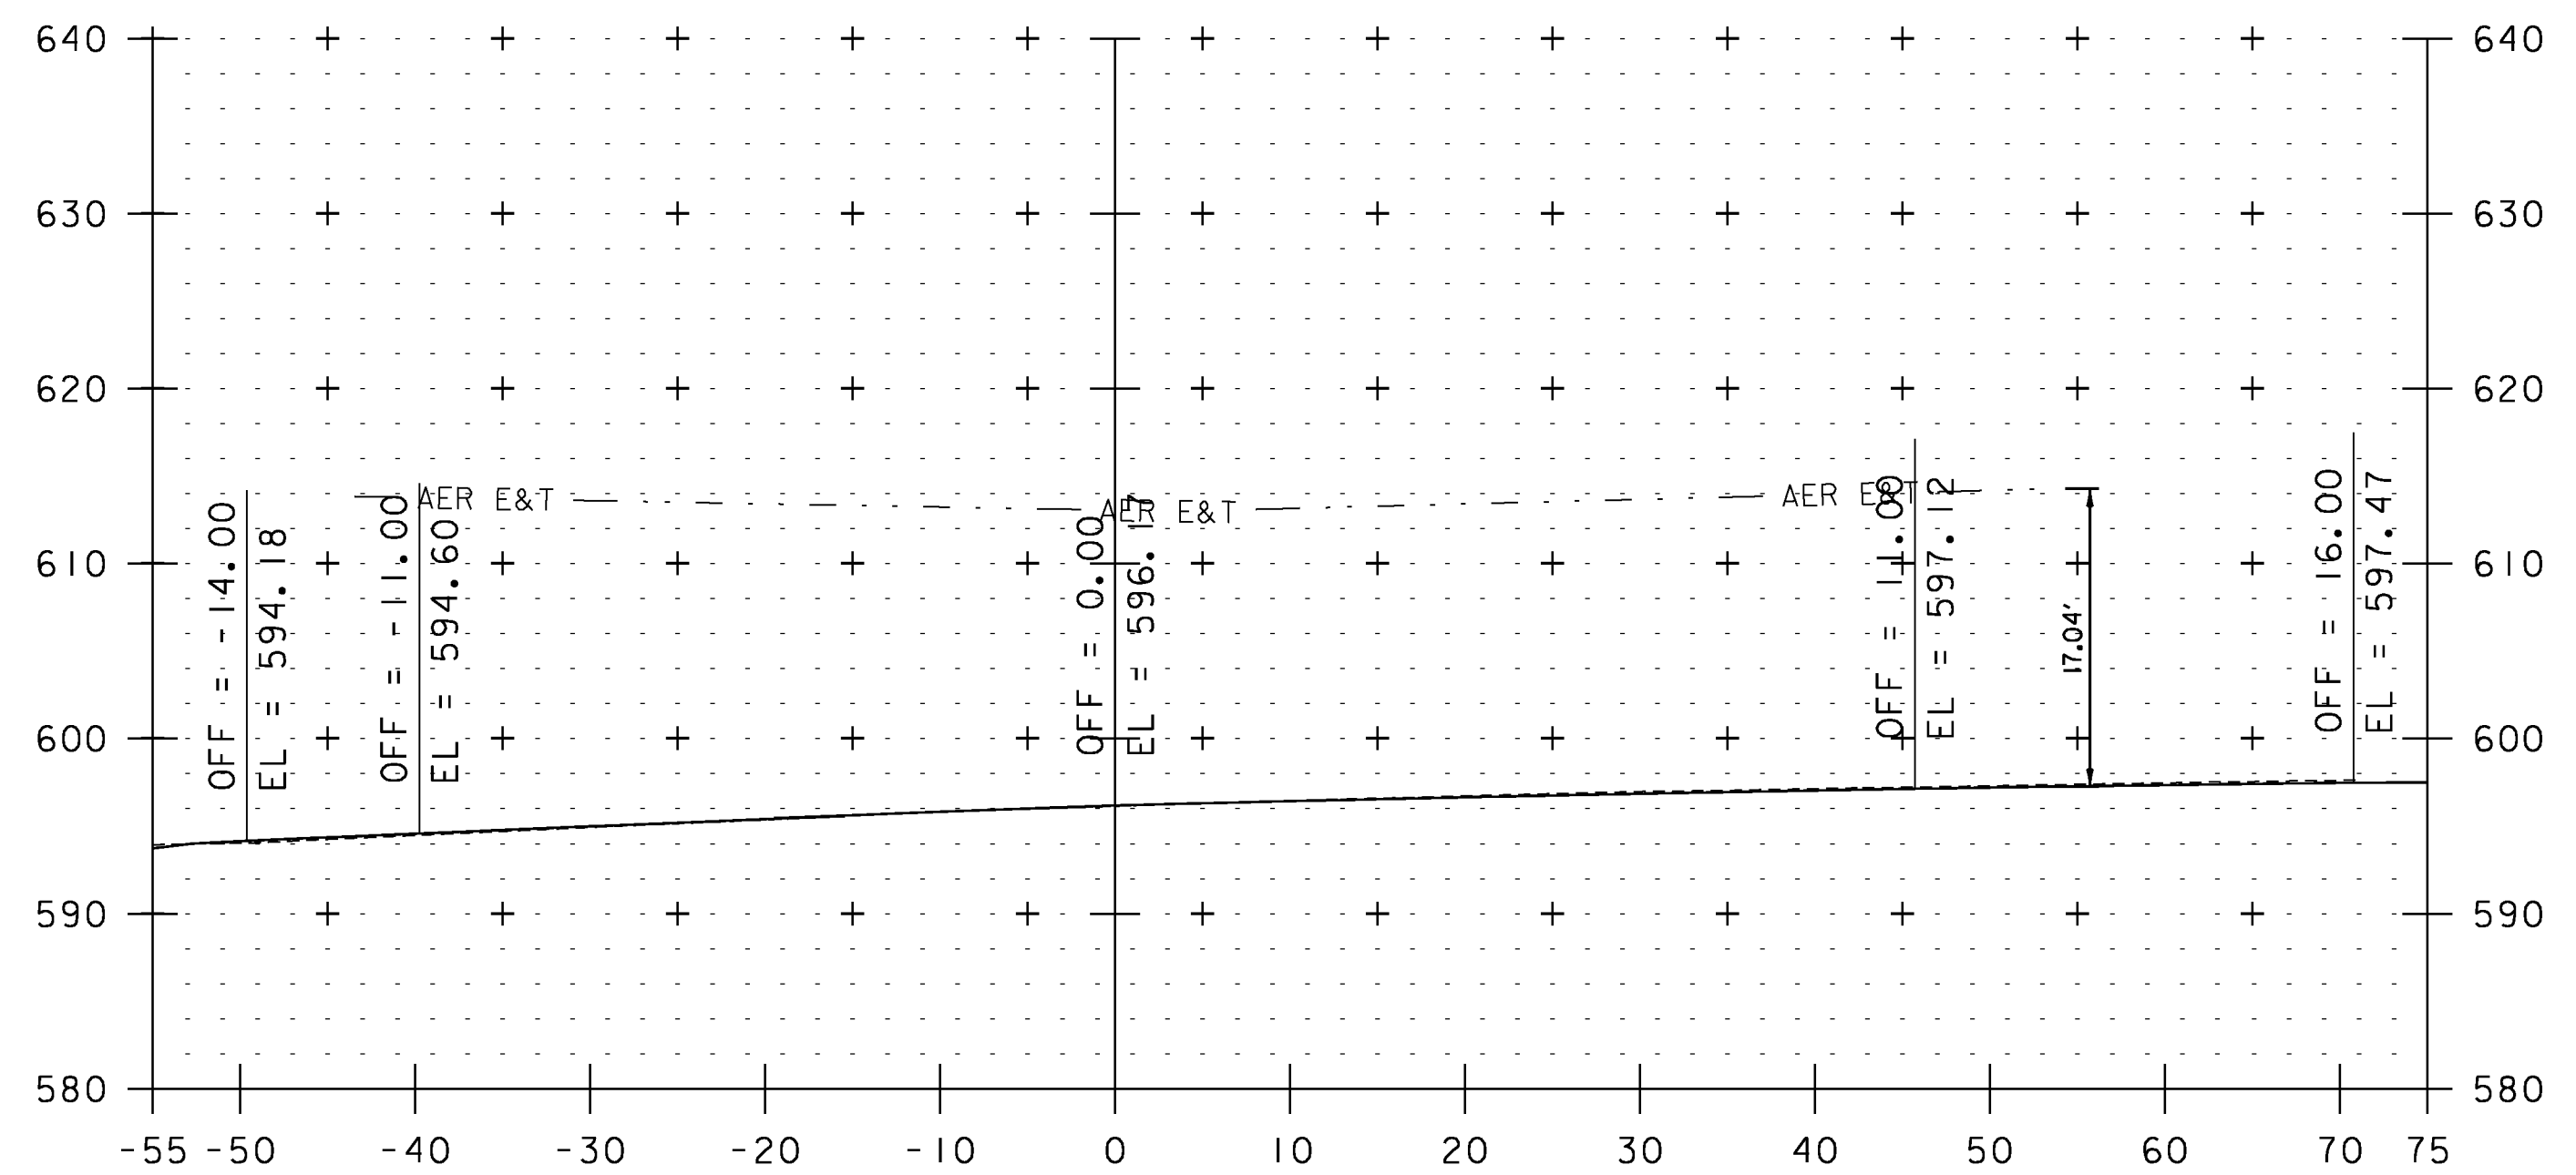

106+49



STA. 101+41 TO STA. 107+79

UTILITY CROSS SECTION SHEET 3

PROJECT NAME: WEATHERSFIELD	PLOT DATE: 2/7/2013
PROJECT NUMBER: STP 2913(I)	DRAWN BY: JLS
FILE NAME: I0c228	CHECKED BY: PTS
PROJECT LEADER: PTS	SHEET 185 OF 234
DESIGNED BY: NLL	
IPARM FILE NAME: pI0c228.I85	