




259+22

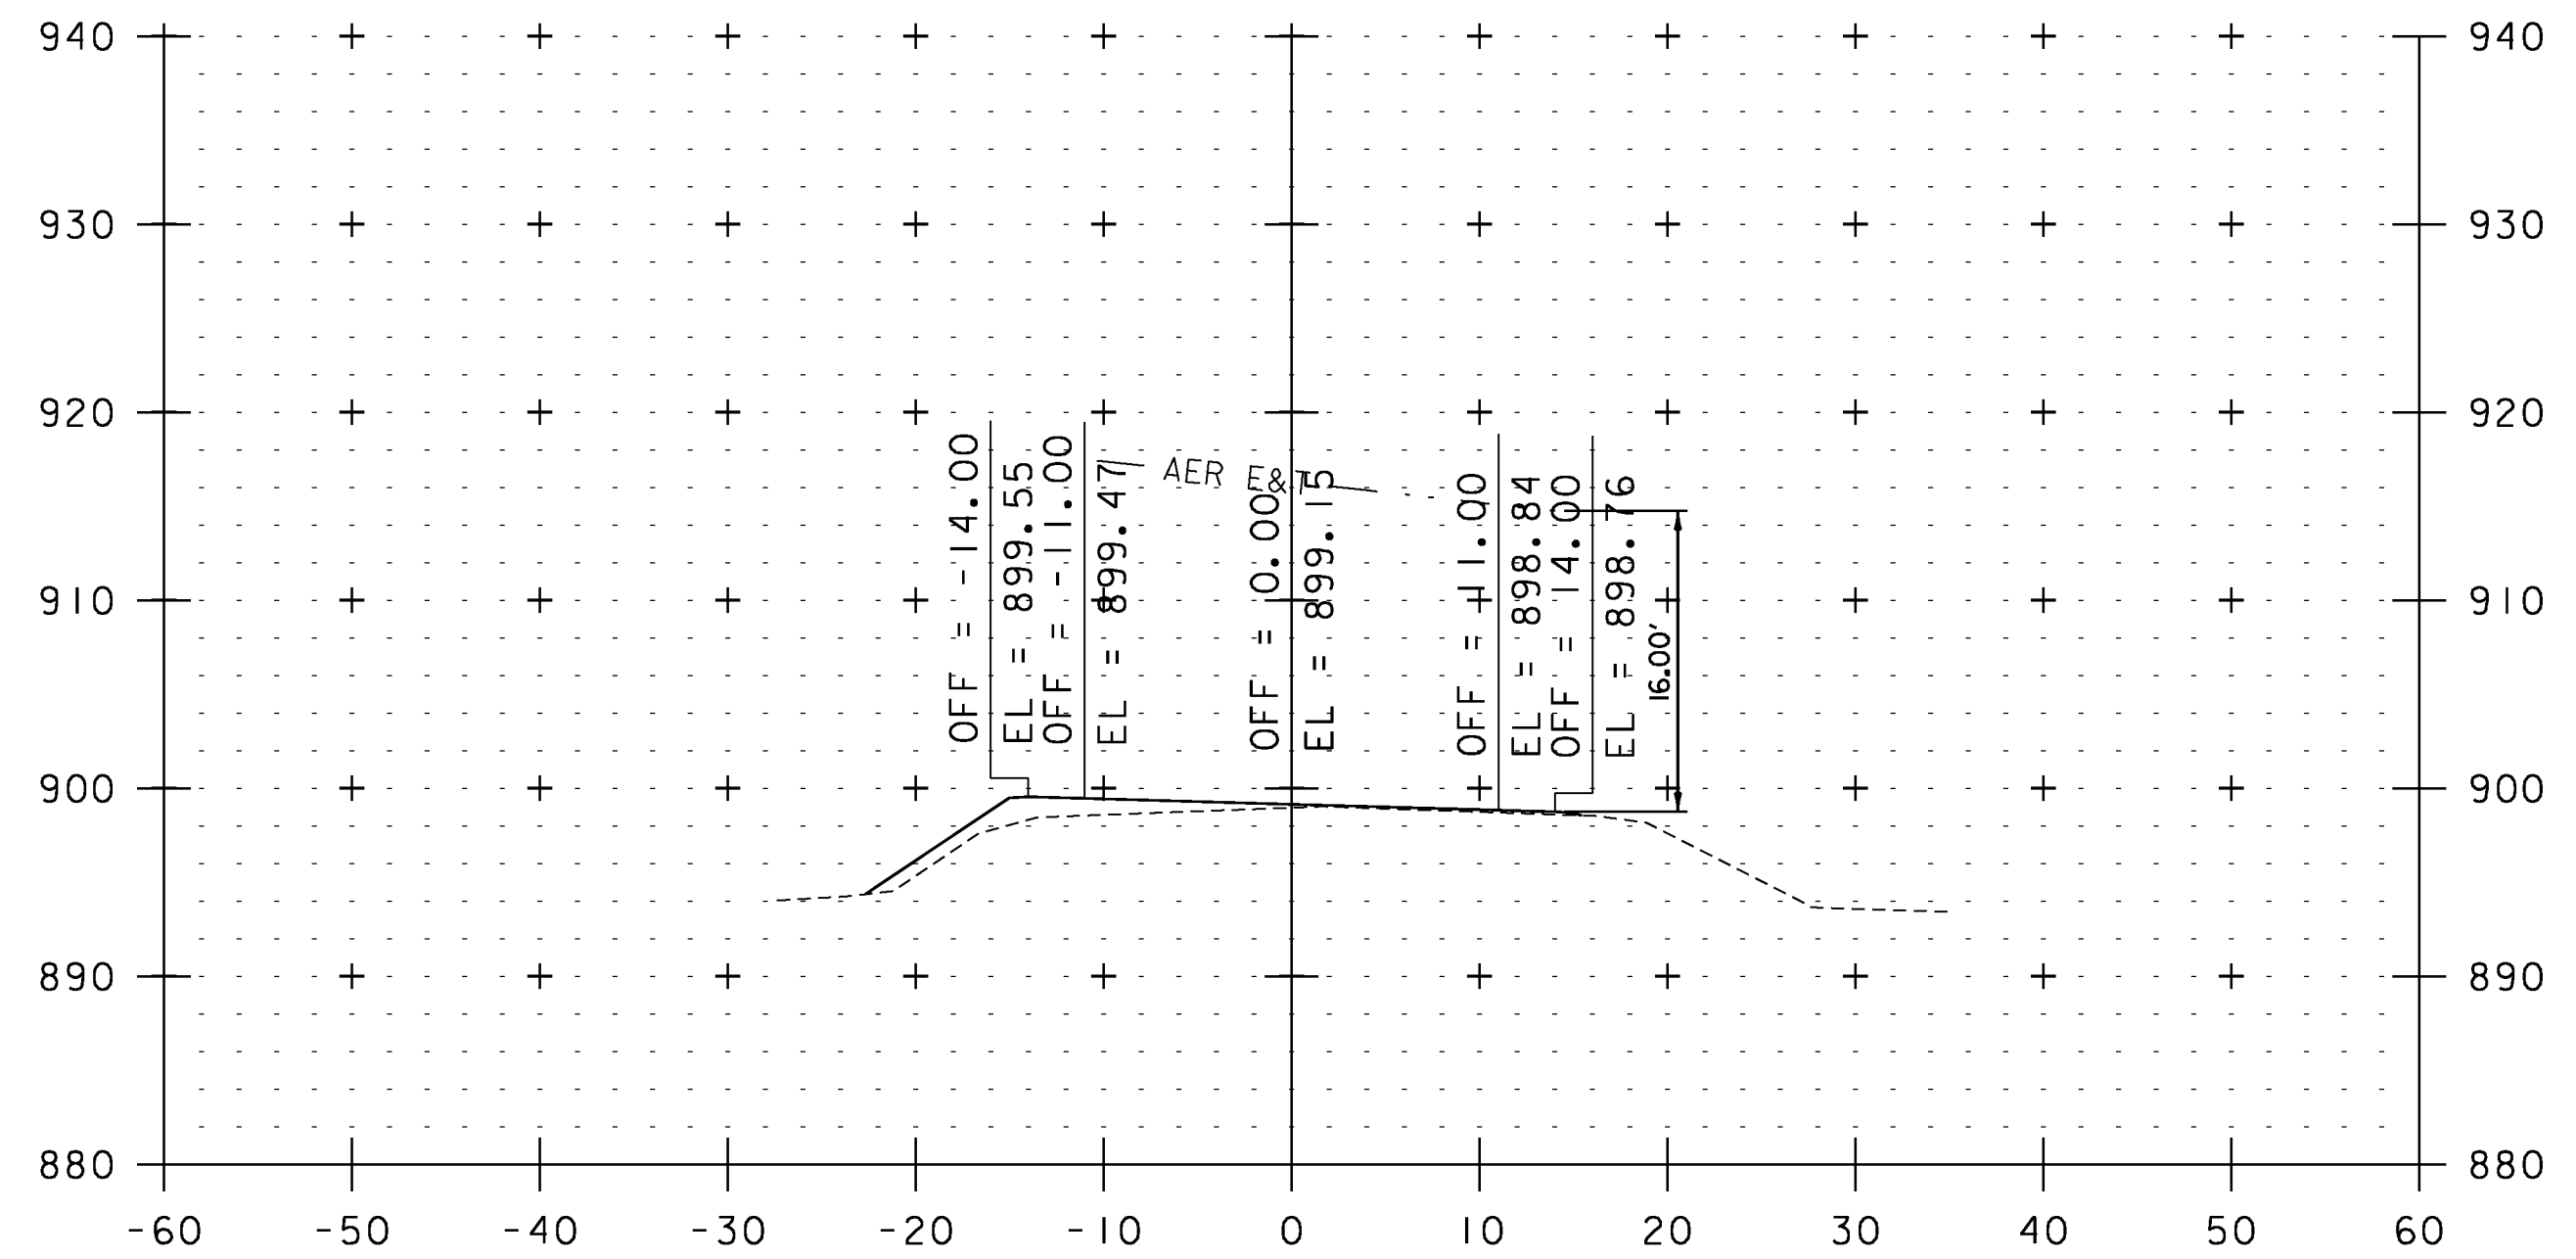

267+27

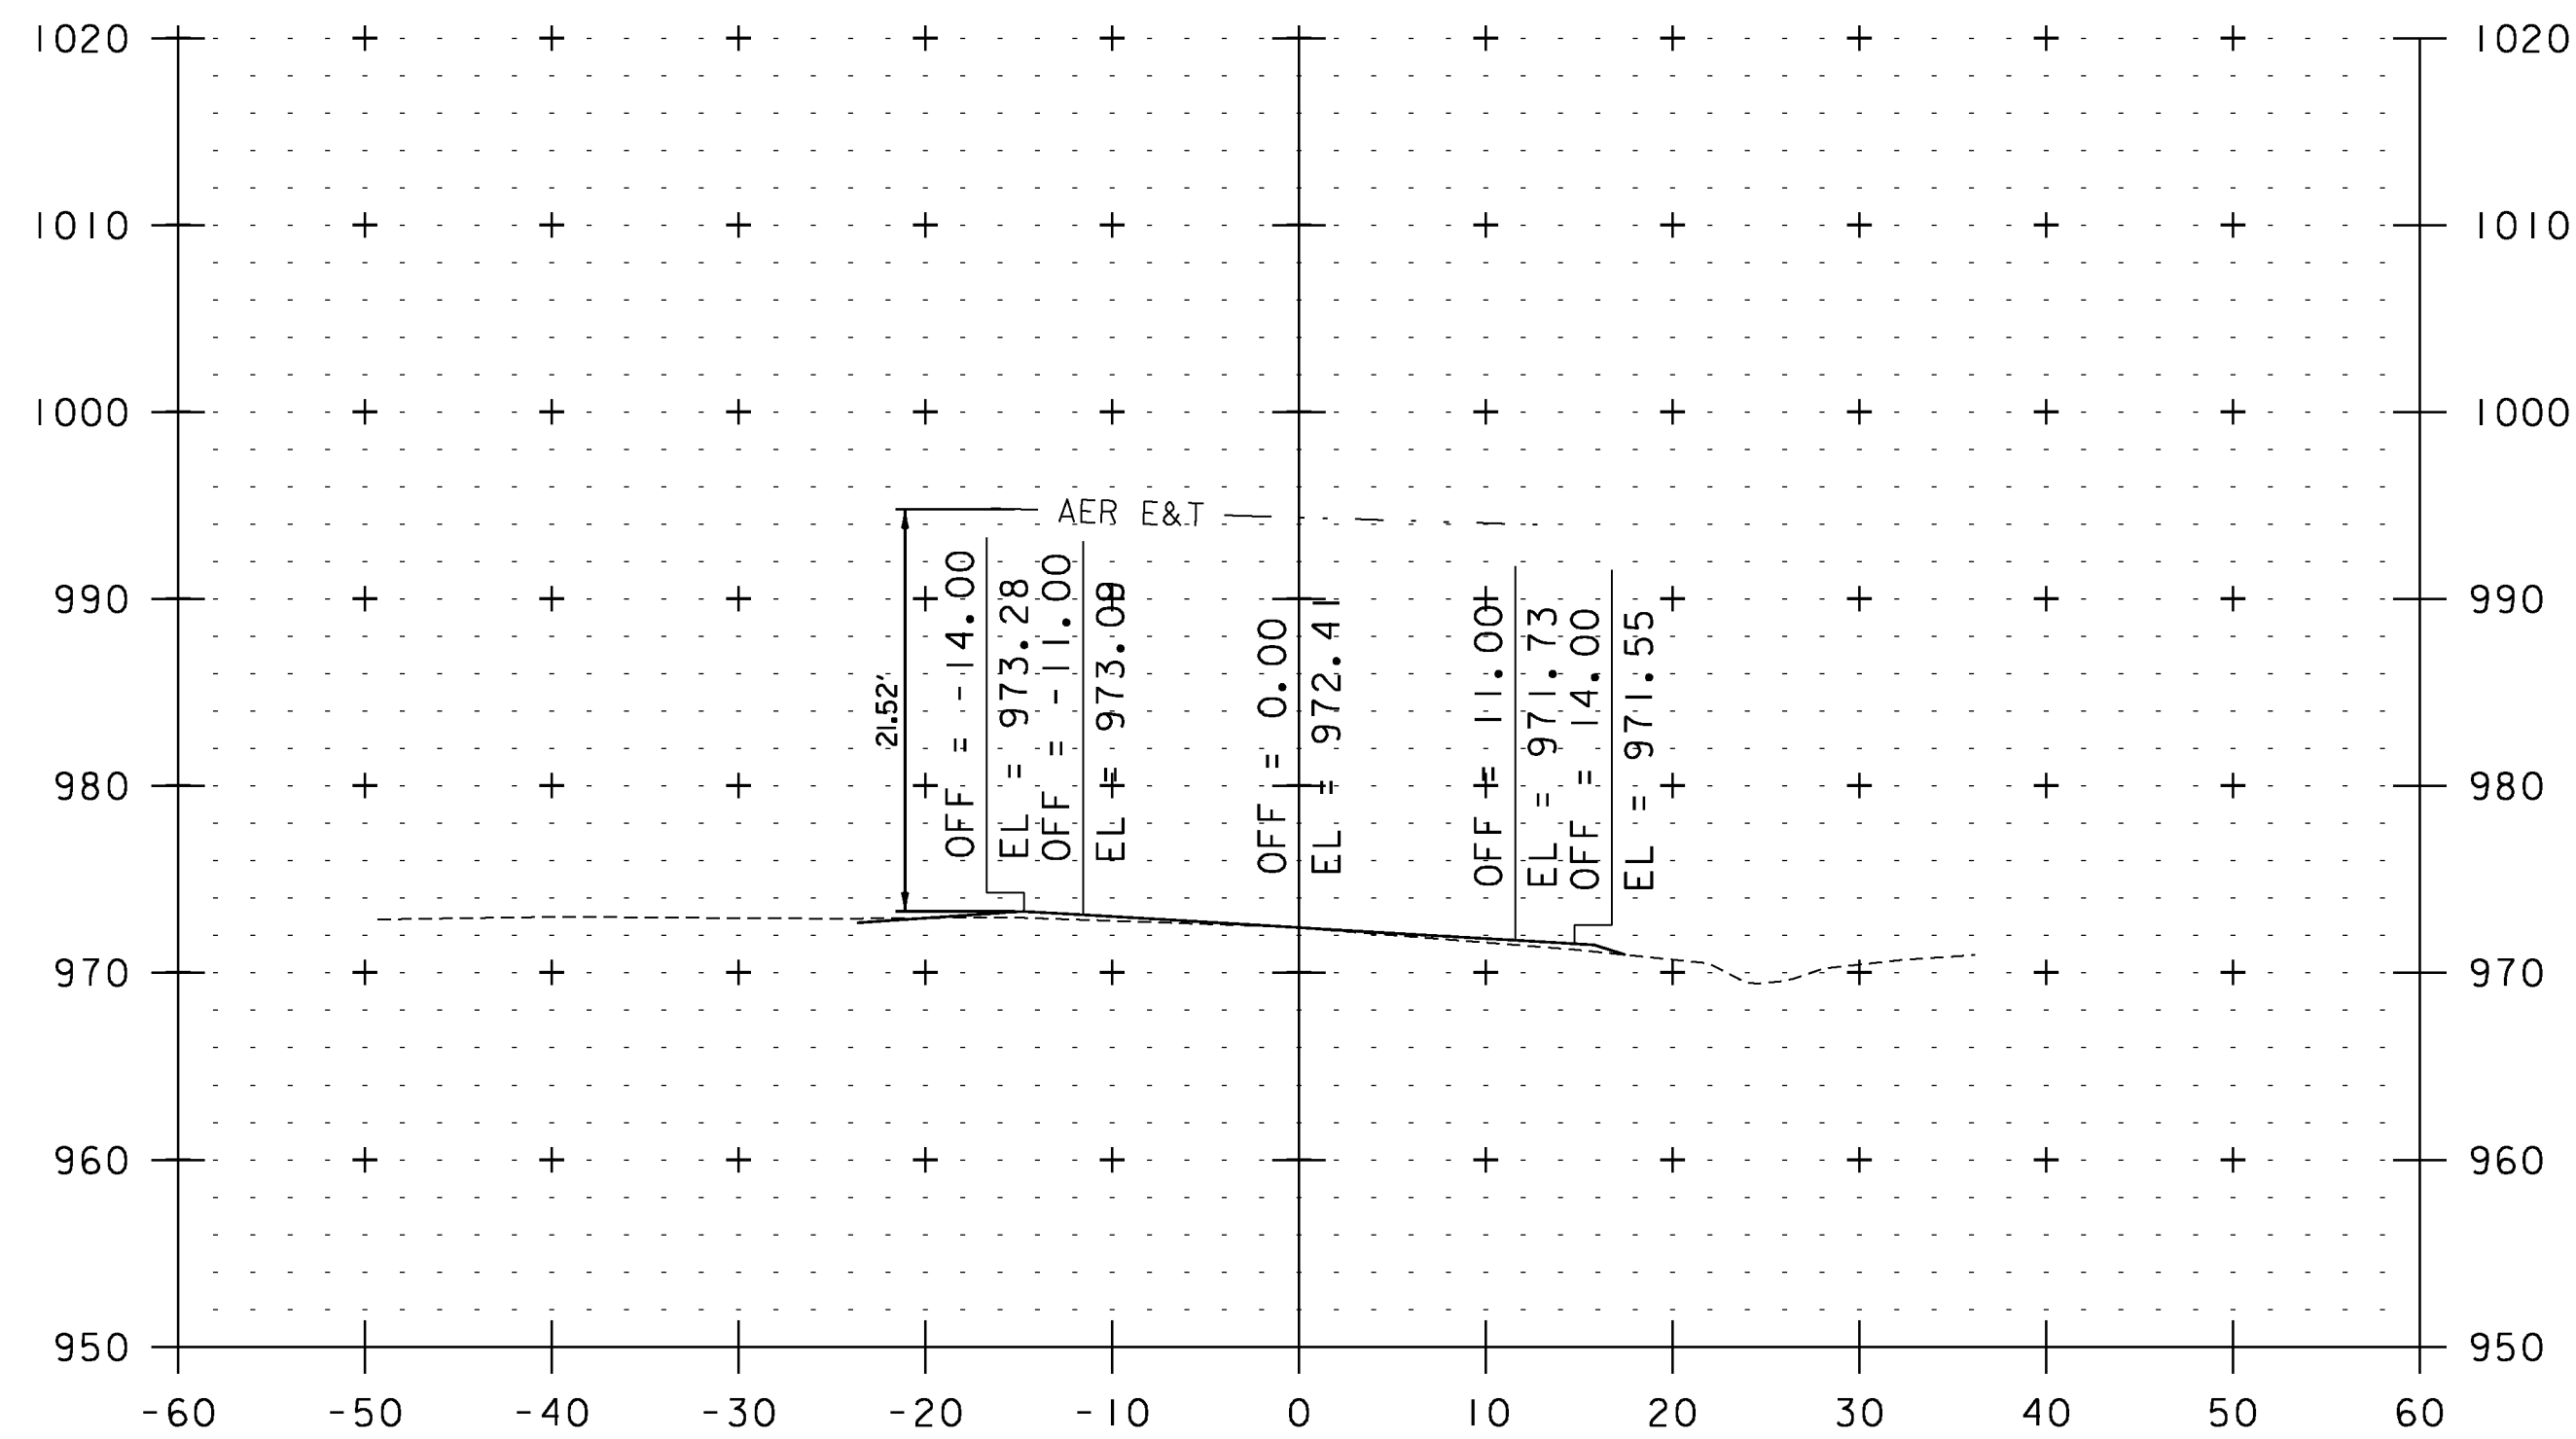

253+40

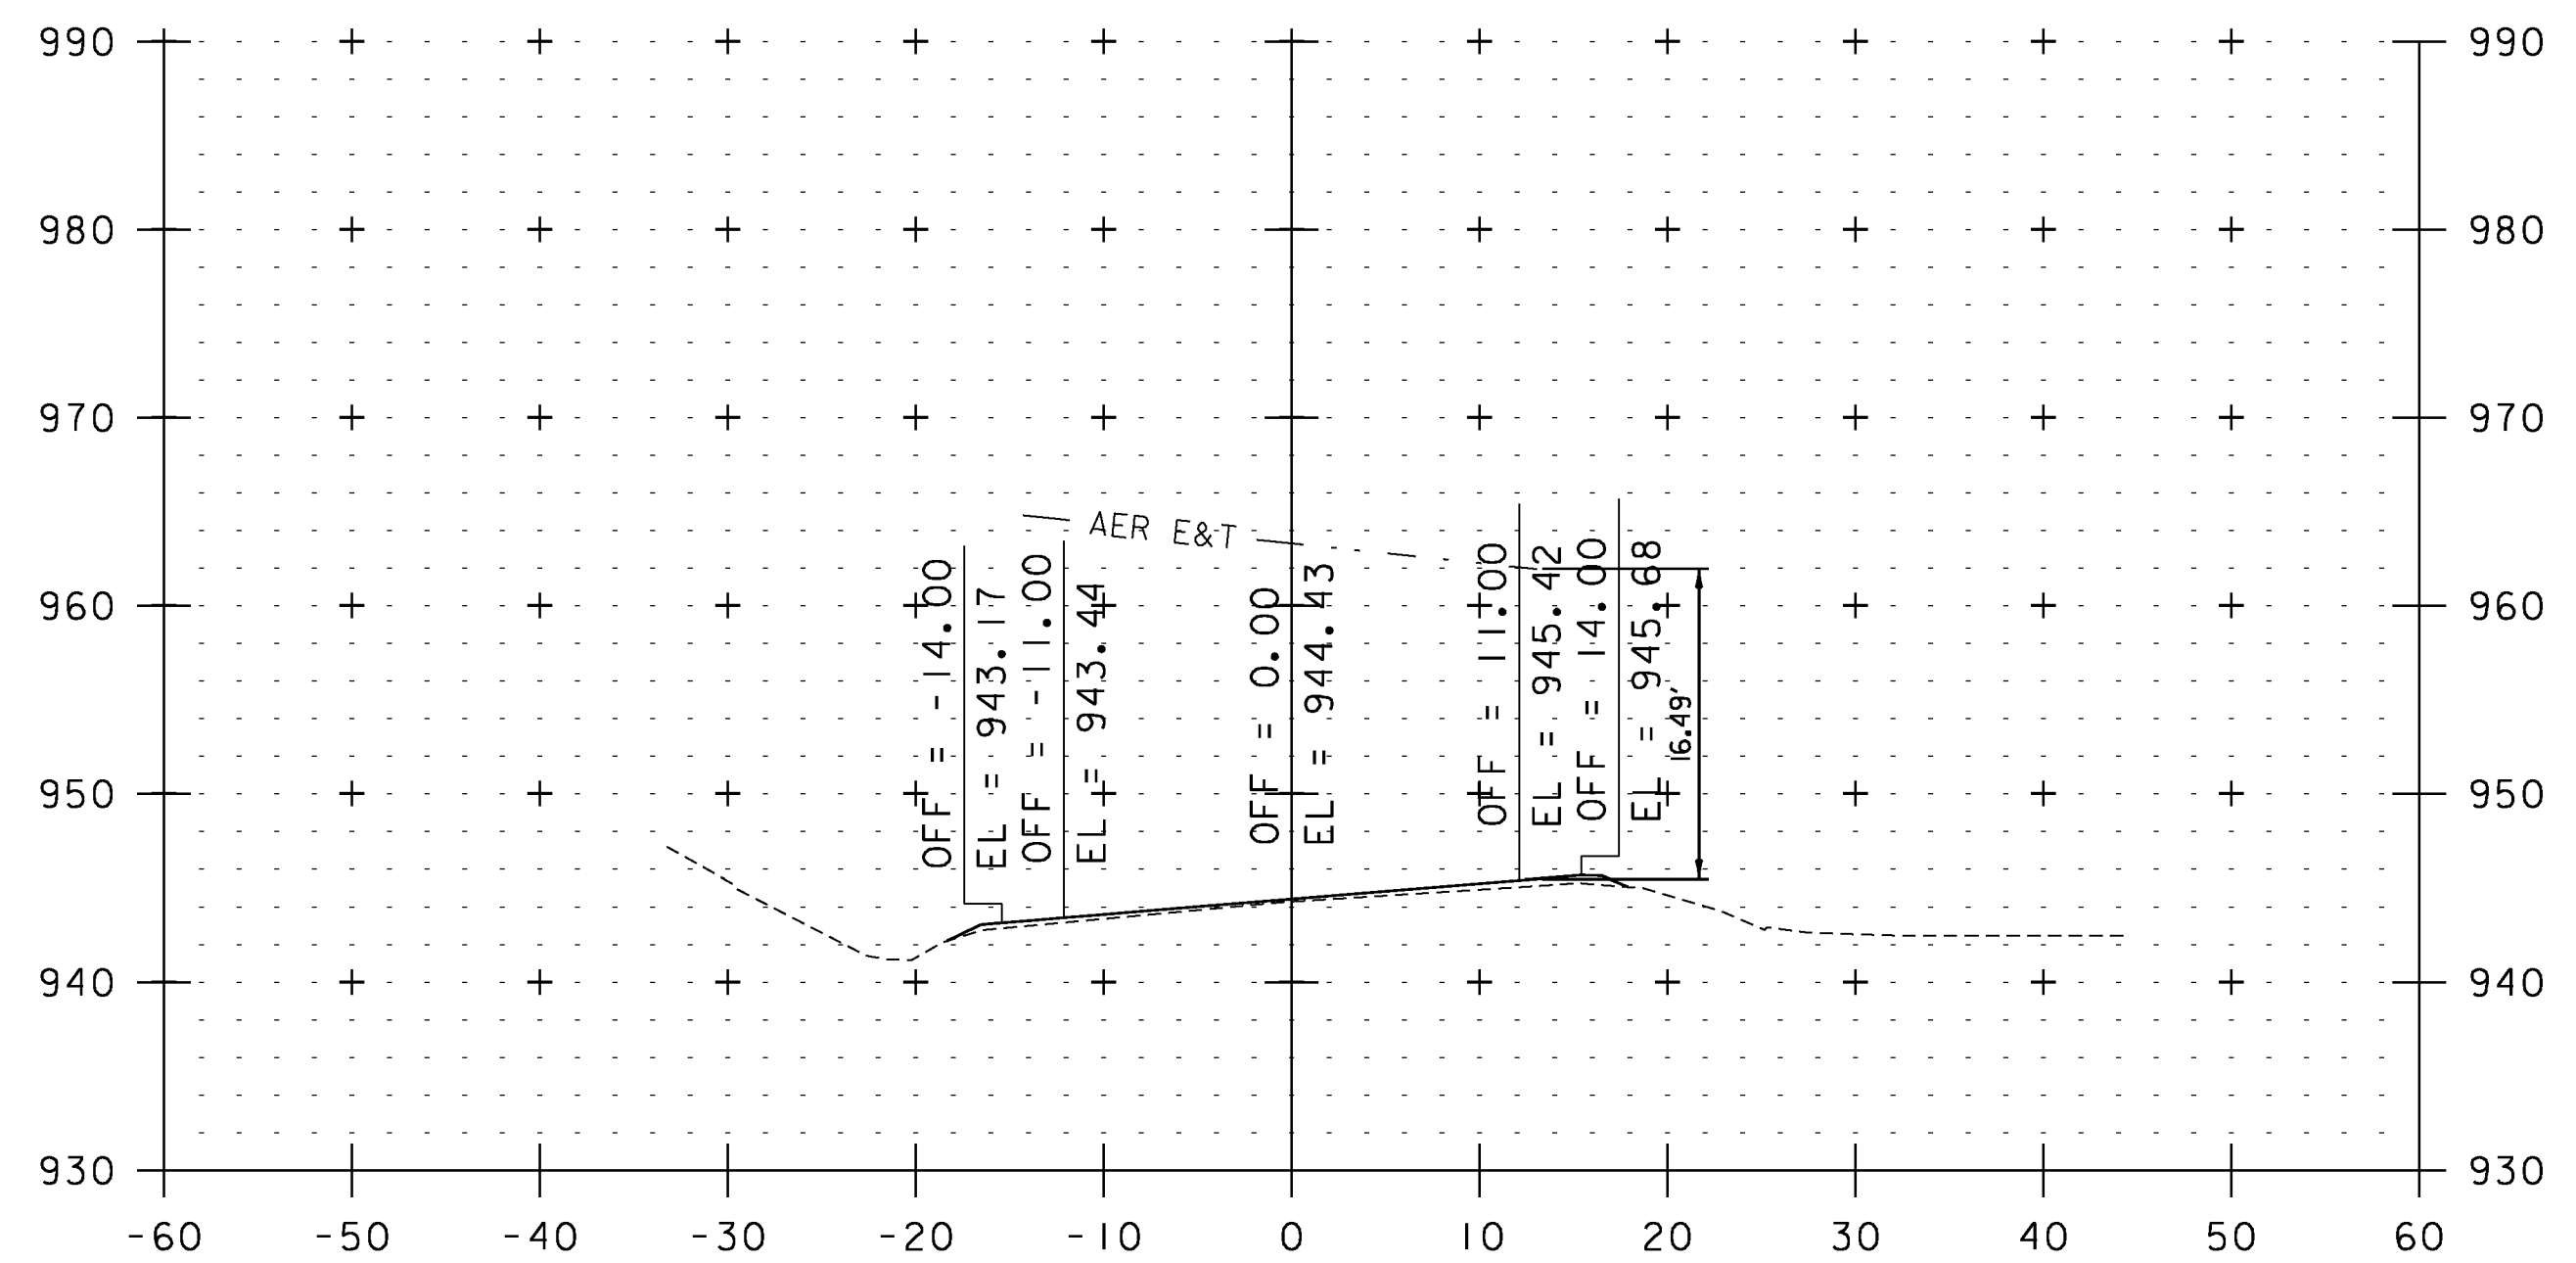

260+81



STA. 253+40 TO STA. 267+27

**UTILITY CROSS SECTION SHEET 12**

PROJECT NAME: WEATHERSFIELD	PLOT DATE: 2/7/2013
PROJECT NUMBER: STP 2913(I)	DRAWN BY: JLS
FILE NAME: I0c228	CHECKED BY: PTS
PROJECT LEADER: PTS	SHEET 194 OF 234
DESIGNED BY: NULL	
IPARM FILE NAME: pI0C228.I94	