




335+14

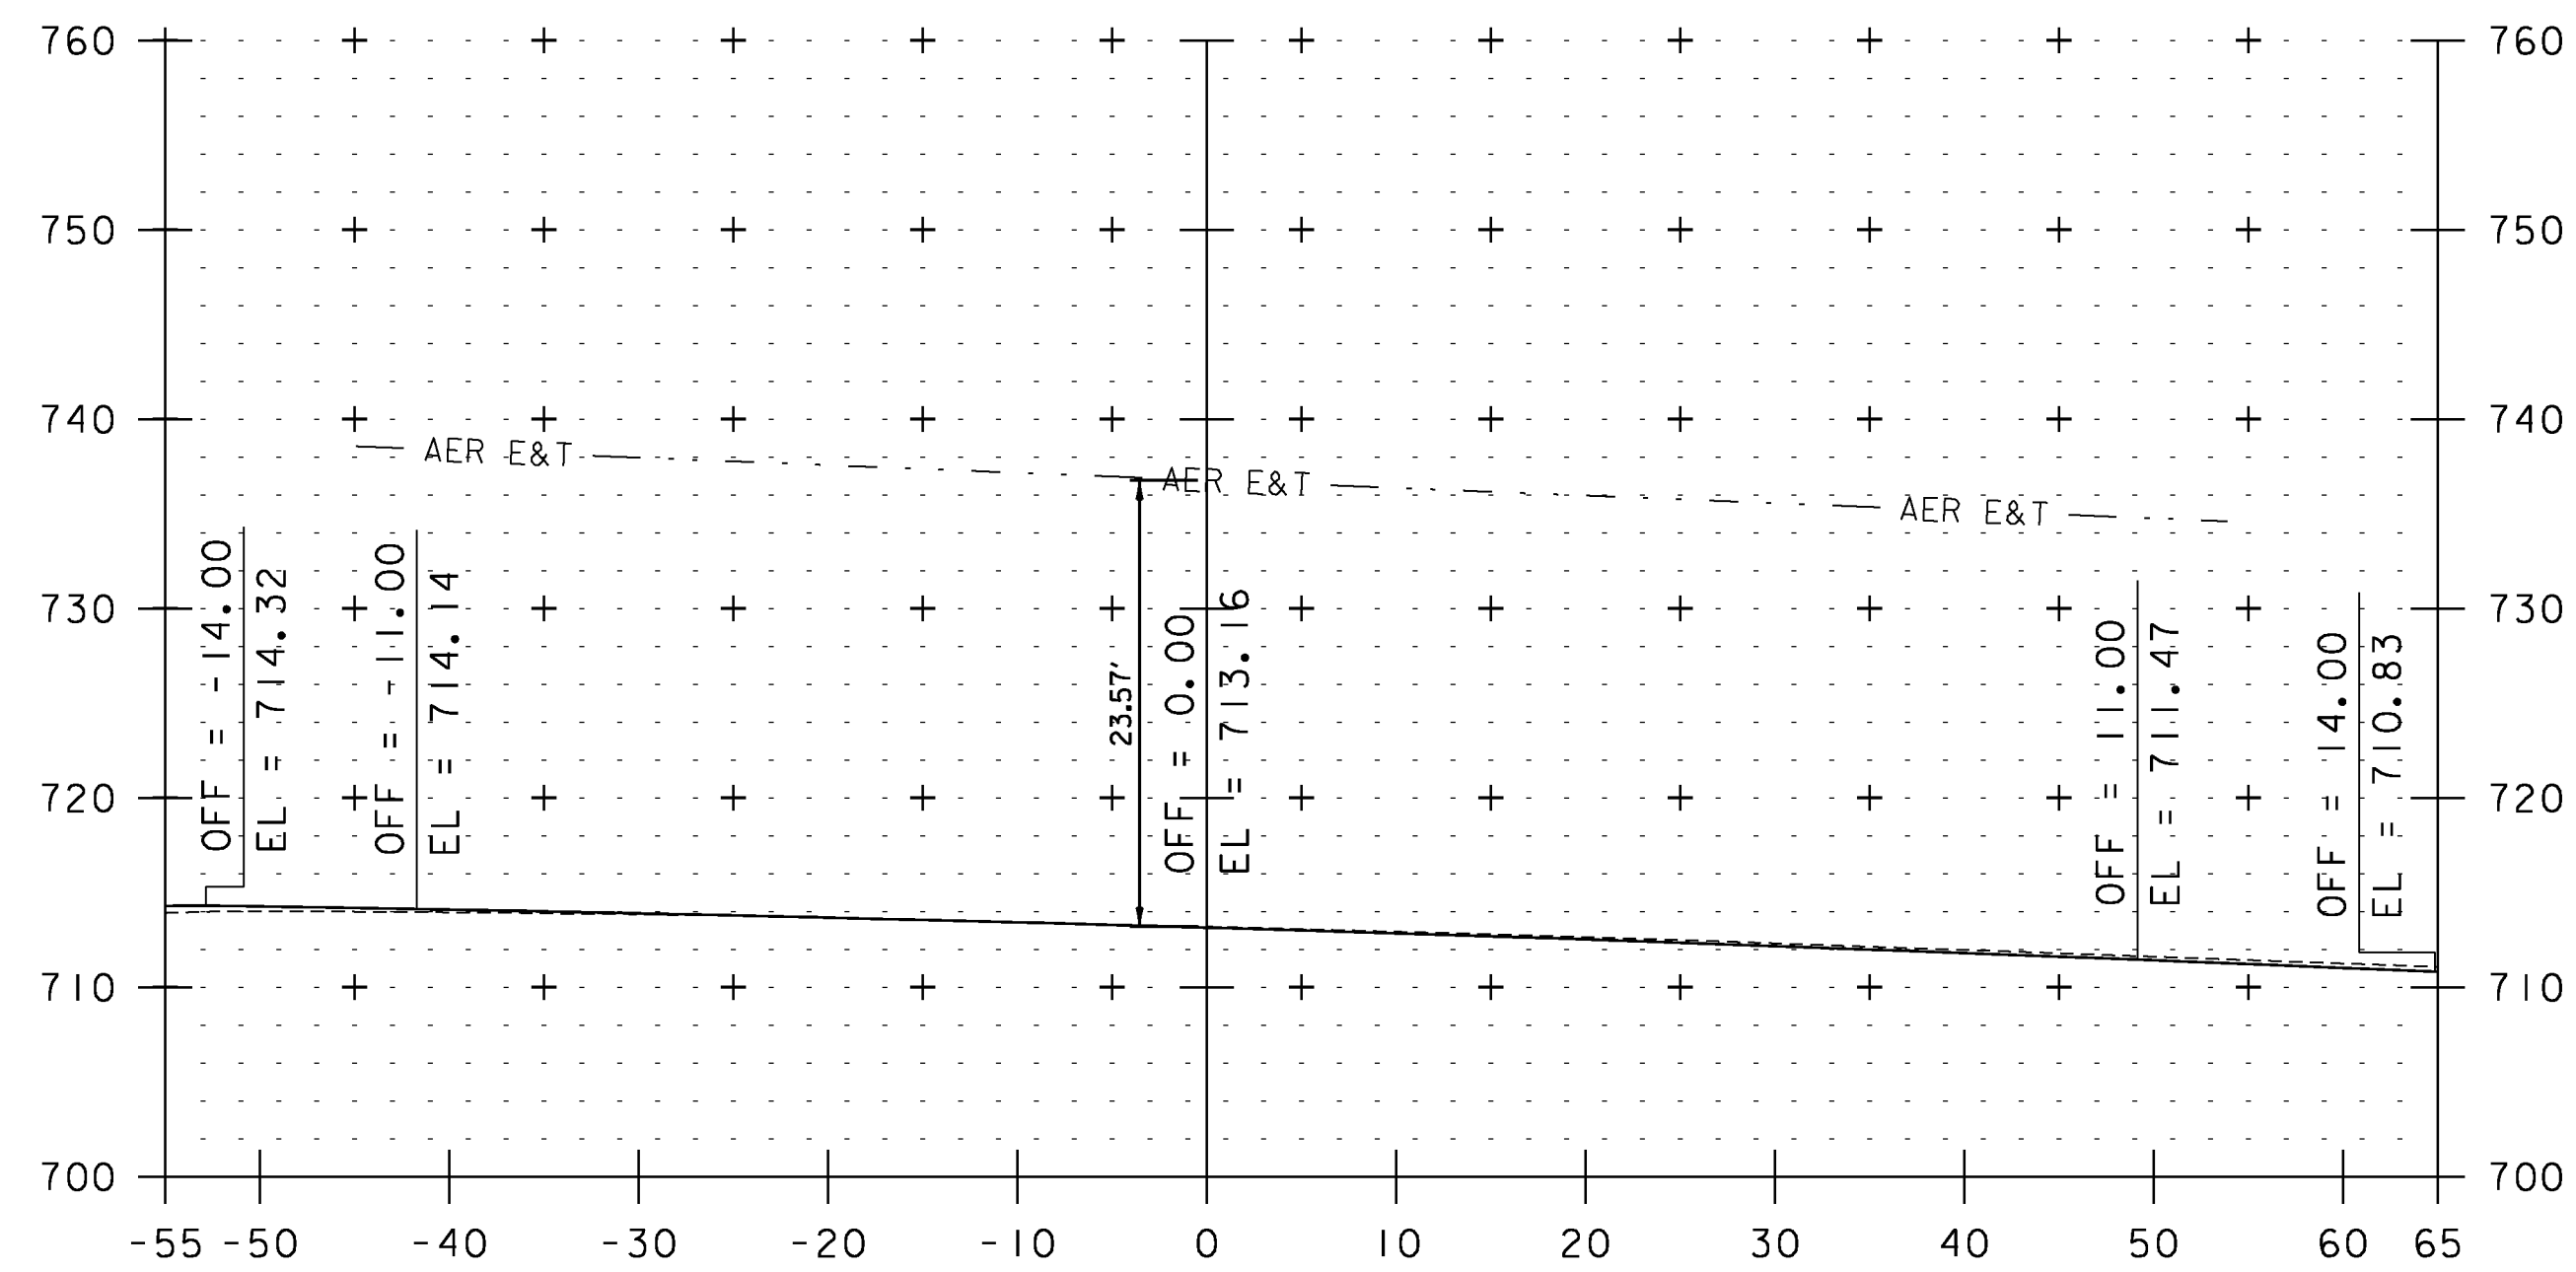


339+30

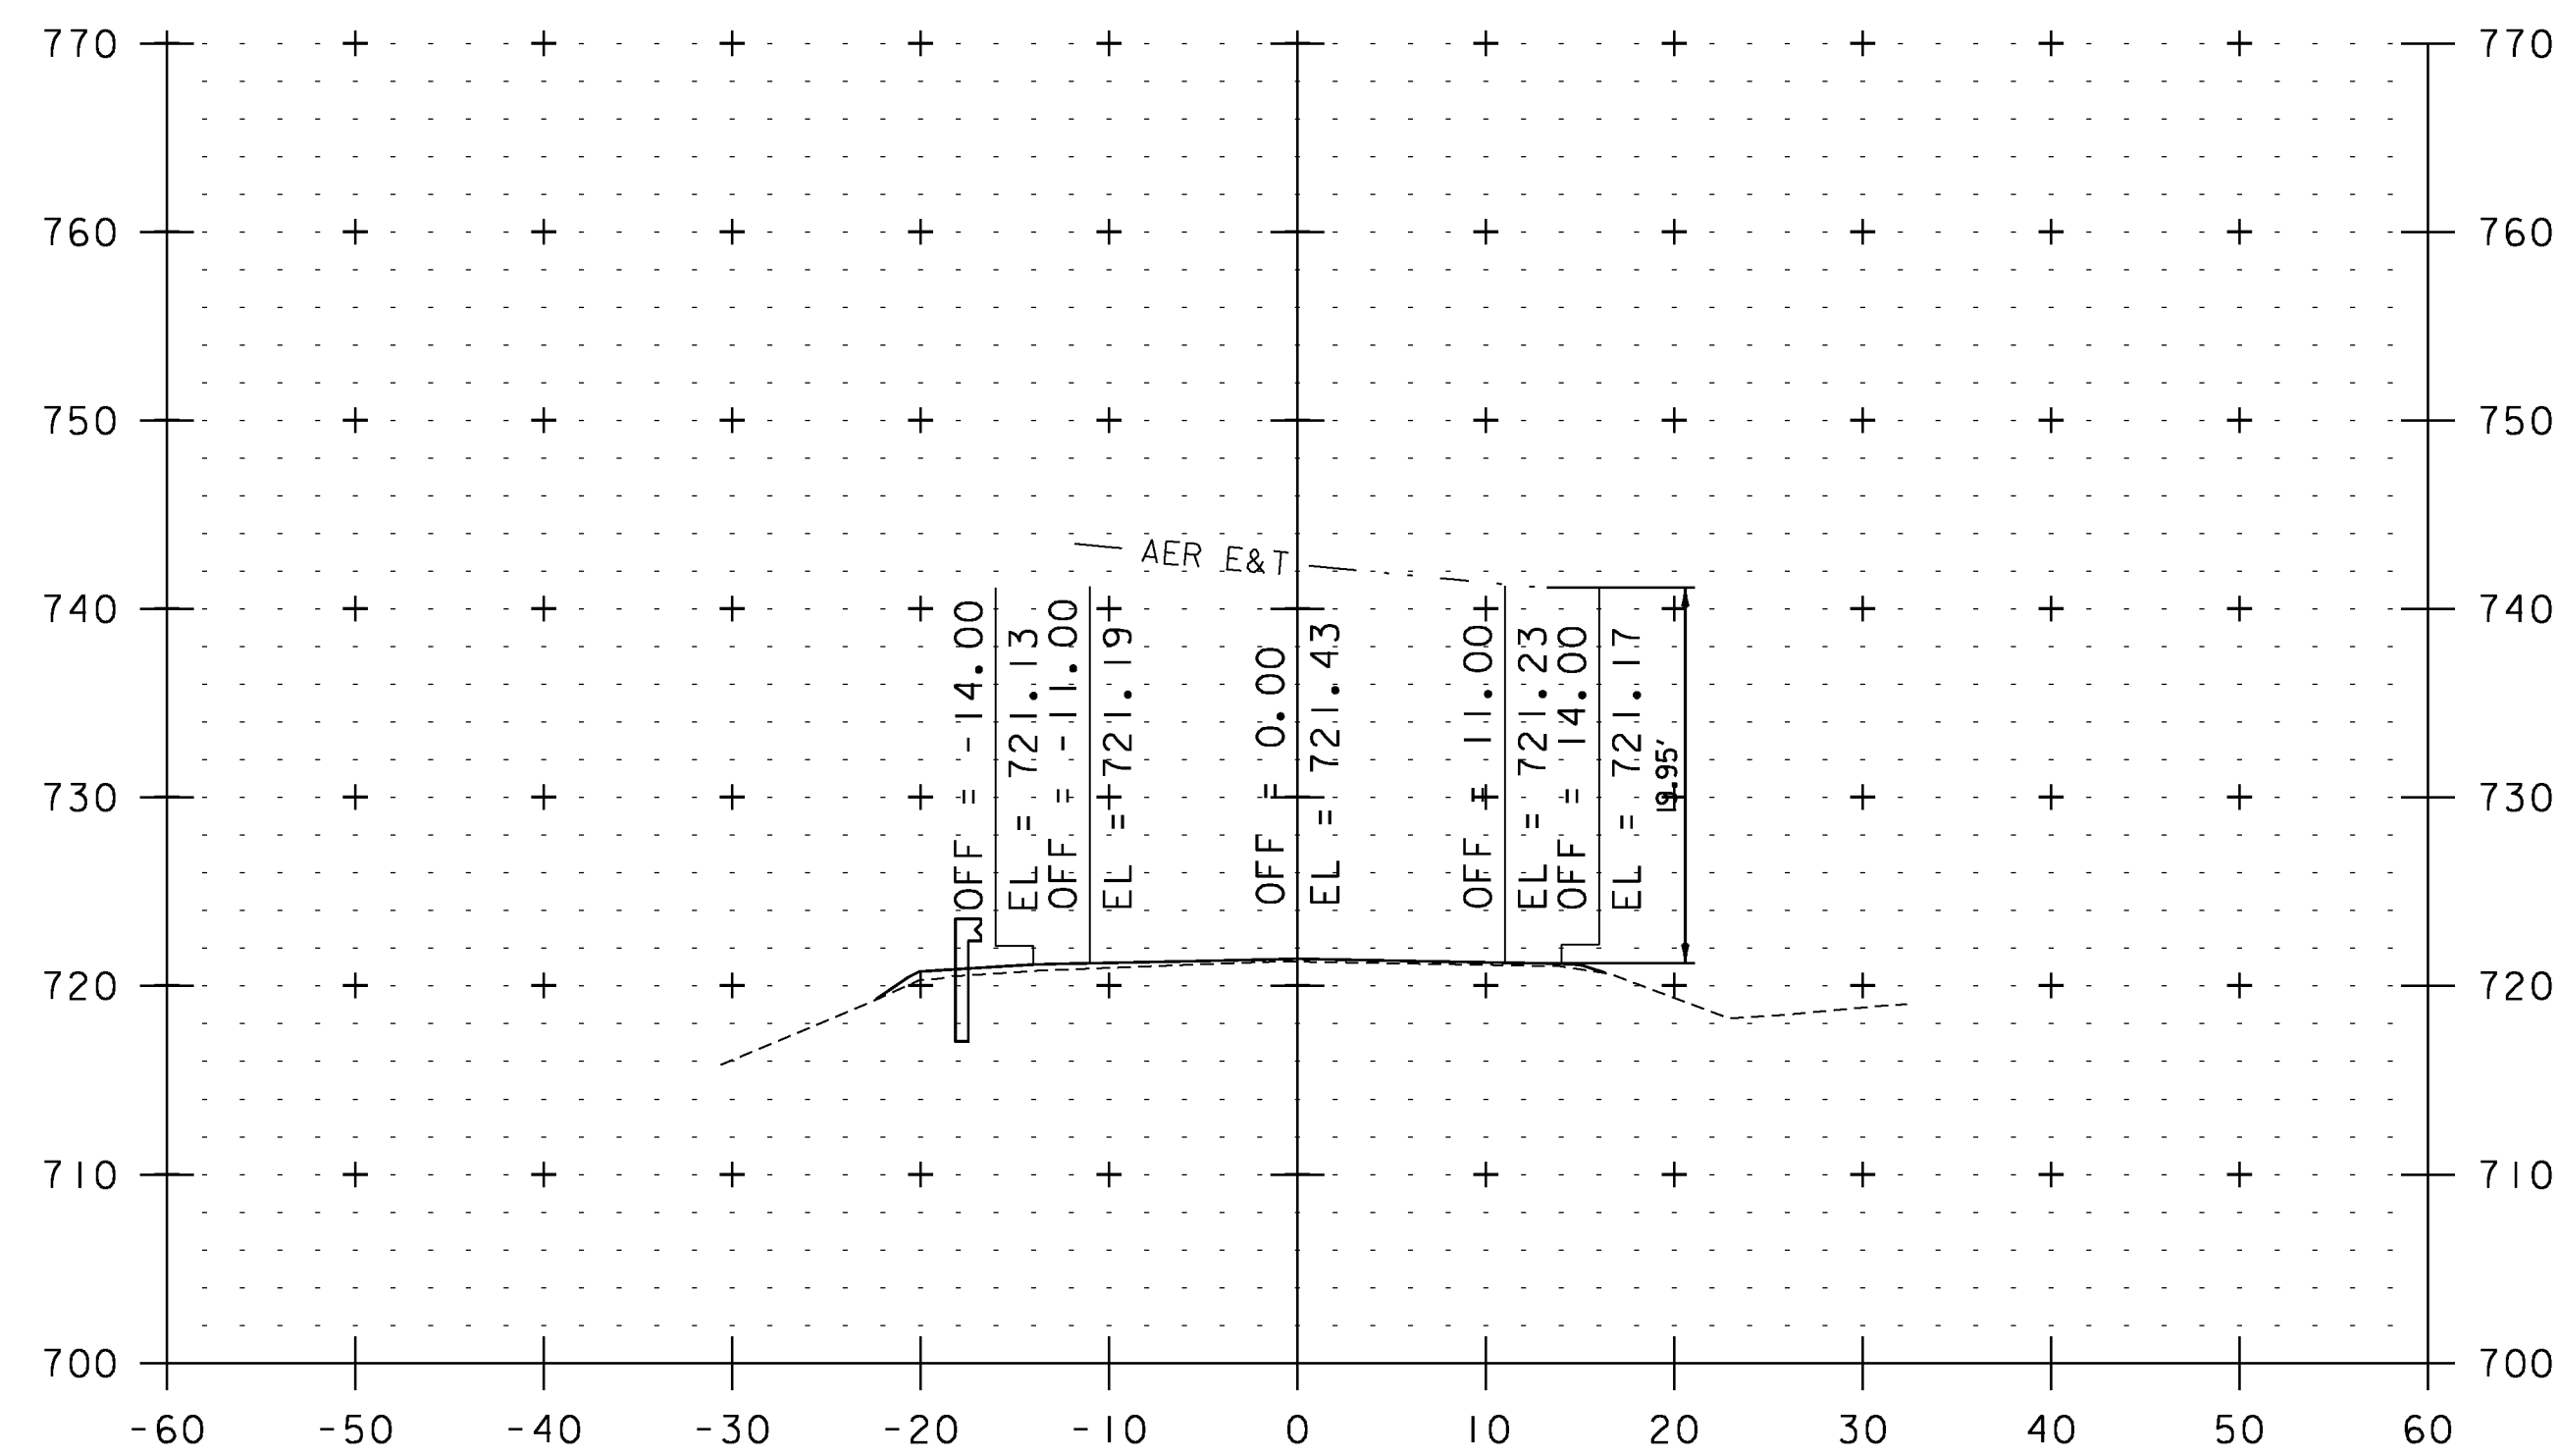

330+82

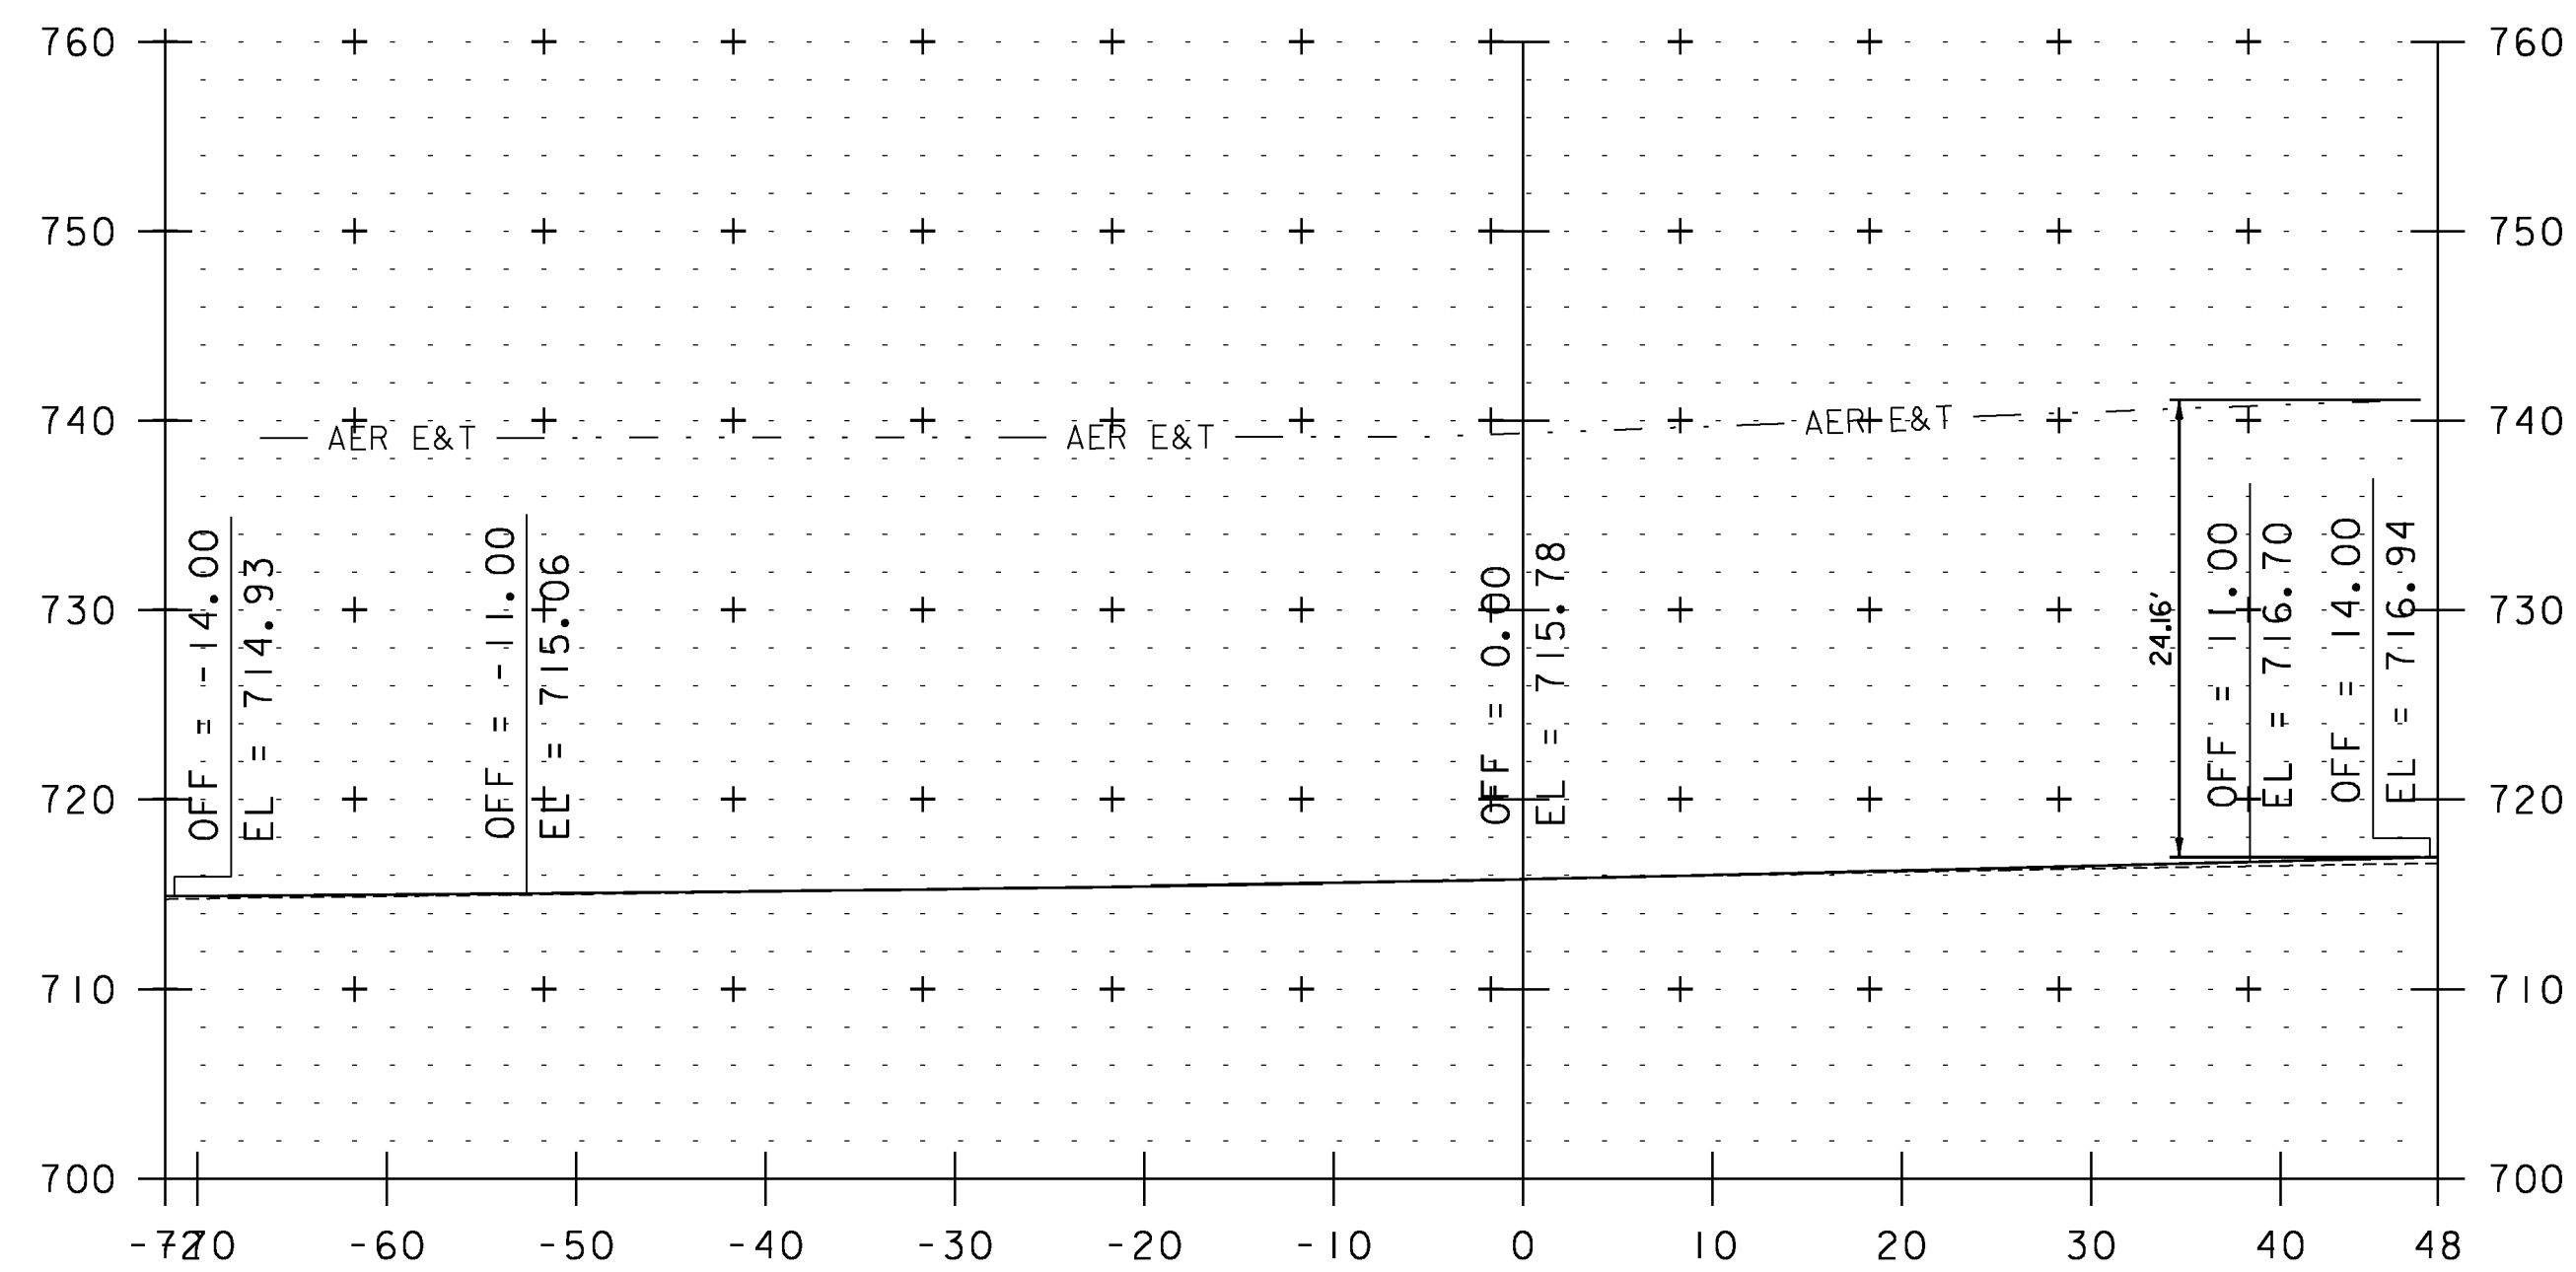

336+60

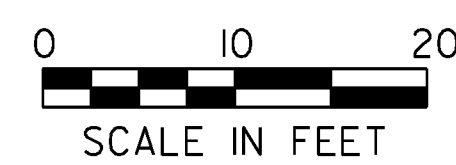

STA. 330+82 TO STA. 339+30

**UTILITY CROSS SECTION SHEET 16**

PROJECT NAME: WEATHERSFIELD	PLOT DATE: 2/7/2013
PROJECT NUMBER: STP 2913(I)	DRAWN BY: JLS
FILE NAME: I0c228	CHECKED BY: PTS
PROJECT LEADER: PTS	SHEET 198 OF 234
DESIGNED BY: NLL	
IPARM FILE NAME: pI0c228_198	