




360+61

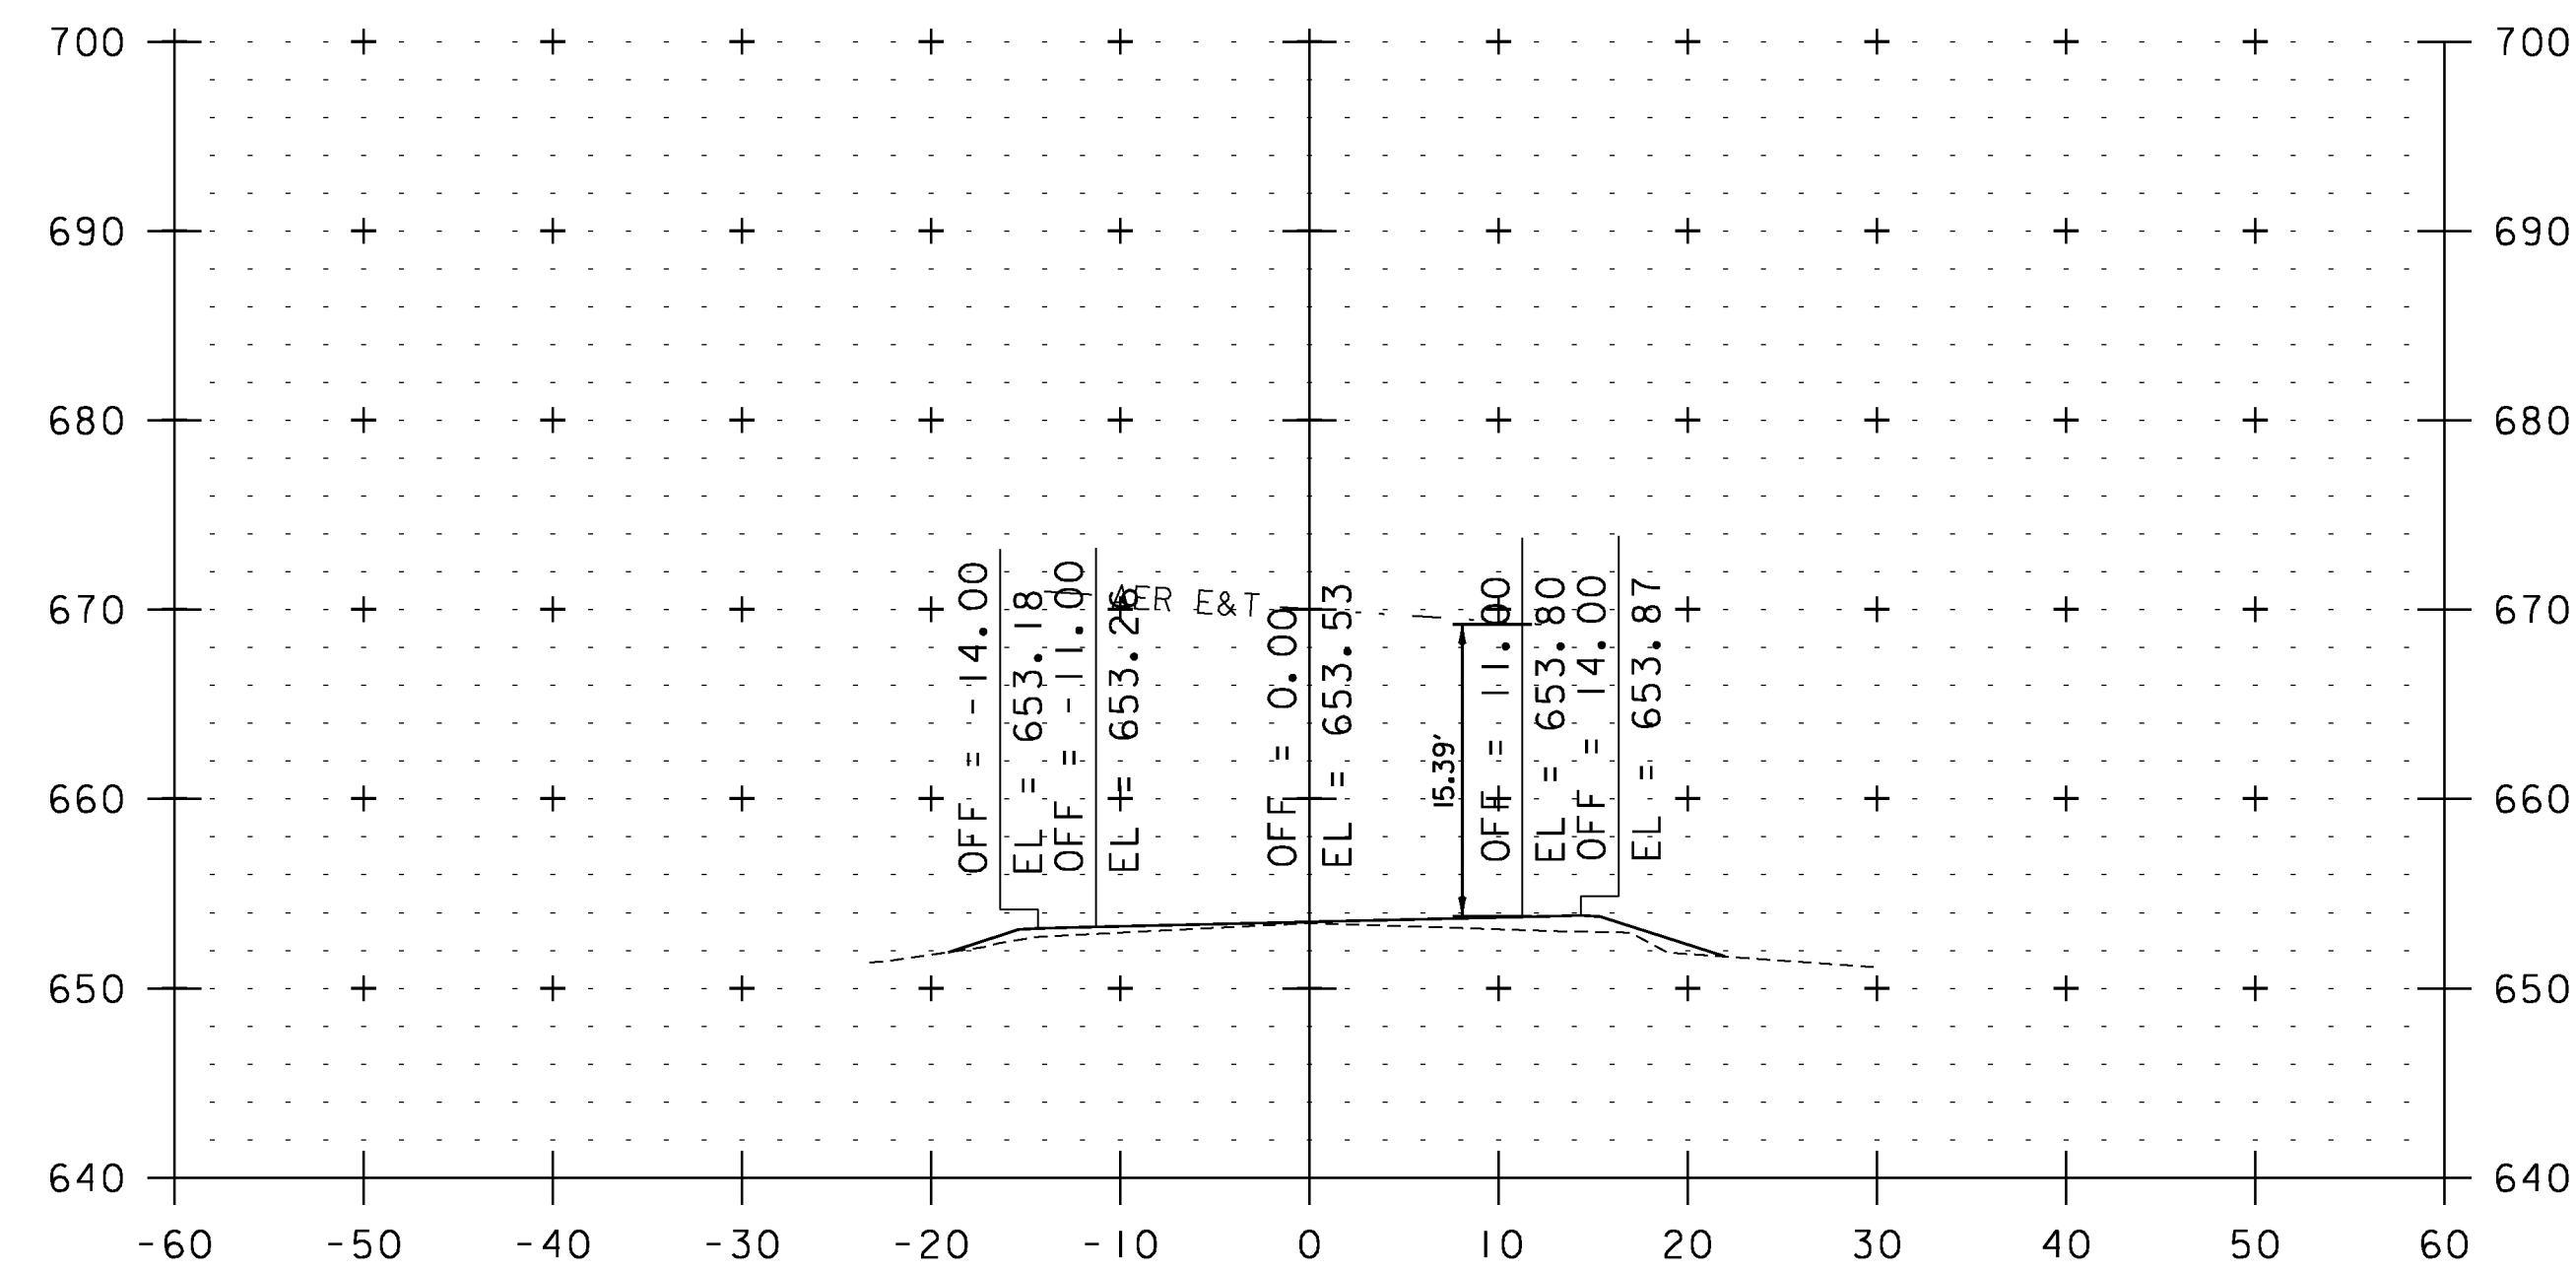


357+00

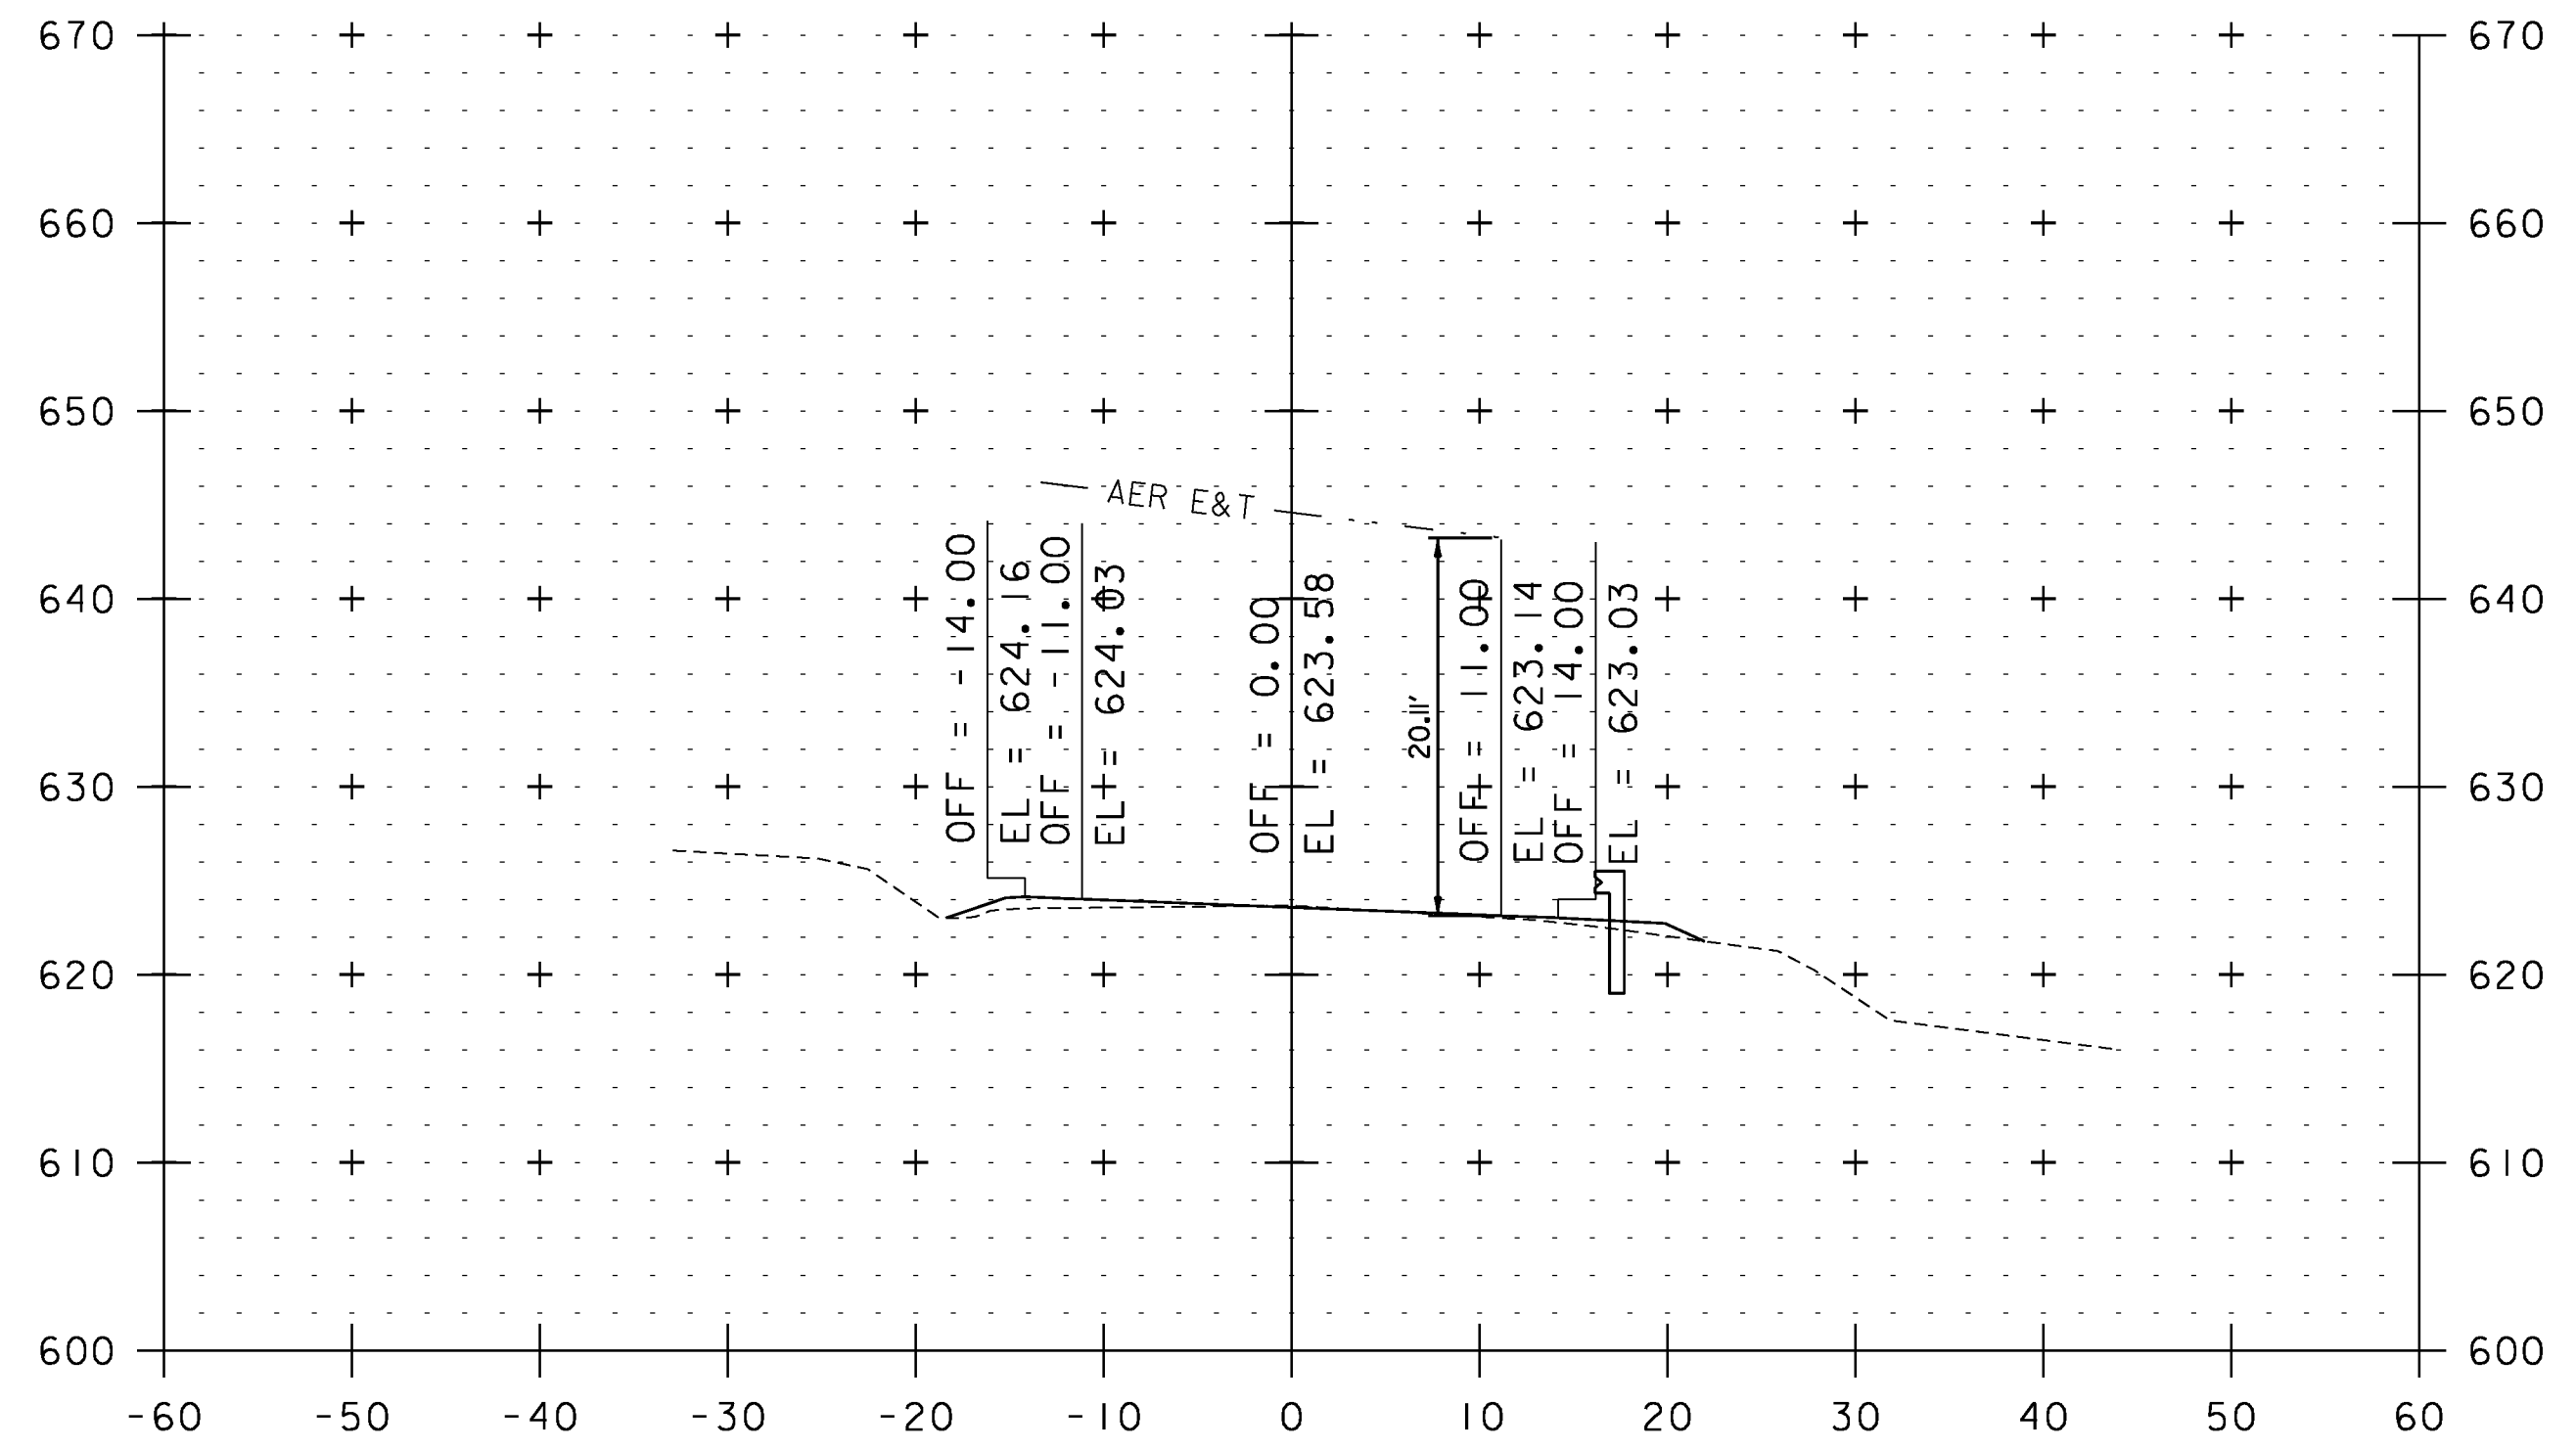

368+83

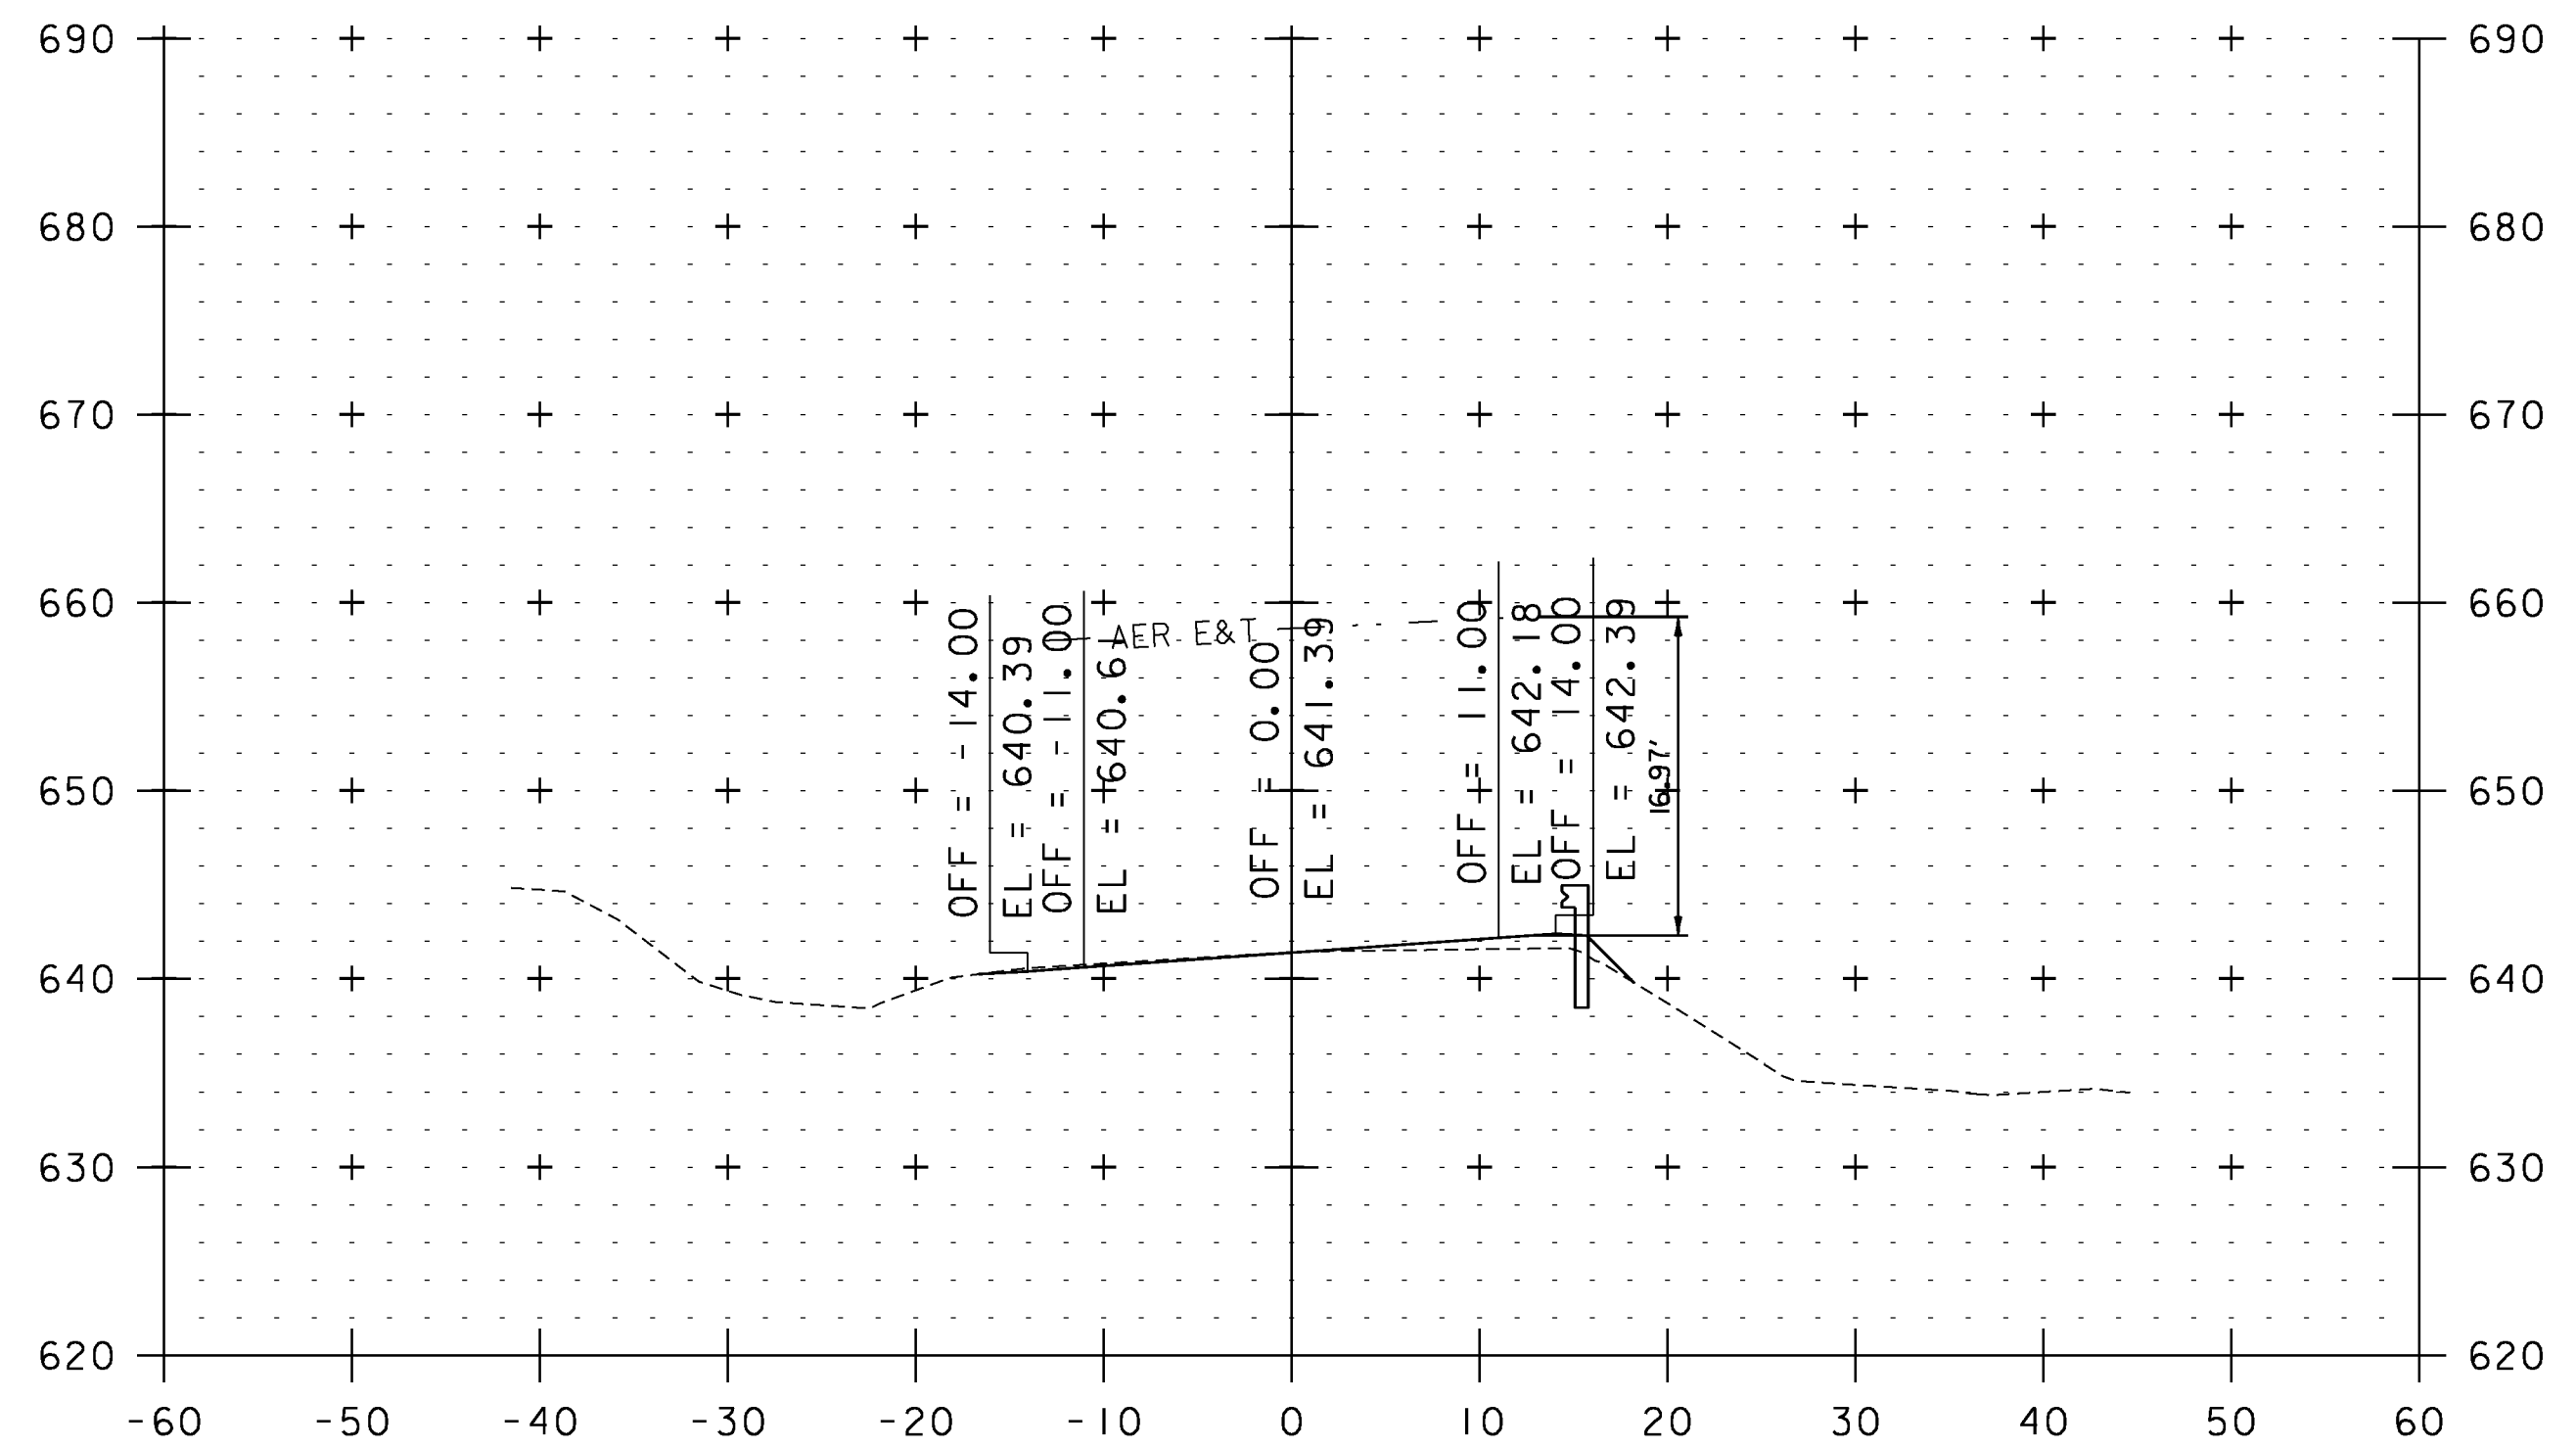

362+78

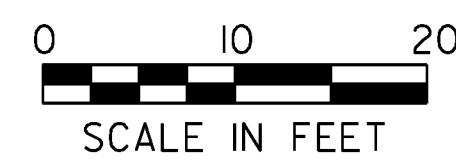

STA. 357+00 TO STA. 368+83

UTILITY CROSS SECTION SHEET 18

PROJECT NAME: WEATHERSFIELD

PROJECT NUMBER: STP 2913(I)

FILE NAME: I0c228

PROJECT LEADER: PTS

DESIGNED BY: NLL

IPARM FILE NAME: pI0c228_200

PLOT DATE: 2/7/2013

DRAWN BY: JLS

CHECKED BY: PTS

SHEET 200 OF 234