




378+37

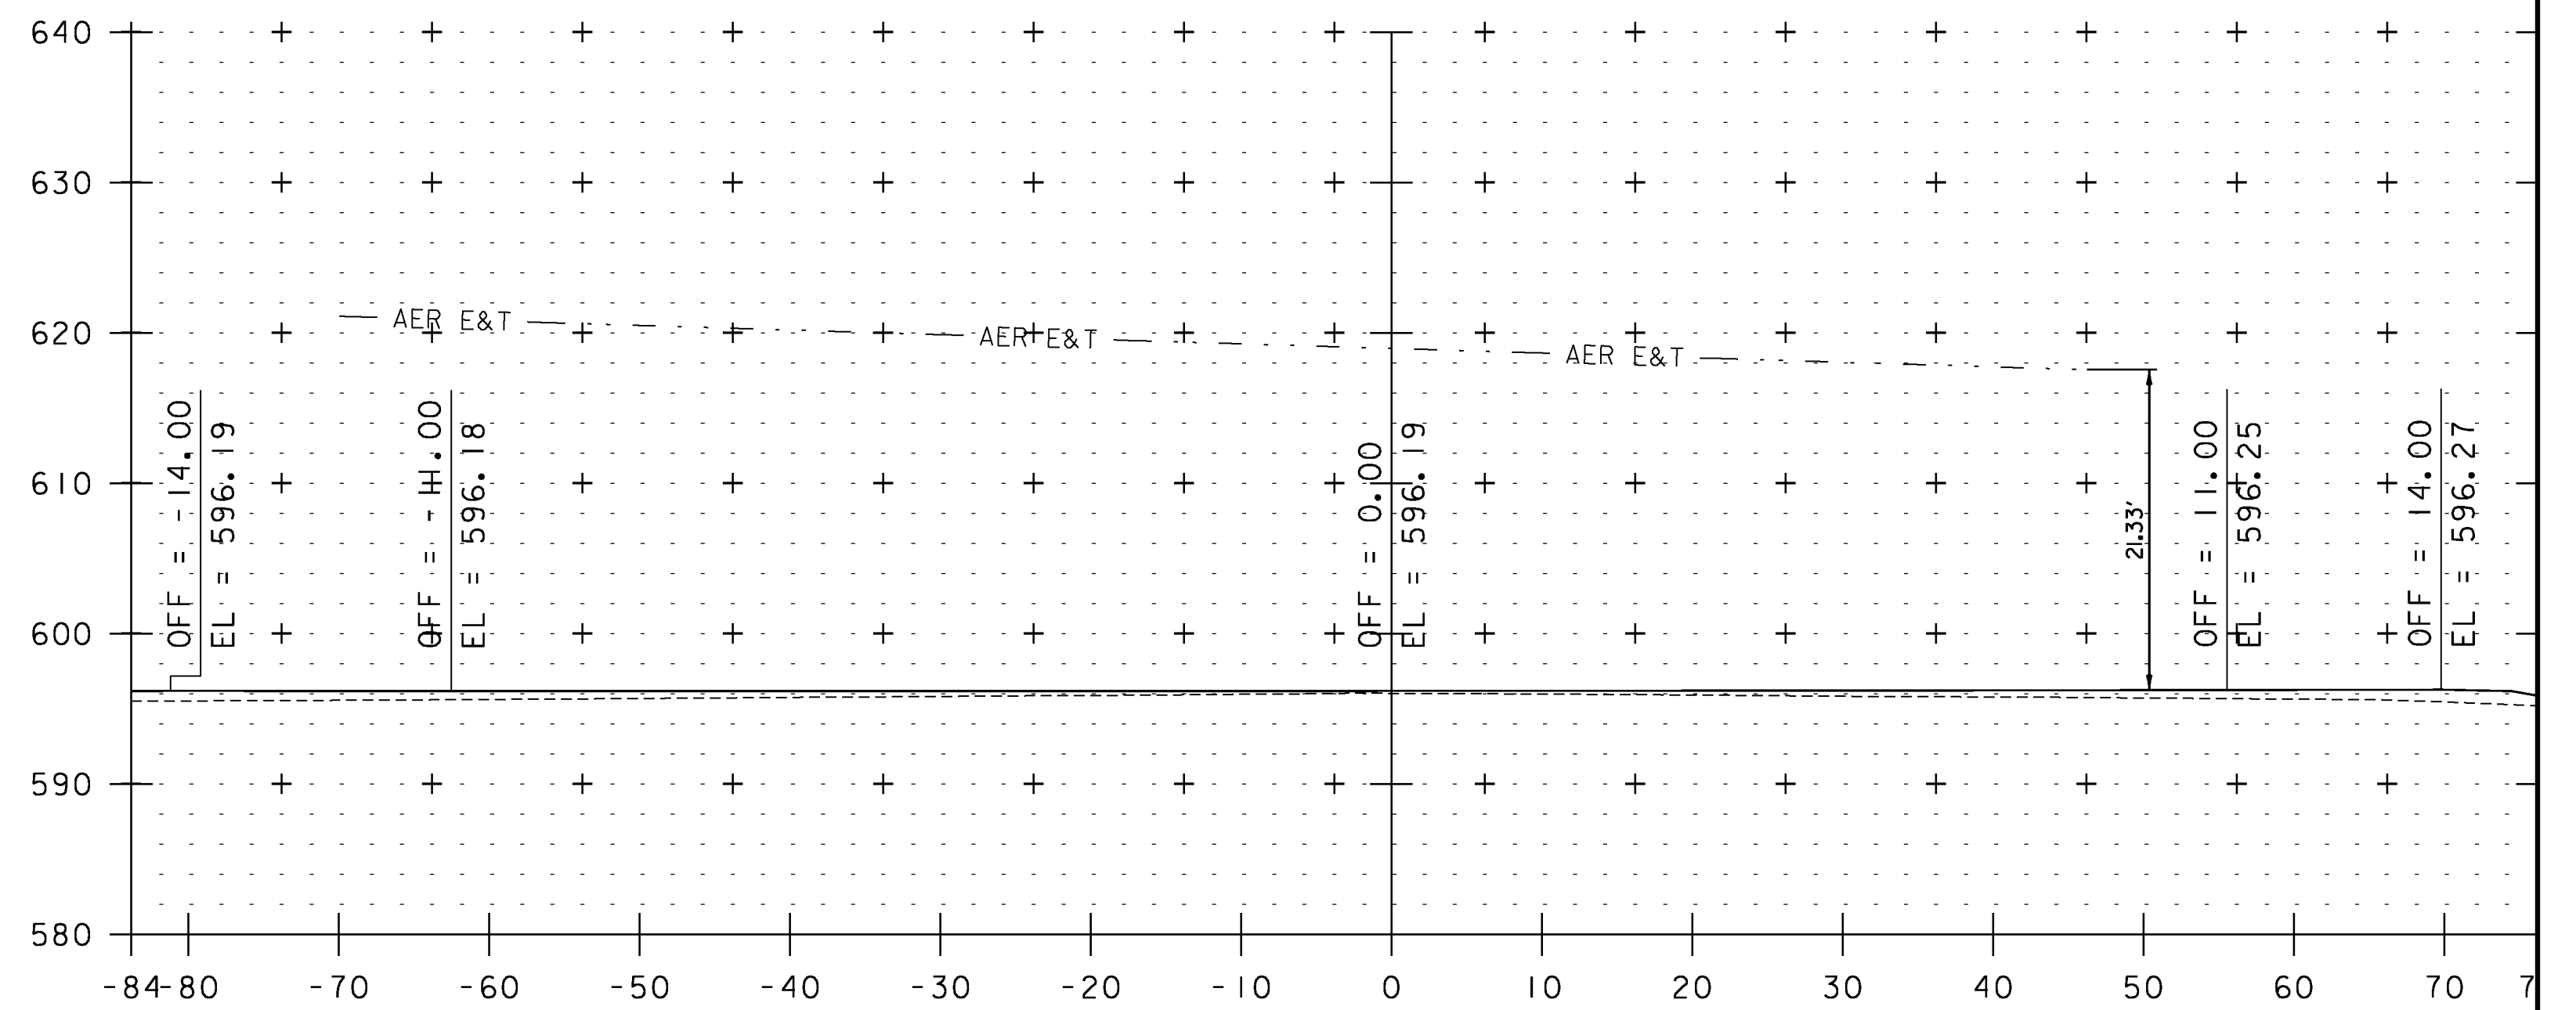

386+44

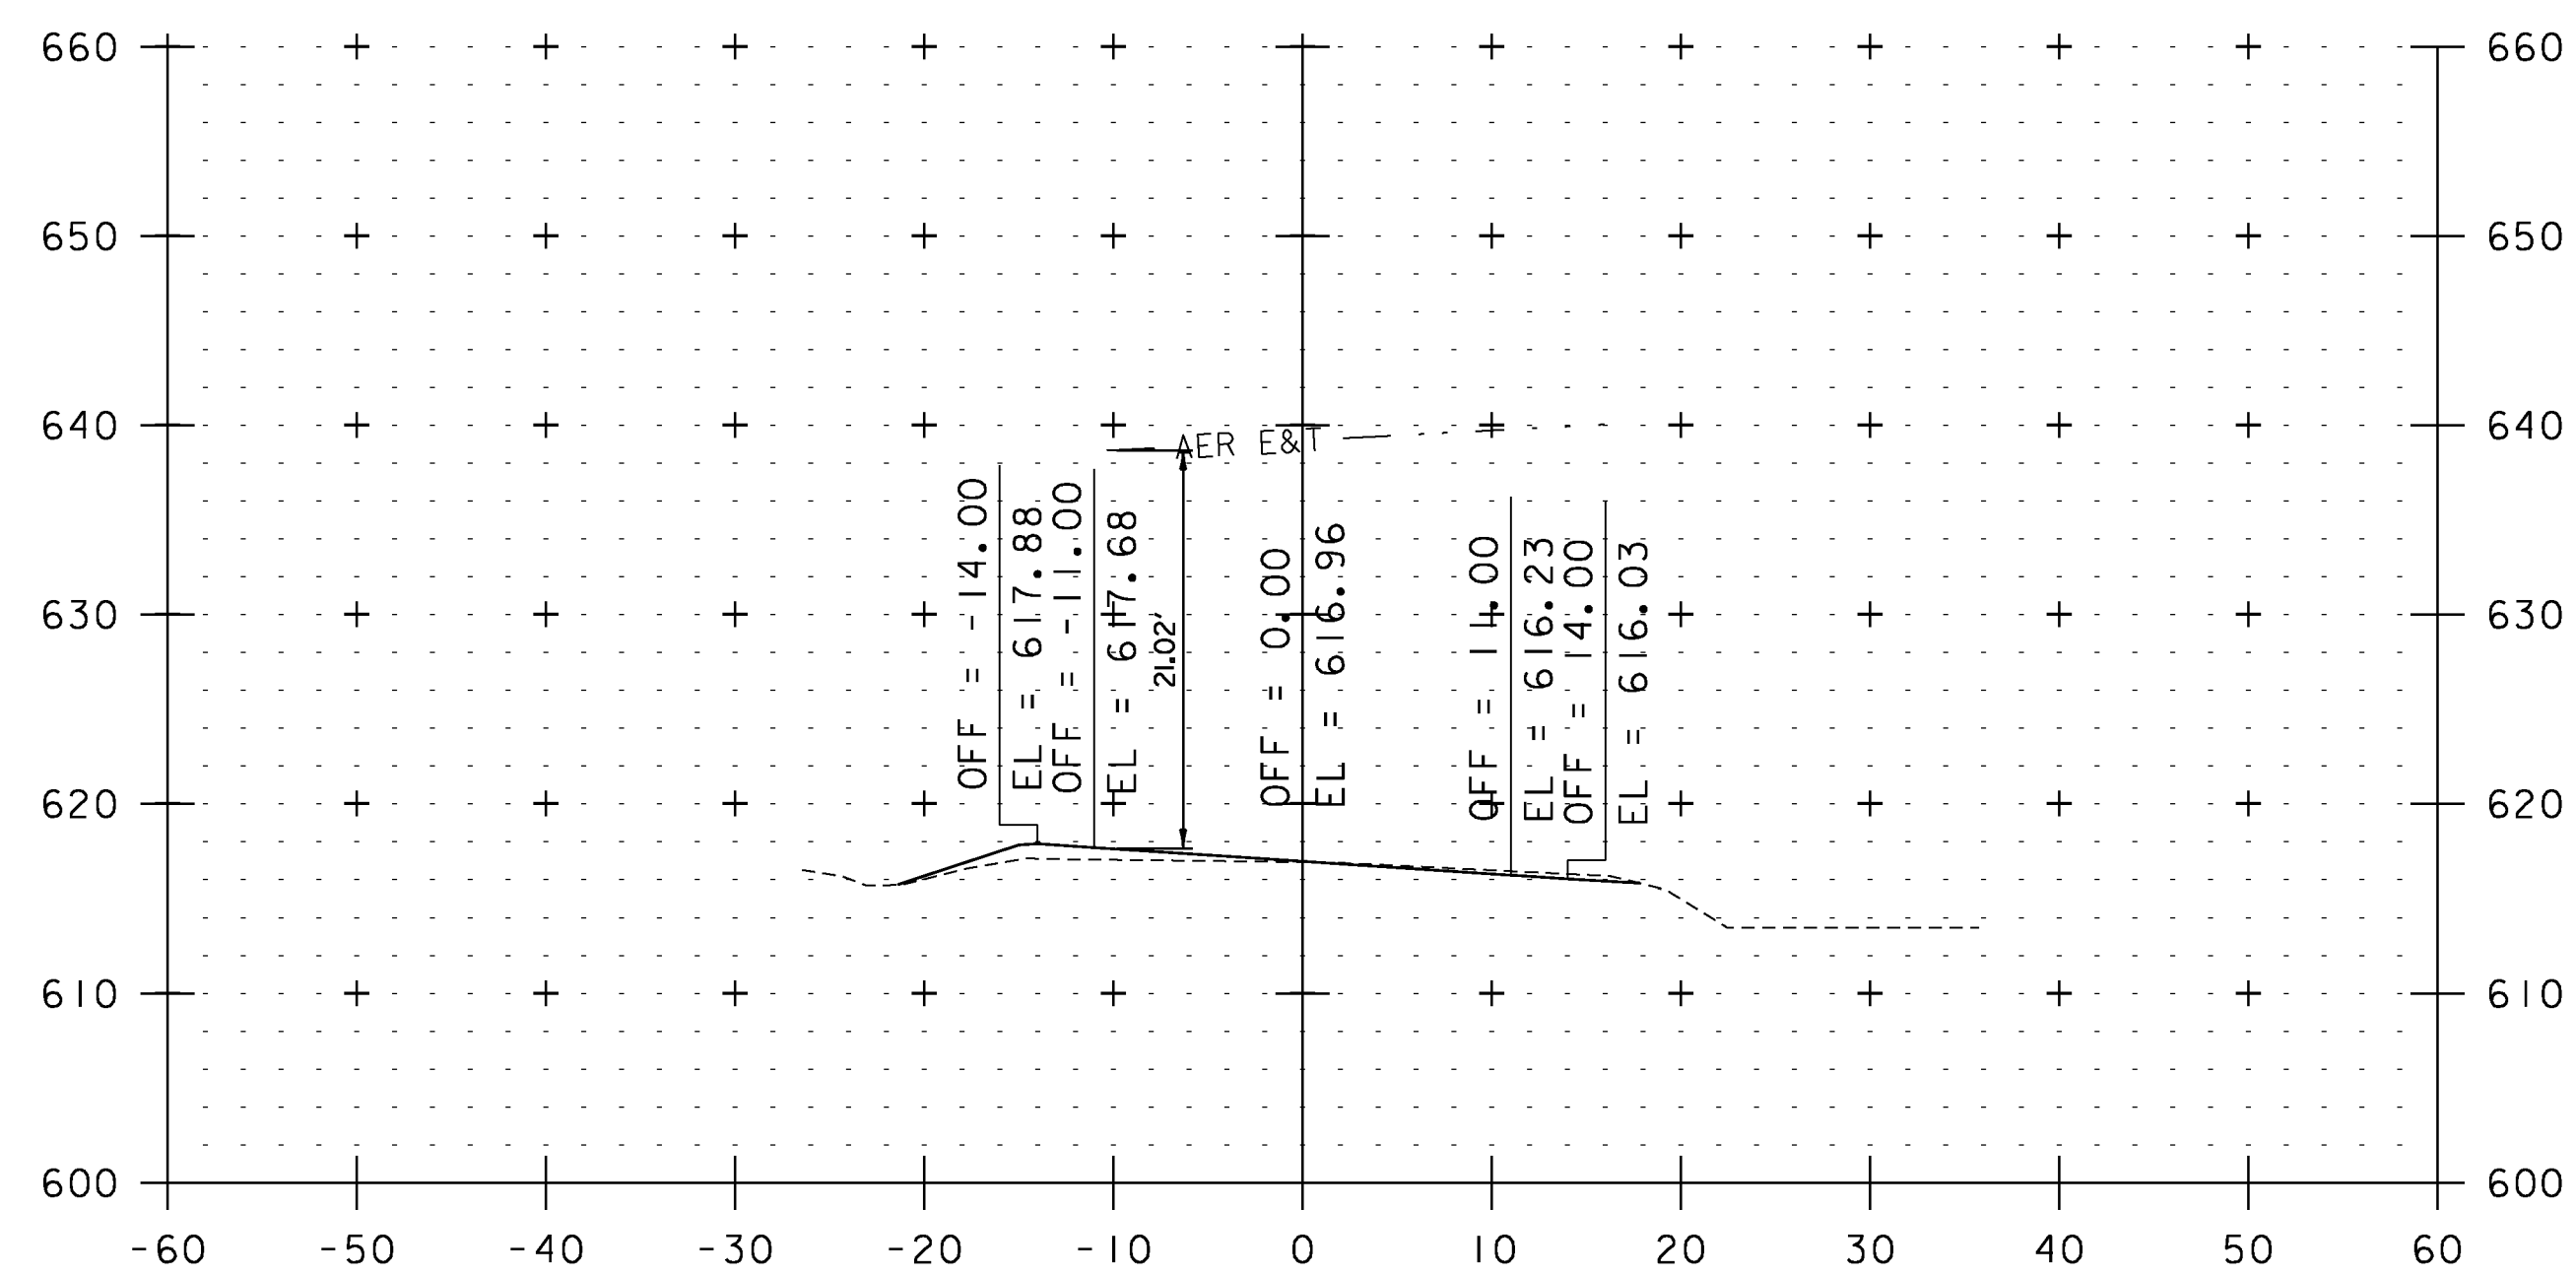


371+59

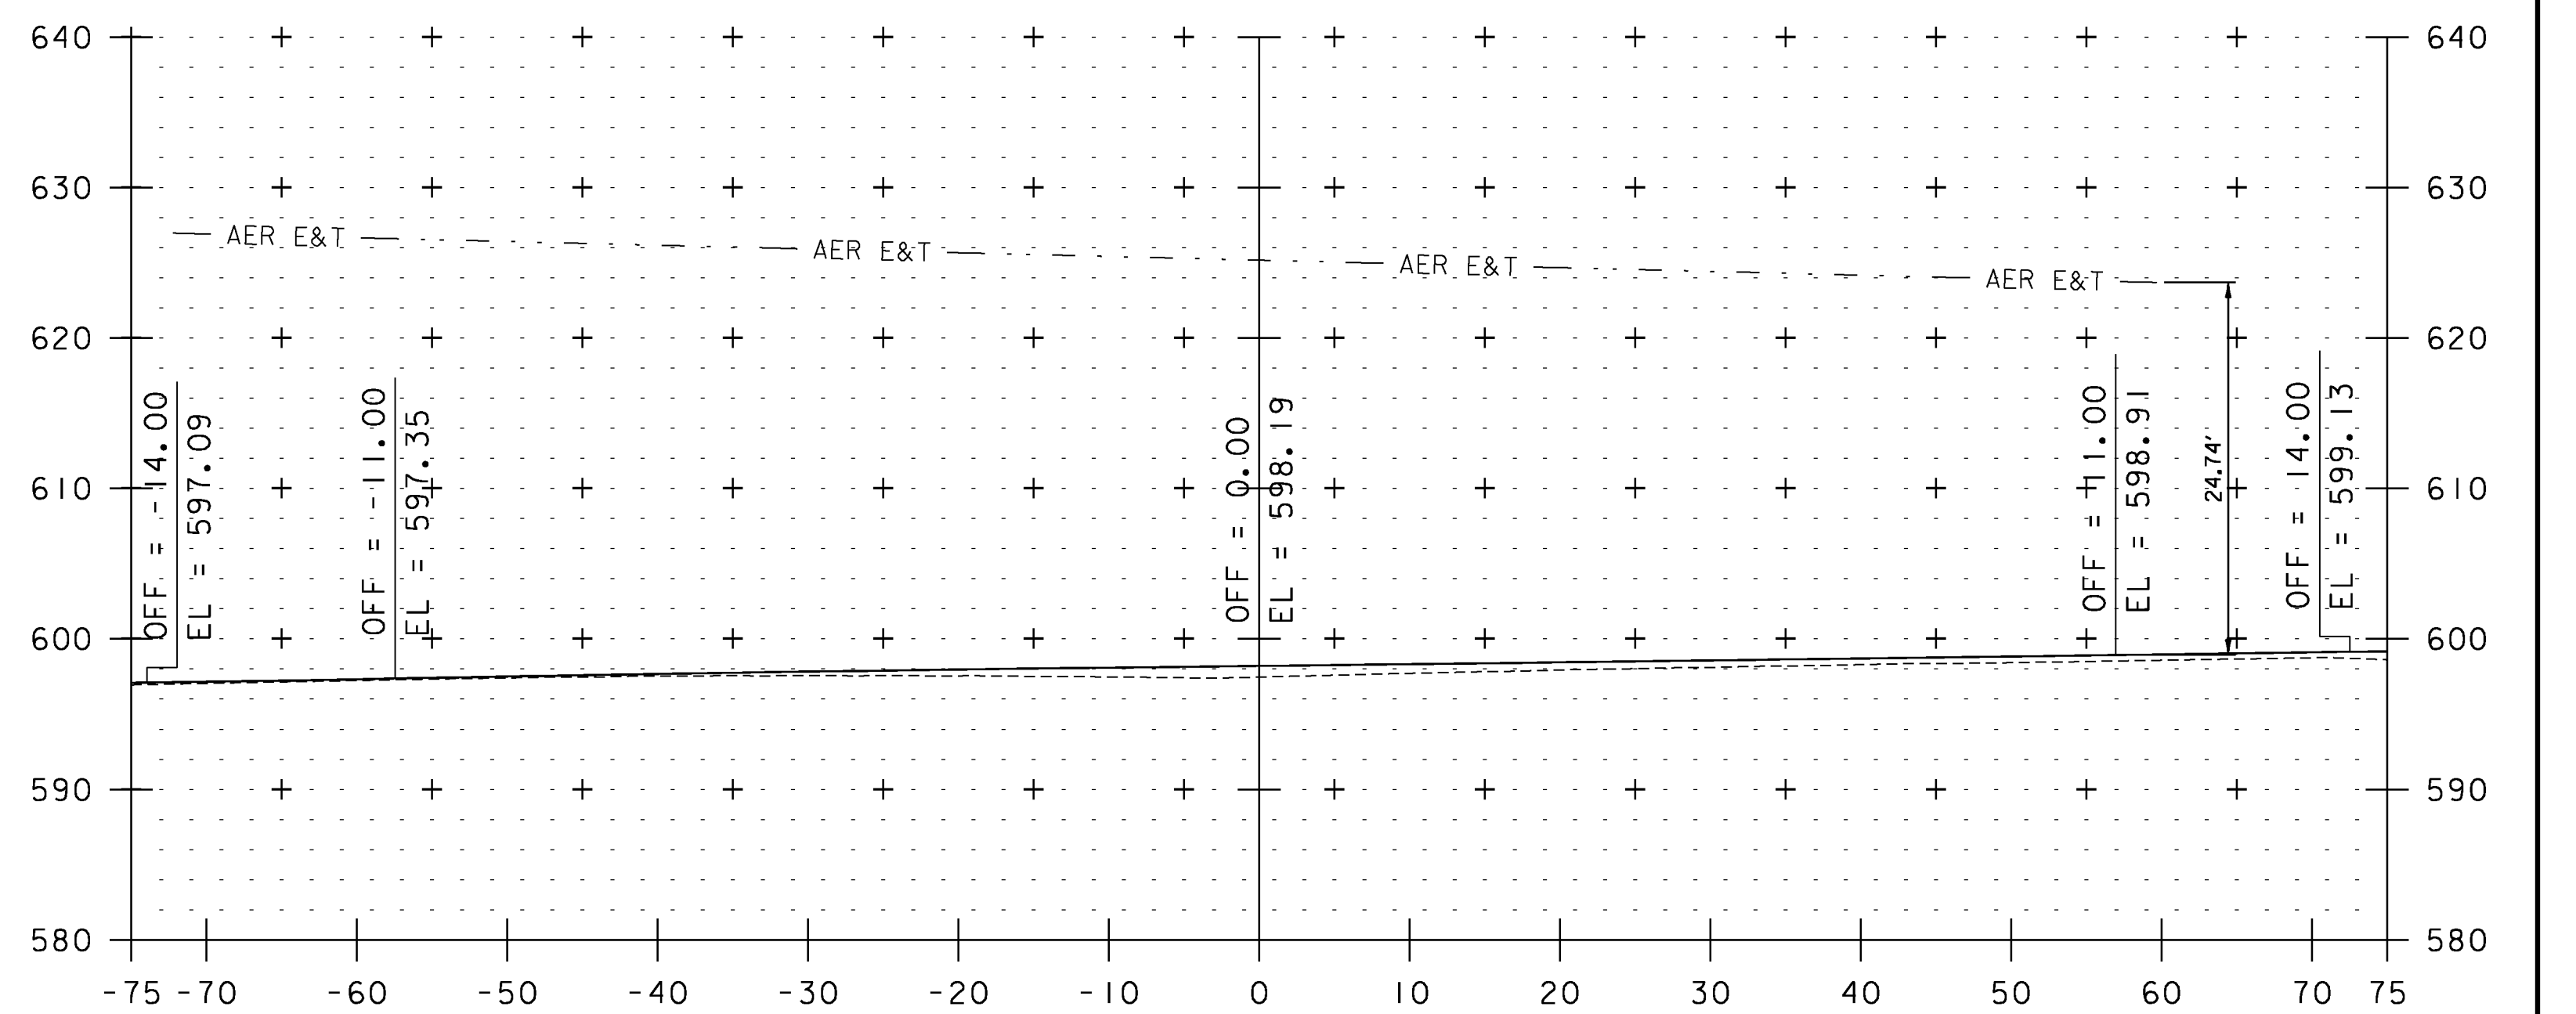

383+67

UTILITY CROSS SECTION SHEET 19

PROJECT NAME: WEATHERSFIELD	FILE NAME: I0c228	PLOT DATE: 2/7/2013
PROJECT NUMBER: STP 2913(I)	PROJECT LEADER: PTS	DRAWN BY: JLS
	DESIGNED BY: NLL	CHECKED BY: PTS
	IPARM FILE NAME: pI0c228_201	SHEET 201 OF 234

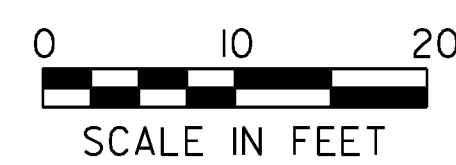

STA. 371+59 TO STA. 386+44