




421+26

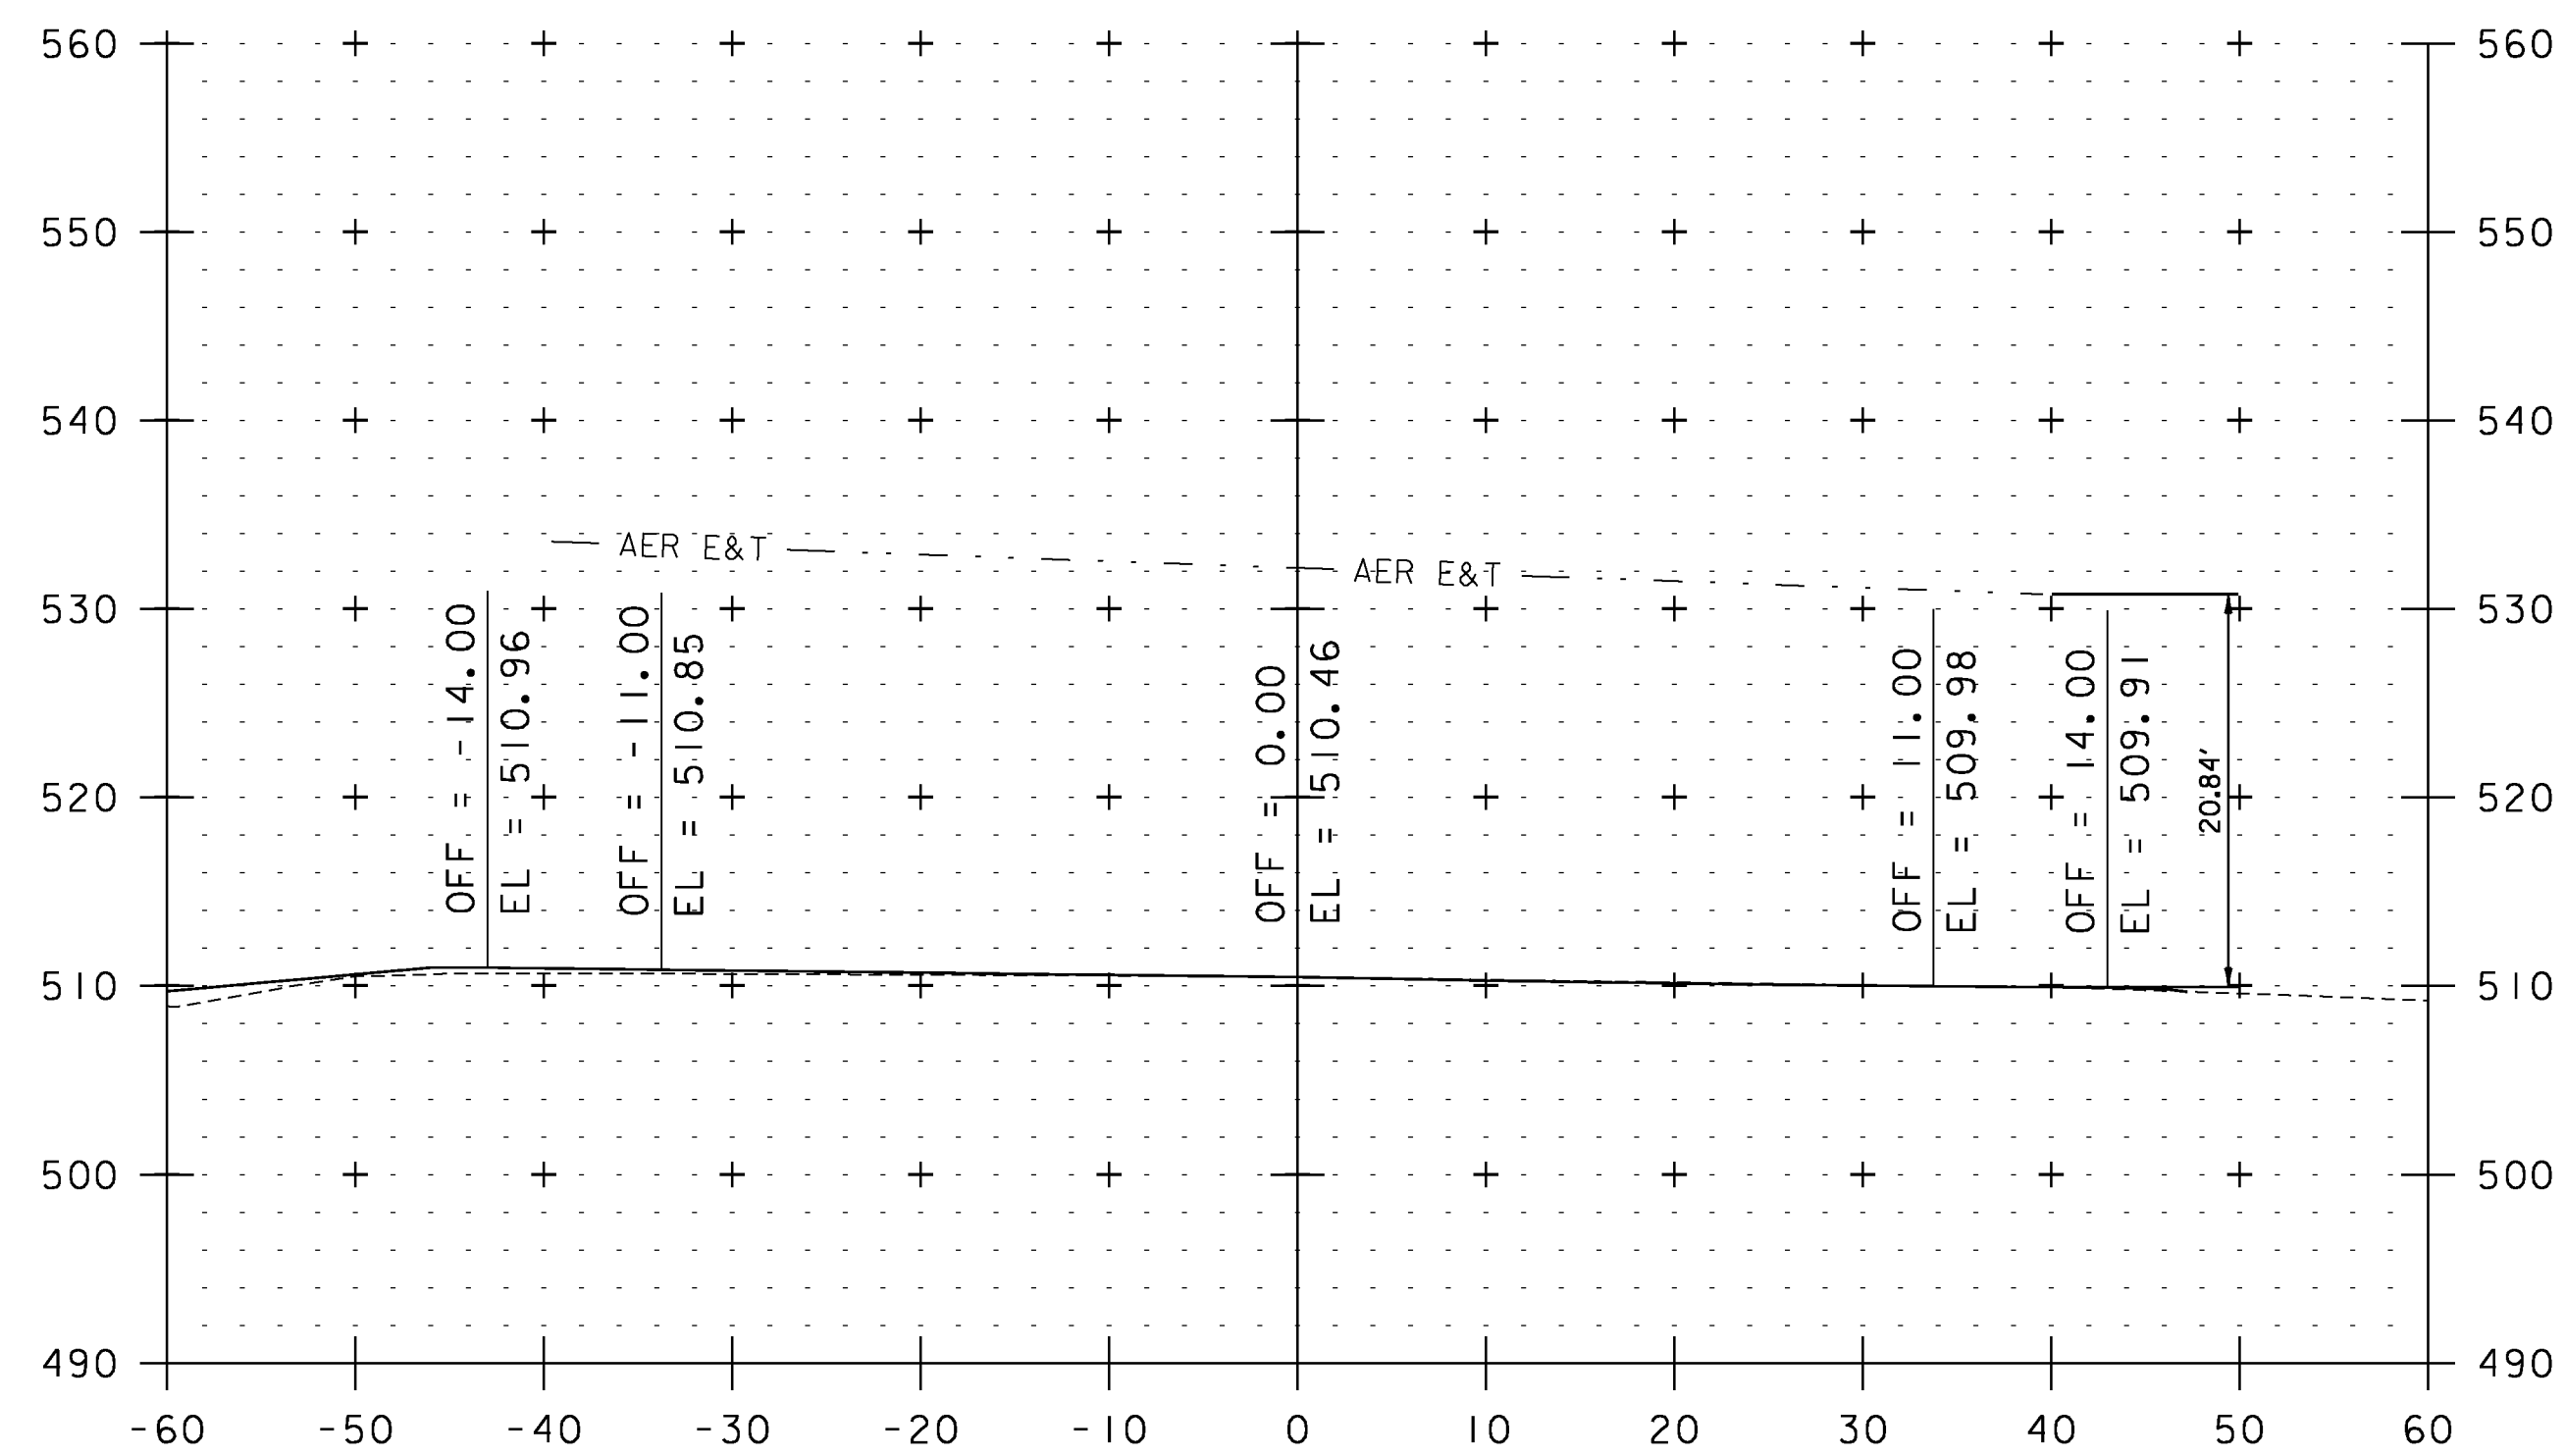

420+20

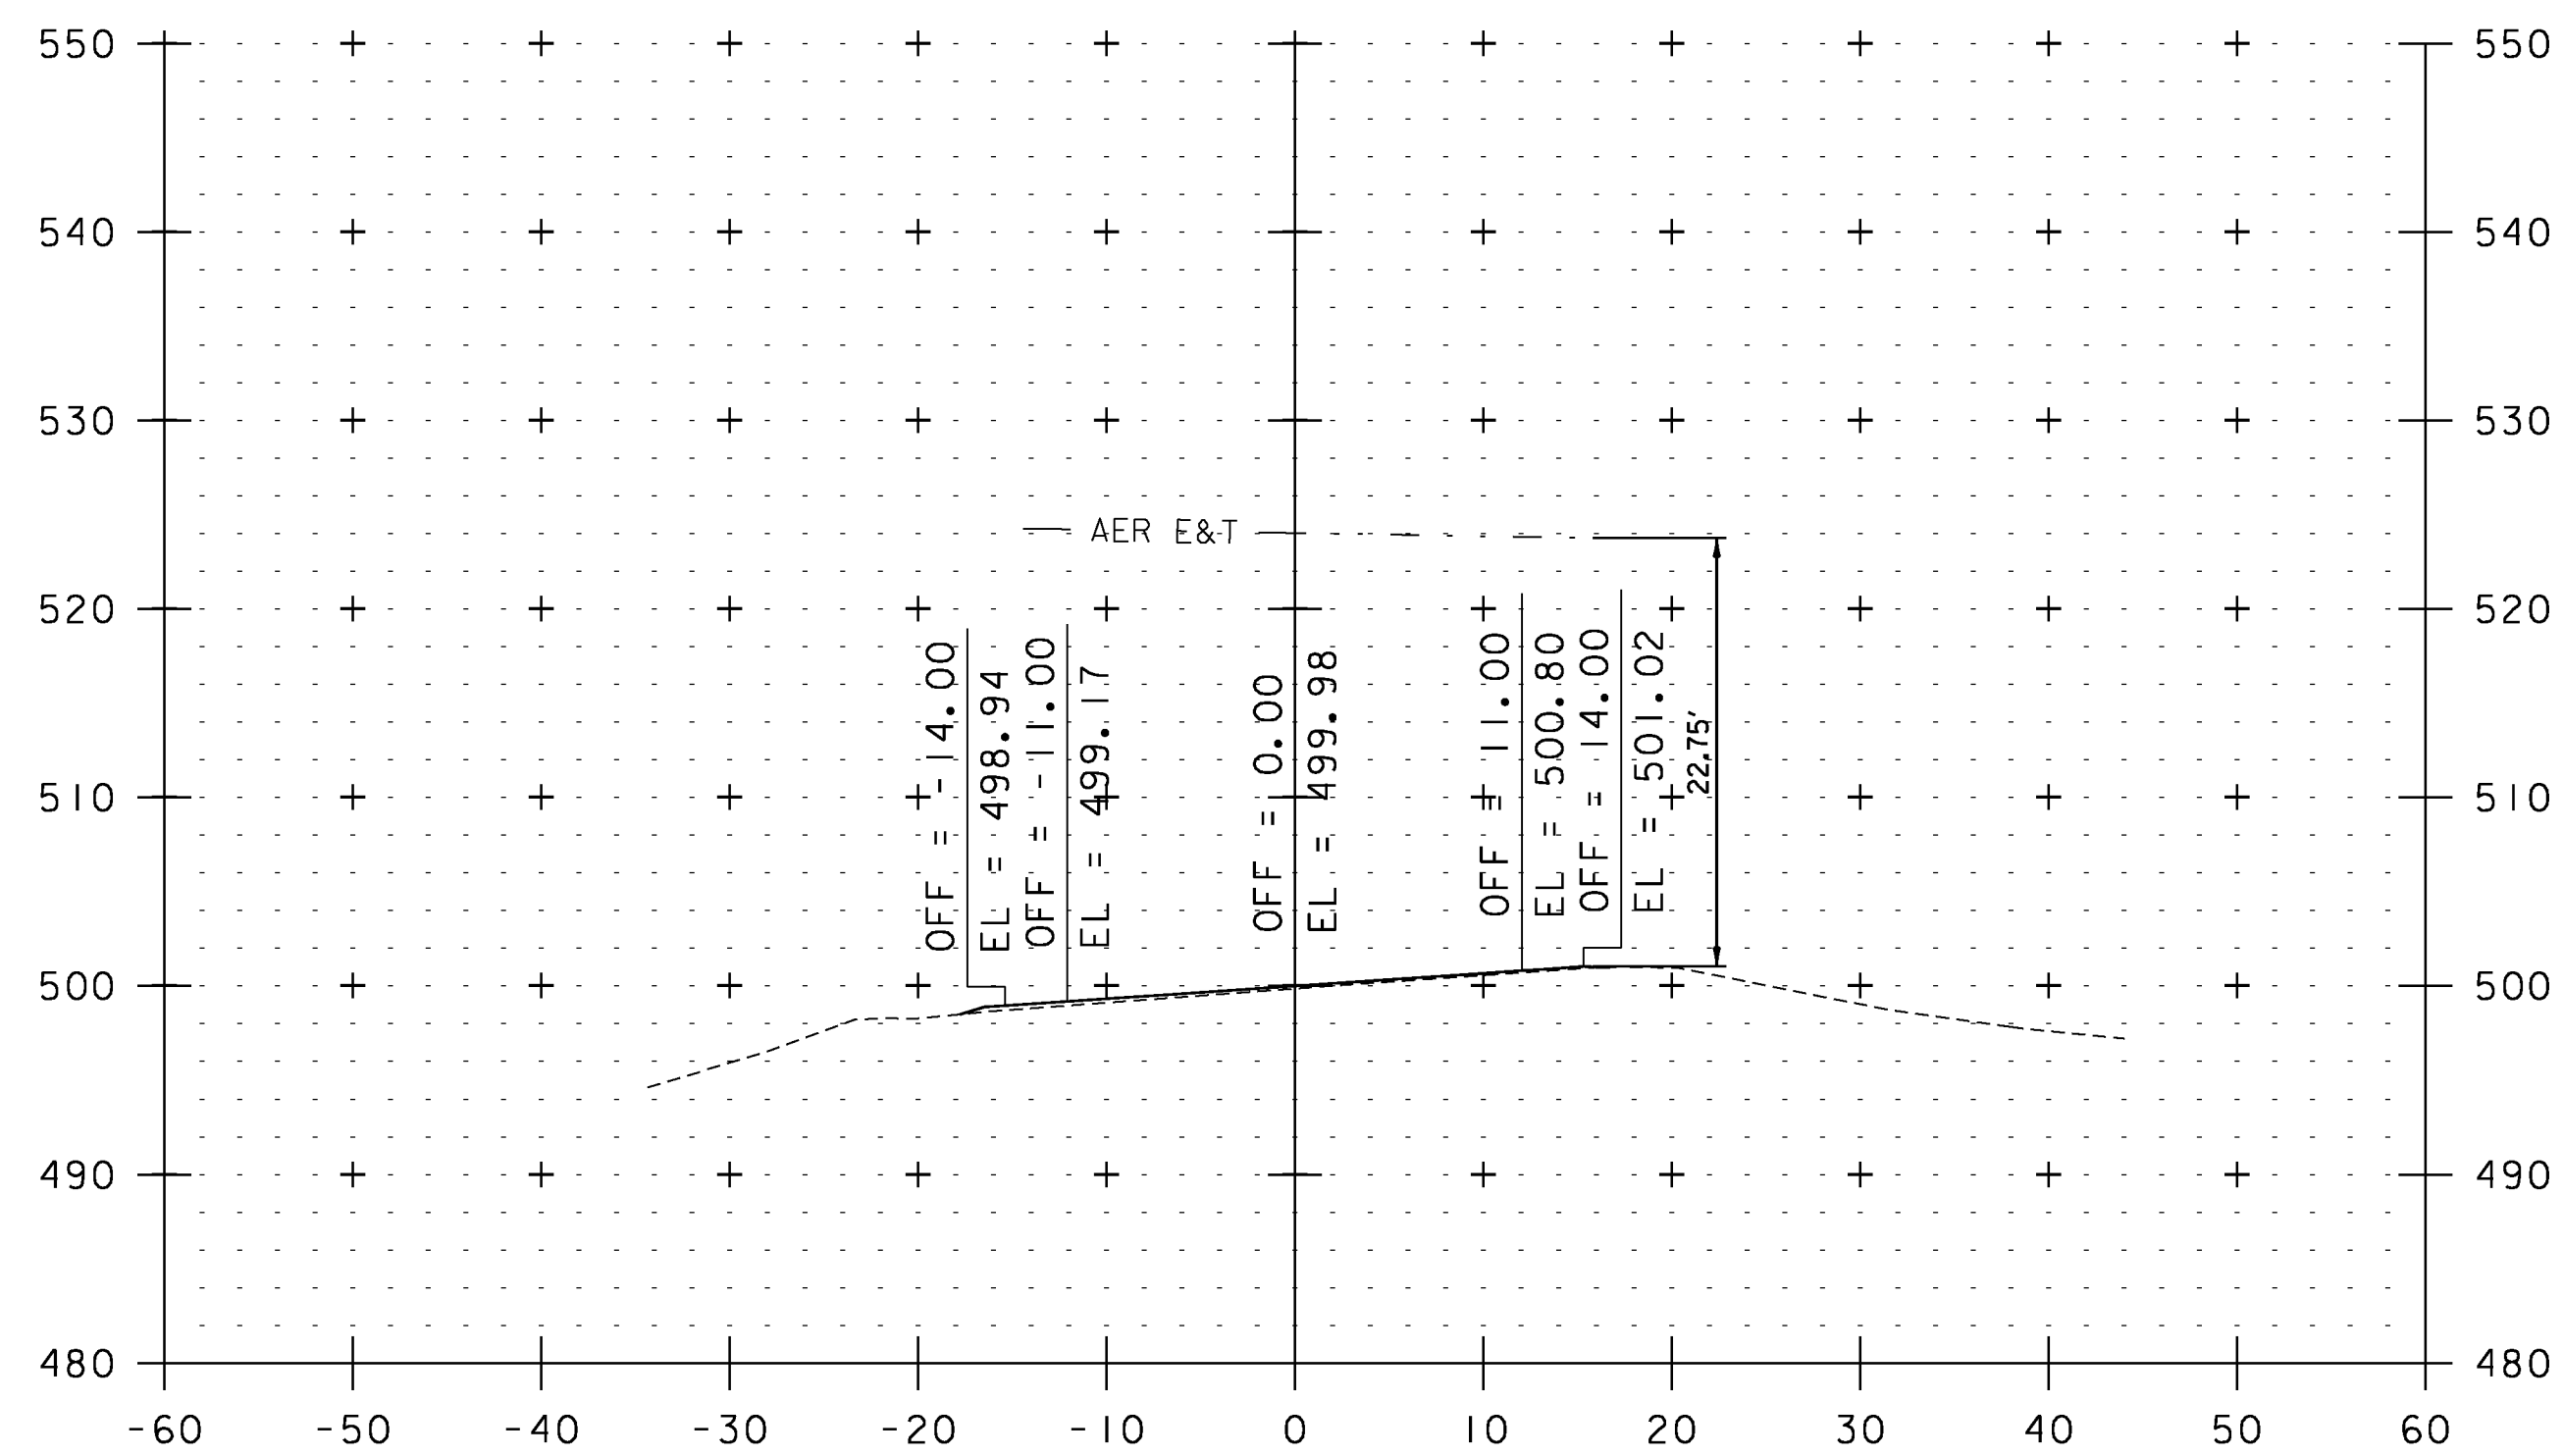

426+47

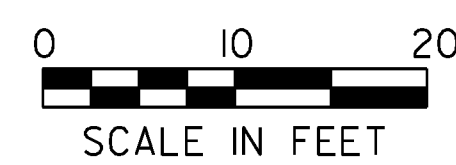

STA. 420+20 TO STA. 426+47

**UTILITY CROSS SECTION SHEET 25**

PROJECT NAME: WEATHERSFIELD	PLOT DATE: 2/7/2013
PROJECT NUMBER: STP 2913(I)	DRAWN BY: JLS
FILE NAME: I0c228	CHECKED BY: PTS
PROJECT LEADER: PTS	SHEET 207 OF 234
DESIGNED BY: NLL	
IPARM FILE NAME: pI0C228_207	