

**VT ROUTE 131
END PROJECT
STP 2913(1)**

**428+75.00 (MM 8.120)
VT ROUTE 131 BEGIN PROJECT
NH 2948(1)
BEGIN 2" COLD PLANE
& OVERLAY**

TEMPORARY 4 INCH WHITE LINE, PAINT
DURABLE 4 INCH WHITE LINE (OPTION BID ITEM)
428+75 TO 428+99 SOLID RT
428+75 TO 429+31 SOLID LT
429+69 TO 434+25 SOLID RT
429+91 TO 434+25 SOLID LT

TEMPORARY 4 INCH YELLOW LINE, PAINT
DURABLE 4 INCH YELLOW LINE (OPTION BID ITEM)
428+75 TO 429+45 SOLID LT & RT
429+85 TO 434+25 SOLID LT & RT

TEMPORARY 6 INCH WHITE LINE, PAINT
DURABLE 6 INCH WHITE LINE (OPTION BID ITEM)
428+99 TO 429+10 SOLID RT (RAMP A)
429+31 TO 429+59 SOLID LT (RAMP B)

TEMPORARY 6 INCH YELLOW LINE, PAINT
DURABLE 6 INCH YELLOW LINE (OPTION BID ITEM)
429+26 TO 429+69 SOLID RT (RAMP A)
429+81 TO 429+91 SOLID LT (RAMP B)

TEMPORARY 24 INCH STOP BAR, PAINT
DURABLE 24 INCH STOP BAR (OPTION BID ITEM)
429+40 TO 429+88 SOLID LT (RAMP B)

TEMPORARY LETTER OR SYMBOL, PAINT
DURABLE LETTER OR SYMBOL (OPTION BID ITEM)
429+64 LT - "STOP" (RAMP B)


STEEL BEAM GUARDRAIL, GALVANIZED
430+30 TO 433+05 RT
431+22.5 TO 434+10 LT

ANCHOR FOR STEEL BEAM RAIL
430+30 RT
431+22.5 LT
433+05 RT
434+10 LT

REMOVAL AND DISPOSAL OF GUARDRAIL
430+43 TO 432+95 RT
431+20 TO 434+09 LT

DELINEATOR WITH STEEL POST
430+30 RT
431+22.5 LT
433+05 RT
434+10 LT

REMOVING SIGNS
AS SHOWN - 4

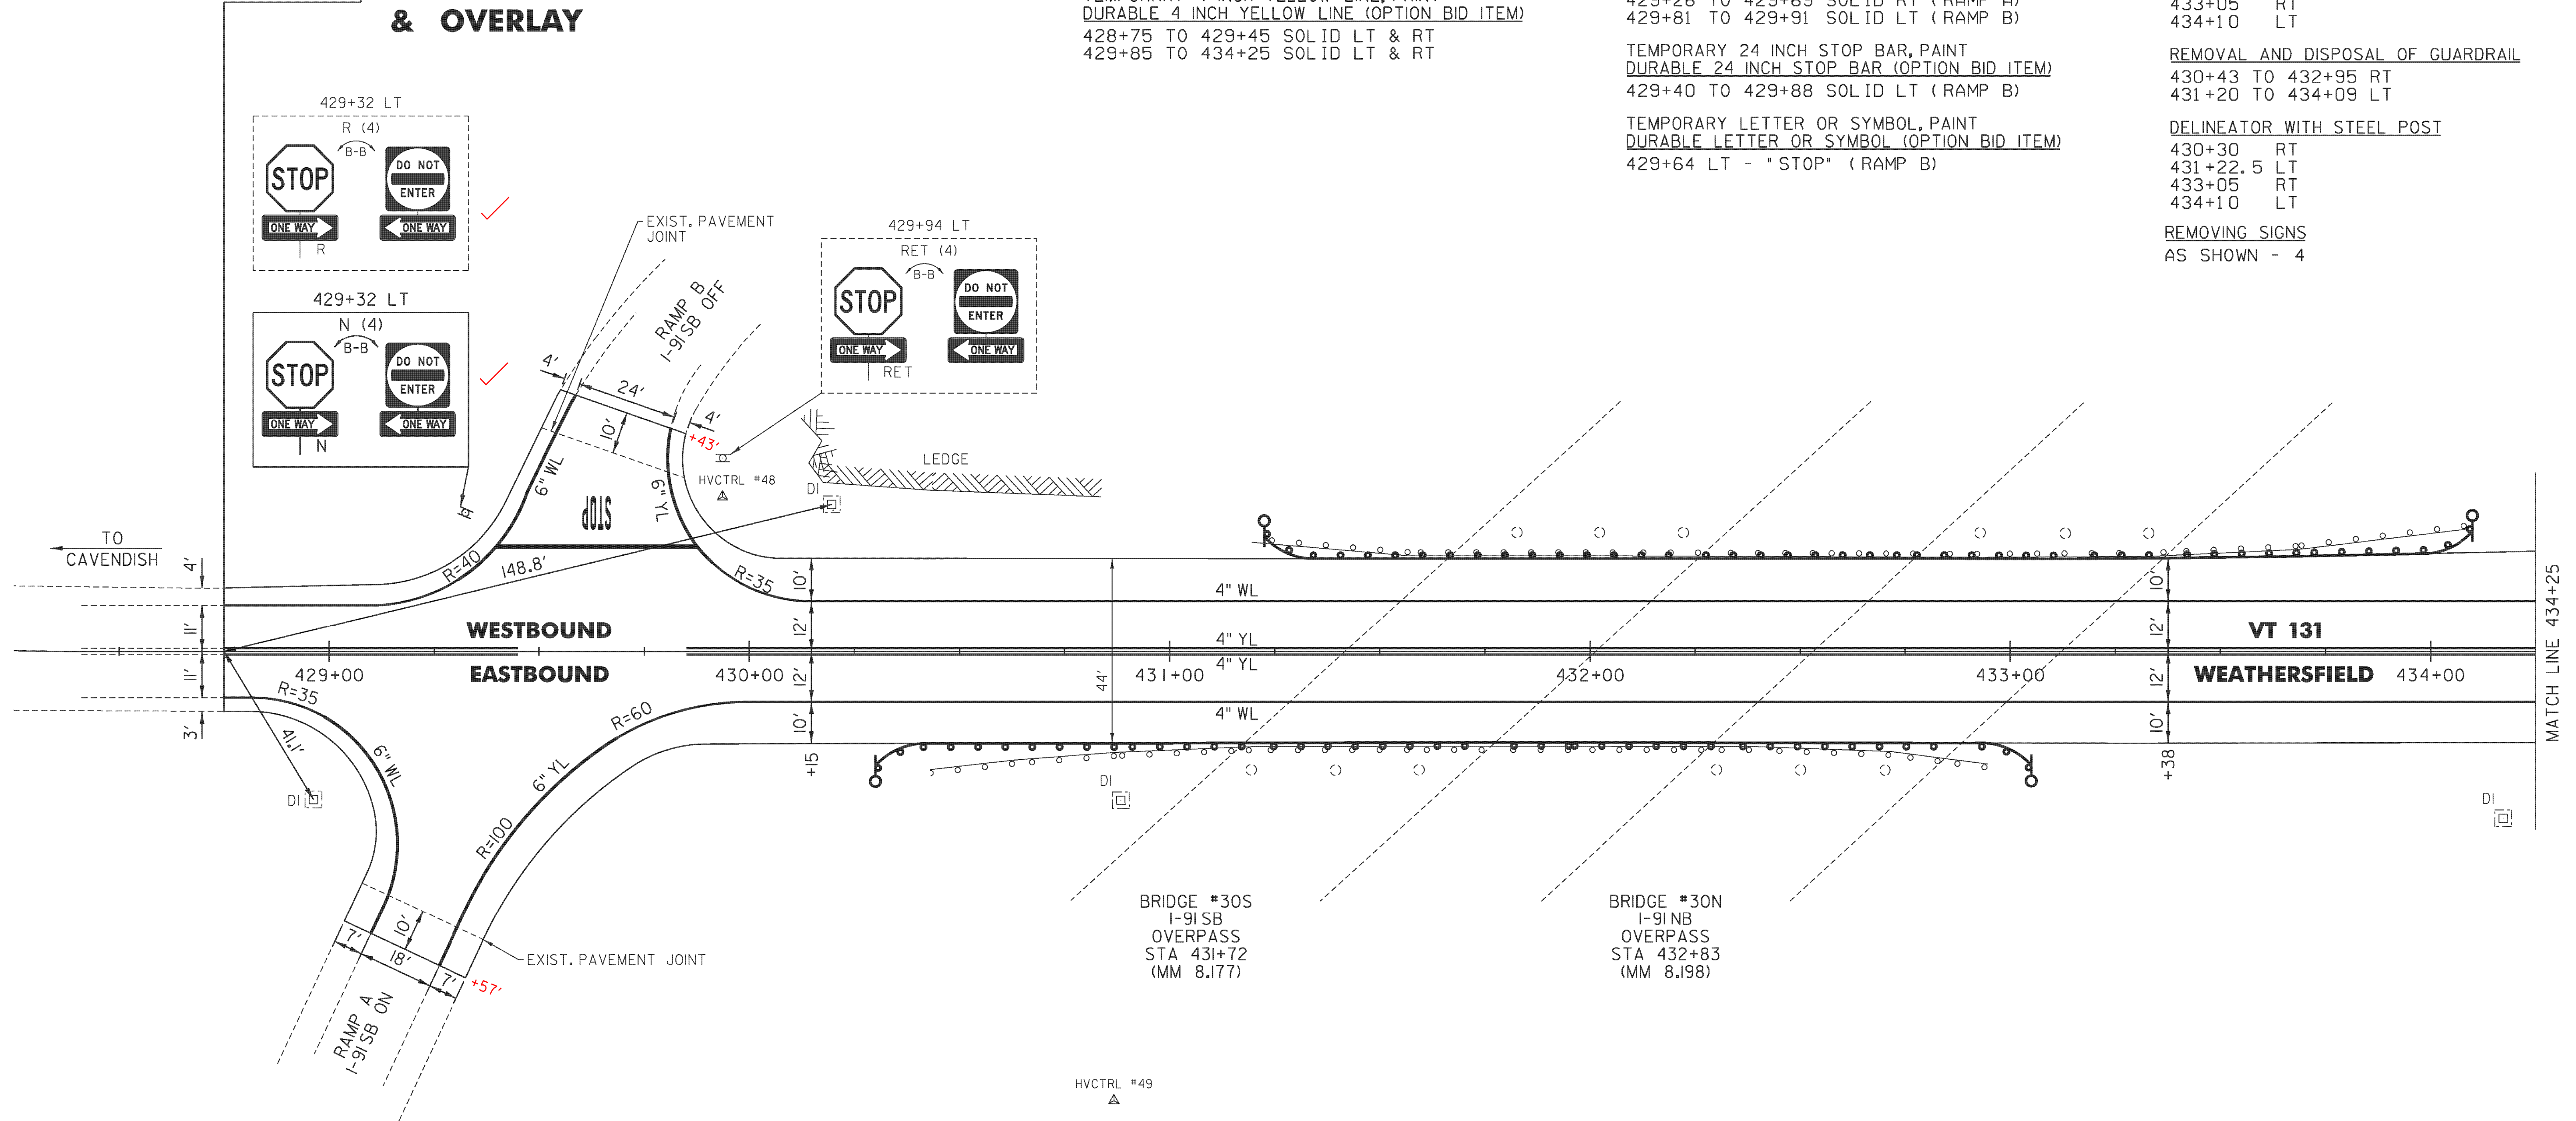

NOT TO SCALE

- LEGEND**
- R = REMOVE EXISTING
 - S = SALVAGE
 - R&S = REMOVE AND SALVAGE
 - N = NEW
 - RET = RETAIN
 - B-B = BACK TO BACK
 - = EXISTING GUARDRAIL
 - - - = PROPOSED GUARDRAIL
 - YL = YELLOW LINE
 - WL = WHITE LINE
 - = DELINEATOR

ROADWAY LAYOUT SHEET 1

PROJECT NAME: WEATHERSFIELD	FILE NAME: p12b126.dgn	PLOT DATE: 2/7/2013
PROJECT NUMBER: NH 2948(1)	PROJECT LEADER: PTS	DRAWN BY: SNG
	DESIGNED BY: NLL	CHECKED BY: PTS
	IPARM FILE NAME: p12B126_217	SHEET 217 OF 234