

TEMPORARY 4 INCH WHITE LINE, PAINT
 DURABLE 4 INCH WHITE LINE (OPTION BID ITEM)

434+25 TO 434+76 SOLID RT
 434+25 TO 435+99 SOLID LT
 435+91 TO 437+23 SOLID RT
 436+50 TO 438+02 SOLID LT (LANE LINE)
 436+50 TO 440+25 DASHED RT (LANE LINE)
 436+78 TO 440+25 SOLID LT
 437+23 TO 434+32 SOLID RT (TH 40)
 437+43 TO 438+18 SOLID RT (TH 40)
 438+02 TO 440+25 DASHED LT (LANE LINE)
 438+18 TO 440+25 SOLID RT

TEMPORARY 4 INCH YELLOW LINE, PAINT
 DURABLE 4 INCH YELLOW LINE (OPTION BID ITEM)

434+25 TO 434+81 SOLID LT & RT
 435+21 TO 436+10 SOLID LT & RT
 436+50 TO 437+37 SOLID LT & RT
 437+38 TO 437+57 DOUBLE SOLID RT (TH 40)
 437+77 TO 440+25 SOLID LT & RT

TEMPORARY 6 INCH WHITE LINE, PAINT
 DURABLE 6 INCH WHITE LINE (OPTION BID ITEM)

434+71 TO 435+91 SOLID RT (RAMP C)
 436+41 TO 436+78 SOLID LT (RAMP D)

TEMPORARY 6 INCH YELLOW LINE, PAINT
 DURABLE 6 INCH YELLOW LINE (OPTION BID ITEM)

434+62 TO 434+76 SOLID RT (RAMP C)
 435+99 TO 436+08 SOLID LT (RAMP D)

TEMPORARY 24 INCH STOP BAR, PAINT
 DURABLE 24 INCH STOP BAR (OPTION BID ITEM)

434+76 TO 435+40 SOLID RT (RAMP C)
 437+58 TO 437+79 SOLID RT (TH 40)

DURABLE LETTER OR SYMBOL (OPTION BID ITEM)

435+01 RT - "STOP" (RAMP C)
 435+27 RT - "STOP" (RAMP C)
 436+74 LT - RIGHT TURN ARROW
 437+35 LT - "ONLY"
 437+62 RT - "STOP" (TH 40)
 437+96 LT - RIGHT TURN ARROW

TEMPORARY LETTER OR SYMBOL, PAINT

435+01 RT - "STOP" (RAMP C)
 435+27 RT - "STOP" (RAMP C)
 436+74 LT - RIGHT TURN ARROW
 437+62 RT - "STOP" (TH 40)
 437+96 LT - RIGHT TURN ARROW

STEEL BEAM GUARDRAIL, GALVANIZED

437+22 TO 439+84 RT (STARTS ON TH 40)

ANCHOR FOR STEEL BEAM RAIL


437+22 RT
 439+84 RT

REMOVAL AND DISPOSAL OF GUARDRAIL

437+16 TO 439+87 RT (STARTS ON TH 40)

DELINEATOR WITH STEEL POST

437+22 RT
 439+84 RT

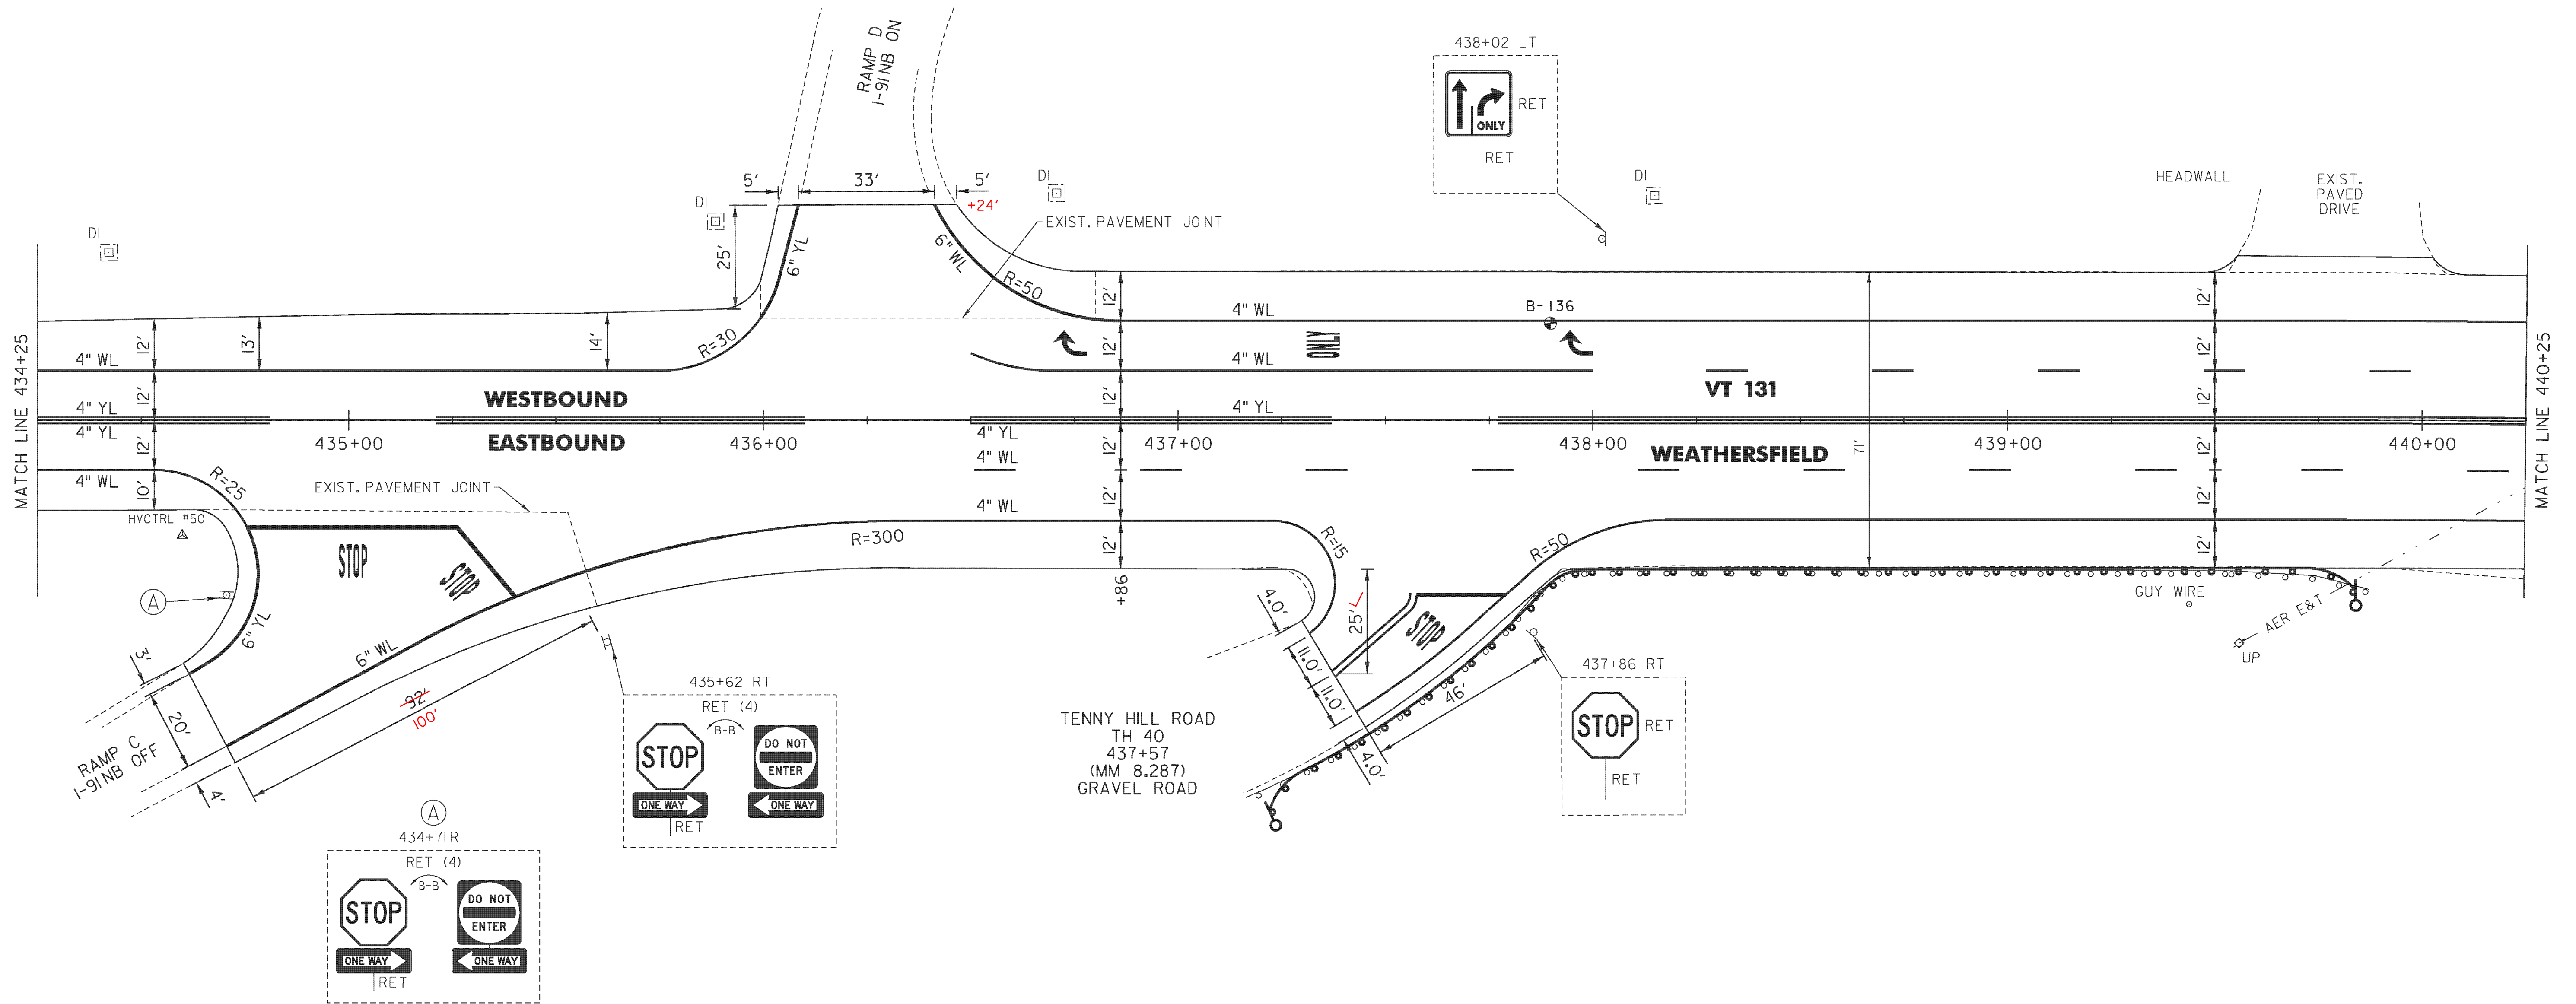

NOT TO SCALE

LEGEND

- R = REMOVE EXISTING
- S = SALVAGE
- R&S = REMOVE AND SALVAGE
- N = NEW
- RET = RETAIN
- B-B = BACK TO BACK
- = EXISTING GUARDRAIL
- = PROPOSED GUARDRAIL
- YL = YELLOW LINE
- WL = WHITE LINE
- = DELINEATOR

ROADWAY LAYOUT SHEET 2

PROJECT NAME: WEATHERSFIELD	FILE NAME: p12b126.dgn	PLOT DATE: 2/7/2013
PROJECT NUMBER: NH 2948(I)	PROJECT LEADER: PTS	DRAWN BY: SNG
	DESIGNED BY: NLL	CHECKED BY: PTS
	IPARM FILE NAME: p12B126_218	SHEET 218 OF 234