


**277+00.00  
US ROUTE 5  
END 2" COLD PLANE  
& OVERLAY**

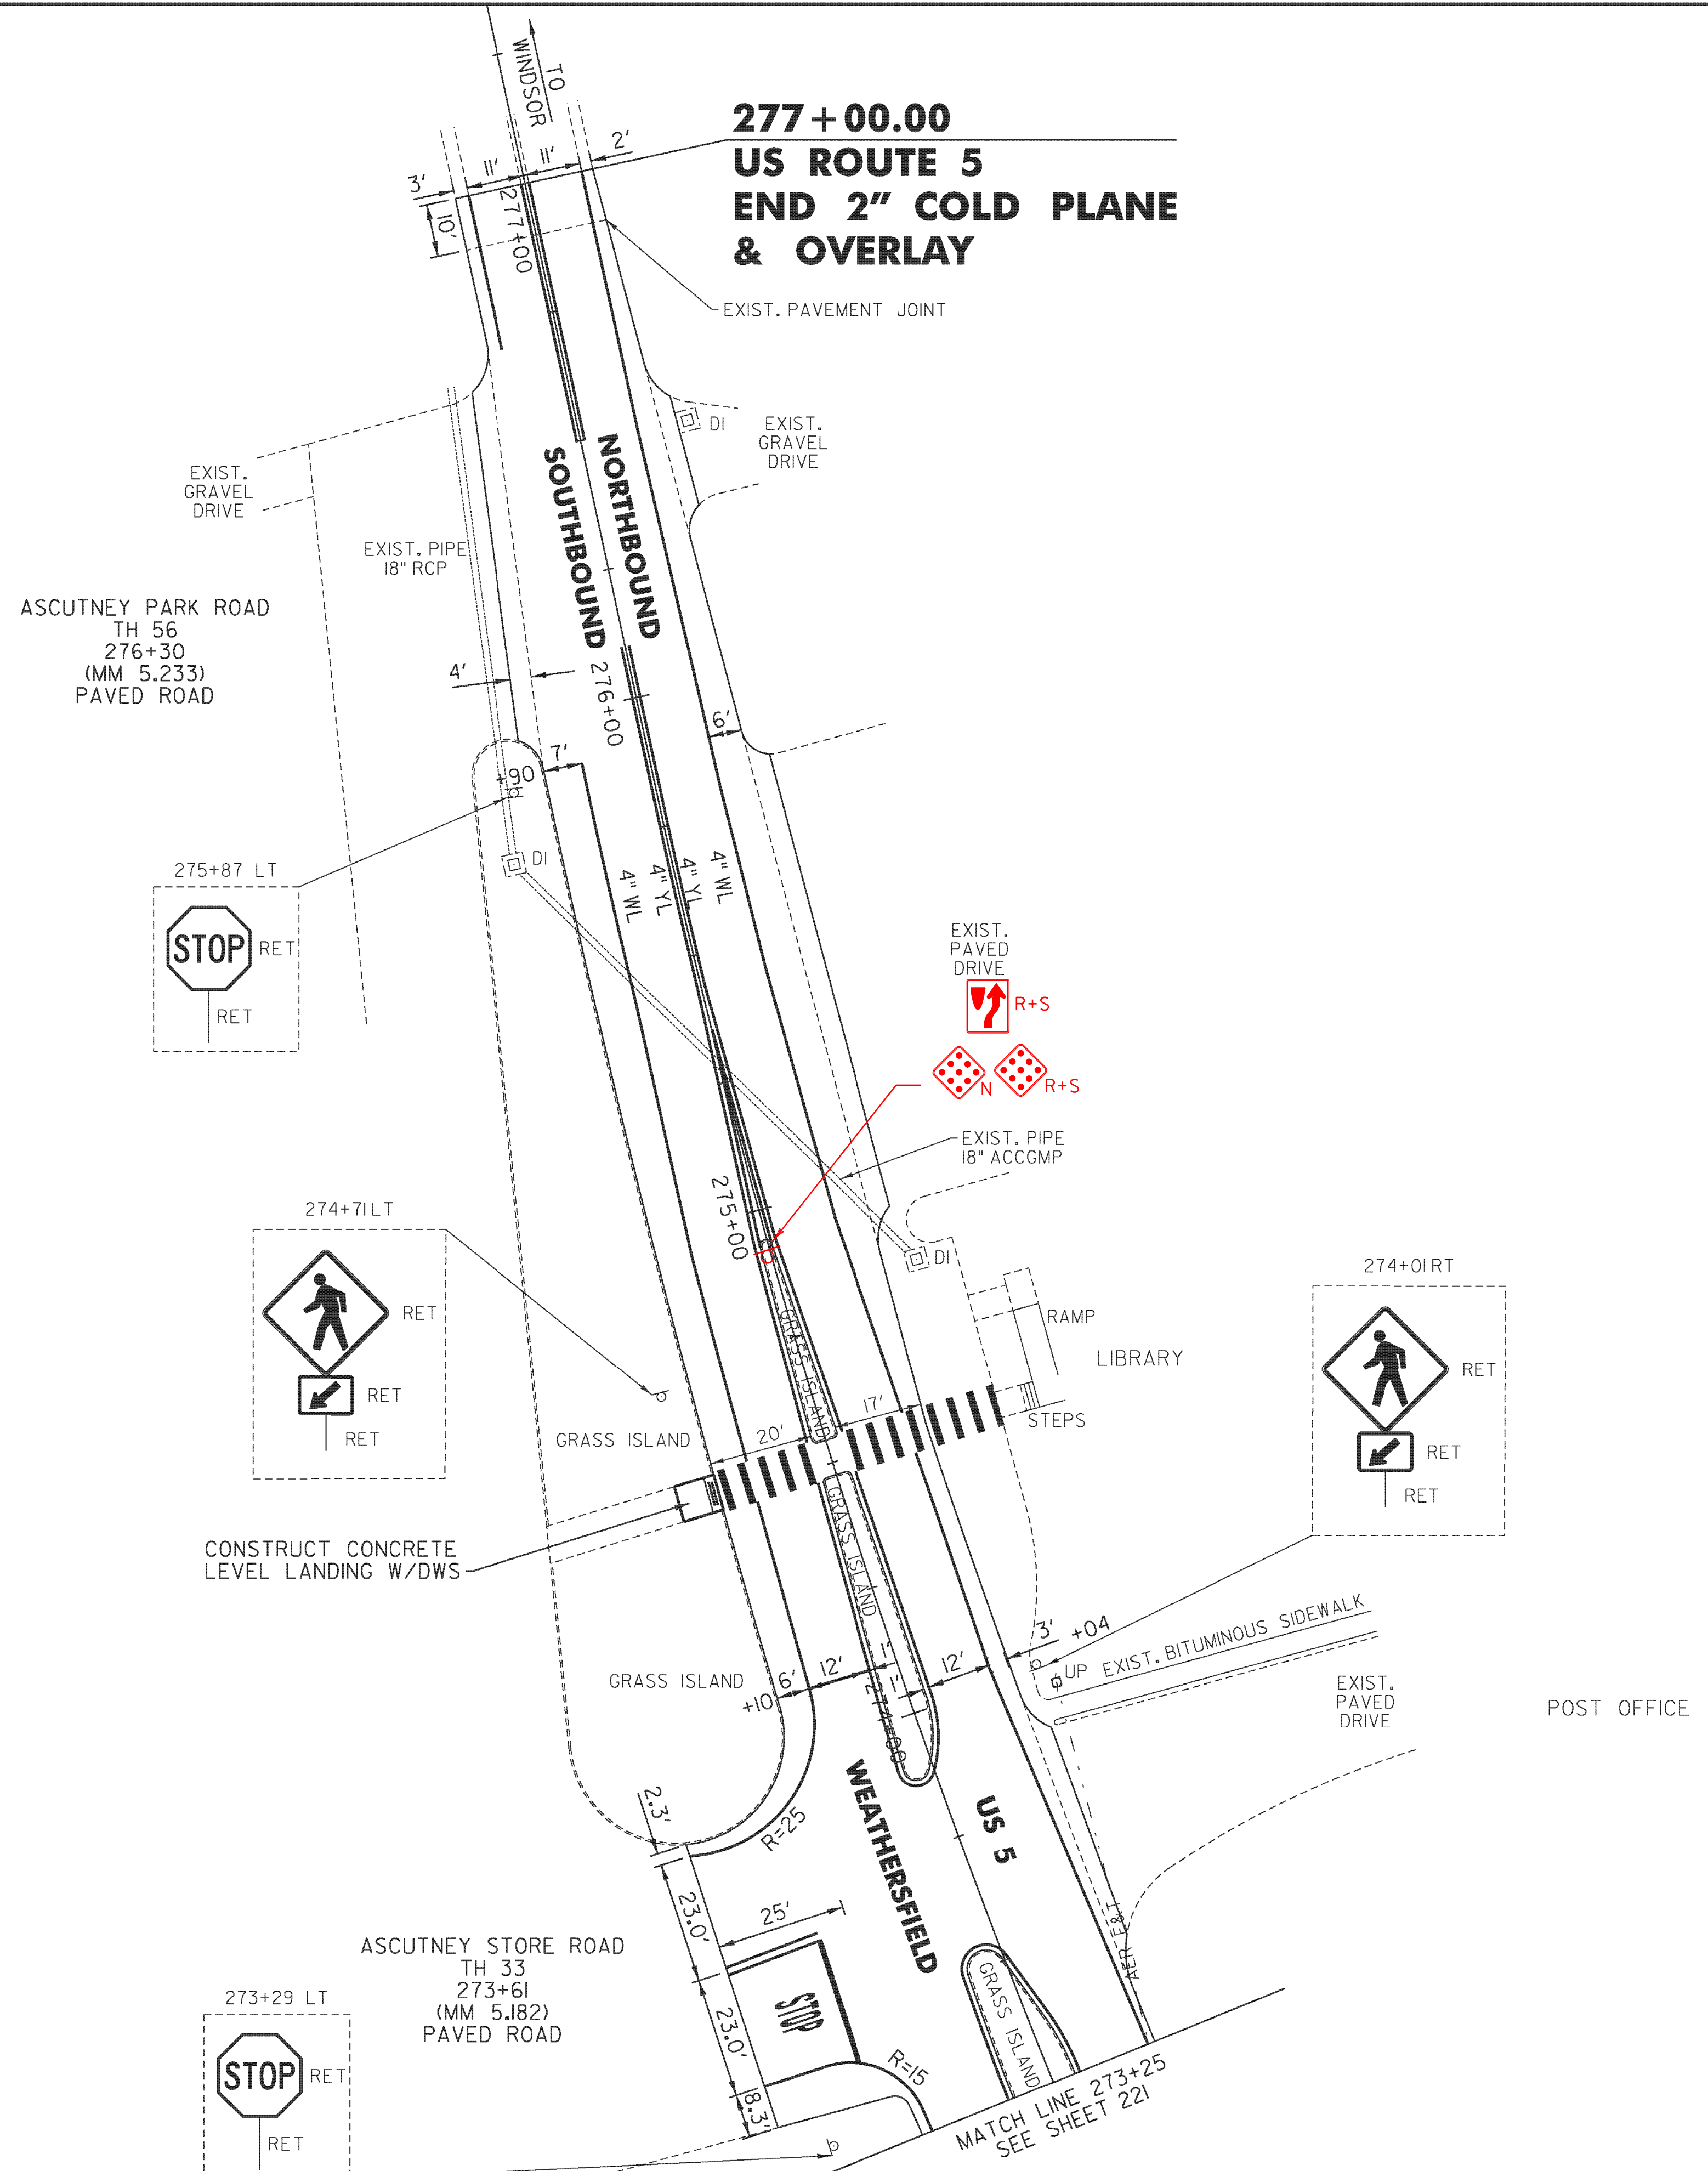

TEMPORARY 4 INCH WHITE LINE, PAINT  
DURABLE 4 INCH WHITE LINE (OPTION BID ITEM)  
273+25 TO 273+30 LT  
273+25 TO 274+47 RT  
273+30 TO 273+44 LT (TH 33)  
273+89 TO 274+11 LT (TH 33)  
274+11 TO 274+47 LT  
274+55 TO 275+84 LT  
274+55 TO 277+00 RT  
276+71 TO 277+00 LT

TEMPORARY 4 INCH YELLOW LINE, PAINT  
DURABLE 4 INCH YELLOW LINE (OPTION BID ITEM)  
273+25 TO 273+54 SOLID LT ( ISLAND)  
273+25 TO 273+54 SOLID RT ( ISLAND)  
273+66 DOUBLE SOLID LT (TH 33)  
273+87 TO 274+47 SOLID LT ( ISLAND)  
273+87 TO 274+47 SOLID RT ( ISLAND)  
274+55 TO 274+93 SOLID LT ( ISLAND)  
274+55 TO 274+93 SOLID RT ( ISLAND)  
274+93 TO 275+35 DOUBLE SOLID LT/DOUBLE SOLID RT  
275+35 TO 276+10 SOLID LT & RT  
276+50 TO 277+00 SOLID LT & RT

TEMPORARY 24 INCH STOP BAR, PAINT  
DURABLE 24 INCH STOP BAR (OPTION BID ITEM)  
273+42 TO 273+66 SOLID LT (TH 33)

TEMPORARY LETTER OR SYMBOL, PAINT  
DURABLE LETTER OR SYMBOL (OPTION BID ITEM)  
273+54 SOLID LT - "STOP" (TH 33)

TEMPORARY CROSSWALK MARKING, PAINT  
DURABLE CROSSWALK MARKING (OPTION BID ITEM)  
274+51 LT & RT

PAINTED CURB  
273+25 TO 273+53 LT & RT ( ISLAND)  
273+88 TO 274+18 LT & RT ( ISLAND)  
274+64 TO 274+94 LT & RT ( ISLAND)

PORTLAND CEMENT CONCRETE SIDEWALK, 5 INCH  
274+48 TO 274+54 LT ( LEVEL LANDING)

DETECTABLE WARNING SURFACE (DWS)  
274+51 LT

**LEGEND**

- R = REMOVE EXISTING
- S = SALVAGE
- R&S = REMOVE AND SALVAGE
- N = NEW
- RET = RETAIN
- B-B = BACK TO BACK
- = EXISTING GUARDRAIL
- = PROPOSED GUARDRAIL
- YL = YELLOW LINE
- WL = WHITE LINE
- = DELINEATOR

**ROADWAY LAYOUT SHEET 6**

PROJECT NAME: WEATHERSFIELD	
PROJECT NUMBER: NH 2948(I)	
FILE NAME: p12b126.dgn	PLOT DATE: 2/7/2013
PROJECT LEADER: PTS	DRAWN BY: SNG
DESIGNED BY: NLL	CHECKED BY: PTS
IPARM FILE NAME: p12B126_223	SHEET 223 OF 234

NOT TO SCALE