

TEMPORARY 4 INCH WHITE LINE, PAINT
 DURABLE 4 INCH WHITE LINE (OPTION BID ITEM)
 13+50 TO 18+50 SOLID LT & RT
 13+50 TO 18+50 DASHED LT (LANE LINE)
 13+50 TO 18+50 DASHED RT (LANE LINE)


TEMPORARY 4 INCH YELLOW LINE, PAINT
 DURABLE 4 INCH YELLOW LINE (OPTION BID ITEM)
 13+50 TO 18+47 SOLID LT & RT
 18+47 TO 18+50 DOUBLE SOLID LT (ISLAND)
 18+47 TO 18+50 DOUBLE SOLID RT (ISLAND)

TEMPORARY LETTER OR SYMBOL, PAINT
 DURABLE LETTER OR SYMBOL (OPTION BID ITEM)
 13+82 SOLID RT - "AHEAD" (2)

STEEL BEAM GUARDRAIL, GALVANIZED
 13+50 TO 15+55 LT
 ANCHOR FOR STEEL BEAM RAIL
 15+55 LT

REMOVAL AND DISPOSAL OF GUARDRAIL
 13+50 TO 15+54 LT
 DELINEATOR WITH STEEL POST
 15+55 LT

REMOVING SIGNS
 AS SHOWN - 27
 ERECTING SALVAGED SIGNS
 AS SHOWN - 1

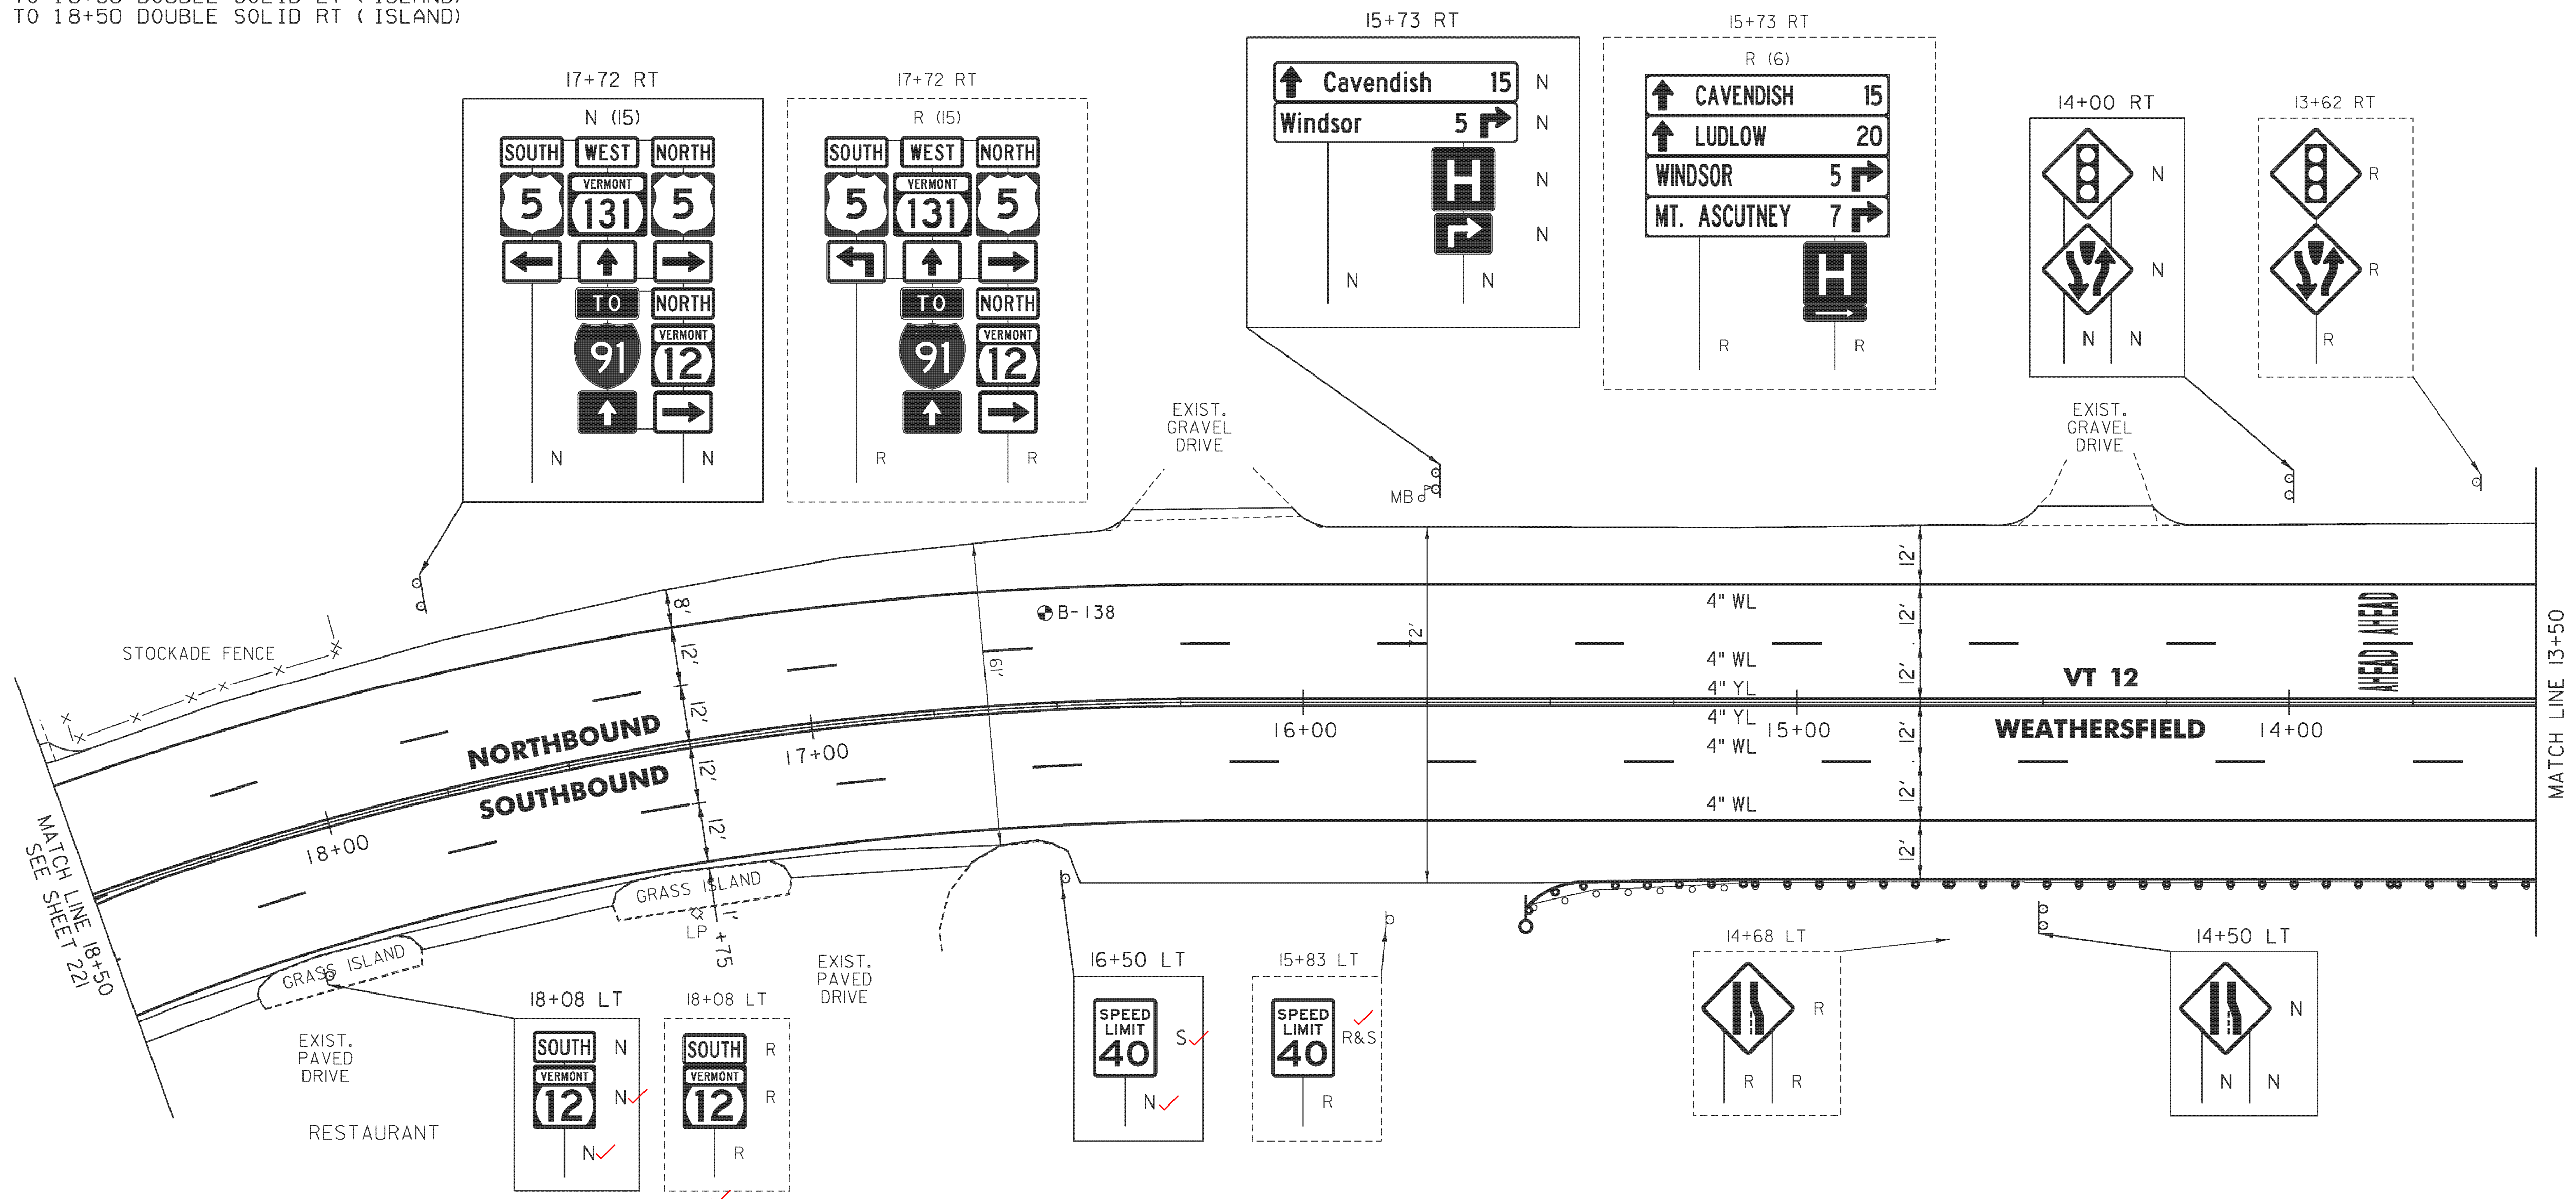

LEGEND

- R = REMOVE EXISTING
- S = SALVAGE
- R&S = REMOVE AND SALVAGE
- N = NEW
- RET = RETAIN
- B-B = BACK TO BACK
- = EXISTING GUARDRAIL
- = PROPOSED GUARDRAIL
- YL = YELLOW LINE
- WL = WHITE LINE
- = DELINEATOR

ROADWAY LAYOUT SHEET 7

PROJECT NAME: WEATHERSFIELD
 PROJECT NUMBER: NH 2948(I)

FILE NAME: p12b126.dgn
 PROJECT LEADER: PTS
 DESIGNED BY: NLL
 IPARM FILE NAME: p12B126_224

PLOT DATE: 2/7/2013
 DRAWN BY: SNG
 CHECKED BY: PTS
 SHEET 224 OF 234

NOT TO SCALE