

TEMPORARY 4 INCH WHITE LINE, PAINT  
 DURABLE 4 INCH WHITE LINE (OPTION BID ITEM)  
 8+50 TO 13+50 SOLID LT & RT  
 10+15 TO 13+50 DASHED RT (LANE LINE)  
 13+25 TO 13+50 DASHED LT (LANE LINE)


TEMPORARY 4 INCH YELLOW LINE, PAINT  
 DURABLE 4 INCH YELLOW LINE (OPTION BID ITEM)  
 8+50 TO 13+50 SOLID LT & RT

TEMPORARY LETTER OR SYMBOL, PAINT  
 DURABLE LETTER OR SYMBOL (OPTION BID ITEM)  
 11+37 SOLID LT - LANE REDUCTION ARROW  
 13+35 SOLID LT - LANE REDUCTION ARROW  
 13+42 SOLID RT - "SIGNAL" (2)

STEEL BEAM GUARDRAIL, GALVANIZED  
 12+55 TO 13+50 LT  
 ANCHOR FOR STEEL BEAM RAIL  
 12+55 LT

REMOVAL AND DISPOSAL OF GUARDRAIL  
 12+52 TO 13+50 LT  
 DELINEATOR WITH STEEL POST  
 12+55 LT

REMOVING SIGNS  
 AS SHOWN - 9

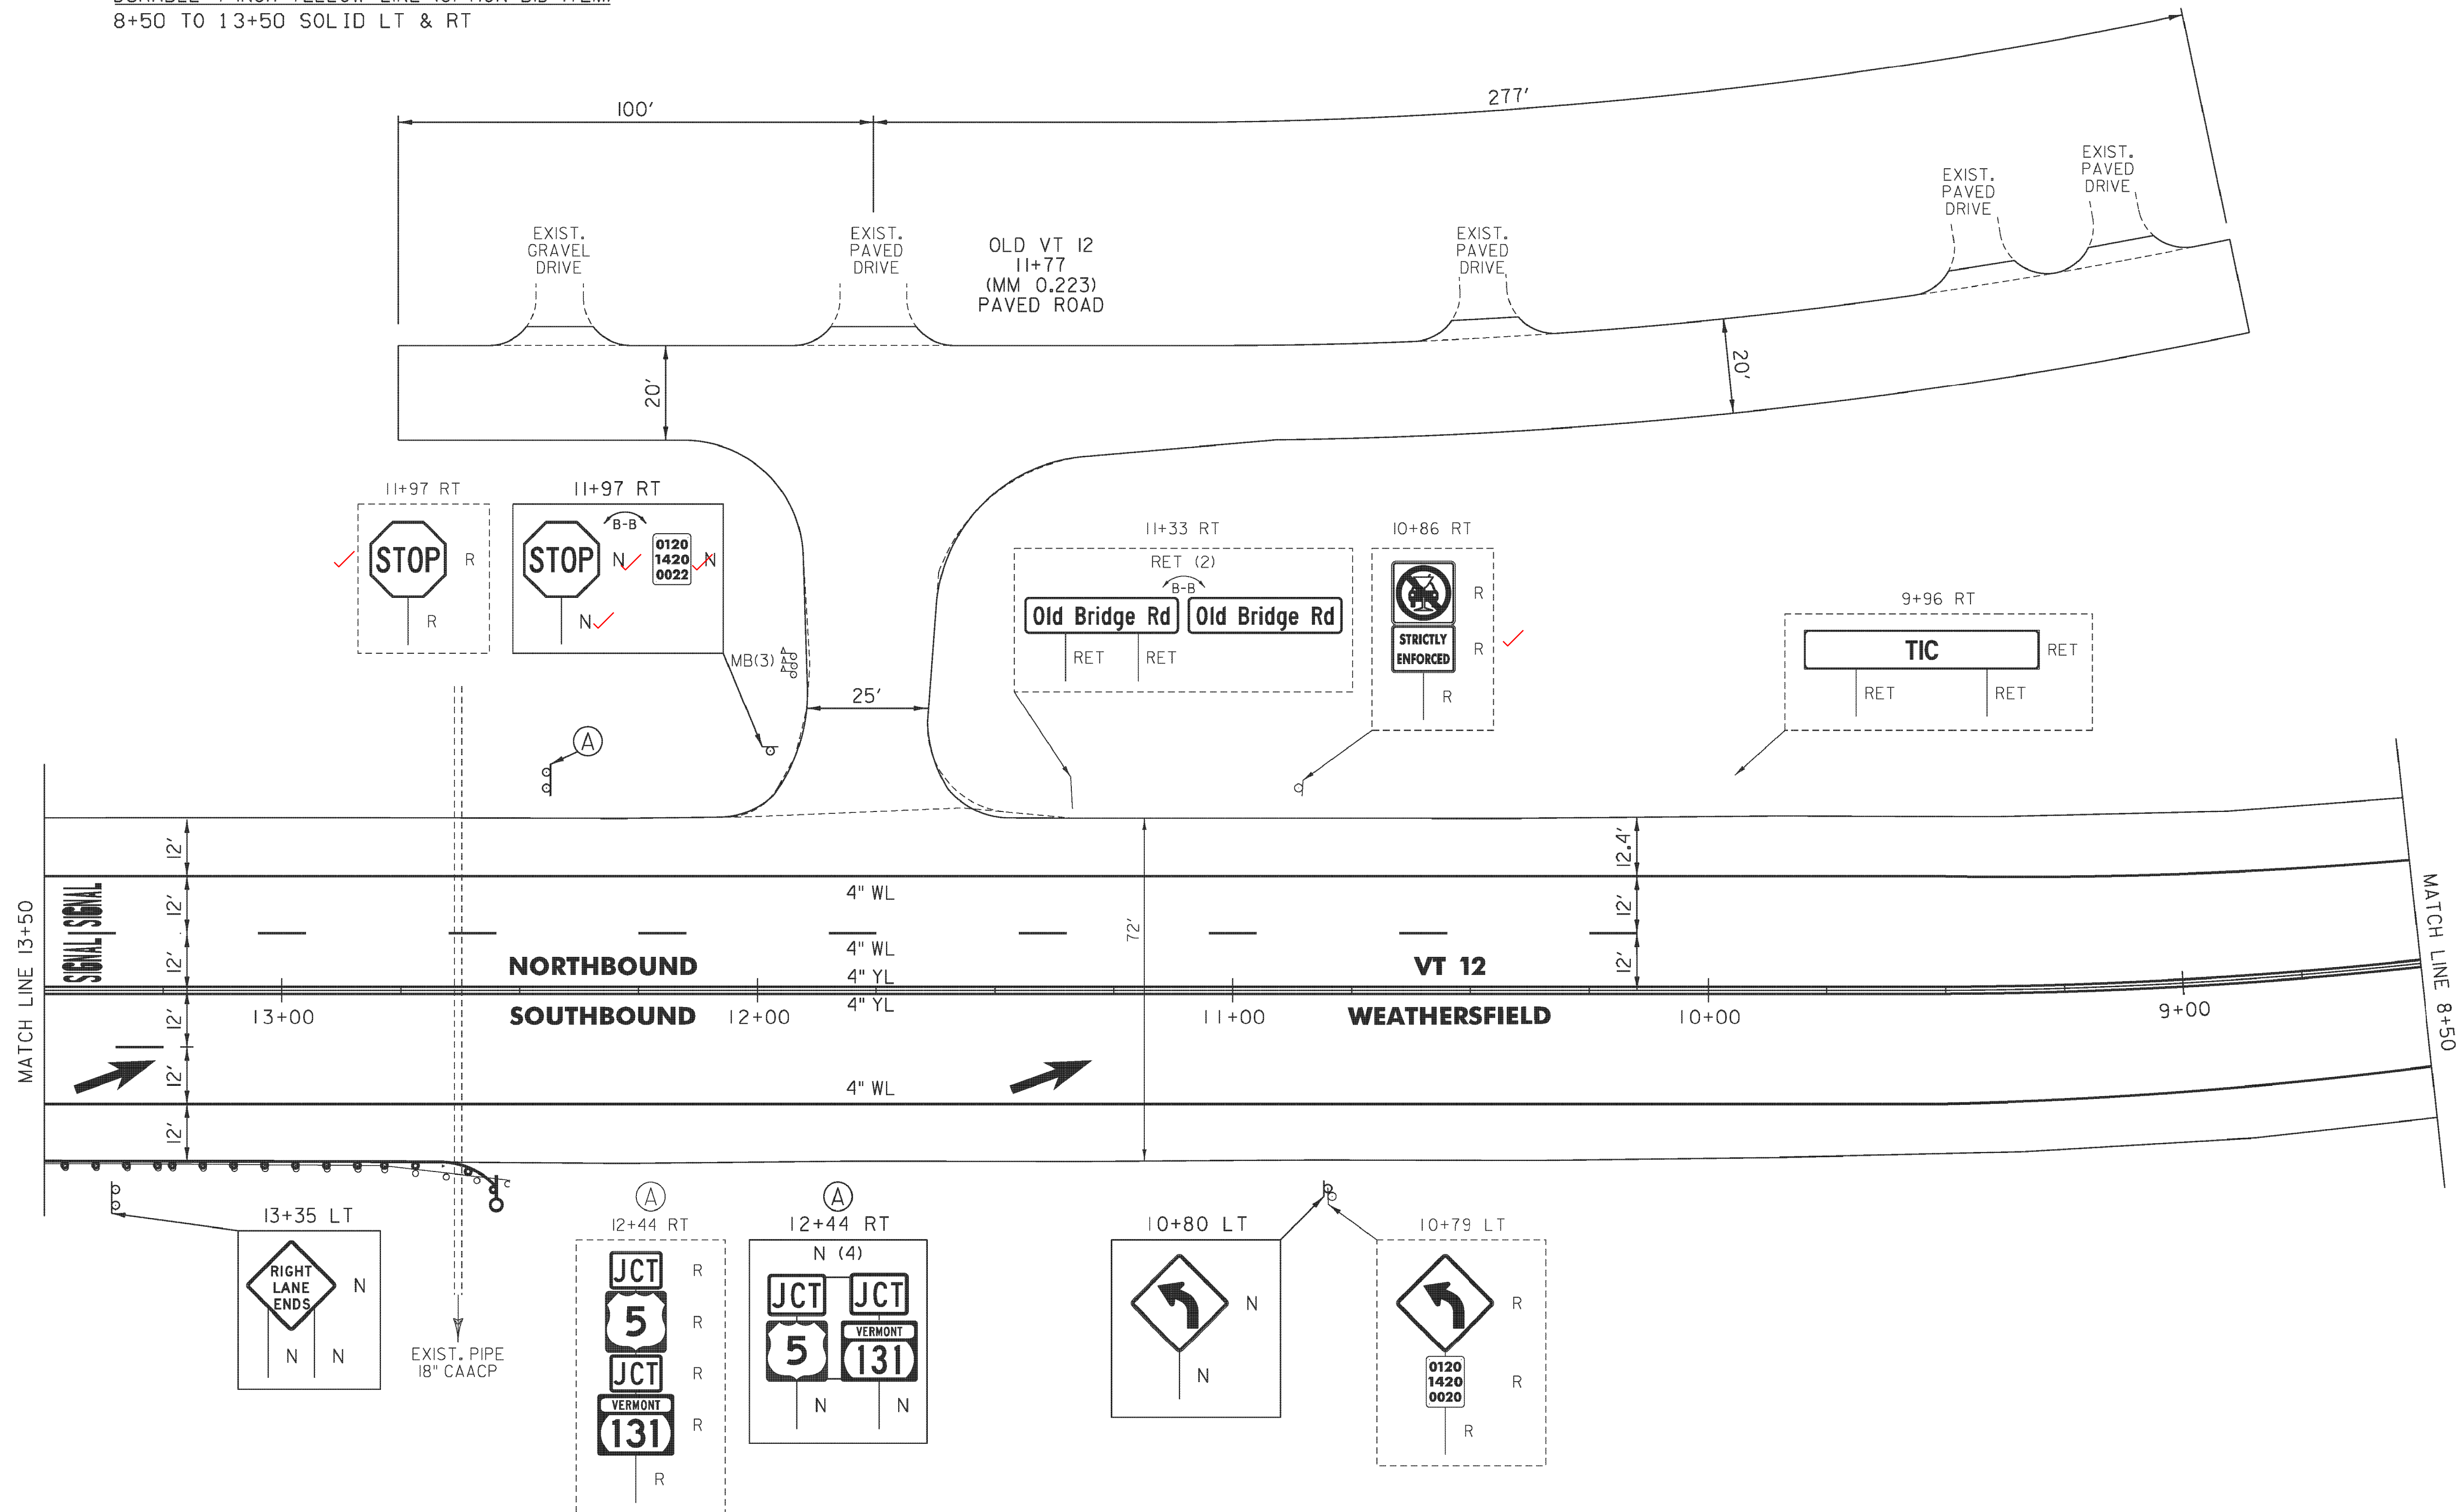

LEGEND

- R = REMOVE EXISTING
- S = SALVAGE
- R&S = REMOVE AND SALVAGE
- N = NEW
- RET = RETAIN
- B-B = BACK TO BACK
- = EXISTING GUARDRAIL
- ⊕ = PROPOSED GUARDRAIL
- YL = YELLOW LINE
- WL = WHITE LINE
- = DELINEATOR

**ROADWAY LAYOUT SHEET 8**

PROJECT NAME:	WEATHERSFIELD
PROJECT NUMBER:	NH 2948(1)
FILE NAME:	pl2bl26.dgn
PROJECT LEADER:	PTS
DESIGNED BY:	NLL
IPARM FILE NAME:	pl2Bl26_225
PLOT DATE:	2/7/2013
DRAWN BY:	SNG
CHECKED BY:	PTS
SHEET	225 OF 234

NOT TO SCALE