


NO BORDER, WHITE OR GREEN
VD-024
VD-025 SIMILAR


TEXT	POST	DIMENSION
TOWN NAMES		
Hyde Park	B	32.50
Morrisville	B	32.50
Woolport	C	29.38
1st Union	C	32.50
Greentaborg	B	32.50
Greene	B	32.50
DeWitt	C	32.50
Rumford	C	32.50
Newbury	C	30.47
Orange	C	32.50
Bradford	C	32.50
COUNTY NAMES		
Caledonia Co.	B (5")	32.50
Lamoille Co.	B (5")	32.50
Orange Co.	B (5")	32.50

TOWN/COUNTY LINE SIGN NOTES:


- WORD TO WORD SPACING FOR COUNTIES AND TWO WORD TOWN NAMES IS ADJUSTABLE TO ACCOMMODATE DIMENSION REQUIREMENT.
- FONT SPACING MAY BE ADJUSTED TO MEET DIMENSION REQUIREMENT.
- DIMENSIONS SHOWN ARE APPROXIMATE AND MAY BE ADJUSTED SLIGHTLY TO ACCOMMODATE VARIOUS MANUFACTURER'S LETTER WIDTHS.

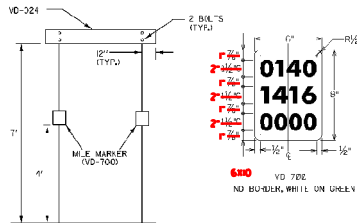


WHEN CROSSING COUNTY BOUNDARIES AN ADDITIONAL COUNTY LINE SIGN (VD-025) SHALL BE MOUNTED BELOW THE TOWN LINE SIGN (VD-024) MAINTAINING AN SEVEN FOOT CLEARANCE.

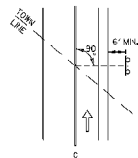


THE SIGN SHALL BE MOUNTED PARALLEL WITH THE ROADWAY, NORMALLY ON RIGHT SIDE TRAVELING WEST TO EAST OR SOUTH TO NORTH.

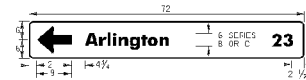


D1-1A

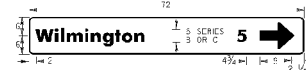

D1-1A

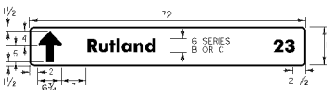

D1-1A

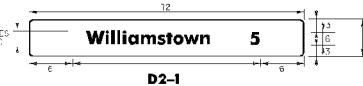


D2-1

**STANDARD DESTINATION SIGN NOTES
 D1-1, D1-1A, D2-1**

THE DESTINATION SIGNS SHOWN ON THIS SHEET SHALL HAVE WHITE RETROREFLECTIVE ASTM TYPE 'II' OR 'IV' TEXT, ARROWS AND BORDERS ON A GREEN RETROREFLECTIVE ASTM TYPE 'I' OR 'II' BACKGROUND.




D1-1

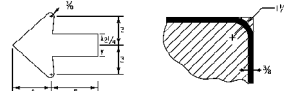


STANDARD ARROW

BORDER DETAIL

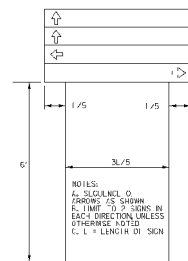

DESTINATION ASSEMBLY



NOTES:
 A. SIGN MOUNTED ON ARROWS (S) SHOWN
 B. TIME TO 3" SIGN IN EACH DIRECTION UNLESS OTHERWISE NOTED
 C. L = LENGTH OF SIGN

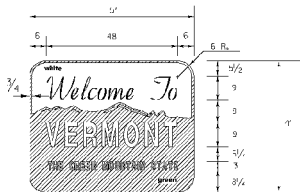


VD-421A

NOTES:
 FOR THE WORDS 'WELCOME TO' USE 'GERBER' FONT
 MURRAY HILL BOLD OR EQUIVALENT, TEXT COLOR IS GREEN,
 ALL OTHER TEXT USE GERBER FONT SOUVENIR
 DEMIMOLD OR EQUIVALENT, TEXT COLOR S WHITE.

MATERIALS:
 THE SIGN BASE MATERIAL IS USDF. FOR THIS SIGN MAY BE ANY OF THE FOLLOWING OF THE MINIMUM THICKNESS NOTED.
 FLAT SHEET ALUMINUM .0100"
 HIGH DENSITY OVERLAP PLYWOOD 5/8"

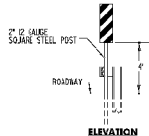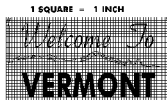

ELEVATION

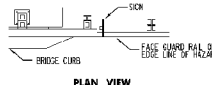

PLAN VIEW

OBJECT MARKER SHOULD BE INSTALLED SO INSIDE EDGE OF SIGN IS PARALLEL TO FACE OF GUARD RAIL OR INSIDE EDGE OF HAZARD.

SIGN SHALL BE MOUNTED SO THE DIAGONAL STRIPES SLOPE DOWNWARD TOWARD ROAD CENTERLINE.


ASSEMBLY HARDWARE SHALL CONFORM TO SECTION 750.02 (a). (WETS'S SHALL NOT BE USED).

SIGN BASE MATERIAL SHALL BE 0.007" FLAT SHEET ALUMINUM.

MOUNTING HARDWARE FOR SIGNS ATTACHED TO ADJUSTMENTS OR HAZARDS SHALL BE APPROVED BY RESIDENT ENGINEER.

PAYMENT FOR ALL MATERIALS AND LABOR NECESSARY TO BE PAID FOR AS ONE 2 SQUARE STEEL SIGN POST IS FEET LONG.

OM-3 INSTALLATION

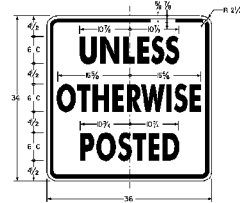

VR-208

ALL DIMENSIONS SHOWN IN INCHES UNLESS OTHERWISE NOTED.

PROJECT NAME:	STATEWIDE NORTHEAST
PROJECT NUMBER:	STPG SIGN 289
FILE NAME:	VR006.GSD
PROJECT LEADER:	A. GAMBLE
DESIGNED BY:	D. GROSSLEY
CHECKED BY:	A. GAMBLE
SIGN DETAILS 1	SHEET 4 OF 106

PLOT DATE: 30-AUG-2000
 DRAWN BY: D.GROSSLEY
 CHECKED BY: A. GAMBLE
 SHEET 4 OF 106