






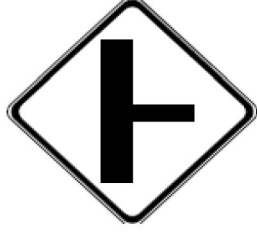


| DIRECTION | MILEPOINT | LOCATION CODE (SHEET 2) | SIGN CODE | WIDTH (IN) | HEIGHT (IN) | SHEETING REMARKS | SIGN LEGEND | NEW SIGNS | | EXISTING SIGNS | | | | EXIST POST | | NUMBER OF NEW POSTS | SQUARE STEEL (IN) | | | TUBULAR STEEL Ø (IN) | | | | SIGN FRAME REQUIRED | REMARKS | SIGN DETAIL | | |
|----------------------------------|-----------|-------------------------|-----------|------------|-------------|------------------|---|-----------|------|----------------|--------------|------------|--------|------------|--------|---------------------|-------------------|------|------|----------------------|------|------------------------------|---|--|-----------------------|----------------------|------------------------|----------------------------|
| | | | | | | | | "A" | "B" | RETAIN | SALVAGE FROM | SALVAGE TO | REMOVE | RETAIN | REMOVE | | 1.75 | 2.00 | 2.50 | 3.00 | 3.50 | 4.00 | 5.00 | | | DETAIL IN SHS | DETAIL ON SHEET NUMBER | DETAIL ON STD SHEET NUMBER |
| | | | | | | | | | | | | | | | | | (LB / FT) | | | (LB / FT) | | | | | | | | |
| GLOVER NB | | | | | | | FY-FLUORESCENT YELLOW FYG-FLUORESCENT YELLOW GREEN | | | | | | | | | | | | | | | "SHS"-STANDARD HIGHWAY SIGNS | | | | | | |
| NB | 1.945 | A | W2-2 R | 30 | 30 | |  | 6.25 | | | | | | | | | | X | | | | | | INSTALL 250'+/- SOUTH OF SQUARE RD. | X | | | |
| NB | 1.990 | C | VR-017 | 24 | 30 | |  | | | | 1 | | | | | | | | | | | | SQUARE RD TH-4 | | | | | |
| NB | 2.115 | A | W1-2 L | 30 | 30 | |  | 6.25 | | | | | | | | | | X | | | | | | INSTALL 265'+/- WEST OF EB GUARD RAIL BEGIN. | X | | | |
| NB | 2.003 | D | R1-1 | 30 | 30 | | STOP | | | | 1 | | | | | | | | | | | | SQUARE RD TH-4 | | | | | |
| NB | 2.300 | A | S3-1 | 30 | 30 | | SCHOOL BUS STOP AHEAD | | | | 1 | | | | | | | | | | | | | | | | | |
| NB | 2.700 | A | M1-5A | 24 | 24 | | ROUTE 16 | | | | | | 1 | | | | | | | | | | | | | | | |
| NB | 3.518 | C | VR-017 | 24 | 30 | |  | | | | | | 1 | | | | | | | | | | SAND HILL TH-42 | | | | | |
| | | C | VR-017 | 24 | 30 | | | 5.00 | | | | | | | | | | X | | | | | | | | | | |
| NB | 3.526 | D | R1-1 | 24 | 24 | |  | | | | | | 1 | | | | | | | | | | SAND HILL TH-42 | | | | | |
| | | D | R1-1 | 30 | 30 | | | 6.25 | | | | | | | | | | X | | | | | | | | | | |
| NB | 3.750 | A | VW-054 | 30 | 30 | |  | | | | | | 1 | | | | | | | | | | | | | | | |
| | | | | | | | HIDDEN DRIVE RIGHT | | | | | | | | | | | | | | | | | | | | | |
| NB | 3.815 | A | VW-054 | 30 | 30 | |  | 6.25 | | | | | | | | | | X | | | | | INSTALL 320' +/- NORTH OF ORIGINAL LOCATION | | | E-154 | | |
| NB | 3.965 | C | VR-017 | 24 | 30 | |  | | | | | | 1 | | | | | | | | | | PARISH SCHOOL RD TH-41 | | | | | |
| | | C | VR-017 | 24 | 30 | | | 5.00 | | | | | | | | | | X | | | | | | | | | | |
| SIGN SUMMARY SHEET | | | | | | | SHEET TOTALS | 35.00 | 0.00 | 3 | 0 | 0 | 5 | 0 | 0 | 6 | 90 | | | | | | | PROJECT NAME: STATEWIDE NORTHEAST | | | | |
| VERMONT AGENCY OF TRANSPORTATION | | | | | | | TOWN DIRECTIONAL TOTALS | SF | SF | EA | EA | EA | EA | EA | EA | EA | FT | | | | | | | PROJECT NUMBER: STPG SIGN (29) | FILE NAME: GLOVER NB | PLOT DATE: 8/18/2010 | | |
| | | | | | | | | | | | | | | | | | | | | | | | | PROJECT MANAGER: A. GAMBLE | DRAWN BY: D. CROSSLEY | | | |
| | | | | | | | | | | | | | | | | | | | | | | | | DESIGNED BY: D. CROSSLEY | CHECKED BY: A. GAMBLE | | | |
| | | | | | | | | | | | | | | | | | | | | | | | | GLOVER VT 16 NB 2 | SHEET 39 | OF | 138 | |