



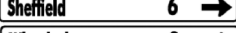
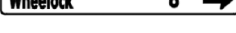


DIRECTION	MILEPOINT	LOCATION CODE (SHEET Z)	SIGN CODE	WIDTH (IN)	HEIGHT (IN)	SHEETING REMARKS	SIGN LEGEND	NEW SIGNS		EXISTING SIGNS				EXIST POST		SQUARE STEEL (IN)			TUBULAR STEEL Ø (IN)				SIGN FRAME REQUIRED	REMARKS	SIGN DETAIL								
								"A"	"B"	RETAIN	SALVAGE FROM	SALVAGE TO	REMOVE	RETAIN	REMOVE	NUMBER OF NEW POSTS	1.75	2.00	2.50	FOUNDATION	3.00	3.50			4.00	5.00	DETAIL IN SHS	DETAIL ON SHEET NUMBER	DETAIL ON STD SHEET NUMBER				
																	(LB / FT)				(LB / FT)												
GLOVER NB							FY-FLUORESCENT YELLOW FYG-FLUORESCENT YELLOW GREEN																"SHS" STANDARD HIGHWAY SIGNS										
NB	3.976	D	R1-1	30	30						1		X													PARISH SCHOOL RD TH-41		X					
		D	R1-1	30	30			6.25																									
NB	4.410	A	W2-1	21	15								X																				
		A	M1-5	30	24																												
		A	W2-1	21	15			2.19																									
		A	M1-5	30	24			6.25																							E-136B		
NB	4.450	A	D1-1A	72	10								X																				
		A	D1-1A	72	10																												
		A	D1-1A	72	10																												
		A	D1-1A	72	10																												
		A	D1-1A	72	12			6.00							2																	4	
		A	D1-1A	72	12			6.00																								4	
		A	D1-1A	72	12			6.00																								4	
		A	D1-1A	72	12			6.00																								4	
NB	4.490	A	W3-1	24	12								X																				
SIGN SUMMARY SHEET							SHEET TOTALS	38.69	0.00	0	0	1	2	0	0	4	60																
								SF	SF	EA	EA	EA	EA	EA	EA	EA	EA	EA	EA	EA	EA	EA	EA	EA	EA	EA	EA	EA	EA	EA	EA	EA	
VERMONT AGENCY OF TRANSPORTATION							TOWN DIRECTIONAL TOTALS	251.7	0.0	5.0	2.0	2.0	54	0.0	0.0	40	600.0																
												PROJECT NAME: STATEWIDE NORTHEAST PROJECT NUMBER: STPG SIGN (29)				FILE NAME: GLOVER NB PROJECT MANAGER: A. GAMBLE DESIGNED BY: D. CROSSLEY GLOVER-VT-16 NB-3				PLOT DATE: 8/19/2010 DRAWN BY: D. CROSSLEY CHECKED BY: A. GAMBLE SHEET 40 OF 138													