







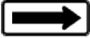

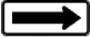


DIRECTION	MILEPOINT	LOCATION CODE (SHEET Z)	SIGN CODE	WIDTH (IN)	HEIGHT (IN)	SHEETING REMARKS	SIGN LEGEND	NEW SIGNS		EXISTING SIGNS				EXIST POST		SQUARE STEEL (IN)			TUBULAR STEEL (IN)				SIGN FRAME REQUIRED	REMARKS	SIGN DETAIL								
								"A"	"B"	RETAIN	SALVAGE FROM	SALVAGE TO	REMOVE	RETAIN	REMOVE	NUMBER OF NEW POSTS	1.75	2.00	2.50	3.00	3.50	4.00			5.00	DETAIL IN SHS	DETAIL ON SHEET NUMBER	DETAIL ON STD SHEET NUMBER					
																	(LB / FT)			(LB / FT)													
<b>NEWBURY WB</b>							FY-FLUORESCENT YELLOW FYG-FLUORESCENT YELLOW GREEN																"SHS" STANDARD HIGHWAY SIGNS										
0302_US302																																	
WB	4.810	E		24	30		MEMORIAL BRIDGE SIGN		1					X																			
WB	4.905	E	W1-6	48	24					1				X																			
		E	W1-6	48	24			8.00							2	X											X						
WB	4.904	G	VR-017	24	30					1				X																			
		G	VR-017	24	30			5.00							1	X											E-141						
WB	4.899	H	R1-1	30	30					1				X																			
		H	R1-1	30	30			6.25							1	X											X						
WB	4.891	F	M1-4	24	24					1				X																			
		F	M6-1	21	15					1																							
		F	M3-4	24	12			2.00							1	X											X						
		F	M1-4 L	30	24			5.00																			X						
		F	M6-1	21	15			2.19																			X						
WB	4.890	F	VD-421A	60	48					1				*																			
		F	VD-421A	60	48			20.00							0																		
<b>SIGN SUMMARY SHEET</b>							<b>SHEET TOTALS</b>	48.44	0.00	1	0	0	6	0	0	7	105																
VERMONT AGENCY OF TRANSPORTATION							<b>TOWN DIRECTIONAL TOTALS</b>	216.0	0.0	6.0	2.0	2.0	57	0.0	0.0	29	435.0																
																PROJECT NAME: STATEWIDE NORTHEAST		PROJECT NUMBER: STPG SIGN (29)		PLOT DATE: 8/19/2010		DRAWN BY: D. CROSSLEY		CHECKED BY: A. GAMBLE		DESIGNED BY: D. CROSSLEY		NEWBURY US 302 WB-1		SHEET 68		OF 138	