

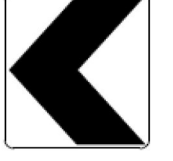
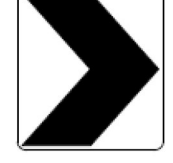
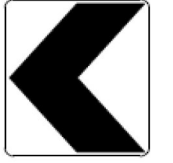
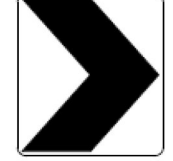


DIRECTION	MILEPOINT	LOCATION CODE (SHEET 2)	SIGN CODE	WIDTH (IN)	HEIGHT (IN)	SHEETING REMARKS	SIGN LEGEND	NEW SIGNS		EXISTING SIGNS				EXIST POST		NUMBER OF NEW POSTS	SQUARE STEEL (IN)			TUBULAR STEEL Ø (IN)				SIGN FRAME REQUIRED	REMARKS	SIGN DETAIL							
								"A"	"B"	RETAIN	SALVAGE FROM	SALVAGE TO	REMOVE	RETAIN	REMOVE		1.75	2.00	2.50	3.00	3.50	4.00	5.00			DETAIL IN SHS	DETAIL ON SHEET NUMBER	DETAIL ON STD SHEET NUMBER					
																	(LB / FT)			(LB / FT)													
																1.88	2.42	3.35	FOUNDATION	7.60	9.00	10.80	14.60										
BRADFORD VT25 SB							FY-FLUORESCENT YELLOW FYG-FLUORESCENT YELLOW GREEN																"SHS"-STANDARD HIGHWAY SIGNS										
0250,VT25																																	
SB	6.740	G	VR-017	24	30		LLL 24,000 LBS			1																		TAPLIN HILL RD TH-4					
SB	6.732	H	R1-1	30	30		STOP			1																		TAPLIN HILL RD TH-4					
SB	6.632	F	W11-4	30	30		COW SYMBOL						1																				
SB	6.280	F	W1-4L	30	30		LEFT REVERSE CURVE						1																				
		F	W13-1	18	18		35 MPH						1																				
SB	6.25	F	W1-5L	30	30	FY		6.25						1			X											INSTALL BEHIND END OF GUARD RAIL	X				
		F	W7-3A	18	18	FY		2.25																					X				
SB	6.181	F	VD-062B	72	16		BUSINESS SIGN			1																							
		F	VD-062B	72	16		BUSINESS SIGN			1																							
SB	6.2	F	W1-8 L	18	24	FY		3.00						1			X											INSTALL AT MM 0620	X				
SB	6.201	E	W1-8 R	18	24	FY		3.00						1			X												X				
SB	6.172	F	W1-8 L	18	24	FY		3.00						1			X											INSTALL MIDWAY BETWEEN BUSINESS SIGNS AND BEGINNING OF GUARD RAIL	X				
SB	6.172	E	W1-8 R	18	24	FY		3.00						1			X												X				
SB	6.140	F	W2-2R	30	30									1																	X		
SIGN SUMMARY SHEET							SHEET TOTALS	20.50	0.00	4	0	0	4	0	0	5	75																
VERMONT AGENCY OF TRANSPORTATION							TOWN DIRECTIONAL TOTALS	432.2	0.0	12.0	0.0	0.0	87	0.0	0.0	76	1140.0																
																PROJECT NAME: STATEWIDE NORTHEAST						PROJECT NUMBER: STPG SIGN (29)											
																FILE NAME: BRADFORD VT 25 SB						PLOT DATE: 8/23/2010											
																PROJECT MANAGER: A. GAMBLE						DRAWN BY: D. CROSSLEY											
																DESIGNED BY: D. CROSSLEY						CHECKED BY: A. GAMBLE											
																BRADFORD VT 25 SB 1						SHEET 92 OF 138											