


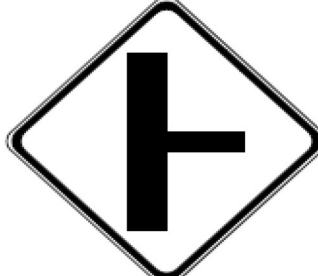
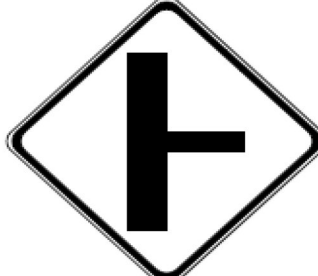




DIRECTION	MILEPOINT	LOCATION CODE (SHEET 2)	SIGN CODE	WIDTH (IN)	HEIGHT (IN)	SHEETING REMARKS	SIGN LEGEND	NEW SIGNS		EXISTING SIGNS				EXIST POST		NUMBER OF NEW POSTS	SQUARE STEEL (IN)			TUBULAR STEEL Ø (IN)				SIGN FRAME REQUIRED	REMARKS	SIGN DETAIL		
								"A"	"B"	RETAIN	SALVAGE FROM	SALVAGE TO	REMOVE	RETAIN	REMOVE		1.75	2.00	2.50	3.00	3.50	4.00	5.00			DETAIL IN SHS	DETAIL ON SHEET NUMBER	DETAIL ON STD SHEET NUMBER
																	(LB / FT)			(LB / FT)								
BRADFORD US5 SB							FY-FLUORESCENT YELLOW FYG-FLUORESCENT YELLOW GREEN															"SHS"-STANDARD HIGHWAY SIGNS						
SB	3.185	F	R1-1	30	30		STOP			1														PRIVATE DRIVE				
SB	3.165	F	S4-3 P	24	8		SCHOOL			1																		
		F	S4-3 P	24	8	FYG		1.33																				
		F	R2-1	24	30		SPEED LIMIT 25			1																		
		F	S4-4P	24	10		WHEN FLASHING 			1																		
SB	3.155	F	R8-3A	24	24			4.00						1	X									INSTALL AT POLE WITH METER	X			
SB	3.135	F	W2-2R	30	30		RIGHT SIDE ROAD					1																
		F	N/A	30	30		SCHOOL BUSES TURNING					1																
		F	VD-062B	72	16		BUSINESS SIGN OXBOW VET CLINIC <===							2	X													
		F	VD-062B	72	16		BUSINESS SIGN SOUTH END MARKET ^UP					1																
SB	3.100	F	VD-062B	72	16		BUSINESS SIGN OXBOW VET CLINIC <===			1																		
		F	VD-062B	72	16		 SOUTH END MARKET ^UP					1																
		F	W2-2R	30	30			6.25						2	X										X			
		F	W16-8	36	8		Fairground Rd 	2.00																		7		
SB	3.065	F	R8-3A	24	24			4.00						1	X									INSTALL 50' +/-SOUTH OF POLE	X			
SIGN SUMMARY SHEET							SHEET TOTALS	17.58	0.00	4	2	2	2	0	0	6	90					PROJECT NAME: STATEWIDE NORTHEAST PROJECT NUMBER: STPG SIGN (29)						
VERMONT AGENCY OF TRANSPORTATION							TOWN TOTALS	531.1	0.0	13.0	4.0	4.0	95	0.0	0.0	85	1275.0					FILE NAME: BRADFORD US5 SB PROJECT MANAGER: A. GAMBLE DESIGNED BY: D. CROSSLEY BRADFORD US 5 SB 5						
																					PLOT DATE: 8/18/2010 DRAWN BY: D. CROSSLEY CHECKED BY: A. GAMBLE SHEET 124 OF 138							