



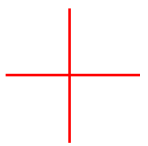


DIRECTION	MILEPOINT	LOCATION CODE (SHEET 2)	SIGN CODE	WIDTH (IN)	HEIGHT (IN)	SHEETING REMARKS	SIGN LEGEND	NEW SIGNS		EXISTING SIGNS				EXIST POST		NUMBER OF NEW POSTS	SQUARE STEEL (IN)			TUBULAR STEEL Ø (IN)				SIGN FRAME REQUIRED	REMARKS	SIGN DETAIL		
								"A"	"B"	RETAIN	SALVAGE FROM	SALVAGE TO	REMOVE	RETAIN	REMOVE		1.75	2.00	2.50	3.00	3.50	4.00	5.00			DETAIL IN SHS	DETAIL ON SHEET NUMBER	DETAIL ON STD SHEET NUMBER
																	(LB / FT)			(LB / FT)								
WILLISTON SOUTHBOUND							FY-FLUORESCENT YELLOW FYG-FLUORESCENT YELLOW GREEN															"SHS"-STANDARD HIGHWAY SIGNS						
SB	0.535	F	W11-6H	30	30		HINGED SNOWMOBILE SIGN 						1		X													
SB	0.5	F	W11-6H	30	30			6.25								1	X							INSTALL 185' SOUTH OF EXISTING SNOWMOBILE SIGN. INSTALL IN CLOSED POSITION			E-153	
SB	0.36	G	VR-017	24	30								1		X													
		G	VR-017	24	30			5.00								1	X							LINCOLN RD (TH-25)			E-141	
SB	0.345	H	R1-1	30	30								1		X													
		H	R1-1	30	30			6.25								1	X							LINCOLN RD (TH-25)	X			
SB	0.32	F	W1-2L	30	30			6.25								1	X							INSTALL 320' +/- NORTH OF LARGE ARROWS	X			
SB	0.259	F	W1-6	48	24		<===LEFT						1		X													
SB	0.258	E	W1-6	48	24		RIGHT ===>						1		X													
	0.44			30	30			6.25																				
SIGN SUMMARY SHEET							SHEET TOTALS	30.0 23.75	0.00	3 2	0	0	1 3	0	0	4	60						PROJECT NAME: Statewide - Northwest Region					
VERMONT AGENCY OF TRANSPORTATION							TOWN DIRECTIONAL TOTALS	472.7	0.0	20.0	1.0	1.0	84	0.0	0.0	67	1005.0						PROJECT NUMBER: STPG SIGN(30)					
								SF	SF	EA	EA	EA	EA	EA	EA	EA	FT						FILE NAME: Williston SB.xls	PLOT DATE: 8/11/2010				
																							PROJECT MANAGER: A. Gamble	DRAWN BY: T. Guazzoni				
																							DESIGNED BY: T. Guazzoni	CHECKED BY: A. Gamble				
																							WILLISTON VT 2A SB SHEET 14	SHEET 36 OF 131				