

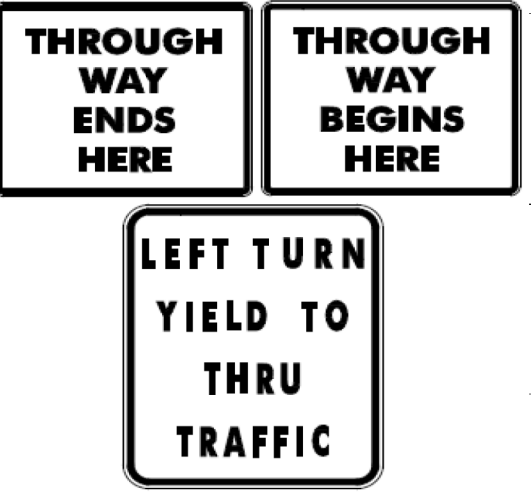


DIRECTION	MILEPOINT	LOCATION CODE (SHEET 2)	SIGN CODE	WIDTH (IN)	HEIGHT (IN)	SHEETING REMARKS	SIGN LEGEND	NEW SIGNS		EXISTING SIGNS				EXIST POST		NUMBER OF NEW POSTS	SQUARE STEEL (IN)			TUBULAR STEEL Ø (IN)				SIGN FRAME REQUIRED	REMARKS	SIGN DETAIL			
								"A"	"B"	RETAIN	SALVAGE FROM	SALVAGE TO	REMOVE	RETAIN	REMOVE		1.75	2.00	2.50	3.00	3.50	4.00	5.00			DETAIL IN SHS	DETAIL ON SHEET NUMBER	DETAIL ON STD SHEET NUMBER	
																	(LB / FT)			(LB / FT)									
MIDDLEBURY NORTHBOUND							FY-FLUORESCENT YELLOW FYG-FLUORESCENT YELLOW GREEN															"SHS"-STANDARD HIGHWAY SIGNS							
		D	R1-1	30	30			6.25							1		X							CONE DR (TH-85)	X				
NB	0.432	A	W2-2L	30	30								1																
		A	M3-1	24	12			2.00							2		X					#2B			GREEN ON WHITE SHEETING	X	7		
		A	M1-5	30	24			5.00																			E-136B		
		A	M5-1L	21	15			2.19																		GREEN ON WHITE SHEETING	X		
		A	M4-5	24	12			2.00																		GREEN ON WHITE SHEETING	X		
		A	M3-2	24	12			2.00																		GREEN ON WHITE SHEETING	X		
		A	M1-5	30	24			5.00																				E-136B	
		A	M6-3L	21	15			2.19																		GREEN ON WHITE SHEETING	X		
NB	0.480	A	VR-615	30	36								1																
		A	VR-040	24	24			4.00							1		X											E-141	
		B	VR-041	24	24			4.00																				E-141	
		A	VR-615	30	36		7.50 9.00																					6	
NB	0.525	A	D1-1A	72	10		ROUTE MARKER ASSEMBLY						1			X													
		A	D1-1A	72	10								1																
SIGN SUMMARY SHEET							SHEET TOTALS	42.13 43.63	0.00	0	0	0	4	0	0	4	60						PROJECT NAME: Statewide - Northwest Region						
VERMONT AGENCY OF TRANSPORTATION							TOWN DIRECTIONAL TOTALS	330.0	0.0	10.0	1.0	1.0	62	0.0	0.0	46	690.0						PROJECT NUMBER: STPG SIGN(30)						
								SF	SF	EA	EA	EA	EA	EA	EA	EA	FT						FILE NAME: Middlebury EB.xls	PLOT DATE: 8/11/2010					
																							PROJECT MANAGER: A. Gamble	DRAWN BY: T. Guazzoni					
																							DESIGNED BY: T. Guazzoni	CHECKED BY: A. Gamble					
																							MIDDLEBURY VT116 NB SHEET 2	SHEET 68 OF 131					