


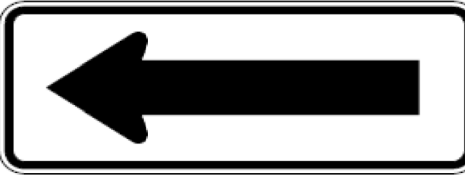




DIRECTION	MILEPOINT	LOCATION CODE (SHEET 2)	SIGN CODE	WIDTH (IN)	HEIGHT (IN)	SHEETING REMARKS	SIGN LEGEND	NEW SIGNS		EXISTING SIGNS				EXIST POST		NUMBER OF NEW POSTS	SQUARE STEEL (IN)			TUBULAR STEEL Ø (IN)				SIGN FRAME REQUIRED	REMARKS	SIGN DETAIL			
								"A"	"B"	RETAIN	SALVAGE FROM	SALVAGE TO	REMOVE	RETAIN	REMOVE		1.75	2.00	2.50	FOUNDATION	3.00	3.50	4.00			5.00	DETAIL IN SHS	DETAIL ON SHEET NUMBER	DETAIL ON STD SHEET NUMBER
																	(LB / FT)				(LB / FT)								
MIDDLEBURY SOUTHBOUND							FY-FLUORESCENT YELLOW FYG-FLUORESCENT YELLOW GREEN															"SHS"-STANDARD HIGHWAY SIGNS							
SB	4.520	F	S3-1	30	30																								
		F	S3-1	36	36	FYG																			X				
SB	4.490	F	W1-4MR	30	30																								
		F	W13-1	24	24																								
		F	W1-4MR	36	36																				6				
		F	W13-1	24	24																			X					
SB	4.425	F	VW-060	30	30																								
		F	VW-060	30	30																				7				
SB	4.330	F	W1-6	48	24																								
		F	W1-6L	48	24																			X					
SB	4.325	E	W1-6	48	24																								
		F	W1-6R	48	24																			X					
SB	4.326	G	VR-017	24	30																								
		G	VR-017	24	30																				E-141				
SB	4.319	H	R1-1	30	30																								
SIGN SUMMARY SHEET							SHEET TOTALS	47.50	0.00	0	1 0	0	10 0	0	0	8	120						PROJECT NAME: Statewide - Northwest Region						
VERMONT AGENCY OF TRANSPORTATION							TOWN DIRECTIONAL TOTALS	324.5	0.0	15.0	3.0	3.0	69	0.0	0.0	44	660.0						PROJECT NUMBER: STPG SIGN(30)	FILE NAME: Middlebury SB.xls	PLOT DATE: 8/11/2010				
																						DESIGNED BY: T. Guazzoni	DRAWN BY: T. Guazzoni	CHECKED BY: A. Gamble					
																						MIDDLEBURY VT 116 SB SHEET 2	SHEET 78	OF 131					