

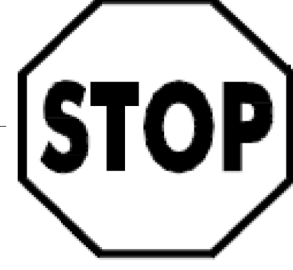



DIRECTION	MILEPOINT	LOCATION CODE (SHEET 2)	SIGN CODE	WIDTH (IN)	HEIGHT (IN)	SHEETING REMARKS	SIGN LEGEND	NEW SIGNS		EXISTING SIGNS				EXIST POST		NUMBER OF NEW POSTS	SQUARE STEEL (IN)			TUBULAR STEEL Ø (IN)				SIGN FRAME REQUIRED	REMARKS	SIGN DETAIL		
								"A"	"B"	RETAIN	SALVAGE FROM	SALVAGE TO	REMOVE	RETAIN	REMOVE		1.75	2.00	2.50	3.00	3.50	4.00	5.00			DETAIL IN SHS	DETAIL ON SHEET NUMBER	DETAIL ON STD SHEET NUMBER
																	(LB / FT)			(LB / FT)								
MIDDLEBURY SOUTHBOUND							FY-FLUORESCENT YELLOW FYG-FLUORESCENT YELLOW GREEN															"SHS"-STANDARD HIGHWAY SIGNS						
SB	0.520	F	R2-1	24	30			5.00							1	X								INSTALL 40' +/- SOUTH OF STOP SIGN	X			
SB	0.470	F	VR-041	24	24		THROUGH WAY BEGINS HERE						1															
		F	VR-041	24	24		THROUGH WAY ENDS HERE						1															
SB	0.402	G	VR-017	24	30								1											WILMAR RD (TH-42) INSTALL BEYOND STORE PARKING AREA			E-141	
		G	VR-017	24	30			5.00							1	X												
SB	0.397	H	R1-1	30	30								1															
		H	R1-1	30	30			6.25							1	X								WILMAR RD (TH-42)	X			
SB	0.230	F	R2-1	24	30								1															
		F	R2-1	24	30			5.00							1	X									X			
SB	0.180	F	M2-1	21	15								1															
		F	M1-4	24	24								1															
		F	M4-6S	24	12								1															
		F	M1-5	30	24								1															
		F	M2-1	21	15			2.19 2.25							2 4	X						#2A	BLACK ON WHITE SHEETING	X				
		F	M1-4	24	24			4.00																	X			
SIGN SUMMARY SHEET							SHEET TOTALS	27.44 27.50	0.00	0	0	0	9	0	0	5	75							PROJECT NAME: Statewide - Northwest Region				
VERMONT AGENCY OF TRANSPORTATION							TOWN DIRECTIONAL TOTALS	324.5	0.0	15.0	3.0	3.0	69	0.0	0.0	44	660.0							PROJECT NUMBER: STPG SIGN(30)				
								SF	SF	EA	EA	EA	EA	EA	EA	EA	FT							FILE NAME: Middlebury SB.xls	PLOT DATE: 8/11/2010			
																								PROJECT MANAGER: A. Gamble	DRAWN BY: T. Guazzoni			
																								DESIGNED BY: T. Guazzoni	CHECKED BY: A. Gamble			
																								MIDDLEBURY VT 116 SB SHEET 9	SHEET 85 OF 131			