


STATE OF VERMONT AGENCY OF TRANSPORTATION



INDEX OF SHEETS
SEE SHEET 2

RECORD PLANS	
CONTRACTOR:	L&D SAFETY MARKINGS CORP.-BERLIN, VT
RESIDENT ENGINEER:	MARK HAUGHWOUT
CONSTRUCTION BEGAN:	JUNE 20, 2011
CONSTRUCTION COMPLETE:	NOVEMBER 17, 2011
RECORD PLANS BY:	MARK HAUGHWOUT & JENNA HYDE
I HEREBY CERTIFY THAT ALL THE CONSTRUCTION REQUIRED BY THIS SET OF DRAWINGS HAS BEEN ACCOMPLISHED AS INDICATED HEREIN.	
BY	<i>Mark Haughwout</i> RESIDENT ENGINEER
DATE	<i>August 29, 2013</i>
NOTE: Any further information concerning final quantities, amounts or other details relative to this project may be found at Central Files in the electronic archives.	

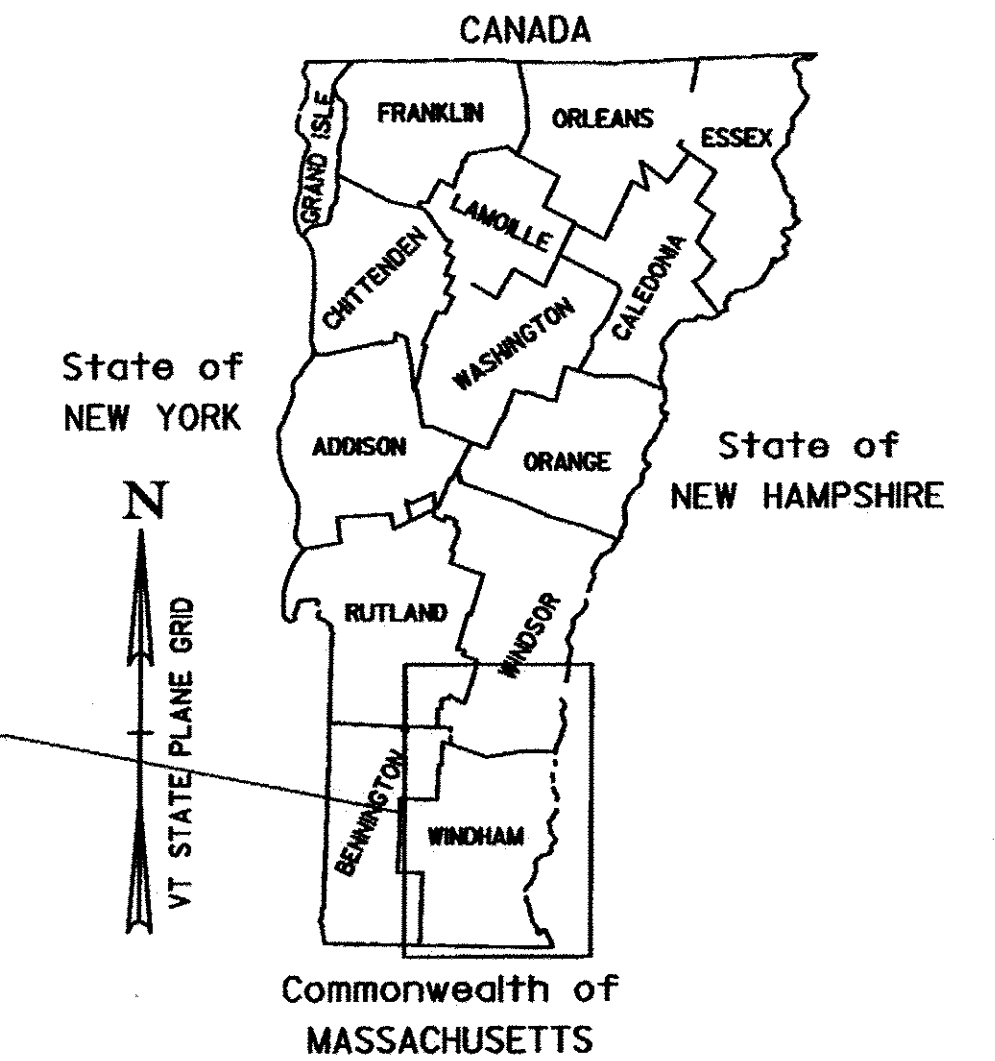

PROJECT LOCATION
STATEWIDE-SOUTHEAST REGION
STPG SIGN (3I)

PROPOSED IMPROVEMENT TOWNS OF BRATTLEBORO, NEWFANE, TOWNSHEND, ROCKINGHAM, CHESTER, SPRINGFIELD AND WEATHERSFIELD COUNTIES OF WINDHAM AND WINDSOR VERMONT ROUTES 9, 10, 30, 131 AND US ROUTE 5

SOUTHEAST REGION SIGN REPLACEMENT - 37.589 MILES ON VT 9 BRATTLEBORO MP 0.000-4.190 (EXCLUDING CLASS I), VT 30 NEWFANE MP 0.000-TOWNSHEND MP 7.357,
US 5 ROCKINGHAM MP 1,493-8,853, VT 10 CHESTER MP 0.000-SPRINGFIELD MP 0.833 AND VT 131 WEATHERSFIELD MP 0.000-8.647

LENGTH OF ROADWAY = 37.589 MILES
LENGTH OF PROJECT = 37.589 MILES

WORK TO BE PERFORMED UNDER THIS PROJECT INCLUDES THE REMOVAL OF EXISTING SIGNS AND POSTS
AND THE INSTALLATION OF NEW SIGNS, SIGN POSTS AND INCIDENTAL ITEMS.

QUALITY ASSURANCE PROGRAM: LEVEL

CONVENTIONAL SYMBOLS

COUNTY LINE	
TOWN LINE	
LIMITS OF ACCESS	
POINT OF ACCESS	
FENCE LINE	
STONE WALL	
TRAVELED WAY	
GUARD RAIL	
RAILROAD	
SURVEY LINE	
CULVERT	
POWER POLE	
TELEPHONE POLE	
TREES	
CONTROL OF ACCESS	
PROPERTY LINE	
R.O.W. TAKING LINE	
SLOPE RIGHTS	
TOP OF CUT	
TOE OF SLOPE	

SURVEYED BY : N/A
SURVEYED DATE : N/A

DATUM
VERTICAL : N/A
HORIZONTAL : N/A


CHESTER-SPRINGFIELD VT 10
CHESTER MP 0.000-3.540
SPRINGFIELD MP 0.000-0.833

NEWFANE-TOWNSHEND VT 30
NEWFANE MP 0.000-5.662
TOWNSHEND MP 0.000-7.357

WEATHERSFIELD VT 131
MP 0.000-8.647

ROCKINGHAM US 5
MP 1,493-8,853

BRATTLEBORO VT 9
MP 0.000-4.190

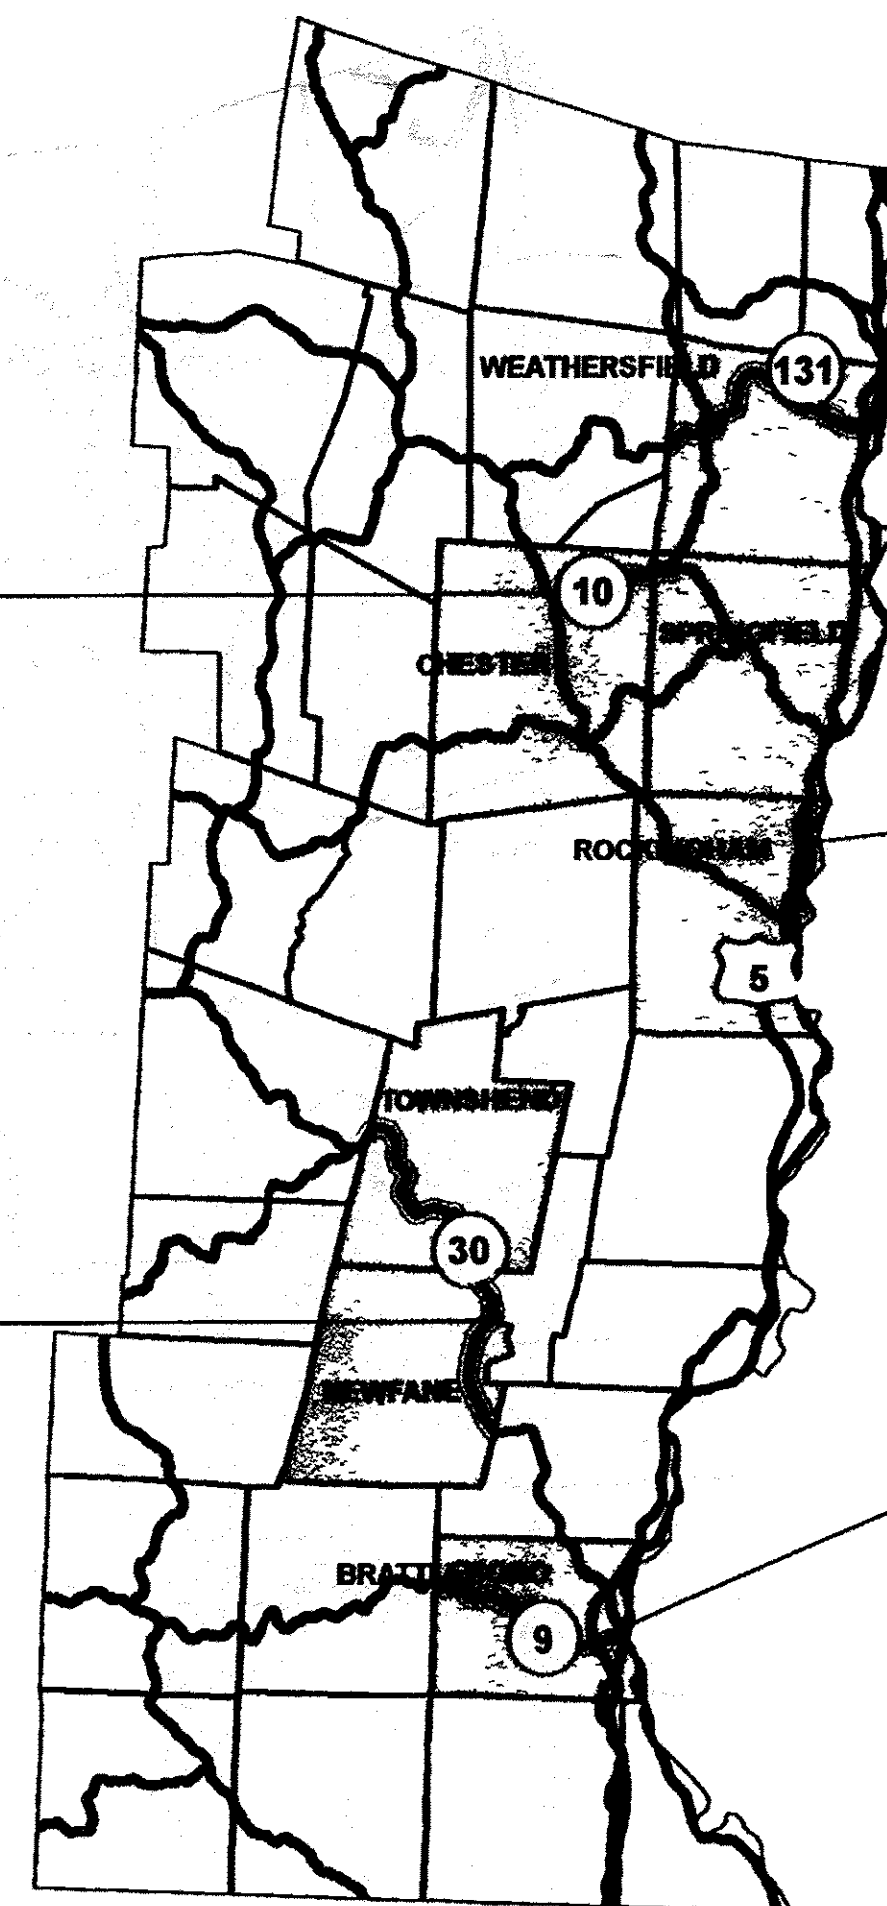

NOT TO SCALE

THESE PLANS ARE SUBJECT TO SUCH ENGINEERING CHANGES AS MAY BE REQUIRED BY THE FEDERAL HIGHWAY ADMINISTRATION OR THE DIRECTOR OF PROGRAM DEVELOPMENT.
CONSTRUCTION IS TO BE CARRIED ON IN ACCORDANCE WITH THESE PLANS AND THE STANDARD SPECIFICATIONS FOR CONSTRUCTION DATED 2006, AS APPROVED BY THE FEDERAL HIGHWAY ADMINISTRATION ON JUNE 15, 2006 FOR USE ON THIS PROJECT, INCLUDING ALL SUBSEQUENT REVISIONS AND SUCH REVISED SPECIFICATIONS AND SPECIAL PROVISIONS AS ARE INCORPORATED IN THESE PLANS.

DIRECTOR OF PROGRAM DEVELOPMENT	
APPROVED <i>Richard F. ...</i>	DATE 10-12-10
PROJECT MANAGER :	AMY GAMBLE
PROJECT NAME :	STATEWIDE - SOUTHEAST REGION
PROJECT NUMBER :	STPG SIGN (3I)
SHEET 1 OF 175 SHEETS	