





R2-1




VR-023b

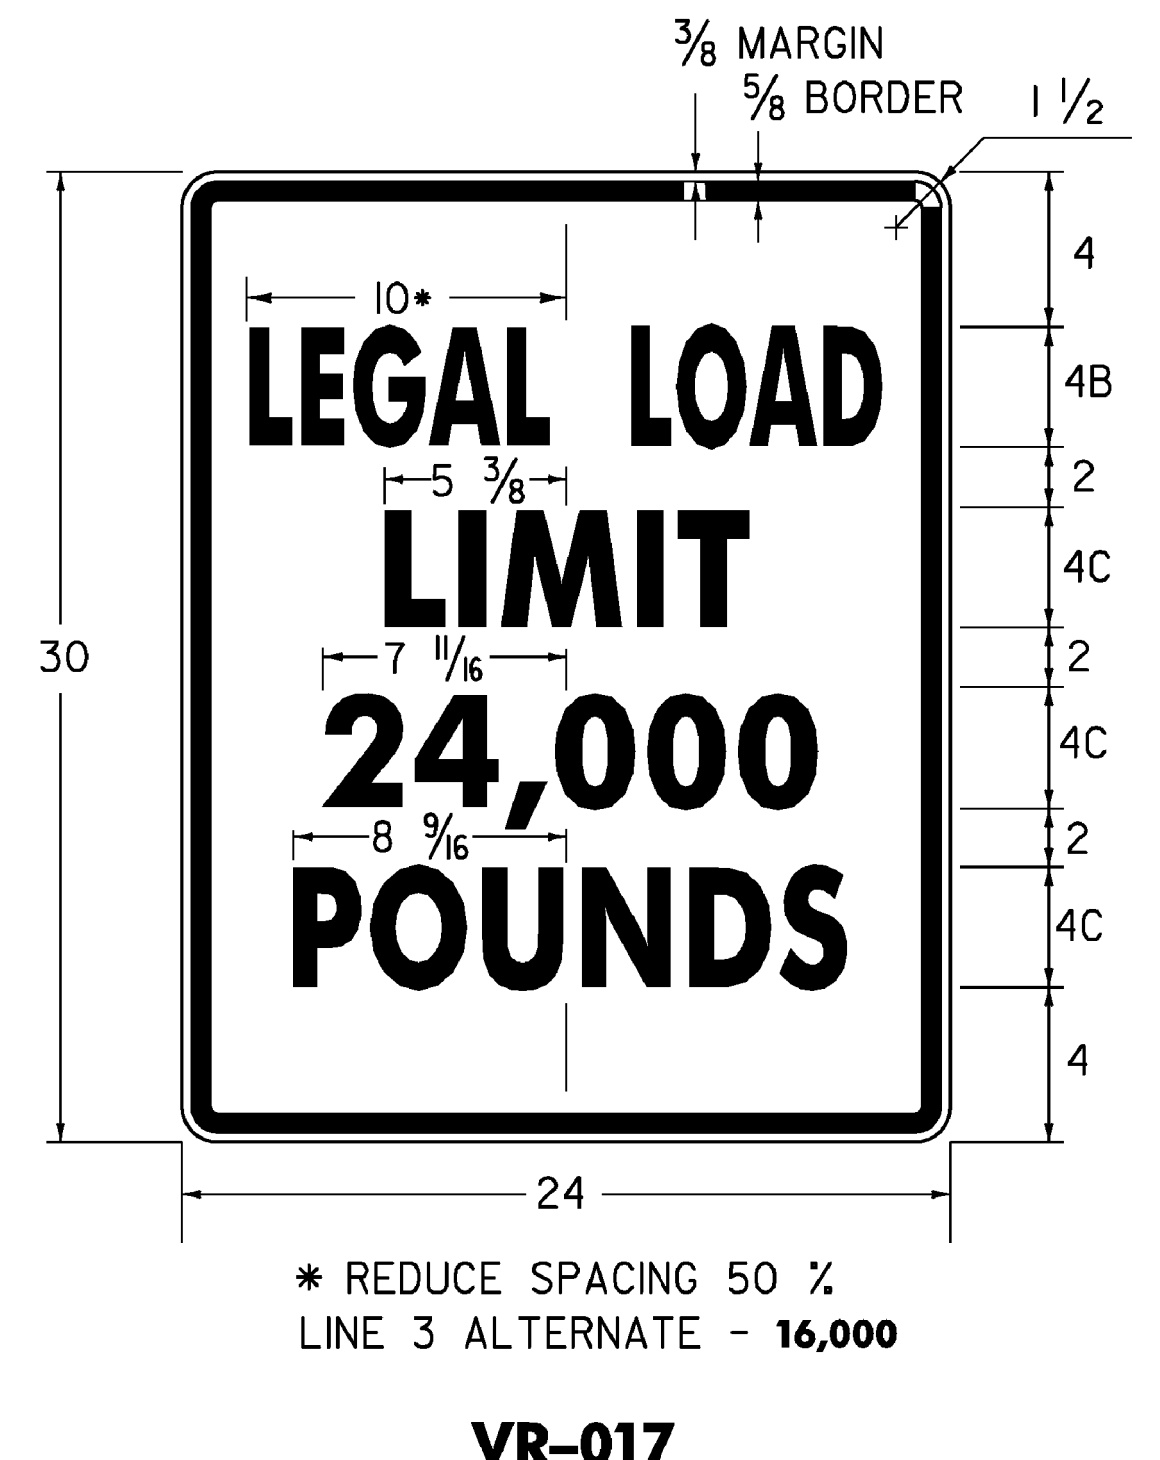


VR-017

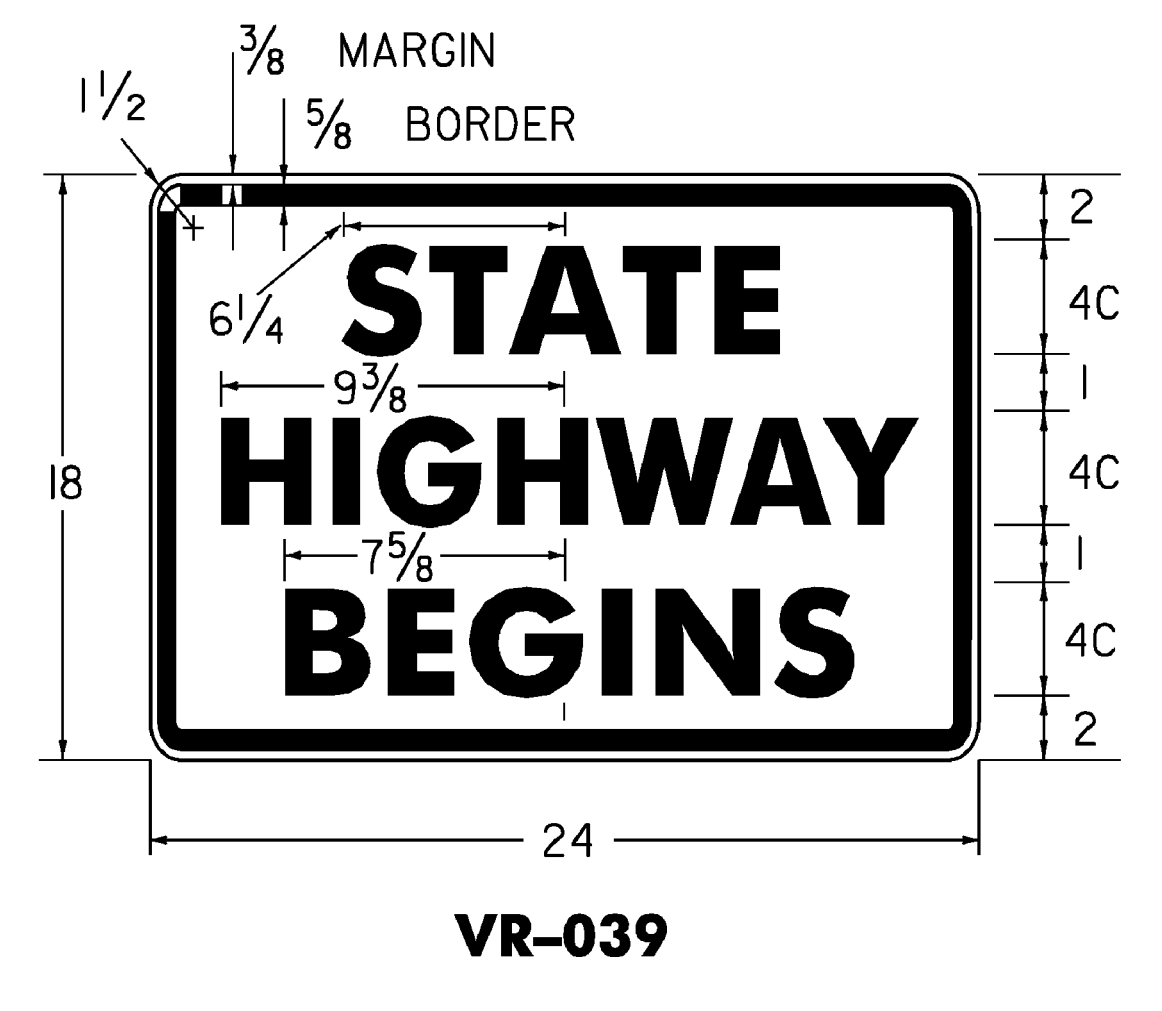


VR-039

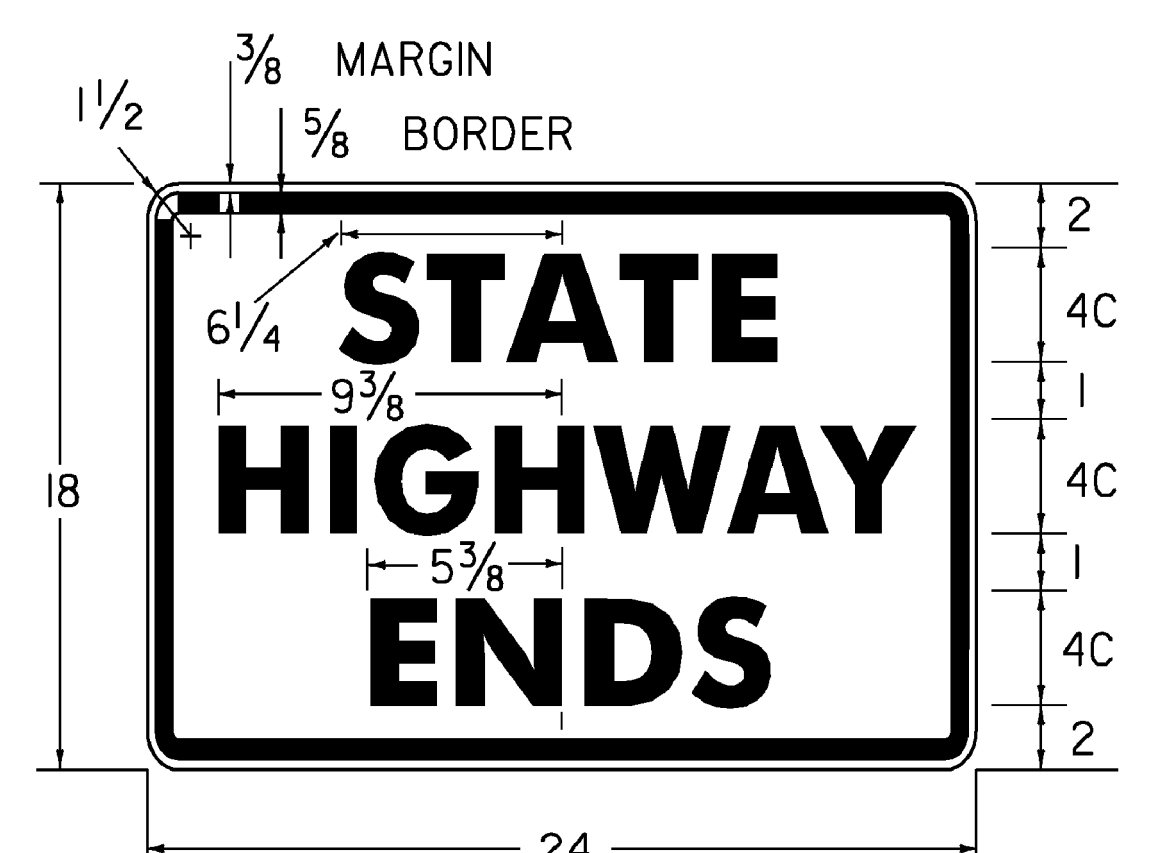


VR-038

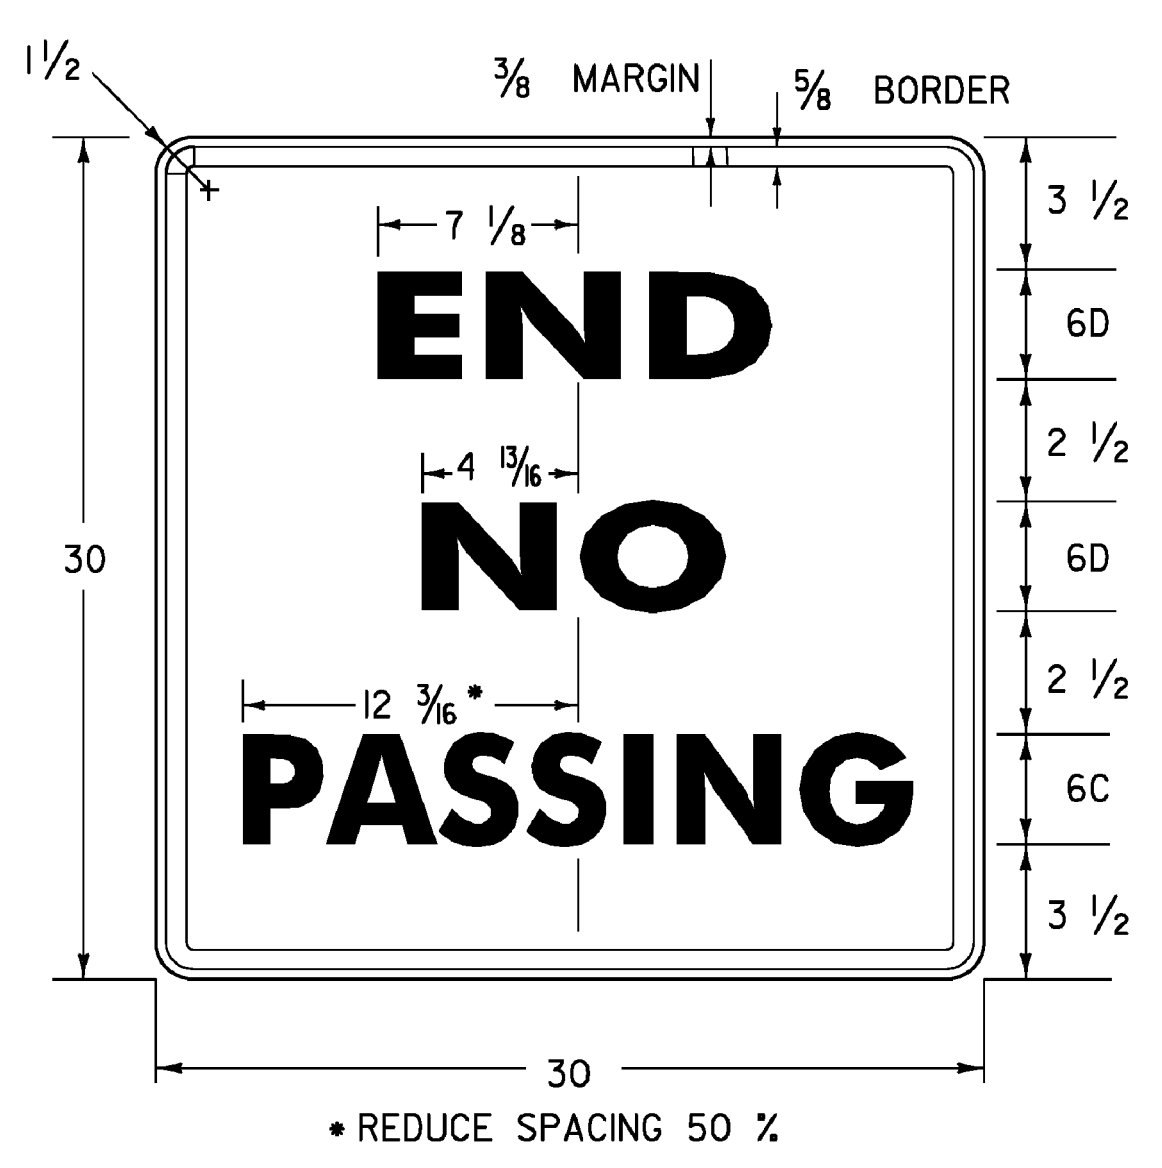


VR-417

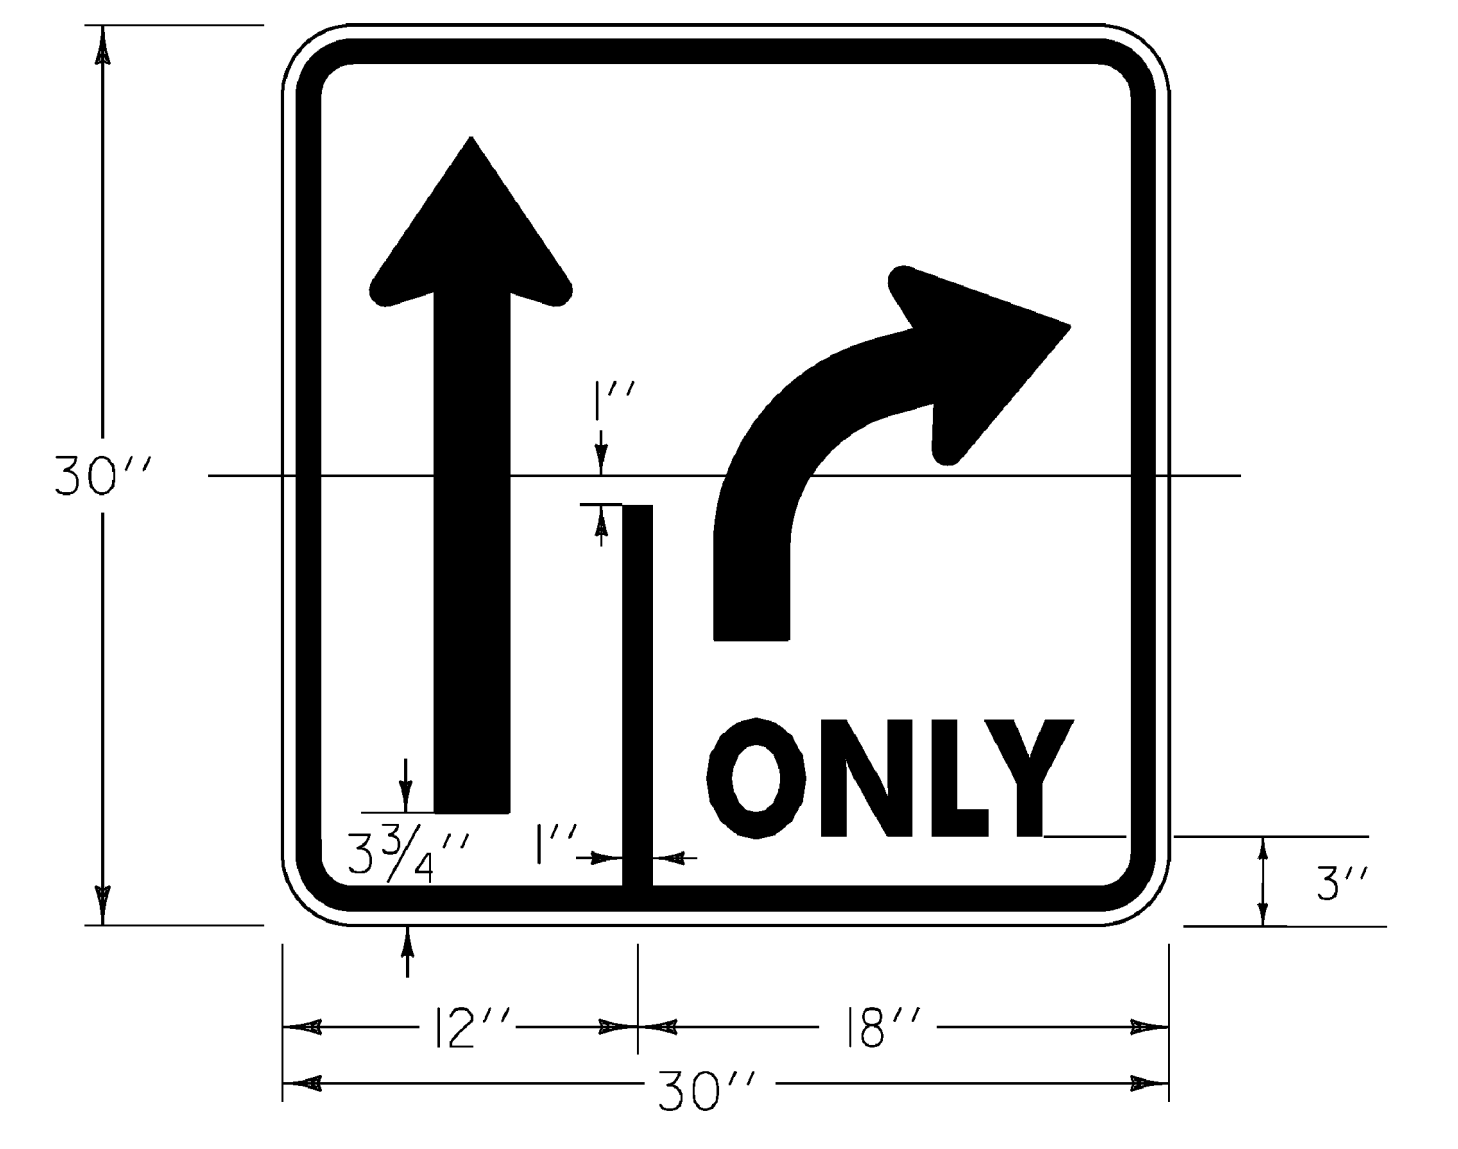


VR-921 (R)

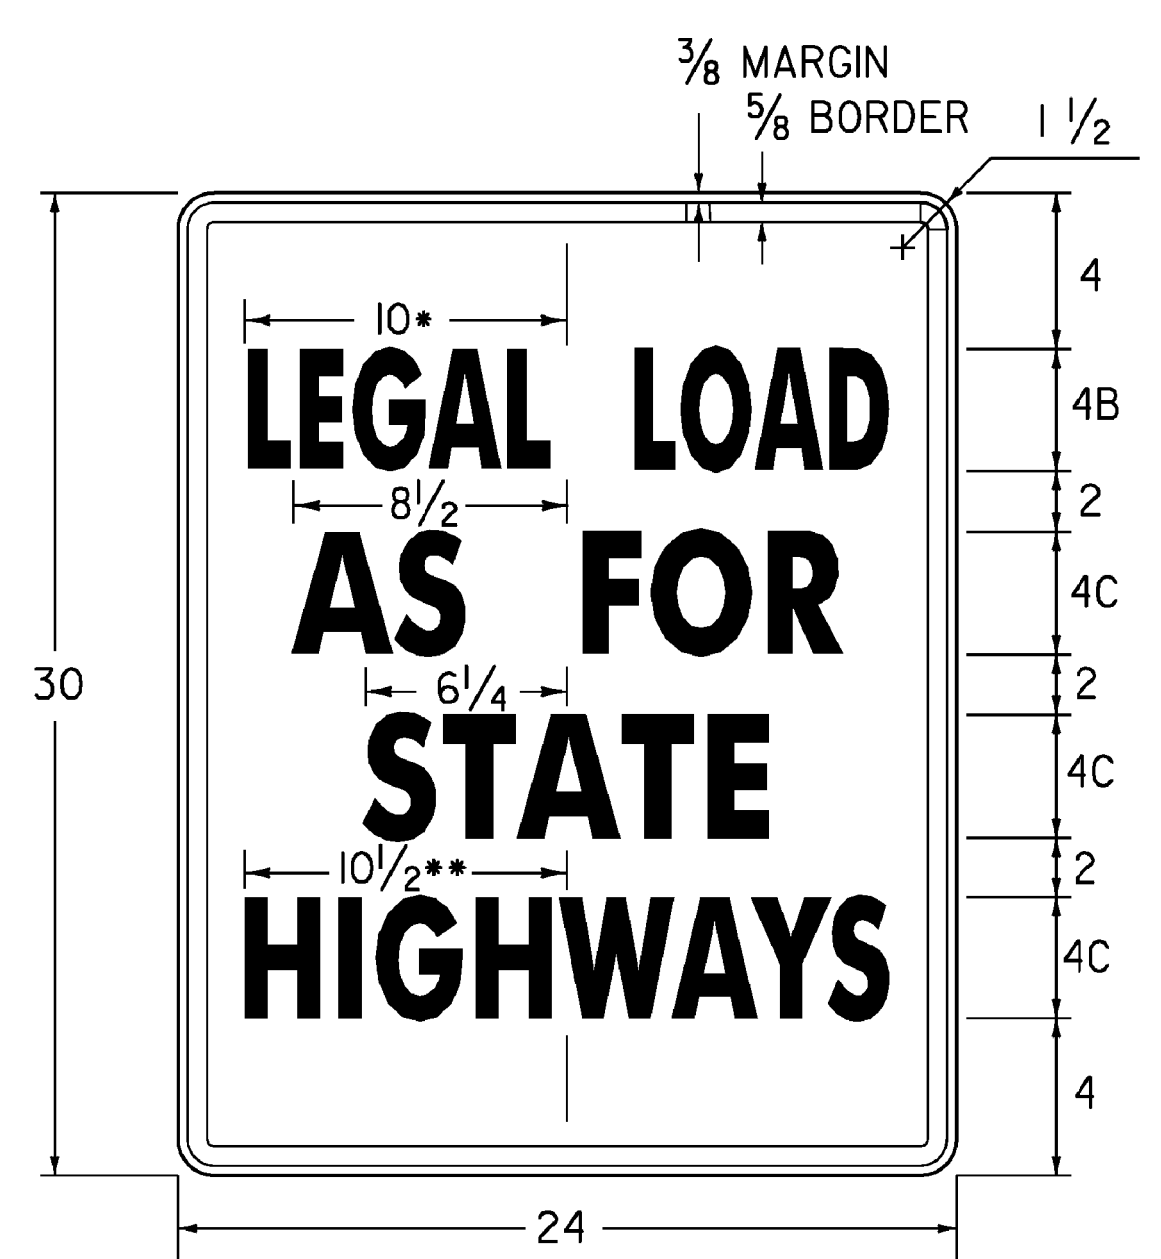

VR-079

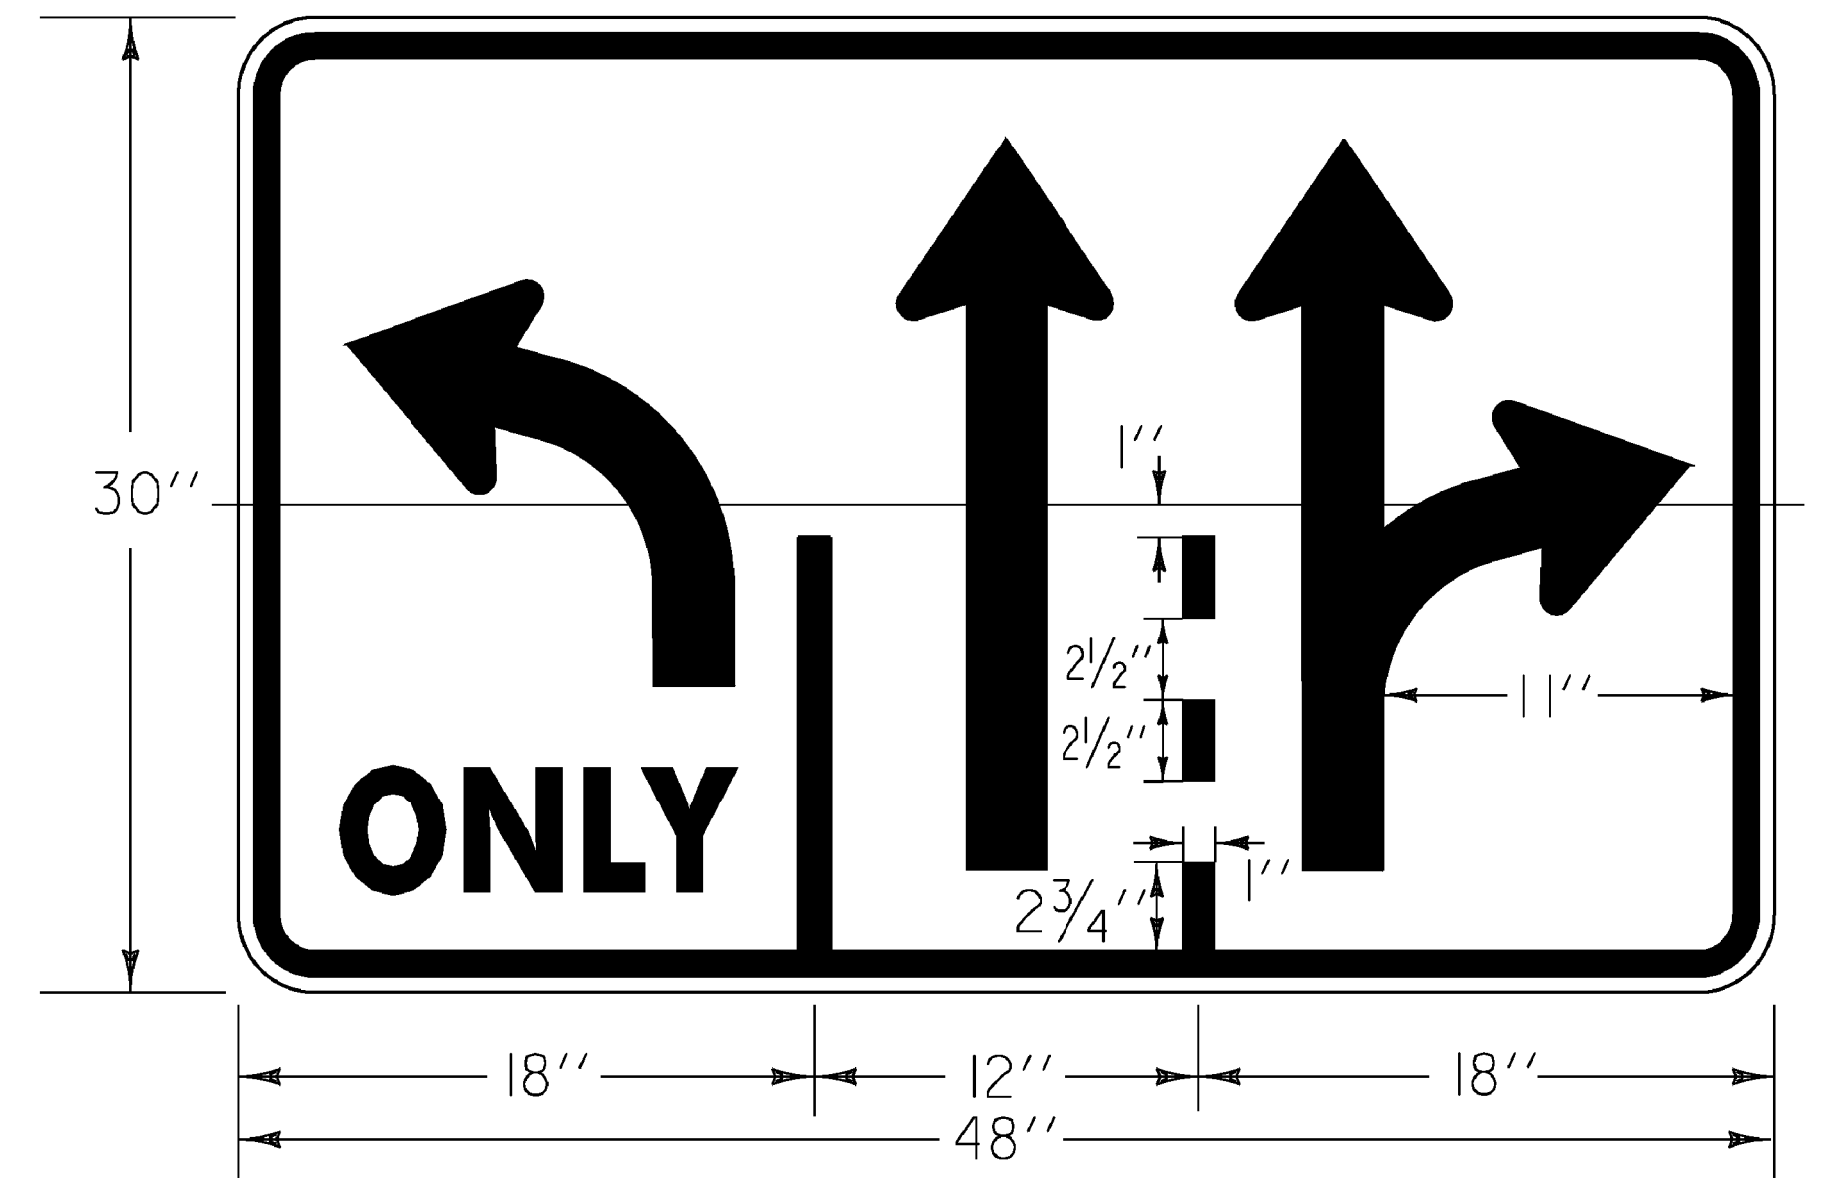


VR-934

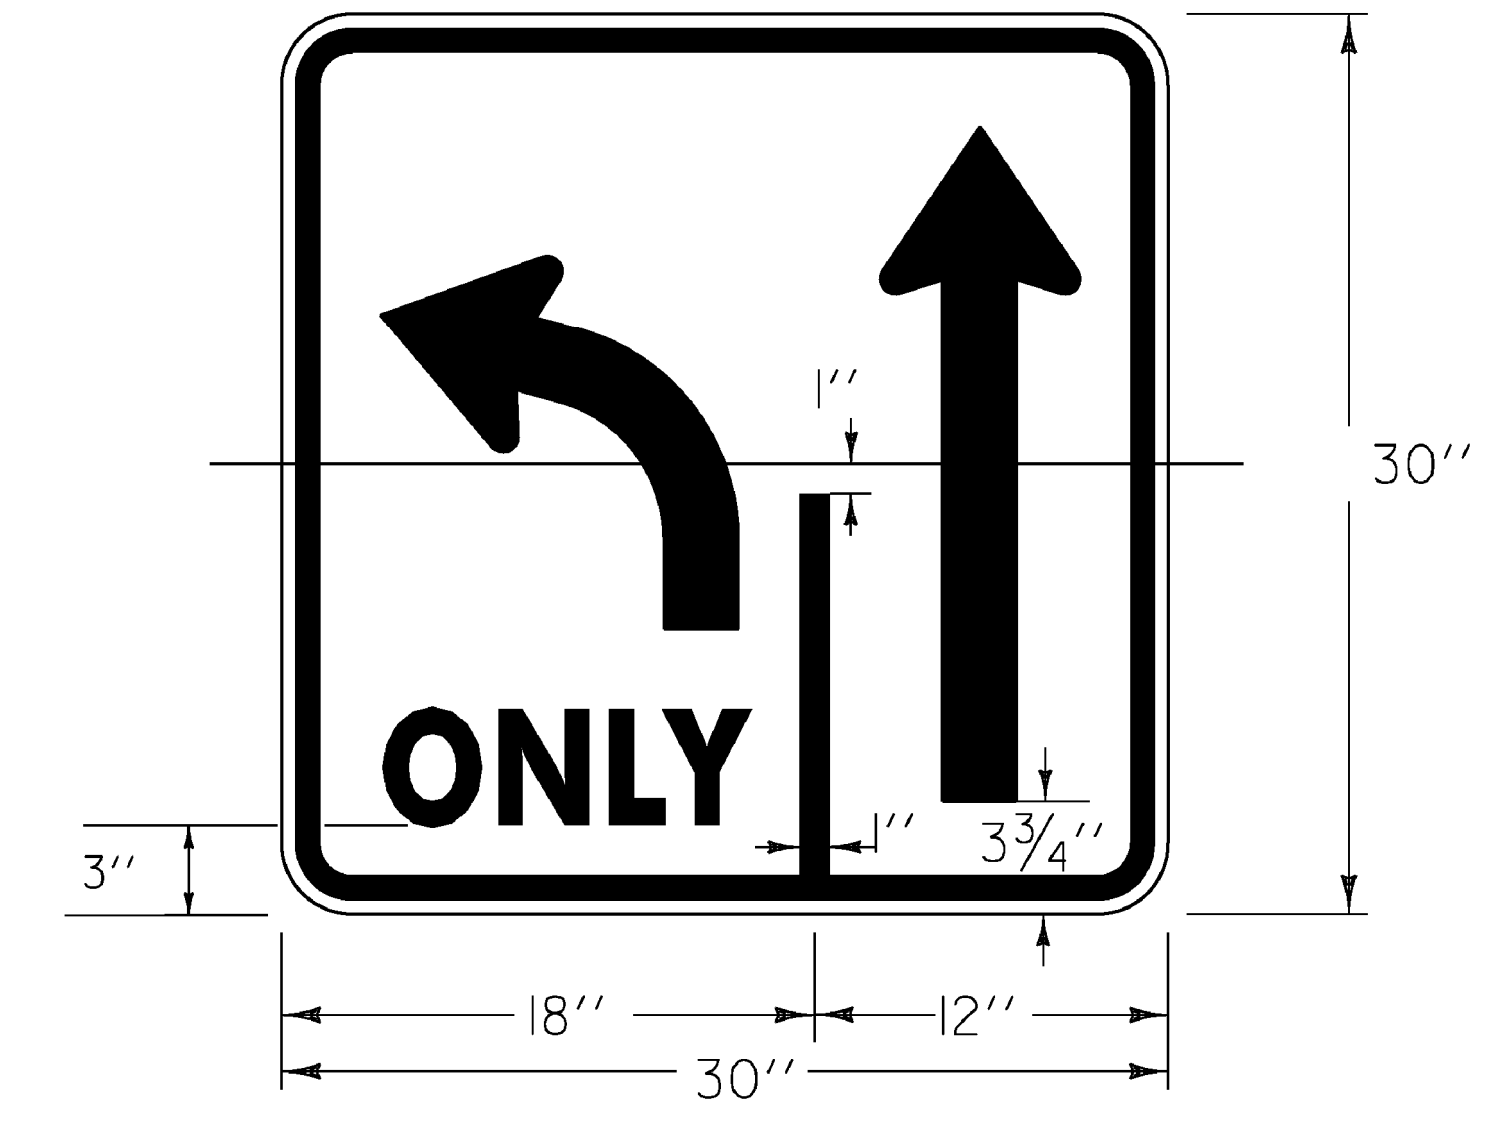


VR-921 (L)

SEE 2004 SHS FOR ADDITIONAL DIMENSIONS
 BLACK TEXT AND BORDER
 WHITE RETROREFLECTIVE BACKGROUND

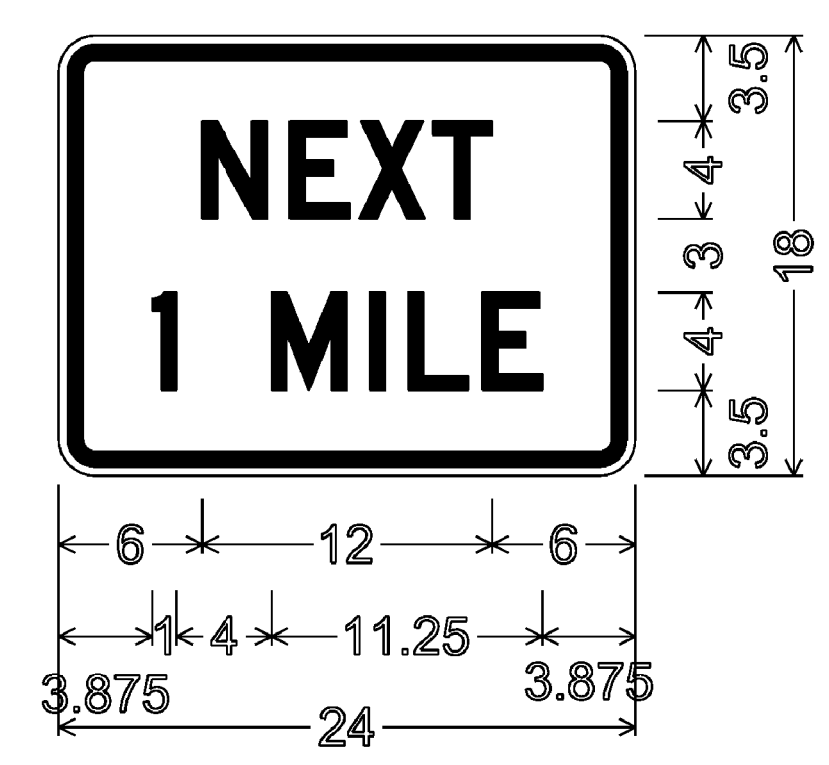


W7-3A

1.500" Radius, 0.625" Border, 0.375" Indent,
 Black on White; "NEXT" D; "1 MILE" D

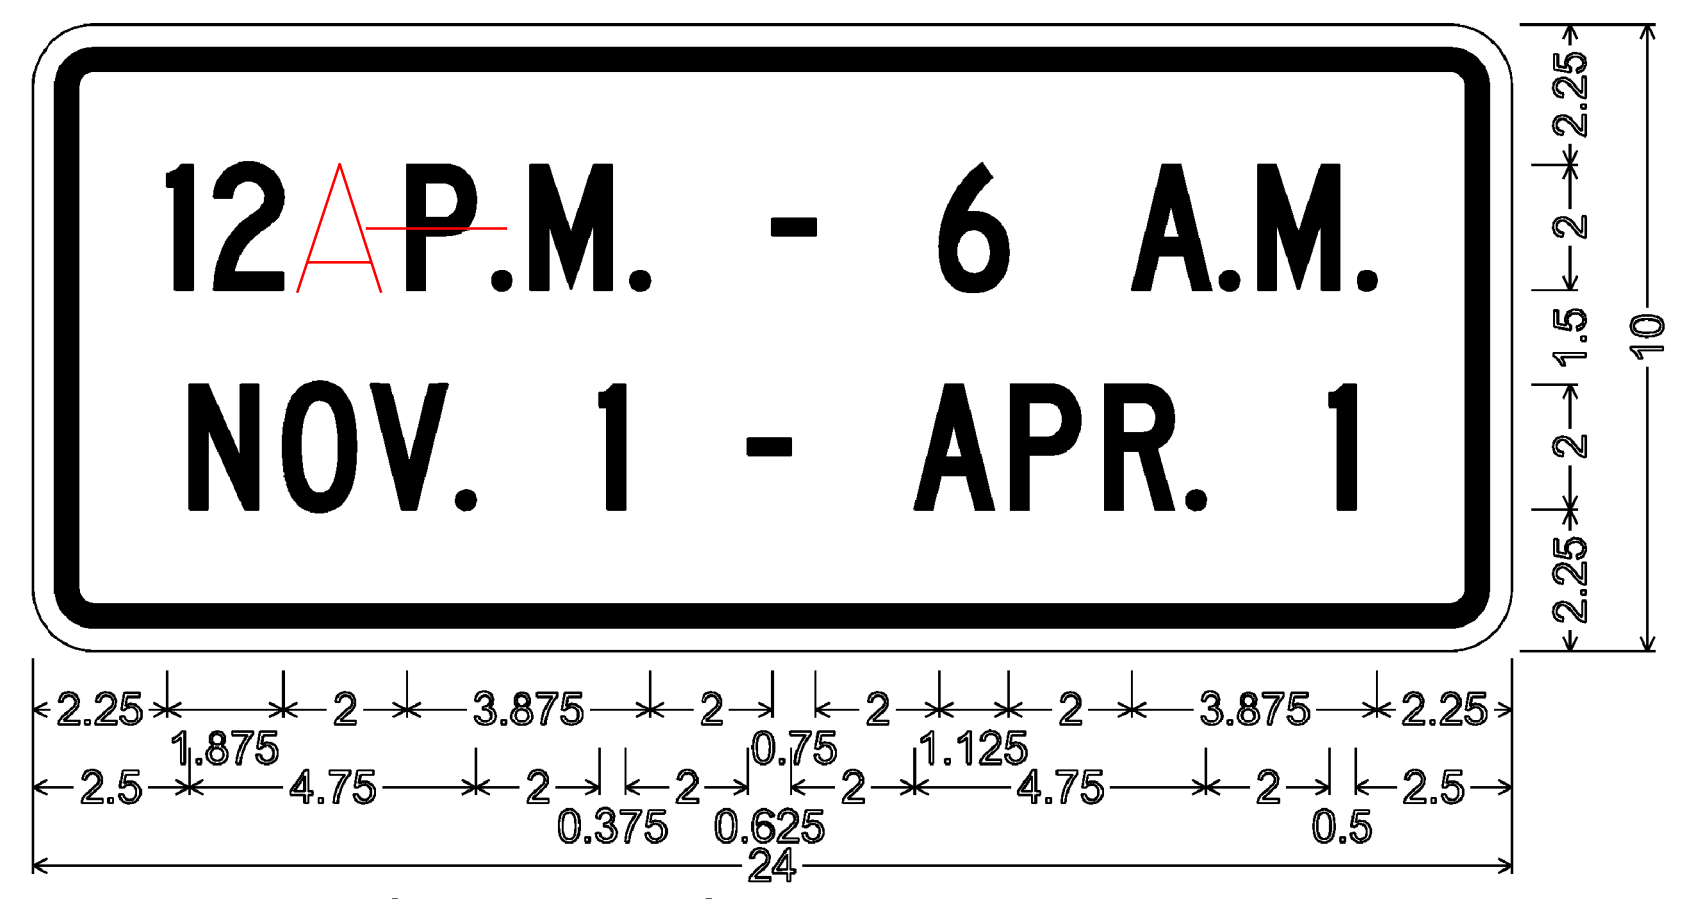

VR-071

1.000" Radius, 0.375" Border, 0.375" Indent, Black on White;
 "12 P.M. - 6 A.M." C; "NOV. 1 - APR. 1" C

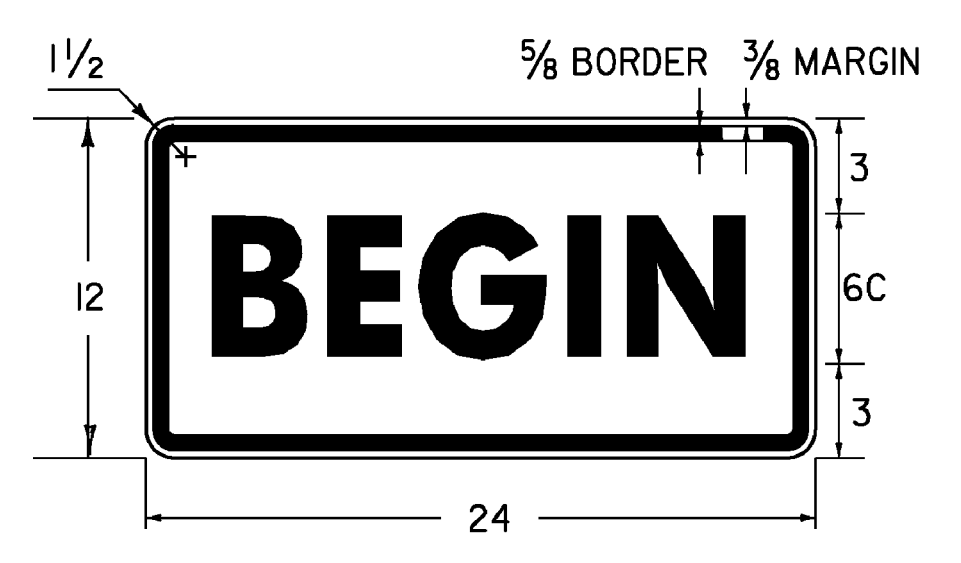

VR-644P

BLACK TEXT AND BORDER
 WHITE RETROREFLECTIVE BACKGROUND

ALL DIMENSIONS SHOWN IN INCHES EXCEPT WHERE NOTED.

PROJECT NAME:	STATEWIDE - SOUTHEAST REGION
PROJECT NUMBER:	STPG SIGN (31)
FILE NAME:	IOB010.SD_3
PROJECT LEADER:	A. GAMBLE
DESIGNED BY:	M. MILLER
SIGN DETAILS 3	
PLOT DATE:	07-OCT-2010
DRAWN BY:	M. MILLER
CHECKED BY:	A. GAMBLE
SHEET 6	OF 175