



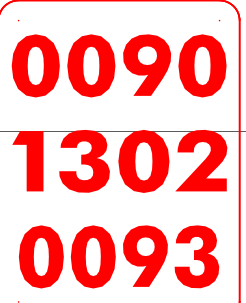



DIRECTION	MILEPOINT	LOCATION CODE (SHEET 2)	SIGN CODE	WIDTH (IN)	HEIGHT (IN)	SHEETING REMARKS	SIGN LEGEND	NEW SIGNS		EXISTING SIGNS				EXIST POST		NUMBER OF NEW POSTS	SQUARE STEEL (IN)			TUBULAR STEEL Ø (IN)				SIGN FRAME REQUIRED	REMARKS	SIGN DETAIL		
								"A"	"B"	RETAIN	SALVAGE FROM	SALVAGE TO	REMOVE	RETAIN	REMOVE		1.75	2.00	2.50	3.00	3.50	4.00	5.00			DETAIL IN SHS	DETAIL ON SHEET NUMBER	DETAIL ON STD SHEET NUMBER
																	(LB / FT)			(LB / FT)								
BRATTLEBORO WB							FY-FLUORESCENT YELLOW FYG-FLUORESCENT YELLOW GREEN															"SHS"-STANDARD HIGHWAY SIGNS						
		F	W4-2R	36	36			9.00							2	14.25' 14.75' X							NEW SYMBOL LOOKS SLIGHTLY DIFFERENT THAN EXISTING	X				
WB	1.354	F	M3-4	24	12		WEST					1											TO BE REPLACED FURTHER AHEAD					
		F	M1-5	24	24		VT-9					1																
WB	1.285	F	R2-1	24	30		SPEED LIMIT 50					1											WILL NOT BE REPLACED					
WB	1.253	F	VR-186E	24	30		TRUCK LANE ENDS					1											THIS REMOVAL POINT BEING REFERENCED FOR NEXT SIGN					
WB	1.167	F	M3-4	24	12			2.00						1	14.25; X								GREEN ON WHITE; INSTALL 450 FT ± WEST OF THE "TRUCK LANE ENDS" REMOVAL	X				
		F	M1-5	24	24			4.00																	E-136B			
WB	0.978	F	W1-2L	30	30							1											NEEDED, DUE TO ROCK FILL (BUT NOT MORE, SIGN IS AT IDEAL SPOT AT CREST OF HILL)	X				
		F	W1-2L	30	30			6.25						1	11.5' X													
WB	0.912	G	VR-017	24	30							1											HAMILTON RD (TH-8)					
		G	VR-017	24	30			5.00						1	10.25' X										6			
WB	0.905	H	R1-1	30	30		  HAMILTON RD.					1											MILE MARKER WAS RE-INSTALLED ON THE NEW POST					
		H	R1-1	30	30			6.25						1	13.0' X										X			
WB	0.865	F	M3-4	24	12		WEST					1																
		F	M1-5	24	24		VT-9					1																
SIGN SUMMARY SHEET							SHEET TOTALS	32.50	0.00	0	0	0	9	0	0	6	90 78.0 FT							PROJECT NAME: STATEWIDE SOUTHEAST REGION				
VERMONT AGENCY OF TRANSPORTATION							TOWN DIRECTIONAL TOTALS	268.5	0.0	2.0	1.0	1.0	64	0.0	0.0	47	705.0							PROJECT NUMBER: STPG SIGN (31)				
																							FILE NAME: BRATTLEBORO WESTBOUND					
																							PROJECT MANAGER: A. GAMBLE					
																							DESIGNED BY: M. MILLER					
																							BRATTLEBORO VT-9 WESTBOUND 6					
																							PLOT DATE: 8/11/2010					
																							DRAWN BY: M. MILLER					
																							CHECKED BY: A. GAMBLE					
																							SHEET 25 OF 175					