
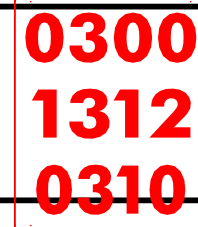







DIRECTION	MILEPOINT	LOCATION CODE (SHEET 2)	SIGN CODE	WIDTH (IN)	HEIGHT (IN)	SHEETING REMARKS	SIGN LEGEND	NEW SIGNS		EXISTING SIGNS				EXIST POST		NUMBER OF NEW POSTS	SQUARE STEEL (IN)			TUBULAR STEEL Ø (IN)				SIGN FRAME REQUIRED	REMARKS	SIGN DETAIL				
								"A"	"B"	RETAIN	SALVAGE FROM	SALVAGE TO	REMOVE	RETAIN	REMOVE		1.75	2.00	2.50	3.00	3.50	4.00	5.00			DETAIL IN SHS	DETAIL ON SHEET NUMBER	DETAIL ON STD SHEET NUMBER		
																	(LB / FT)			(LB / FT)										
NEWFANE SB							FY-FLUORESCENT YELLOW FYG-FLUORESCENT YELLOW GREEN																"SHS"-STANDARD HIGHWAY SIGNS							
		F	W7-3A	24	18			3.00																INSTALL STOP SIGN ON A SEPARATE POST (MUTCD REQ) 5 - 10 FT IN ADVANCE OF THE DO NOT ENTER / ONE WAY SIGNS BELOW.	X					
SB	3.064	G	VR-017	24	30		 LEGAL LOAD LIMIT 24000 POUNDS			1														INSTALL DO NOT ENTER AND ONE WAY SIGNS ON A SEPARATE POST ACROSS FROM THE OTHER DO NOT ENTER / ONE WAY SIGNS						
SB	3.058	H	R1-1	30	30		 STOP			1														NEWFANE-TOWNSHEND STP 2401(1) TO REPLACE IN 2010						
SB	3.021	F	R2-1	24	30							1																		
		F	R2-1	24	30			5.00																			X			
SB	2.960	G	VR-345	24	30		 NO PARKING HERE TO CORNER					1																		
		G	R7-1L	12	18			1.50																	INSTALLED PARALLEL TO ROUTE 30 IN "G" POSITION; ARROW DESIGN IN SHS	X				
SB	2.953	G	VR-017	24	30		LEGAL LOAD LIMIT 24000 POUNDS			1															COURT STREET (TH-1); NEWFANE-TOWNSHEND STP 2401(1) TO REPLACE IN 2010					
SB	2.948	H	R1-1	30	30		 STOP			1															NEWFANE-TOWNSHEND STP 2401(1) TO REPLACE IN 2010					
SB	2.902	G	VR-017	24	30		LEGAL LOAD LIMIT 24000 POUNDS			1															WEST STREET (TH-1); NEWFANE-TOWNSHEND STP 2401(1) TO REPLACE IN 2010					
SB	2.893	H	R1-1	30	30		 STOP			1															NEWFANE-TOWNSHEND STP 2401(1) TO REPLACE IN 2010					
SB	2.871	F	M3-3	24	12							1																		
		F	M1-5	24	24							1																		
		F	M3-3	24	12			2.00																	GREEN ON WHITE	X				
		F	M1-5	24	24			4.00																						
SIGN SUMMARY SHEET							SHEET TOTALS		15.50	0.00	6	0	0	4	0	0	3	45												
VERMONT AGENCY OF TRANSPORTATION							SF	SF	EA	EA	EA	EA	EA	EA	EA	EA	EA	EA	39.25											
TOWN DIRECTIONAL TOTALS							284.2	0.0	23.0	2.0	2.0	55	0.0	0.0	50	750.0														
PROJECT NAME: STATEWIDE SOUTHEAST REGION																						PROJECT NUMBER: STPG SIGN (31)								
FILE NAME: NEWFANE SOUTHBOUND												PLOT DATE: 8/12/2010																		
PROJECT MANAGER: A. GAMBLE												DRAWN BY: M. MILLER																		
DESIGNED BY: M. MILLER												CHECKED BY: A. GAMBLE																		
NEWFANE VT-30 SOUTHBOUND 4												SHEET 41 OF 175																		