

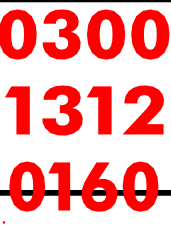





DIRECTION	MILEPOINT	LOCATION CODE (SHEET 2)	SIGN CODE	WIDTH (IN)	HEIGHT (IN)	SHEETING REMARKS	SIGN LEGEND	NEW SIGNS		EXISTING SIGNS				EXIST POST		NUMBER OF NEW POSTS	SQUARE STEEL (IN)			TUBULAR STEEL Ø (IN)				SIGN FRAME REQUIRED	REMARKS	SIGN DETAIL				
								"A"	"B"	RETAIN	SALVAGE FROM	SALVAGE TO	REMOVE	RETAIN	REMOVE		1.75	2.00	2.50	3.00	3.50	4.00	5.00			DETAIL IN SHS	DETAIL ON SHEET NUMBER	DETAIL ON STD SHEET NUMBER		
																	(LB / FT)			(LB / FT)										
NEWFANE SB							FY-FLUORESCENT YELLOW FYG-FLUORESCENT YELLOW GREEN															"SHS"-STANDARD HIGHWAY SIGNS								
SB	1.828	F	R2-1	24	30																		INSTALL STOP SIGN ON A SEPARATE POST (MUTCD REQ) 5 - 10 FT IN ADVANCE OF THE DO NOT ENTER / ONE WAY SIGNS BELOW.							
		F	R2-1	24	30			5.00										12.75' X					INSTALL DO NOT ENTER AND ONE WAY SIGNS ON A SEPARATE POST ACROSS FROM THE OTHER DO NOT ENTER / ONE WAY SIGNS	X						
SB	1.738	F	OM-3R	12	36		RIGHT OBJECT MARKER															SIGN WAS REMOVED PRIOR TO PROJECT				NOT WARRANTED				
SB	1.730	E	OM-3L	12	36		LEFT OBJECT MARKER															SIGN WAS REMOVED PRIOR TO PROJECT				NOT WARRANTED				
SB	1.659	G	VR-017	24	30		LEGAL LOAD LIMIT 24000 POUNDS			1												X				BROWNS ROAD (TH-45); NEWFANE-TOWNSHEND STP 2401(1) TO REPLACE IN 2010				
SB	1.652	H	R1-1	30	30		  STOP			1												X				NEWFANE-TOWNSHEND STP 2401(1) TO REPLACE IN 2010				
SB	1.607	F	R2-1	24	30																									
		F	R2-1	24	30			5.00																			X			
SB	1.471 1.457	F	M3-3	24	12																									
		F	M1-5	24	24																									
		F	M3-3	24	12																						X			
		F	M1-5	24	24			4.00																					E-136B	
SB	1.434	F	R2-1	24	30																									
		F	R2-1	24	30			5.00																			X			
SB	1.156	F	S2-1	36	36		SCHOOL ZONE (WITH CROSSWALK LINES)																							
SIGN SUMMARY SHEET							SHEET TOTALS											21.00	0.00	2	0	0	6 8	0	0	4	51.5 60	PROJECT NAME: STATEWIDE SOUTHEAST REGION PROJECT NUMBER: STPG SIGN (31)		
VERMONT AGENCY OF TRANSPORTATION							SF	SF	EA	EA	EA	EA	EA	EA	EA	EA	EA	EA	EA	EA	EA	EA	EA	FILE NAME: NEWFANE SOUTHBOUND PROJECT MANAGER: A. GAMBLE DESIGNED BY: M. MILLER NEWFANE VT-30 SOUTHBOUND 6			PLOT DATE: 8/12/2010 DRAWN BY: M. MILLER CHECKED BY: A. GAMBLE SHEET 43 OF 175			
TOWN DIRECTIONAL TOTALS							284.2	0.0	23.0	2.0	2.0	55	0.0	0.0	50	750.0														