

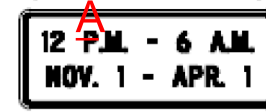


DIRECTION	MILEPOINT	LOCATION CODE (SHEET 2)	SIGN CODE	WIDTH (IN)	HEIGHT (IN)	SHEETING REMARKS	SIGN LEGEND	NEW SIGNS		EXISTING SIGNS				EXIST POST		NUMBER OF NEW POSTS	SQUARE STEEL (IN)			TUBULAR STEEL Ø (IN)				SIGN FRAME REQUIRED	REMARKS	SIGN DETAIL		
								"A"	"B"	RETAIN	SALVAGE FROM	SALVAGE TO	REMOVE	RETAIN	REMOVE		1.75	2.00	2.50	3.00	3.50	4.00	5.00			DETAIL IN SHS	DETAIL ON SHEET NUMBER	DETAIL ON STD SHEET NUMBER
																	(LB / FT)			(LB / FT)								
TOWNSHEND NB							FY-FLUORESCENT YELLOW FYG-FLUORESCENT YELLOW GREEN															"SHS"-STANDARD HIGHWAY SIGNS						
NB	1.878	A	M2-1	21	15		JCT																					
		A	M1-6	24	24		ROUTE 35																					
NB	1.910	A	W11-2	30	30		PEDESTRIAN SYMBOL																					
		A	W16-9	24	10		AHEAD (PLAQUE)																					
		A	M2-1	21	15			2.19															14.75' X		X			
		A	M1-6	24	24			4.00																	9			
NB	1.926	A	R8-3A	24	24																							
		A	VR-071	24	10																							
		A	R8-3A	24	24			4.00																	X			
		A	VR-071	24	10			1.67																	6			
NB	1.953	A	D1-1A	72	10																							
		A	D1-1A	72	10																							
		A	D1-1A	72	10		(6 DESTINATION / HOSPITAL SIGN ASSEMBLY)																					
		A	D1-1A	72	10																							
		A	D9-2	24	24																							
SIGN SUMMARY SHEET							SHEET TOTALS	11.86	0.00	0	0	0	11	0	0	2	28.5							PROJECT NAME: STATEWIDE SOUTHEAST REGION				
								SF	SF	EA	EA	EA	EA	EA	EA	EA	FT							PROJECT NUMBER: STPG SIGN (31)				
VERMONT AGENCY OF TRANSPORTATION							TOWN DIRECTIONAL TOTALS	334.0	0.0	25.0	0.0	0.0	81	0.0	0.0	54	810.0							FILE NAME: TOWNSHEND NORTHBOUND	PLOT DATE: 8/12/2010			
																								PROJECT MANAGER: A. GAMBLE	DRAWN BY: M. MILLER			
																								DESIGNED BY: M. MILLER	CHECKED BY: A. GAMBLE			
																								TOWNSHEND VT-30 NORTHBOUND 4	SHEET 51 OF 175			