

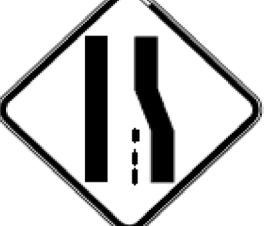






DIRECTION	MILEPOINT	LOCATION CODE (SHEET 2)	SIGN CODE	WIDTH (IN)	HEIGHT (IN)	SHEETING REMARKS	SIGN LEGEND	NEW SIGNS		EXISTING SIGNS				EXIST POST		NUMBER OF NEW POSTS	SQUARE STEEL (IN)			TUBULAR STEEL Ø (IN)				SIGN FRAME REQUIRED	REMARKS	SIGN DETAIL		
								"A"	"B"	RETAIN	SALVAGE FROM	SALVAGE TO	REMOVE	RETAIN	REMOVE		1.75	2.00	2.50	3.00	3.50	4.00	5.00			DETAIL IN SHS	DETAIL ON SHEET NUMBER	DETAIL ON STD SHEET NUMBER
																	(LB / FT)			(LB / FT)								
<b>ROCKINGHAM NB</b>							FY-FLUORESCENT YELLOW FYG-FLUORESCENT YELLOW GREEN															"SHS"-STANDARD HIGHWAY SIGNS						
NB	2.864	A	R2-1	24	30			5.00							1	14.75' X							INSTALL BEHIND RAIL 150 FEET ± NORTH OF "NORTH US-5" SIGN ASSEMBLY.	X				
NB	3.062	A	W9-1	36	36			9.00							2	10.0' 11.25' X							TEXT SIGN. INSTALL 250 FT ± IN ADVANCE OF "RIGHT LANE DROP" SYMBOL AHEAD (NEXT ENTRY).	X				
NB	3.109	A	W4-2R	30	30								1		X													
		A	W4-2R	36	36			9.00						2	10.0' 11.0' X								X					
NB	3.147	A	VR-186E	24	30		TRUCK LANE ENDS						1		X													
NB	3.184	A	VW-205	30	30		WATCH FOR TURNING VEHICLES						1		X													
NB	3.203	A	VW-205	36	36			9.00						2	14.75' 15.0' X								INSTALL 100 FT ± NORTH OF PREVIOUS POSITION			E-154		
NB	3.278	A	R2-1	24	30								1		X													
		A	R4-1	24	30								1		X													
		A	R2-1	24	30			5.00						1	16.25' X								SPEED LIMIT SIGN IN UPPER POSITION.	X				
		A	R4-1	24	30			5.00																X				
NB	3.317	C	VR-017	24	30																			SPENCER DRIVE (TH-83); SIGN AND POST MISSING				
		C	VR-017	24	30			5.00						1	13.0' X										6			
NB	3.324	D	R1-1	30	30		STOP						1		X													
		A		36	8		SPENCER DRIVE (TH-83)					1																
<b>SIGN SUMMARY SHEET</b>							<b>SHEET TOTALS</b>	47.00	0.00	0	1	0	6	0	0	9	<del>116</del> 135							PROJECT NAME: STATEWIDE SOUTHEAST REGION				
								SF	SF	EA	EA	EA	EA	EA	EA	EA	FT						PROJECT NUMBER: STPG SIGN (31)					
VERMONT AGENCY OF TRANSPORTATION							<b>TOWN DIRECTIONAL TOTALS</b>	506.0	0.0	9.0	6.0	7.0	93	0.0	0.0	76	1140.0							FILE NAME: ROCKINGHAM NORTHBOUND	PLOT DATE: 8/13/2010			
																						PROJECT MANAGER: A. GAMBLE	DRAWN BY: M. MILLER					
																					DESIGNED BY: M. MILLER	CHECKED BY: A. GAMBLE						
																					ROCKINGHAM US-5 NORTHBOUND 4	SHEET 75	OF	175				