








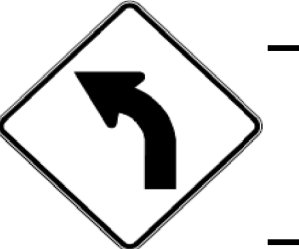


DIRECTION	MILEPOINT	LOCATION CODE (SHEET 2)	SIGN CODE	WIDTH (IN)	HEIGHT (IN)	SHEETING REMARKS	SIGN LEGEND	NEW SIGNS		EXISTING SIGNS				EXIST POST		NUMBER OF NEW POSTS	SQUARE STEEL (IN)			TUBULAR STEEL Ø (IN)				SIGN FRAME REQUIRED	REMARKS	SIGN DETAIL			
								"A"	"B"	RETAIN	SALVAGE FROM	SALVAGE TO	REMOVE	RETAIN	REMOVE		1.75	2.00	2.50	FOUNDATION	3.00	3.50	4.00			5.00	DETAIL IN SHS	DETAIL ON SHEET NUMBER	DETAIL ON STD SHEET NUMBER
																	(LB / FT)				(LB / FT)								
ROCKINGHAM NB							FY-FLUORESCENT YELLOW FYG-FLUORESCENT YELLOW GREEN															"SHS"-STANDARD HIGHWAY SIGNS							
NB	7.375	A	W1-2R	30	30			6.25							1			13.75'						INSTALL NEXT TO MILE MARKER 0050 / 1314 / 0740	X				
		A	W13-1P	18	18			2.25																	X				
NB	7.564	A	W12-2	36	36																		(13'-6" OR LESS REQUIRES SIGNS, THESE SIGNS ARE NOT REQUIRED)						
		A	W16-3	24	18																								
		A	W1-10R	36	36			9.00							2			14.0'						INSTALL IN SAME POSITION AS REMOVED HEIGHT RESTRICTION SIGNS	X				
		A	W16-8aP	24	15			2.50																INSTALL PLAQUE ON LEFT POST		7			
NB	7.692	A	N/A	30	30																								
		A	VW-133R	30	30			6.25							1			13.75'									E-154		
NB	7.862	A	W1-2L	30	30			6.25							1			14.0'						INSTALL 900 FT ± NORTH OF HIDDEN DRIVE RIGHT SIGN, JUST BEFORE BEGIN OF GUARDRAIL / CURVE LEFT	X				
NB	8.055	A	VW-202	30	30																								
NB	8.060	A	VW-202	30	30			6.25							1			X						INSTALL 26 FT ± NORTH OF THE PREVIOUS POSITION, TO GET AWAY FROM UTILITY POLE			E-154		
NB	8.136	A	W7-1a	30	30			6.25							1			14.0'						INSTALL 400 FT ± NORTH OF TRUCKS ENTERING SIGN	X				
		A	W7-3aP	24	18			3.00																	X				
NB	8.401	A	W1-2L	30	30			6.25							1			13.75'						INSTALL 1400 FT ± NORTH OF HILL SYMBOL SIGNS, JUST BEFORE BEGIN OF GUARDRAIL / CURVE LEFT	X				
NB	8.597	C	VR-017	24	30																								
SIGN SUMMARY SHEET							SHEET TOTALS	48.00 54.25	0.00	0	0	0	5	0	0	7 8			97.25 120						PROJECT NAME: STATEWIDE SOUTHEAST REGION PROJECT NUMBER: STPG SIGN (31)				
VERMONT AGENCY OF TRANSPORTATION							TOWN DIRECTIONAL TOTALS	506.0	0.0	9.0	6.0	7.0	93	0.0	0.0	76			1140.0						FILE NAME: ROCKINGHAM NORTHBOUND PROJECT MANAGER: A. GAMBLE DESIGNED BY: M. MILLER ROCKINGHAM US-5 NORTHBOUND 15	PLOT DATE: 8/13/2010 DRAWN BY: M. MILLER CHECKED BY: A. GAMBLE SHEET 86 OF 175			