

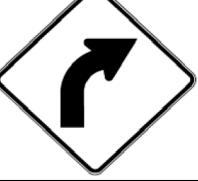









DIRECTION	MILEPOINT	LOCATION CODE (SHEET 2)	SIGN CODE	WIDTH (IN)	HEIGHT (IN)	SHEETING REMARKS	SIGN LEGEND	NEW SIGNS		EXISTING SIGNS				EXIST POST		NUMBER OF NEW POSTS	SQUARE STEEL (IN)			TUBULAR STEEL Ø (IN)				SIGN FRAME REQUIRED	REMARKS	SIGN DETAIL		
								"A"	"B"	RETAIN	SALVAGE FROM	SALVAGE TO	REMOVE	RETAIN	REMOVE		1.75	2.00	2.50	3.00	3.50	4.00	5.00			DETAIL IN SHS	DETAIL ON SHEET NUMBER	DETAIL ON STD SHEET NUMBER
																	(LB / FT)			(LB / FT)								
<b>ROCKINGHAM SB</b>							FY-FLUORESCENT YELLOW FYG-FLUORESCENT YELLOW GREEN															"SHS"-STANDARD HIGHWAY SIGNS						
SB	8.558	F	W1-2R	30	30			6.25								1	13.75' X							INSTALL 100 FT ± SOUTH OF THE JUNCTION WITH TH-107.	X			
<del>SB</del>	<del>8.229</del>	<del>F</del>	<del>VW-202</del>	<del>30</del>	<del>30</del>		<del></del>	<del>6.25</del>								<del>1</del>	<del>X</del>							<del>INSTALL 400 FT ± IN ADVANCE OF THE DRIVE TO "BFI WASTE SYSTEMS" (DRIVE #854)</del>			E-154	
SB	8.006	F	W1-2R	30	30			6.25								1	13.5' X							INSTALL AT NORTHERLY CORNER OF WHITE PICKET FENCE TO DRIVE # 856	X			
SB	7.780	F	W1-2L	30	30			6.25								1	13.5' X							INSTALL ON NORTH SIDE OF DRIVE, IN ADVANCE OF LEFT CURVE, 1200 FT ± NORTH OF CURVE RIGHT SIGN SOUTH	X			
SB	7.600	G	VR-017	24	24											1								RANDALL HILL ROAD (TH-20)				
		G	VR-017	24	30			5.00								1	12.5' X									6		
SB	7.592	H	R1-1	24	24																							
		H	R1-1	30	30			6.25								1	13.0' X								X			
SB	7.117	G	VR-017	24	30																			ALDEN ROAD (TH-22)				
		G	VR-017	24	30			5.00			1	1	1			1	13.5' 12.25' X							ON 10/12/11, THIS POST WAS FOUND DAMAGED AND IT WAS REPLACED BY CONTRACTOR.		6		
SB	7.108	H	R1-1	30	30																							
		H	R1-1	30	30			6.25								1	12.25' X								X			
SB	6.821	F	W7-1	30	30		HILL SYMBOL																					
SB	6.792	F	W7-1a	30	30			6.25									1	13.75' X						INSTALL 150 FT ± SOUTH OF HILL SIGN THAT WAS REMOVED	X			
		F	W7-3aP	24	18			3.00																	X			
<b>SIGN SUMMARY SHEET</b>							SHEET TOTALS	50.5 <del>56.75</del>	0.00	0	1	1	6	0	0	9	118.0 <del>135</del>							PROJECT NAME: STATEWIDE SOUTHEAST REGION PROJECT NUMBER: STPG SIGN (31)				
VERMONT AGENCY OF TRANSPORTATION							TOWN DIRECTIONAL TOTALS	442.6	0.0	9.0	3.0	3.0	78	0.0	0.0	73	1095.0							FILE NAME: ROCKINGHAM SOUTHBOUND PROJECT MANAGER: A. GAMBLE DESIGNED BY: M. MILLER ROCKINGHAM US-5 SOUTHBOUND 1	PLOT DATE: 8/13/2010 DRAWN BY: M. MILLER CHECKED BY: A. GAMBLE SHEET 88 OF 175			