


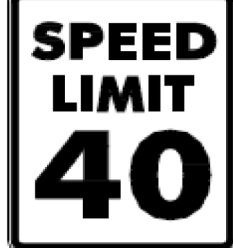








DIRECTION	MILEPOINT	LOCATION CODE (SHEET 2)	SIGN CODE	WIDTH (IN)	HEIGHT (IN)	SHEETING REMARKS	SIGN LEGEND	NEW SIGNS		EXISTING SIGNS				EXIST POST		NUMBER OF NEW POSTS	SQUARE STEEL (IN)			TUBULAR STEEL Ø (IN)				SIGN FRAME REQUIRED	REMARKS	SIGN DETAIL			
								"A"	"B"	RETAIN	SALVAGE FROM	SALVAGE TO	REMOVE	RETAIN	REMOVE		1.75	2.00	2.50	3.00	3.50	4.00	5.00			DETAIL IN SHS	DETAIL ON SHEET NUMBER	DETAIL ON STD SHEET NUMBER	
																	(LB / FT)			(LB / FT)									
CHESTER EB							FY-FLUORESCENT YELLOW FYG-FLUORESCENT YELLOW GREEN															"SHS"-STANDARD HIGHWAY SIGNS							
EB	1.110	C	VR-017	24	30																		MATTSON ROAD (TH-30); EXISTING SIGN AND POST MISSING						
		C	VR-017	24	30			5.00																	6				
EB	1.114	D	R1-1	30	30																								
		D	R1-1	30	30			6.25																X					
EB	1.125	A	W1-5L	30	30																		LEFT WINDING CURVES						
		A	R2-1	24	30			5.00																	X				
EB	1.535	B	W1-6	48	24																		LARGE ARROW RIGHT						
EB	1.715	A	R2-1	24	30																								
		A	R2-1	24	30			5.00																	X				
EB	2.176	C	VR-017	24	24																								
		C	VR-017	24	30			5.00																		6			
EB	2.184	D	R1-1	24	24																								
		D	R1-1	30	30			-6.25																	X				
EB	2.225	A	R2-1	24	30			5.00																	X				
		A	W5-1	30	30																		ROAD NARROWS						
SIGN SUMMARY SHEET								SHEET TOTALS		26.25 37.50	0.00	0 ³	0	0	5 ⁷	0	0	7	76.0 105					PROJECT NAME: STATEWIDE SOUTHEAST REGION					
VERMONT AGENCY OF TRANSPORTATION								SF	SF	EA	EA	EA	EA	EA	EA	EA	EA	EA	EA	EA	EA	EA	EA	EA	PROJECT NUMBER: STPG SIGN (31)				
TOWN DIRECTIONAL TOTALS							163.5	0.0	1.0	0.0	0.0	33	0.0	0.0	30	450.0					FILE NAME: CHESTER EASTBOUND	PLOT DATE: 8/13/2010			DESIGNED BY: M. MILLER	CHECKED BY: A. GAMBLE			
																							CHESTER VT-10 EASTBOUND 3	SHEET 103	OF 175				