



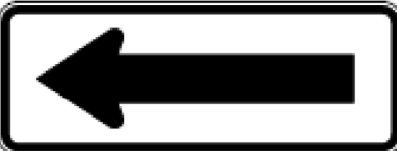

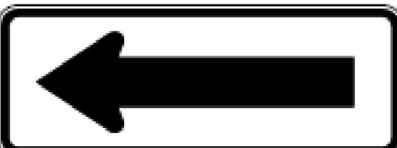






DIRECTION	MILEPOINT	LOCATION CODE (SHEET 2)	SIGN CODE	WIDTH (IN)	HEIGHT (IN)	SHEETING REMARKS	SIGN LEGEND	NEW SIGNS		EXISTING SIGNS				EXIST POST		NUMBER OF NEW POSTS	SQUARE STEEL (IN)			TUBULAR STEEL Ø (IN)				SIGN FRAME REQUIRED	REMARKS	SIGN DETAIL			
								"A"	"B"	RETAIN	SALVAGE FROM	SALVAGE TO	REMOVE	RETAIN	REMOVE		1.75	2.00	2.50	3.00	3.50	4.00	5.00			DETAIL IN SHS	DETAIL ON SHEET NUMBER	DETAIL ON STD SHEET NUMBER	
																	(LB / FT)			(LB / FT)									
CHESTER WB							FY-FLUORESCENT YELLOW FYG-FLUORESCENT YELLOW GREEN															"SHS"-STANDARD HIGHWAY SIGNS							
WB	2.949	H	R1-1	30	30		 	6.25																			X		
WB	2.905	F	W1-2L	30	30			6.25																			X		INSTALL 220 FT ± WEST OF GOULD ROAD, JUST BEFORE THE BEGINNING OF THE TREELINE
		F	W13-1	18	18			2.25																			X		
WB	2.870	F	W1-6	48	24																							DURING THE SNOWSTORM ON 10/29/11, THE SIGN AND POST WERE DAMAGED WHEN THEY WERE HIT BY A VEHICLE. ON 11/17/11 THE CONTRACTOR REPLACED THE POST AND SIGN	
		F	W1-6	48	24			8.00																			X		
WB	2.865	E	W1-6	48	24			8.00																			X		INSTALL 25 FT ± BEYOND THE LARGE ARROW LEFT, TO 10 FT± BEYOND THE UTILITY POLE; FACES EB TRAFFIC
WB	2.840	F	W1-6	48	24																							SEE ABOVE ALSO DAMAGED.	
		F	W1-6	48	24			8.00																			X		SEE SHEET #112A.
WB	2.839	E	W1-6	48	24																							FACES EB TRAFFIC	
		E	W1-6	48	24			8.00																			X		
WB	2.715	F	W1-6	48	24		LARGE ARROW LEFT																						
WB	2.647	G	VR-017	24	24																							ROAD SIGN WAS SALVAGED AND RE-ERECTED.	
		H	R1-1	24	24																							AMSDEN HILL ROAD (TH-24); EXISTING SIGNS ARE MOUNTED BACK-TO-BACK	
		G	VR-017	24	30		 BACK-TO-BACK 	5.00																				INSTALL BACK-TO-BACK; NOTE 16,000 POUND LIMIT	
		H	R1-1	30	30			6.25																		X		NOTE: THE EXTRA STOP SIGN ON THE LEFT IS DUE TO THE HOUSE ON THE RIGHT THAT RESTRICTS VISIBILITY	
SIGN SUMMARY SHEET							SHEET TOTALS	58.00	0.00	0	0	0	6	0	0	11	141.5							PROJECT NAME: STATEWIDE SOUTHEAST REGION					
								SF	SF	EA	EA	EA	EA	EA	EA	EA	FT							PROJECT NUMBER: STPG SIGN (31)					
VERMONT AGENCY OF TRANSPORTATION							TOWN DIRECTIONAL TOTALS	275.0	0.0	0.0	0.0	0.0	53	0.0	0.0	48	720.0							FILE NAME: CHESTER WESTBOUND					
																								PROJECT MANAGER: A. GAMBLE					
																								DESIGNED BY: M. MILLER					
																								CHESTER VT-10 WESTBOUND 2					
																								PLOT DATE: 8/13/2010					
																								DRAWN BY: M. MILLER					
																								CHECKED BY: A. GAMBLE					
																								SHEET 107 OF 175					