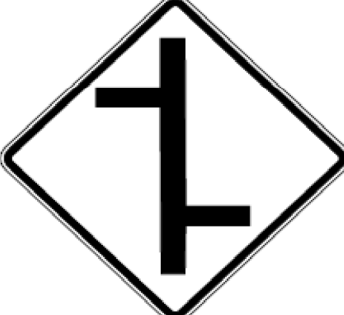



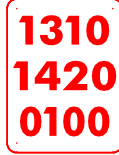



DIRECTION	MILEPOINT	LOCATION CODE (SHEET 2)	SIGN CODE	WIDTH (IN)	HEIGHT (IN)	SHEETING REMARKS	SIGN LEGEND	NEW SIGNS		EXISTING SIGNS				EXIST POST		NUMBER OF NEW POSTS	SQUARE STEEL (IN)			TUBULAR STEEL Ø (IN)				SIGN FRAME REQUIRED	REMARKS	SIGN DETAIL		
								"A"	"B"	RETAIN	SALVAGE FROM	SALVAGE TO	REMOVE	RETAIN	REMOVE		1.75	2.00	2.50	3.00	3.50	4.00	5.00			DETAIL IN SHS	DETAIL ON SHEET NUMBER	DETAIL ON STD SHEET NUMBER
																	(LB / FT)			(LB / FT)								
WEATHERSFIELD EB							FY-FLUORESCENT YELLOW FYG-FLUORESCENT YELLOW GREEN															"SHS"-STANDARD HIGHWAY SIGNS						
EB	0.000	A	VD-024	72	10		Weathersfield Cavendish	5.00							2	12.5'	12.0'	X						INSTALL BEHIND RAIL DIRECTLY ACROSS FROM THE EXISTING TOWN LINE SIGN (WHICH WILL BE REMOVED)		4		
		A	VD-700	6	10		1310 1420 0000 1310 1406 0765	0.42																CAVENDISH MILE MARKER; INSTALL ON RIGHT-SIDE POST		4		
		A	VD-700	6	10			0.42																WEATHERSFIELD MILE MARKER; INSTALL ON LEFT-SIDE POST		4		
EB	0.774	A	VD-062B	72	16		BUSINESS DIRECTORY SIGN			1				X										ROCKLEDGE FARM <===				
EB	0.905	A	W2-1M	30	30							1		X														
		A	W2-1Md	30	30			6.25							1	14.0'	X								5			
EB	0.940	A	W3-5	36	36							1		X														
		A	W3-5	36	36			9.00							2	15.0'	14.0'	X							X			
EB	0.970	A	VD-018	30	18		Downers Amsden 1					1		X														
		A	VD-018	30	18			3.75							1	11.5'	X								8			
EB	0.984	C	VR-017	24	30		 LEGAL LOAD LIMIT 6 TONS	5.00		-				X	1	12.5'	X			OLD SIGN MISSING NEW SIGN INSTALLED.			UPPER FALLS ROAD (TH-20); RETAIN SIGN AND POST, BOTH ARE AS-NEW					
EB	0.990	D	R1-1	30	30		 					1		X														
		D	R1-1	30	30			6.25							1	12.5'	X			MM SALVAGED ONTO THE NEW POST				X				
EB	1.050	A	R2-1	24	30							1		X														
		A	R2-1	30	36			7.50							1	14.5'	X								6			
SIGN SUMMARY SHEET							SHEET TOTALS	43.59 38.59	0.00	1 2	0	0	5	0	0	8	118.5 120						PROJECT NAME: STATEWIDE SOUTHEAST REGION PROJECT NUMBER: STPG SIGN (31)					
VERMONT AGENCY OF TRANSPORTATION							TOWN DIRECTIONAL TOTALS	778.3	0.0	47.0	9.0	9.0	180	0.0	0.0	108	1620.0						FILE NAME: WEATHERSFIELD EASTBOUND PROJECT MANAGER: A. GAMBLE DESIGNED BY: M. MILLER WEATHERSFIELD VT-131 EB 1	PLOT DATE: 8/19/2010 DRAWN BY: M. MILLER CHECKED BY: A. GAMBLE SHEET 122 OF 175				