
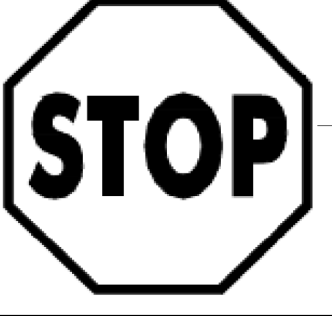







DIRECTION	MILEPOINT	LOCATION CODE (SHEET 2)	SIGN CODE	WIDTH (IN)	HEIGHT (IN)	SHEETING REMARKS	SIGN LEGEND	NEW SIGNS		EXISTING SIGNS				EXIST POST		NUMBER OF NEW POSTS	SQUARE STEEL (IN)			TUBULAR STEEL Ø (IN)				SIGN FRAME REQUIRED	REMARKS	SIGN DETAIL		
								"A"	"B"	RETAIN	SALVAGE FROM	SALVAGE TO	REMOVE	RETAIN	REMOVE		1.75	2.00	2.50	3.00	3.50	4.00	5.00			DETAIL IN SHS	DETAIL ON SHEET NUMBER	DETAIL ON STD SHEET NUMBER
																	(LB / FT)			(LB / FT)								
<b>WEATHERSFIELD EB</b>							FY-FLUORESCENT YELLOW FYG-FLUORESCENT YELLOW GREEN															"SHS"-STANDARD HIGHWAY SIGNS						
EB	7.393	A	W3-5	36	36		SPEED REDUCTION 40 MPH				1							15.5' 15.0' X						SIGN WAS REPLACED IN 2007; SALVAGE ONTO A NEW SET OF POSTS				
EB	7.435	C	--	24	30		LEGAL LOAD LIMIT 8 TONS					1												LAVIGNE ROAD (TH-102)				
		C	VR-017	24	30			5.00										14.0' X						NEW SIGN HAS DIFFERENT TEXT COMPARED TO EXISTING SIGN		6		
EB	7.441	D	R1-1	30	30							1																
		D	R1-1	30	30			6.25										12.5' X							X			
EB	7.470	A	VD-018A	30	18							1																
		A	VD-018	30	18			3.75										15.0' X								9		
EB	7.508	A	R2-1	30	36		SPEED LIMIT 40			1														SIGN WAS REPLACED IN 2007				
EB	7.660	C	VR-017	24	30							1												GOULDEN RIDGE ROAD (TH-46)				
		C	VR-017	24	30			5.00										12.5' X								6		
EB	7.670	D	R1-1	30	30					1														SIGN WAS REPLACED IN 2007				
EB	7.768	A	R2-1	24	30							1												SIGN WAS REPLACED IN 2007 BUT HAS SLIGHT DAMAGE		X		
		A	R2-1	24	30			5.00										14.75' X										
EB	7.928	A	W11-8	36	36							1																
		A	W11-8	30	30			6.25										15.75' X							X			
<b>SIGN SUMMARY SHEET</b>							SHEET TOTALS		31.25	0.00	2	0	1	6	0	0	8	115.0 <del>120</del>						PROJECT NAME: STATEWIDE SOUTHEAST REGION				
VERMONT AGENCY OF TRANSPORTATION							TOWN DIRECTIONAL TOTALS		SF	SF	EA	EA	EA	EA	EA	EA	EA	FT						PROJECT NUMBER: STPG SIGN (31)				
									778.3	0.0	47.0	9.0	9.0	180	0.0	0.0	108	1620.0						FILE NAME: WEATHERSFIELD EASTBOUND	PLOT DATE: 8/19/2010			
																								PROJECT MANAGER: A. GAMBLE	DRAWN BY: M. MILLER			
																								DESIGNED BY: M. MILLER	CHECKED BY: A. GAMBLE			
																								WEATHERSFIELD VT-131 EB 15	SHEET 136 OF 175			