


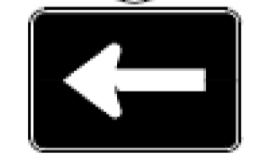


DIRECTION	MILEPOINT	LOCATION CODE (SHEET 2)	SIGN CODE	WIDTH (IN)	HEIGHT (IN)	SHEETING REMARKS	SIGN LEGEND	NEW SIGNS		EXISTING SIGNS				EXIST POST		NUMBER OF NEW POSTS	SQUARE STEEL (IN)			TUBULAR STEEL Ø (IN)				SIGN FRAME REQUIRED	REMARKS	SIGN DETAIL		
								"A"	"B"	RETAIN	SALVAGE FROM	SALVAGE TO	REMOVE	RETAIN	REMOVE		1.75	2.00	2.50	3.00	3.50	4.00	5.00			DETAIL IN SHS	DETAIL ON SHEET NUMBER	DETAIL ON STD SHEET NUMBER
																	(LB / FT)			(LB / FT)								
WEATHERSFIELD WB							FY-FLUORESCENT YELLOW FYG-FLUORESCENT YELLOW GREEN															"SHS"-STANDARD HIGHWAY SIGNS						
WB	8.216	F	D1-1A	72	12		^UP CAVENDISH 15			1				X										REPLACED IN 2007				
		F	D1-1A	72	12		^UP LUDLOW 20			1														REPLACED IN 2007				
		F	D1-1A	72	12		<--- (90 DEG) SPRINGFIELD 10			1														REPLACED IN 2007				
WB	8.195	F	W11-8	36	36									1														
		F	W11-8	36	36			6.25							1			14.0'						SIGN DOWNSIZED PER M. MILLER, TRAFFIC OPS., 04/28/2011	X			
WB	8.155	F	M3-3	24	12		SOUTH							1														
		F	M1-1	24	24		I-91							1														
		F	M6-1	21	15		LEFT							1														
		F	M3-4	24	12		WEST							1										WEST-VT-131 UP-ARROW SIGNS NOT BEING REPLACED				
		F	M1-5	30	24		VT 131							1														
		F	M6-3	21	15		^UP ARROW							1										THIS SIGN WAS NOT REPLACED.				
		F	M3-3	24	12			2.00							1			14.25'						WHITE ON BLUE	X			
		F	M1-1	24	24			4.00																	X			
		F	M6-1	21	15			2.19																WHITE ON BLUE	X			
WB	8.118	F	M3-4	24	12									1														
SIGN SUMMARY SHEET							SHEET TOTALS	14.44 17.19	0.00	3	0	0	8	0	0	2			28.25 45					PROJECT NAME: STATEWIDE SOUTHEAST REGION				
							SF	SF	EA	EA	EA	EA	EA	EA	EA	EA			FT					PROJECT NUMBER: STPG SIGN (31)				
VERMONT AGENCY OF TRANSPORTATION							TOWN DIRECTIONAL TOTALS	644.2	0.0	17.0	1.0	1.0	153	0.0	0.0	78			1170.0					FILE NAME: WEATHERSFIELD WESTBOUND	PLOT DATE: 8/19/2010			
																							PROJECT MANAGER: A. GAMBLE	DRAWN BY: M. MILLER				
																							DESIGNED BY: M. MILLER	CHECKED BY: A. GAMBLE				
																							WEATHERSFIELD VT-131 WB 10	SHEET 160 OF 175				