

# STATE OF VERMONT AGENCY OF TRANSPORTATION




## PROPOSED IMPROVEMENT TOWNS OF DORSET, MOUNT TABOR, DANBY, SHAFTSBURY, WINHALL, AND STOCKBRIDGE COUNTIES OF BENNINGTON, RUTLAND, AND WINDSOR VERMONT ROUTES 7A, 30, 107 US ROUTE 7

SOUTHWEST REGION SIGN REPLACEMENT - 32.878 MILES:  
US 7 DORSET MP 1.750-DANBY MP 2.473, VT 7A SHAFTSBURY MP 0.000-6.895,  
VT 30 WINHALL MP 0.000-7.659, VT 107 STOCKBRIDGE MP 0.000-6.700


LENGTH OF ROADWAY = 32.878 MILES  
LENGTH OF PROJECT = 32.878 MILES

WORK TO BE PERFORMED UNDER THIS PROJECT INCLUDES THE REMOVAL OF EXISTING SIGNS AND POSTS  
AND THE INSTALLATION OF NEW SIGNS AND SIGN POSTS AND INCIDENTAL ITEMS.

INDEX OF SHEETS  
SEE SHEET 2

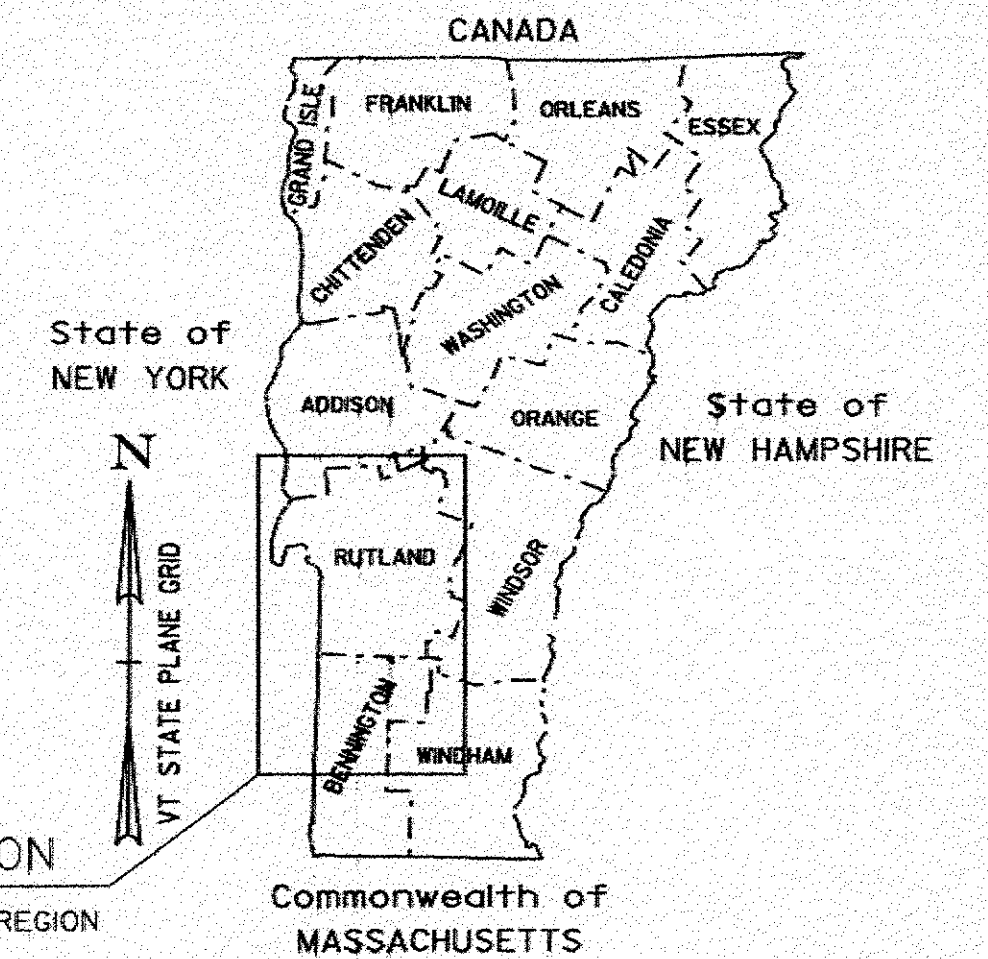

RECORD PLANS	
CONTRACTOR:	F. R. LAFAYETTE, INC. - ESSEX JUNCTION, VT
RESIDENT ENGINEER:	JOSH HULETT
CONSTRUCTION BEGAN:	JUNE 14, 2011
CONSTRUCTION COMPLETE:	JULY 7, 2011
RECORD PLANS BY:	JOSH HULETT & C. PIERCE
I HEREBY CERTIFY THAT ALL THE CONSTRUCTION REQUIRED BY THIS SET OF DRAWINGS HAS BEEN ACCOMPLISHED AS INDICATED HEREIN.	
BY	<i>Josh Hulett</i> RESIDENT ENGINEER
DATE	5/22/12
NOTE: Any further information concerning final quantities, amounts or other details relative to this project may be found at Central Files in the electronic archives.	

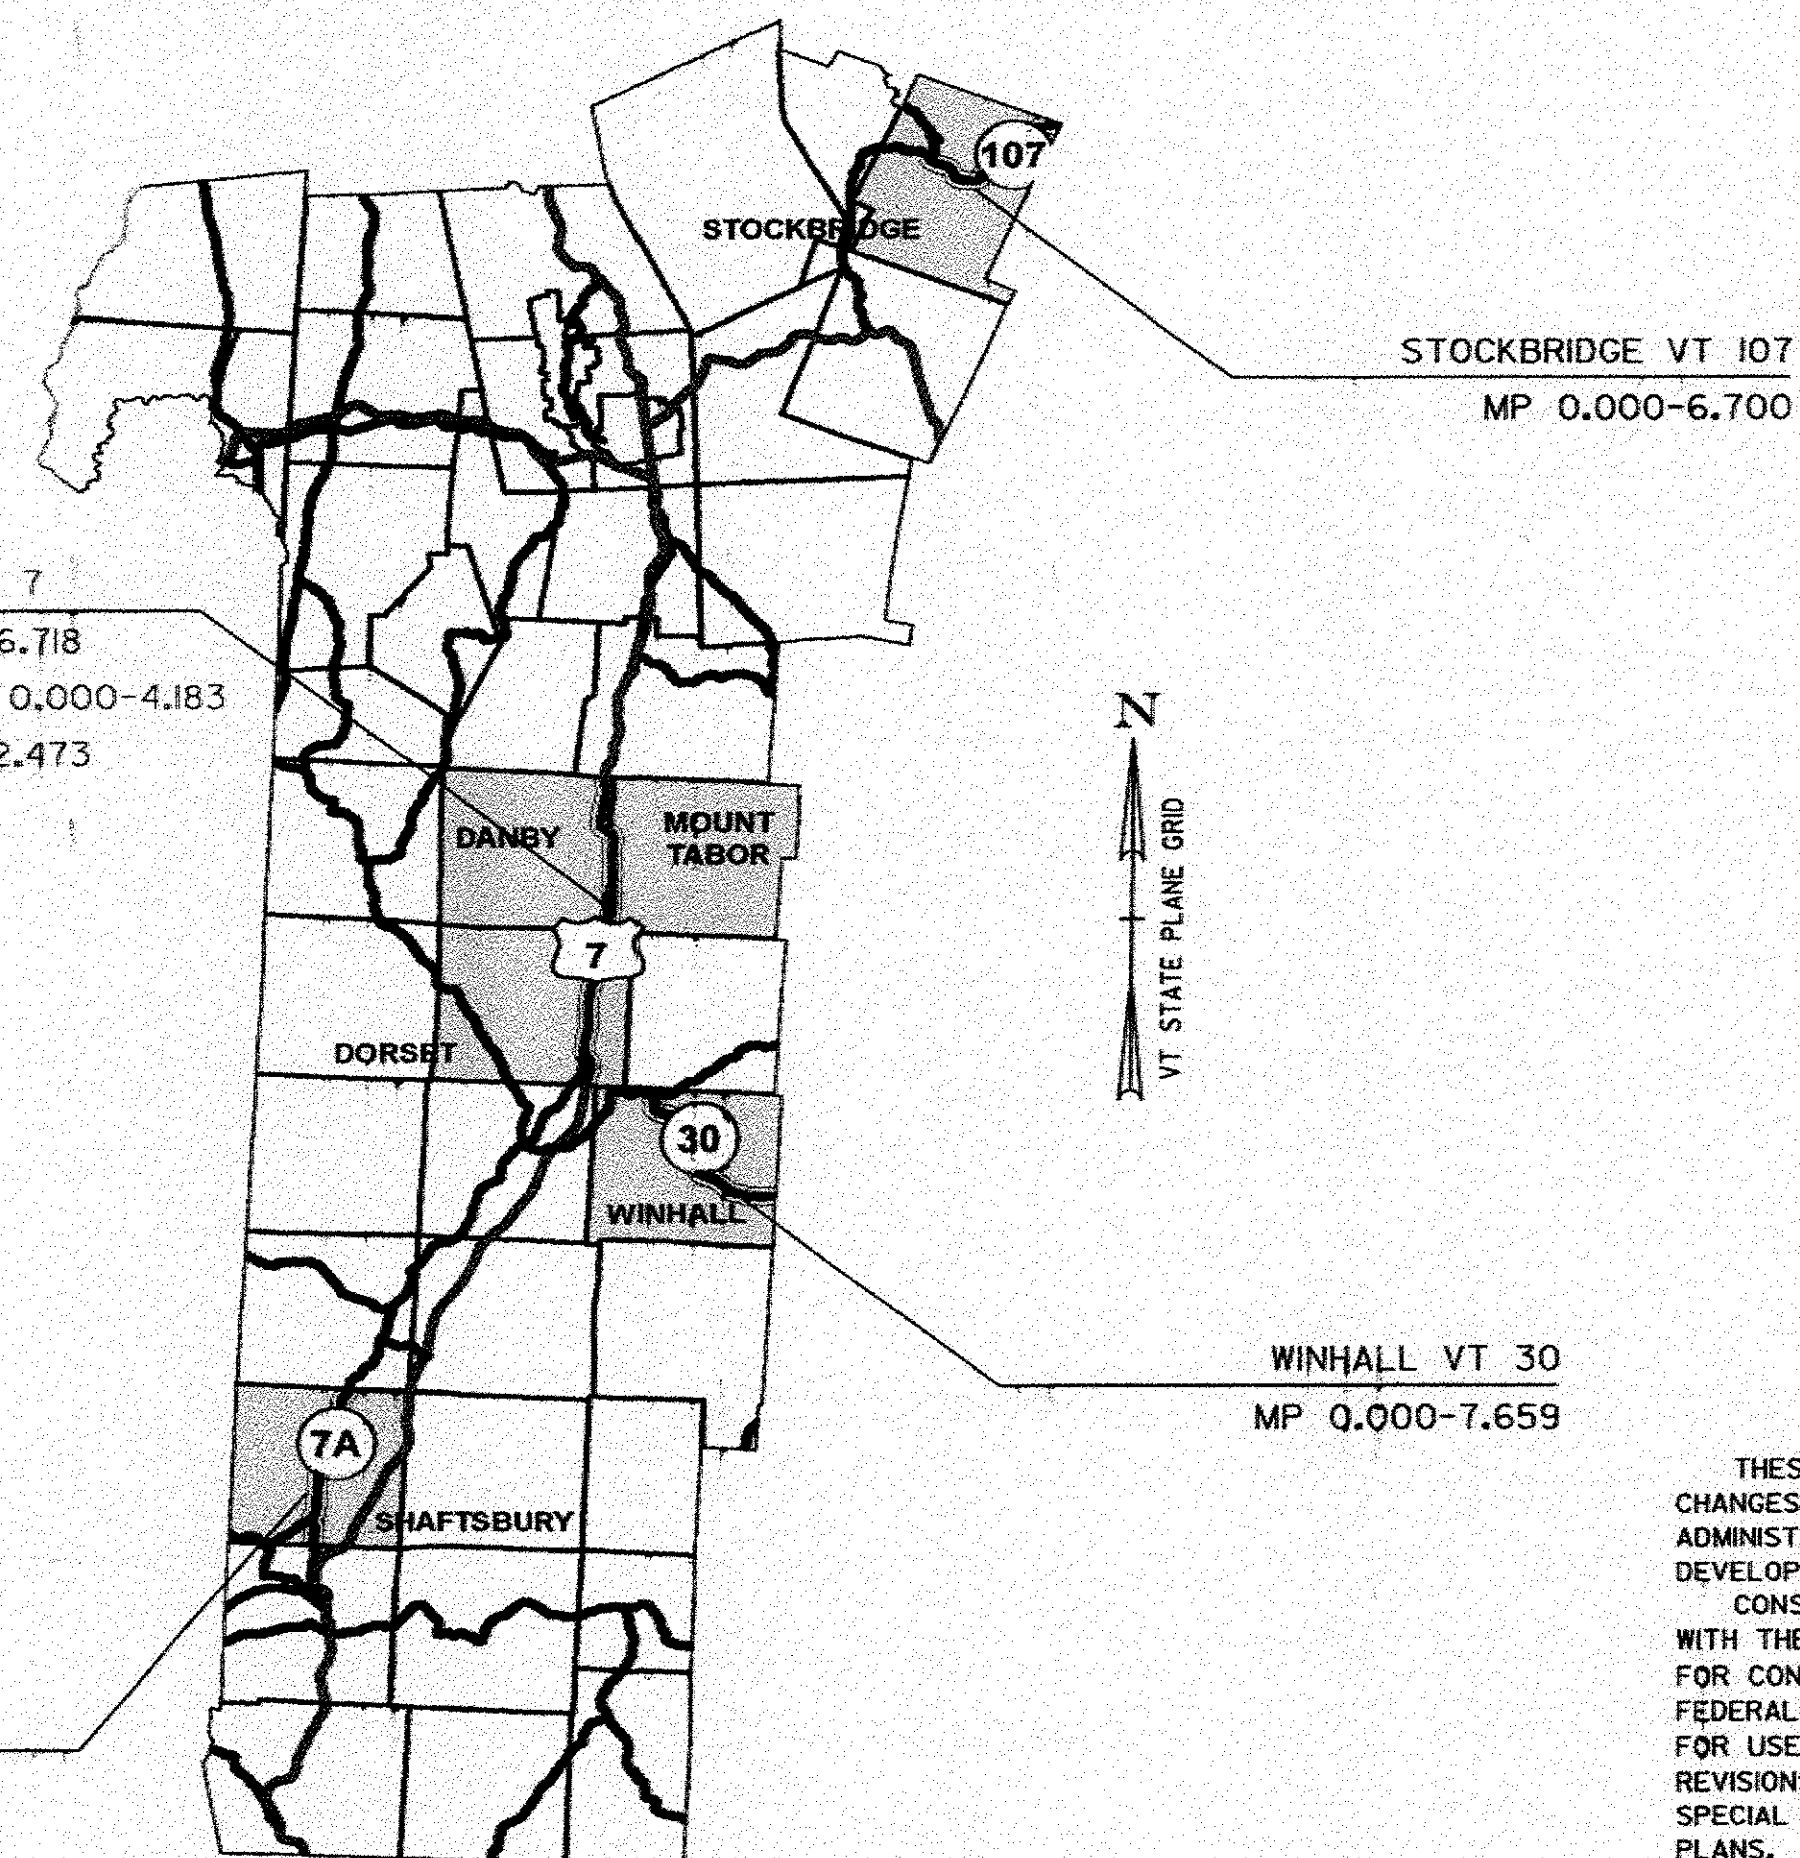

CONVENTIONAL SYMBOLS	
COUNTY LINE	
TOWN LINE	
LIMITS OF ACCESS	
POINT OF ACCESS	
FENCE LINE	
STONE WALL	
TRAVELED WAY	
GUARD RAIL	
RAILROAD	
SURVEY LINE	
CULVERT	
POWER POLE	
TELEPHONE POLE	
TREES	
CONTROL OF ACCESS	
PROPERTY LINE	
R.O.W. TAKING LINE	
SLOPE RIGHTS	
TOP OF CUT	
TOE OF SLOPE	

SURVEYED BY :	N/A
SURVEYED DATE :	N/A
DATUM	
VERTICAL	N/A
HORIZONTAL	N/A

NOT TO SCALE

THESE PLANS ARE SUBJECT TO SUCH ENGINEERING CHANGES AS MAY BE REQUIRED BY THE FEDERAL HIGHWAY ADMINISTRATION OR THE DIRECTOR OF PROGRAM DEVELOPMENT.  
CONSTRUCTION IS TO BE CARRIED ON IN ACCORDANCE WITH THESE PLANS AND THE STANDARD SPECIFICATIONS FOR CONSTRUCTION DATED 2006, AS APPROVED BY THE FEDERAL HIGHWAY ADMINISTRATION ON JUNE 15, 2006 FOR USE ON THIS PROJECT, INCLUDING ALL SUBSEQUENT REVISIONS AND SUCH REVISED SPECIFICATIONS AND SPECIAL PROVISIONS AS ARE INCORPORATED IN THESE PLANS.

DIRECTOR OF PROGRAM DEVELOPMENT	
APPROVED <i>Richard Starnes</i>	DATE 8-31-10
PROJECT MANAGER :	AMY GAMBLE
PROJECT NAME :	STATEWIDE - SOUTHWEST REGION
PROJECT NUMBER :	STPG SIGN (32)
SHEET 1 OF 90 SHEETS	