


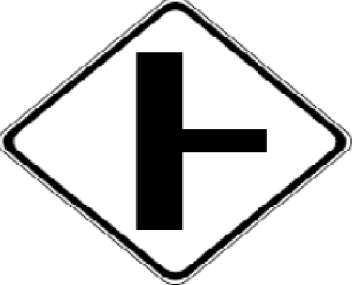






DIRECTION	MILEPOINT	LOCATION CODE (SHEET 2)	SIGN CODE	WIDTH (IN)	HEIGHT (IN)	SHEETING REMARKS	SIGN LEGEND	NEW SIGNS		EXISTING SIGNS				EXIST POST		NUMBER OF NEW POSTS	SQUARE STEEL (IN)			TUBULAR STEEL Ø (IN)				SIGN FRAME REQUIRED	REMARKS	SIGN DETAIL		
								"A"	"B"	RETAIN	SALVAGE FROM	SALVAGE TO	REMOVE	RETAIN	REMOVE		1.75	2.00	2.50	3.00	3.50	4.00	5.00			DETAIL IN SHS	DETAIL ON SHEET NUMBER	DETAIL ON STD SHEET NUMBER
																	(LB / FT)			(LB / FT)								
									1.88	2.42	3.35	FOUNDATION	7.60	9.00	10.80	14.60												
<b>WINHALL VT-30</b>							FY-FLUORESCENT YELLOW FYG-FLUORESCENT YELLOW GREEN																"SHS"-STANDARD HIGHWAY SIGNS					
		D	R1-1	30	30			6.25															REPLACE SIGN AND RETAIN SIGN POST.	X				
NB	0.700	A	R2-1	24	30			5.00							1	14.5 X							INSTALL 50 FEET SOUTH OF EXISTING SPEED LIMIT 40 SIGN ASSEMBLY.	X				
NB	0.710	A	R2-1	24	30		SPEED LIMIT 40																					
NB	0.855	A	VW-544	30	30		EMERGENCY VEHICLES																					
NB	0.955	A	R2-1	24	30		SPEED LIMIT 40																					
		A	VW-544	30	30			6.25							1	14.5 X										6		
NB	1.000	A	W2-2R	30	30																							
		A	W2-2MR	30	30			6.25							1	14.0 X										6		
NB	1.057	A	S1-1	36	36																							
		A	W16-9FYG	24	10																							
		A	S1-1	36	36	FYG		9.00							1	14.0 X								X				
		A	S4-3P	24	8	FYG		1.33																X				
NB	1.113	A	D1-1E	72	20																							
		A	D1-1E	72	20			10.00							2	14.5 15.75 X							1 ADDITIONAL SIGN REMOVED			6		
NB	1.147	C	VR-017	24	30			5.00							1	13.5 X										4		
<b>SIGN SUMMARY SHEET</b>							SHEET TOTALS	49.08	0.00	0	0	0	8 7	0	0	7	105 100.75							PROJECT NAME: STATEWIDE - SOUTHWEST REGION PROJECT NUMBER: STPG SIGN(32)				
VERMONT AGENCY OF TRANSPORTATION							TOWN DIRECTIONAL TOTALS	456.7	0.0	5.0	3.0	3.0	79	0.0	0.0	51	765.0							FILE NAME: WINHALL NB.XLS PROJECT MANAGER: A. GAMBLE DESIGNED BY: J. KELLY WINHALL NORTHBOUND SHEET 4				
																							PLOT DATE: 8/26/2010 DRAWN BY: J. KELLY CHECKED BY: A. GAMBLE SHEET 30 OF 90					