




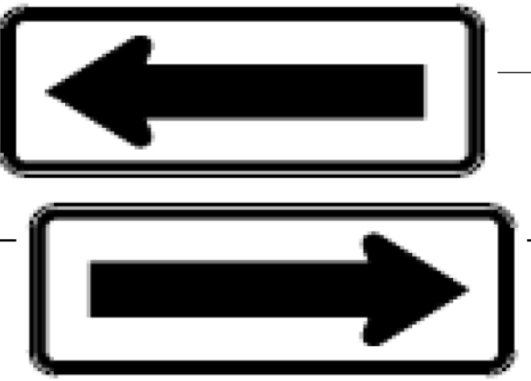



DIRECTION	MILEPOINT	LOCATION CODE (SHEET 2)	SIGN CODE	WIDTH (IN)	HEIGHT (IN)	SHEETING REMARKS	SIGN LEGEND	NEW SIGNS		EXISTING SIGNS				EXIST POST		NUMBER OF NEW POSTS	SQUARE STEEL (IN)			TUBULAR STEEL Ø (IN)				SIGN FRAME REQUIRED	REMARKS	SIGN DETAIL			
								"A"	"B"	RETAIN	SALVAGE FROM	SALVAGE TO	REMOVE	RETAIN	REMOVE		1.75	2.00	2.50	FOUNDATION	3.00	3.50	4.00			5.00	DETAIL IN SHS	DETAIL ON SHEET NUMBER	DETAIL ON STD SHEET NUMBER
																	(LB / FT)				(LB / FT)								
STOCKBRIDGE VT-107							FY-FLUORESCENT YELLOW FYG-FLUORESCENT YELLOW GREEN																"SHS"-STANDARD HIGHWAY SIGNS						
EB	4.240	A	S3-1	30	30																								
EB	5.085	A	VW-619	30	30																								
		A	VW-619	36	36			9.00							2			15.0 15.5 X							6				
EB	5.148	A	VW-054R	30	30																								
		A	VW-054R	30	30			6.25							1			15.0 X							6				
EB	5.426	A	W1-4L	30	30		LEFT REVERSE CURVE																						
EB	5.485	A	W1-4L	30	30			6.25							1			15.0 X						X					
EB	6.460	A	W1-2L	30	30	FY		6.25							1			15.5 X						X					
		A	W13-1	18	18	FY		2.25																X					
EB	6.524	A	W1-6	48	24																								
		B	W1-6	48	24																								
		A	W1-6	48	24	FY		8.00							2			13.25 13.0 X						X					
		B	W1-6	48	24	FY		8.00																X					
WB	0.490	F	VW-054R	30	30			6.25							1			14.5 X											
SIGN SUMMARY SHEET							SHEET TOTALS	52.25 46.00	0.00	0	0	0	6	0	0	7			405.16.75					PROJECT NAME: STATEWIDE - SOUTHWEST REGION PROJECT NUMBER: STPG SIGN(32)					
VERMONT AGENCY OF TRANSPORTATION							TOWN DIRECTIONAL TOTALS	138 131.8	0.0	24.0	1.0	1.0	24 23	0.0	0.0	20 19			295.0 286.0					FILE NAME: STOCKBRIDGE EB.XLS PROJECT MANAGER: A. GAMBLE DESIGNED BY: J. KELLY STOCKBRIDGE EASTBOUND SHEET 5	PLOT DATE: 7/13/2010 DRAWN BY: J. KELLY CHECKED BY: A. GAMBLE SHEET 81 OF 90				