

STATE OF VERMONT AGENCY OF TRANSPORTATION




PROPOSED IMPROVEMENT TOWNS OF DORSET, MOUNT TABOR, DANBY, SHAFTSBURY, WINHALL, AND STOCKBRIDGE COUNTIES OF BENNINGTON, RUTLAND, AND WINDSOR VERMONT ROUTES 7A, 30, 107 US ROUTE 7

SOUTHWEST REGION SIGN REPLACEMENT - 32.878 MILES:
US 7 DORSET MP 1.750-DANBY MP 2.473, VT 7A SHAFTSBURY MP 0.000-6.895,
VT 30 WINHALL MP 0.000-7.659, VT 107 STOCKBRIDGE MP 0.000-6.700


LENGTH OF ROADWAY = 32.878 MILES
LENGTH OF PROJECT = 32.878 MILES

WORK TO BE PERFORMED UNDER THIS PROJECT INCLUDES THE REMOVAL OF EXISTING SIGNS AND POSTS
AND THE INSTALLATION OF NEW SIGNS AND SIGN POSTS AND INCIDENTAL ITEMS.

INDEX OF SHEETS
SEE SHEET 2

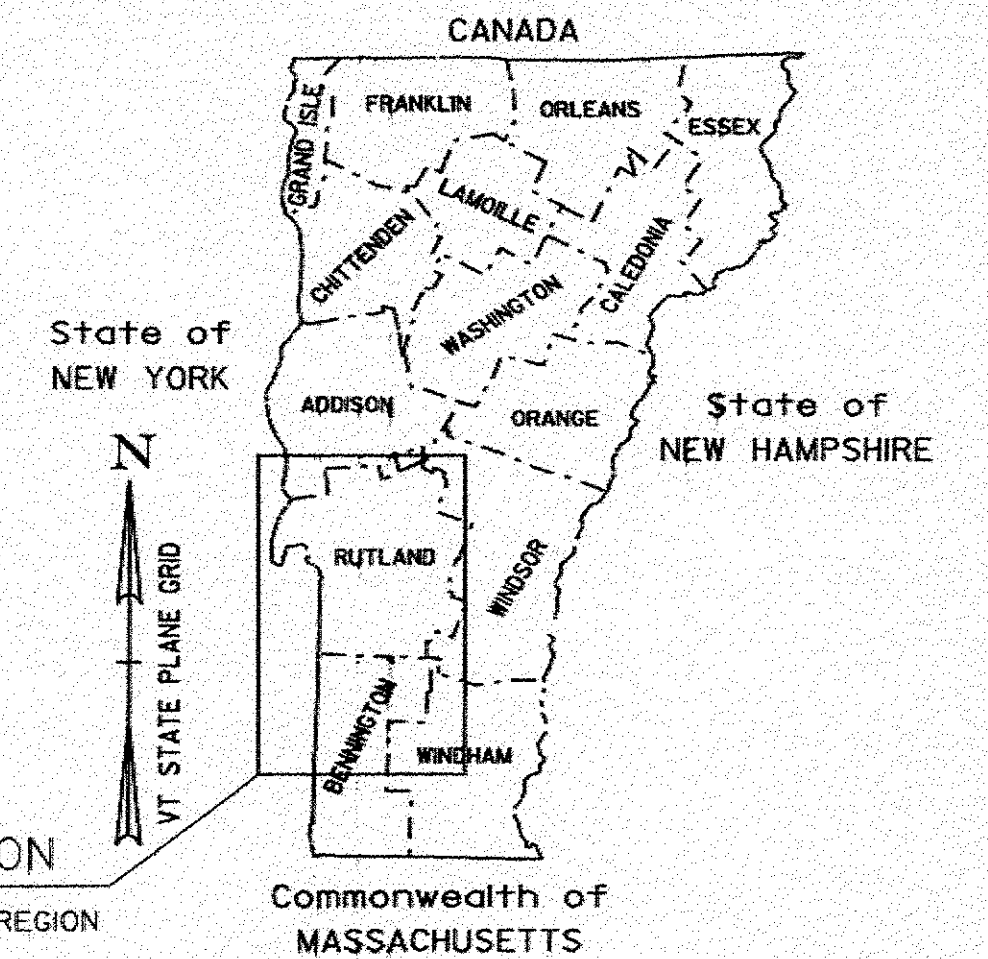

RECORD PLANS	
CONTRACTOR:	F. R. LAFAYETTE, INC. - ESSEX JUNCTION, VT.
RESIDENT ENGINEER:	JOSH HULETT
CONSTRUCTION BEGAN:	JUNE 14, 2011
CONSTRUCTION COMPLETE:	JULY 7, 2011
RECORD PLANS BY:	JOSH HULETT & C. PIERCE
I HEREBY CERTIFY THAT ALL THE CONSTRUCTION REQUIRED BY THIS SET OF DRAWINGS HAS BEEN ACCOMPLISHED AS INDICATED HEREIN.	
BY	<i>Josh Hulett</i> RESIDENT ENGINEER
DATE	5/22/12
NOTE: Any further information concerning final quantities, amounts or other details relative to this project may be found at Central Files in the electronic archives.	

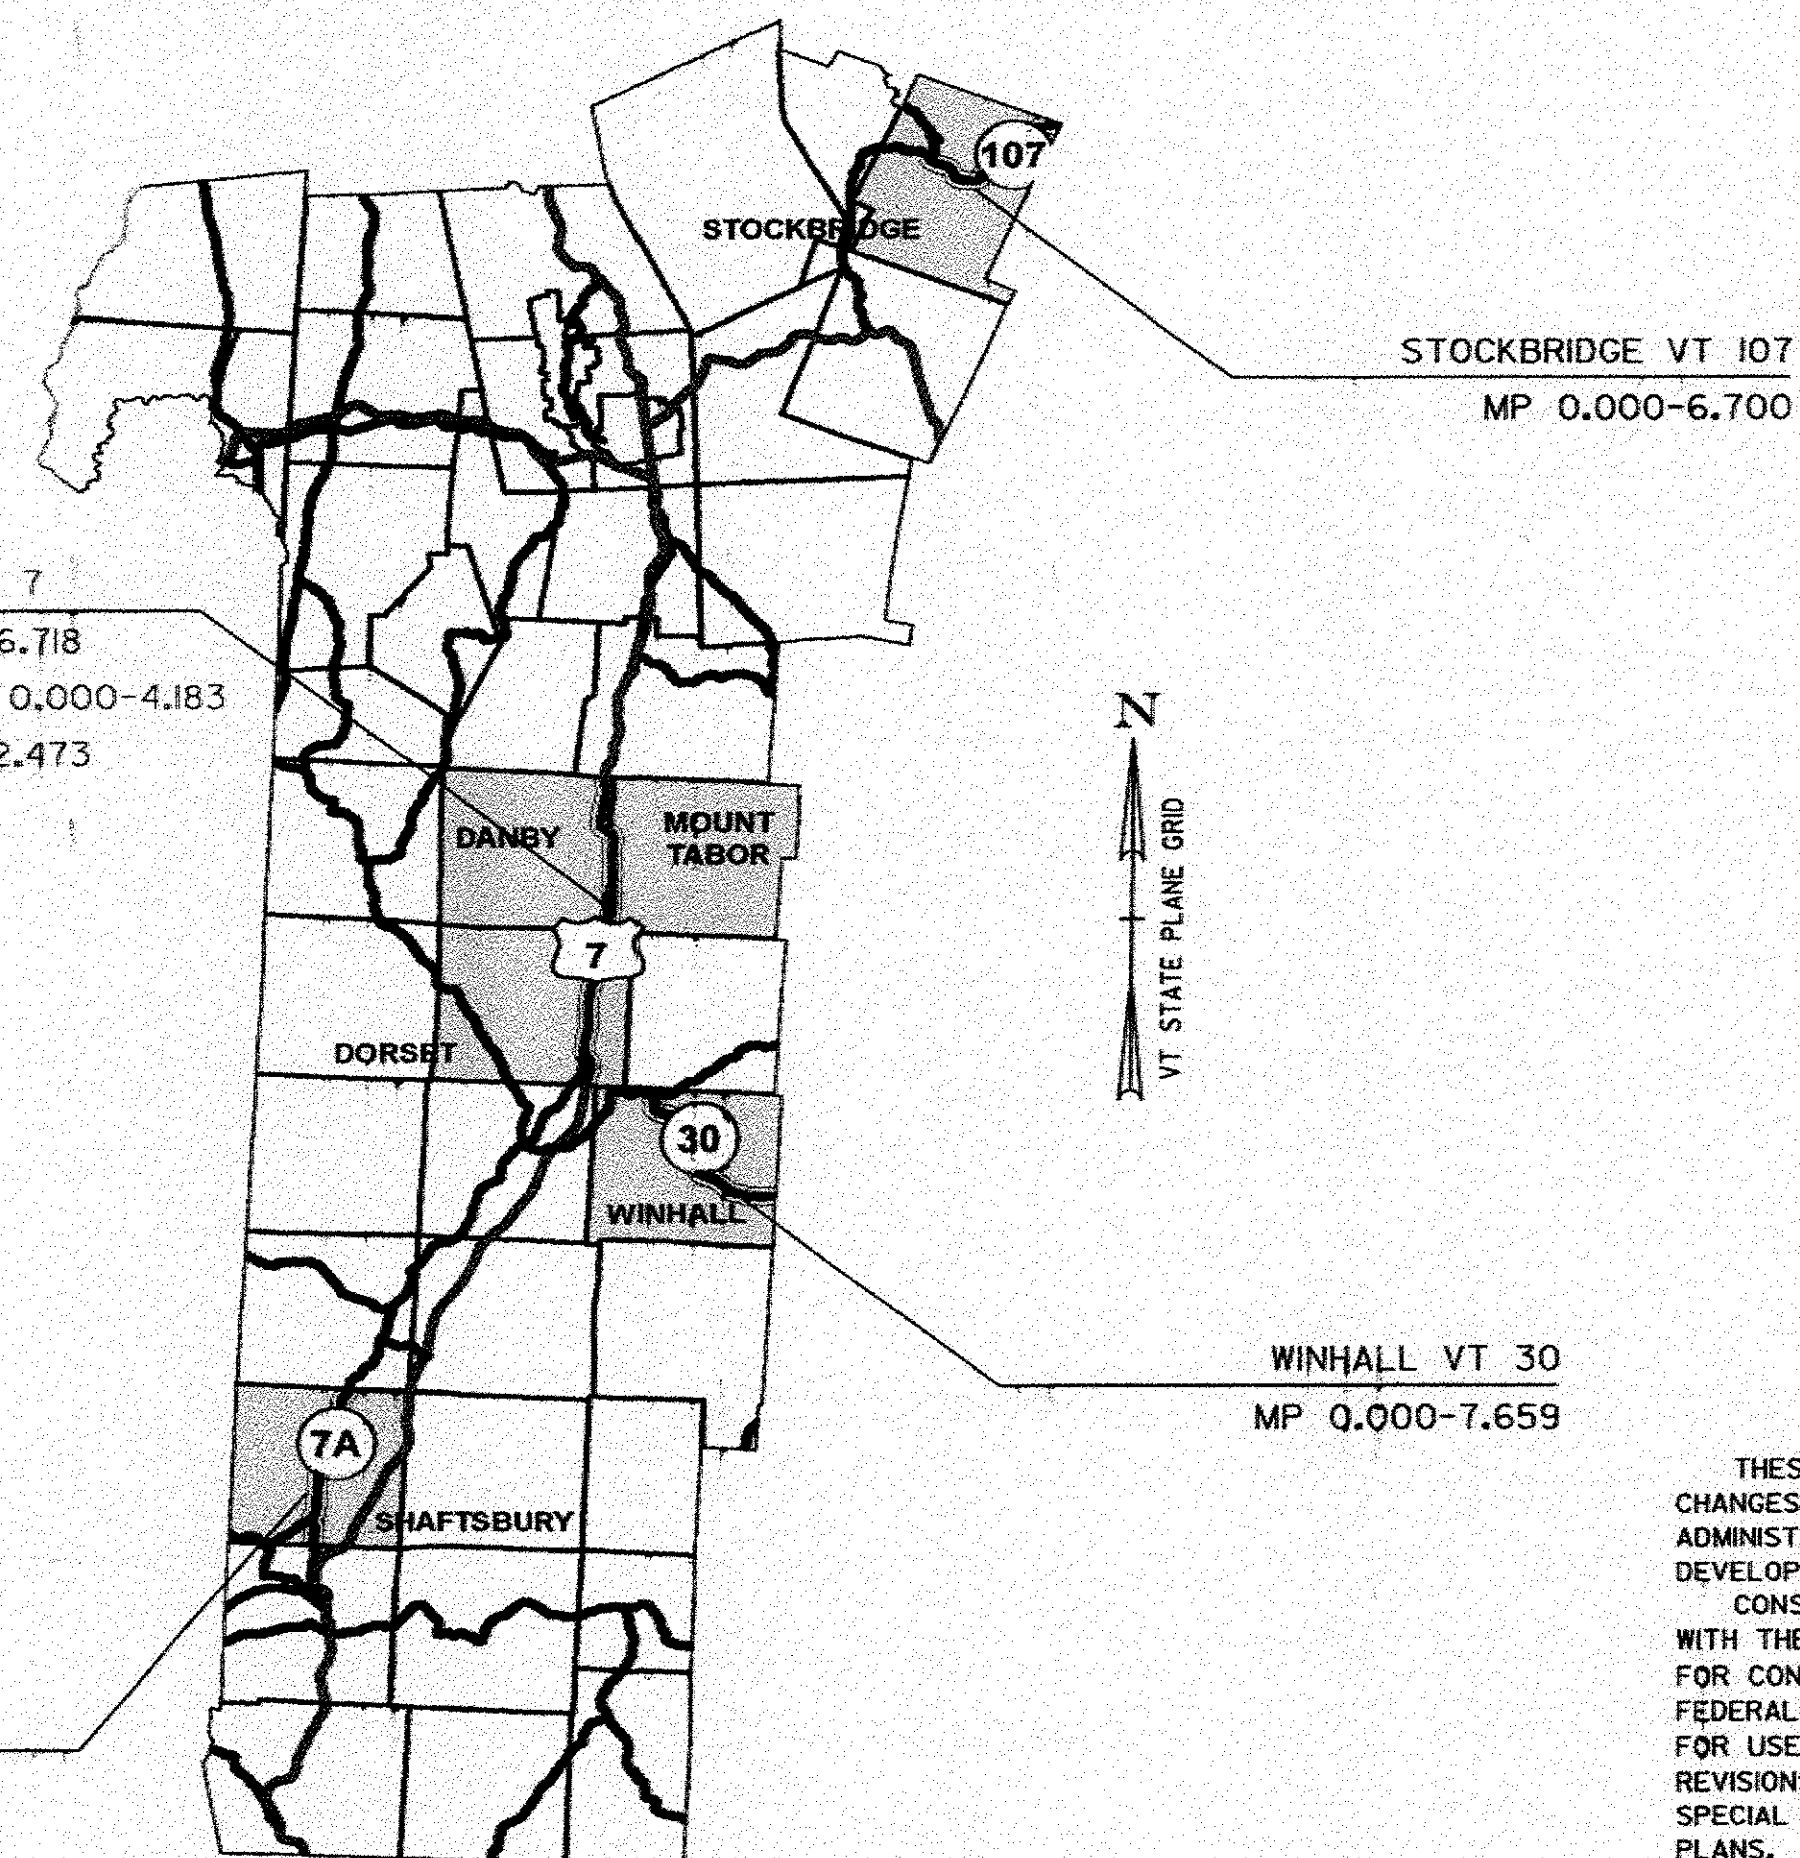

NOT TO SCALE

THESE PLANS ARE SUBJECT TO SUCH ENGINEERING CHANGES AS MAY BE REQUIRED BY THE FEDERAL HIGHWAY ADMINISTRATION OR THE DIRECTOR OF PROGRAM DEVELOPMENT.
CONSTRUCTION IS TO BE CARRIED ON IN ACCORDANCE WITH THESE PLANS AND THE STANDARD SPECIFICATIONS FOR CONSTRUCTION DATED 2006, AS APPROVED BY THE FEDERAL HIGHWAY ADMINISTRATION ON JUNE 15, 2006 FOR USE ON THIS PROJECT, INCLUDING ALL SUBSEQUENT REVISIONS AND SUCH REVISED SPECIFICATIONS AND SPECIAL PROVISIONS AS ARE INCORPORATED IN THESE PLANS.

DIRECTOR OF PROGRAM DEVELOPMENT	
APPROVED <i>Richard Starnes</i>	DATE 8-31-10
PROJECT MANAGER	AMY GAMBLE
PROJECT NAME :	STATEWIDE - SOUTHWEST REGION
PROJECT NUMBER :	STPG SIGN (32)
SHEET 1 OF 90 SHEETS	

CONVENTIONAL SYMBOLS	
COUNTY LINE	
TOWN LINE	
LIMITS OF ACCESS	
POINT OF ACCESS	
FENCE LINE	
STONE WALL	
TRAVELED WAY	
GUARD RAIL	
RAILROAD	
SURVEY LINE	
CULVERT	
POWER POLE	
TELEPHONE POLE	
TREES	
CONTROL OF ACCESS	
PROPERTY LINE	
R.O.W. TAKING LINE	
SLOPE RIGHTS	
TOP OF CUT	
TOE OF SLOPE	

SURVEYED BY :	N/A
SURVEYED DATE :	N/A
DATUM	
VERTICAL	N/A
HORIZONTAL	N/A

INDEX SHEETS

1	TITLE SHEET
2	GENERAL NOTES
3	QUANTITY SHEET
4-6	SIGN DETAILS
7	ROUTE MARKER SIGN ASSEMBLY
8-17	SHAFTSBURY NB VT-7A TRAFFIC SIGN SUMMARY SHEETS 1-10
18-26	SHAFTSBURY SB VT-7A TRAFFIC SIGN SUMMARY SHEETS 1-9
27-38	WINHALL NB VT-30 TRAFFIC SIGN SUMMARY SHEETS 1-12
39-50	WINHALL SB VT-30 TRAFFIC SIGN SUMMARY SHEETS 1-12
51-55	DORSET NB US-7 TRAFFIC SIGN SUMMARY SHEETS 1-5
56-62	DORSET SB US-7 TRAFFIC SIGN SUMMARY SHEETS 1-7
63-67	MOUNT TABOR NB US-7 TRAFFIC SIGN SUMMARY SHEETS 1-5
68-72	MOUNT TABOR SB US-7 TRAFFIC SIGN SUMMARY SHEETS 1-5
73-74	DANBY NB US-7 TRAFFIC SIGN SUMMARY SHEETS 1-2
75-76	DANBY SB US-7 TRAFFIC SIGN SUMMARY SHEETS 1-2
77-81	STOCKBRIDGE EB VT-107 TRAFFIC SIGN SUMMARY SHEETS 1-5
82-87	STOCKBRIDGE WB VT-107 TRAFFIC SIGN SUMMARY SHEETS 1-6
88	TOWN TOTAL SIGN SUMMARY SHEET
89-90	TRAFFIC CONTROL SHEETS

STANDARDS

E-121	STANDARD SIGN PLACEMENT CONVENTIONAL ROAD	08/08/1995
E-136B	STATE ROUTE MARKER SIGN DETAILS	08/08/1995
E-138	MILEMARKER DETAILS STATE AND TOWN HIGHWAYS	05/30/2003
E-145A	REGULATORY SIGN DETAILS LANE USE CONTROL SIGNS	12/23/1994
E-164	SQUARE STEEL SIGN POST	06/08/09

GENERAL NOTES

SIGN DESIGN AND FABRICATION:

- ALL SIGNS SHALL BE DESIGNED IN ACCORDANCE WITH THE LATEST REVISION OF THE 2009 MUTCD AND THE 2004 STANDARD HIGHWAY SIGN AND MARKINGS BOOK (SHS), VAOT STANDARDS OR AS DETAILED ON THE PLANS.
- ALL LETTERS AND NUMBERS USED FOR ALL SIGNS SHALL CONFORM TO THE APPLICABLE FONT AS DEFINED AND DETAILED IN THE 2004 SHS.
- ALL ARROWS AND SYMBOLS SHALL CONFORM WITH THE 2004 SHS UNLESS OTHERWISE DETAILED ON THE PLANS.
- COLORS USED ON ALL SIGNS SHALL CONFORM WITH THE REQUIREMENTS OF SECTION 1A.2 OF THE MUTCD. FY = FLUORESCENT YELLOW, FYG = FLUORESCENT YELLOW GREEN.
- SIGN SHEETING FOR FLUORESCENT YELLOW AND FLUORESCENT YELLOW GREEN SHALL BE ASTM D4956 TYPE VII, VIII OR IX. ALL OTHER SIGN SHEETING SHALL BE TYPE III OR IV.
- SHEETING TYPES AND MANUFACTURERS SHALL NOT BE MIXED ON A SINGLE SIGN ASSEMBLY. SHEETING COLOR/TYPE SHOULD BE BY THE SAME MANUFACTURER AND BE CONSISTENT THROUGHOUT THE PROJECT.
- SIGN BASE MATERIAL FOR DELINEATORS AND MILE MARKER PLAQUES (VD-700) SHALL BE 0.063" THICK FLAT SHEET ALUMINUM. UNLESS OTHERWISE NOTED ON THE PLANS, ALL OTHER SIGNS SHALL BE FLAT SHEET ALUMINUM WITH THE FOLLOWING MINIMUM THICKNESSES:


SIGN SIZE	9" X 12"		
	12" X 12"		
	18" X 18"		
	24" X 15"		
	24" X 10"		48" X 18"
	24" X 12"	36" X 12"	48" X 24"
	24" X 18"	36" X 15"	48" X 30"
	24" X 24"	36" X 18"	48" X 42"
	24" X 30"	36" X 24"	48" X 48"
	30" X 15"	30" X 42"	48" X 60"
	30" X 18"	36" X 36"	72" X 10"
30" X 30"	36" X 48"	72" X 12"	
30" X 42"	36" X 54"	72" X 20"	
THICKNESS	0.080"	0.100"	0.125"

SIGN POSTS:

- ALL SIGN POSTS SHALL BE INSTALLED IN A NEW ANCHOR. ALL SIGNS INSTALLED IN PAVED OR CONCRETE ISLANDS OR SIDEWALKS SHALL ALSO BE INSTALLED WITH AN 18" SLEEVE.
- 1.75" SQUARE STEEL POSTS SHALL BE 14 GAUGE STEEL. 2" AND 2.5" SQUARE STEEL POSTS SHALL BE 12 GAUGE STEEL.

SIGN INSTALLATION:

- THE CONTRACTOR SHALL BE RESPONSIBLE FOR REPAIRING ANY DAMAGE TO PRIVATE OR PUBLIC PROPERTY CAUSED BY THE CONTRACTOR, AT THEIR EXPENSE.
- ALL SIGNS WITHIN THE PROJECT LIMITS ARE TO BE REPLACED UNLESS OTHERWISE NOTED OR AS DIRECTED BY THE RESIDENT ENGINEER. SIGN LOCATIONS AS SHOWN ON THE PLANS ARE APPROXIMATE. EXACT LOCATIONS TO BE DETERMINED BY THE ENGINEER IN THE FIELD.
- ALL SIGN PLACEMENT SHALL BE IN CONFORMANCE WITH VAOT STANDARD E-121 STANDARD SIGN PLACEMENT CONVENTIONAL ROADS.

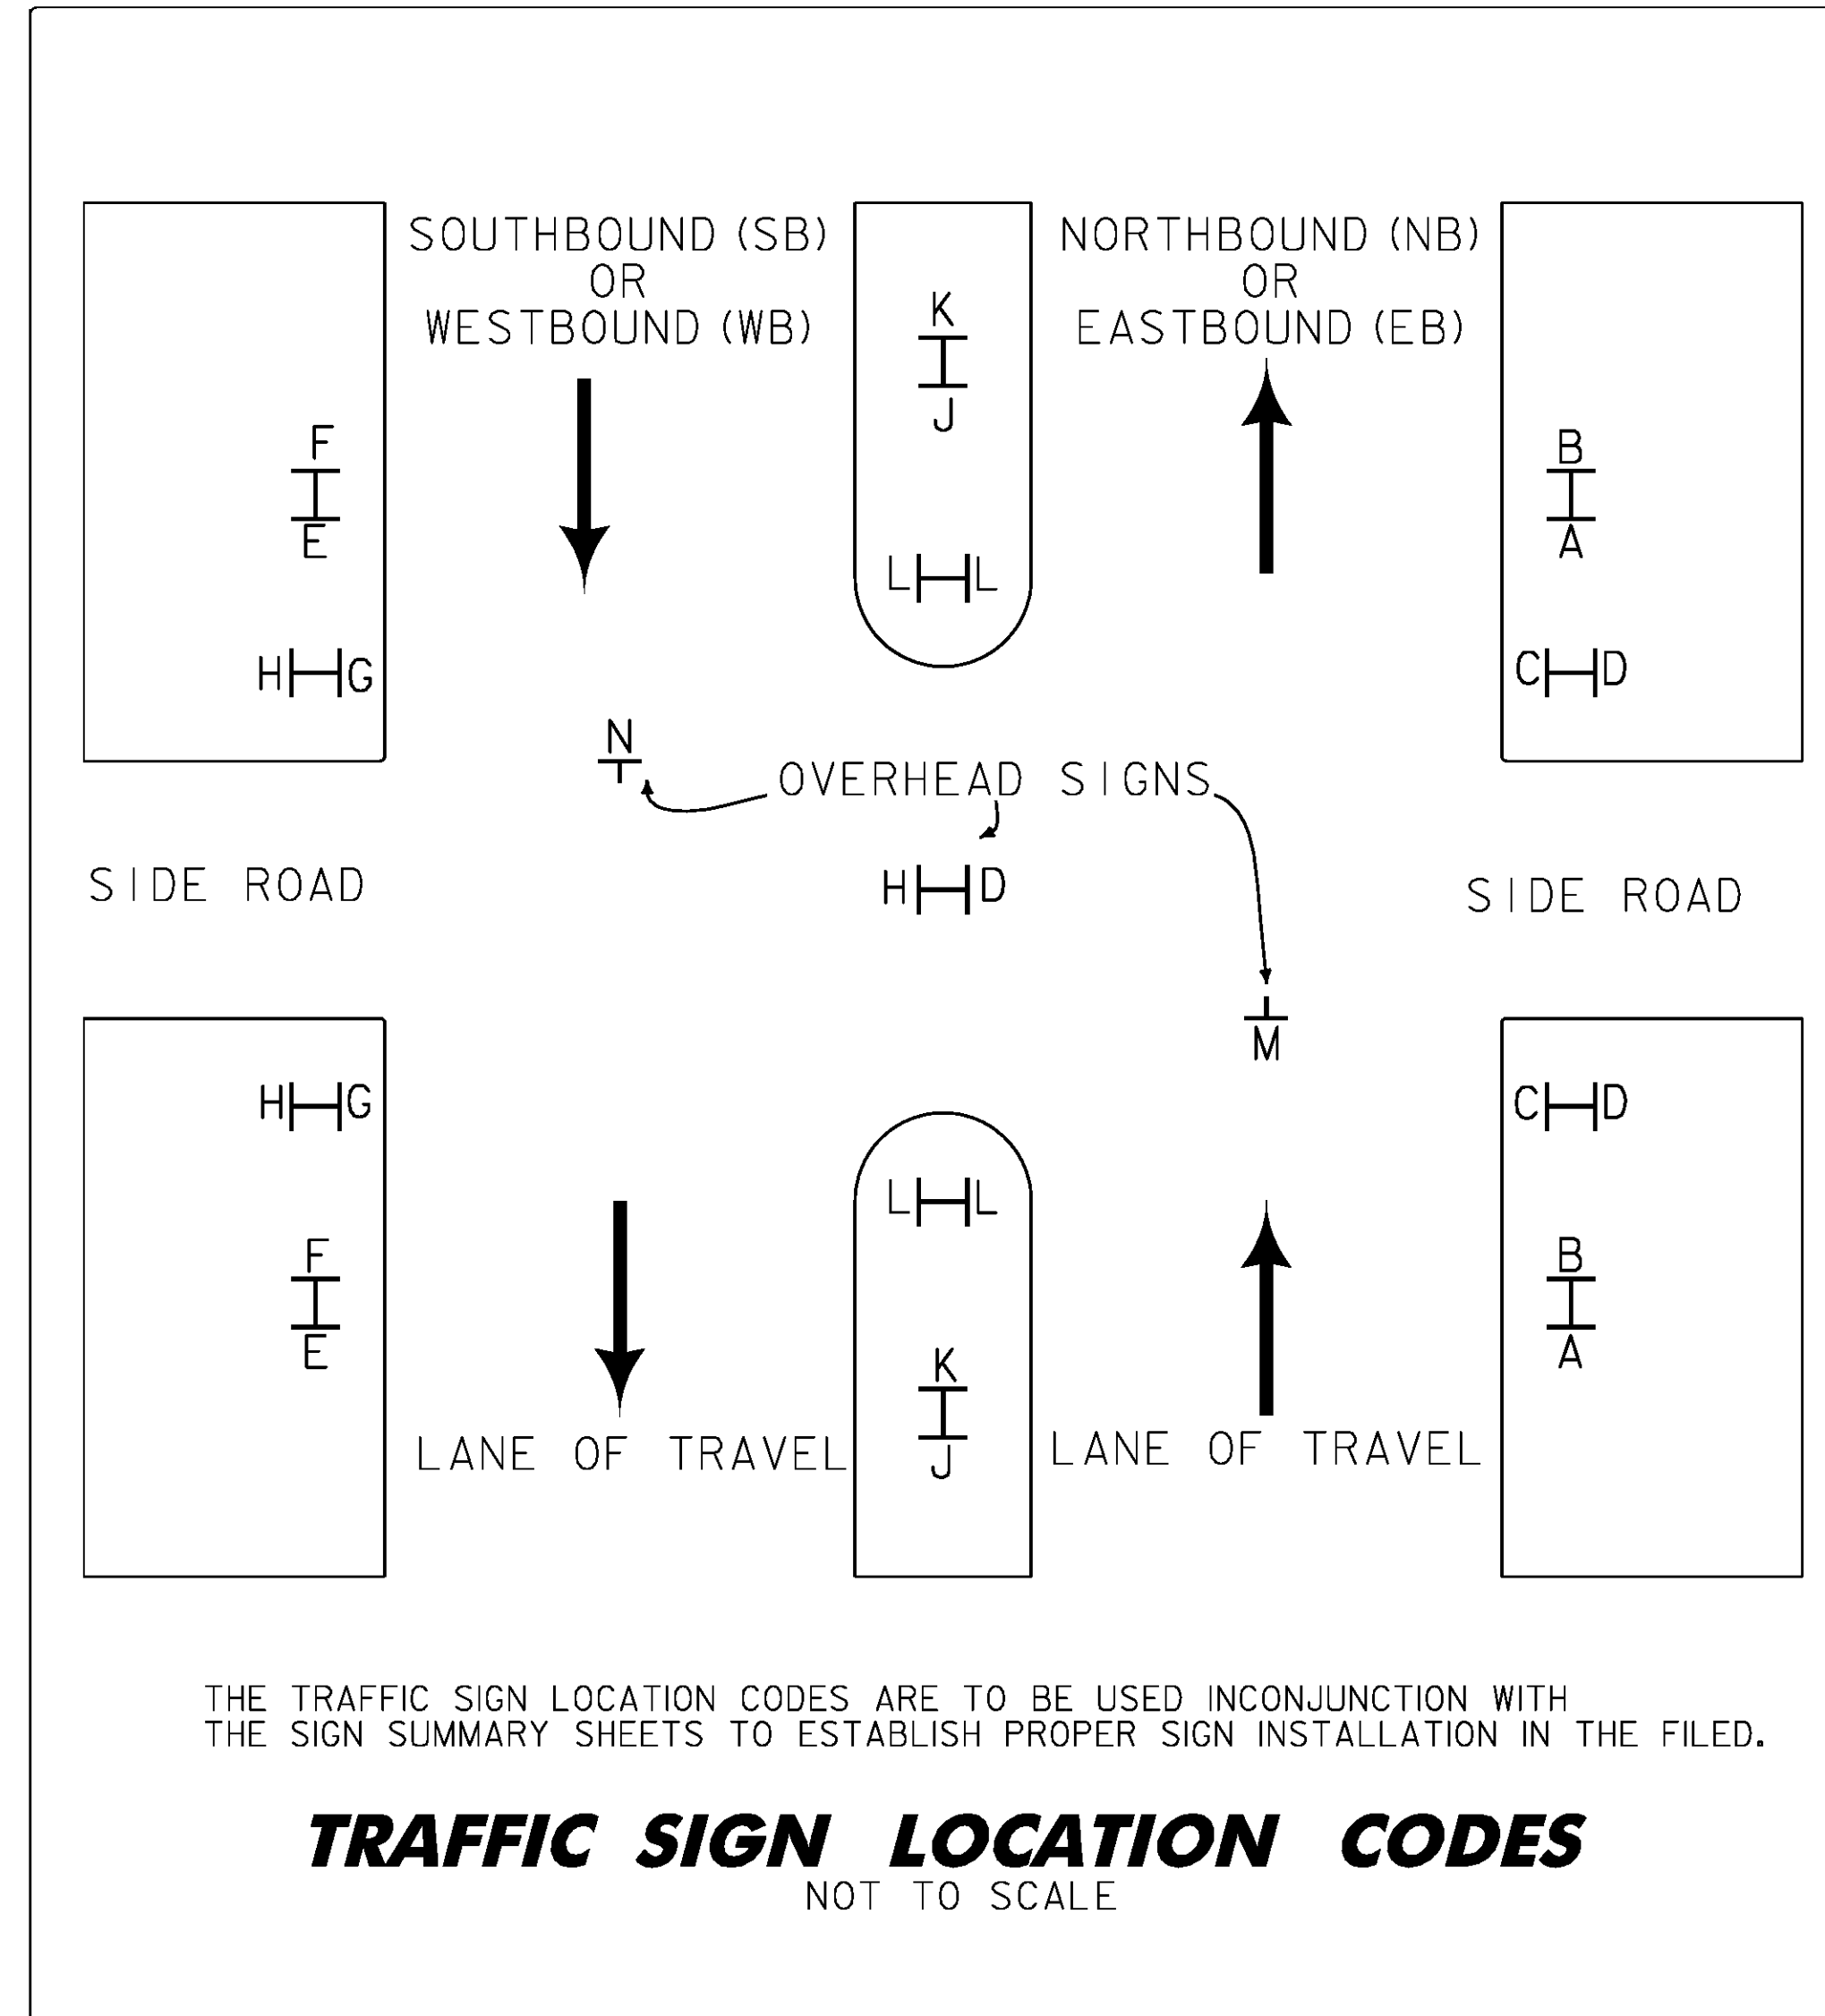

THE TRAFFIC SIGN LOCATION CODES ARE TO BE USED INCONJUNCTION WITH THE SIGN SUMMARY SHEETS TO ESTABLISH PROPER SIGN INSTALLATION IN THE FILED.

TRAFFIC SIGN LOCATION CODES
NOT TO SCALE

GENERAL NOTES:

- ALL EXISTING MILE MARKER PLAQUES ATTACHED TO A DELINEATOR POST OR ATTACHED TO A RETAINED STAND ALONE SIGN POST ASSEMBLY SHALL BE RETAINED. IF AN EXISTING MILE MARKER PLAQUE IS ATTACHED TO A SIGN POST THAT IS TO BE REMOVED AND REPLACED IN THE SAME LOCATION, THE MILE MARKER PLAQUE SHALL BE REMOVED, SALVAGED AND INSTALLED ONTO THE NEW SIGN POST. IF AN EXISTING MILE MARKER PLAQUE IS ATTACHED TO A SIGN POST THAT IS TO BE RELOCATED TO A DIFFERENT LOCATION, THE MILE MARKER PLAQUE SHALL BE REMOVED, UNLESS OTHERWISE DIRECTED BY THE ENGINEER. PAYMENT FOR THIS WORK SHALL BE INCIDENTAL TO ITEM 675.341 SQUARE TUBE SIGN POST AND ANCHOR. PAYMENT FOR NEW MILE MARKERS AS SHOWN ON THESE PLANS SHALL BE PAID FOR AS ITEM 675.20 TRAFFIC SIGNS, TYPE A.
- SALVAGED SIGN TOTALS HAVE BEEN ADDED TO THE TOTAL SIGN REMOVAL COLUMN ON THE TOWN TOTAL SIGN SUMMARY SHEET.
- EXISTING STREET NAME SIGNS ATTACHED TO SIGN POSTS THAT ARE TO BE REPLACED SHALL BE REMOVED AND INSTALLED ONTO NEW POST. ALL WORK AND MATERIALS NECESSARY TO REMOVE AND INSTALL THE STREET NAME SIGNS SHALL BE PAID UNDER ITEM 675.60 ERECTING SALVAGED SIGNS. AN ESTIMATED QUANTITY HAS BEEN ADDED TO ITEM 675.60 TO PAY FOR THIS WORK.
- ALL EXISTING STREET NAME OR BUS STOP SIGNS INSTALLED ON STAND ALONE SIGN POSTS SHALL BE RETAINED UNLESS OTHERWISE NOTED.
- SELECTIVE CUTTING OF TREES OR TREE BRANCHES MAY BE NECESSARY TO PROVIDE FULL VISIBILITY FOR ANY EXISTING (RETAINED) OR NEW SIGN LOCATIONS FOR A DISTANCE OF 200 FEET. THIS WORK WILL BE PERFORMED AT THE DIRECTION OF THE RESIDENT ENGINEER IN ACCORDANCE WITH 20L05 THINNING AND TRIMMING PART (b); AND SHALL BE INCIDENTAL TO ITEM 675.20 TRAFFIC SIGNS, TYPE A. UNLESS OTHERWISE DIRECTED BY THE RESIDENT ENGINEER ALL CUT MATERIAL SHALL BE DISPOSED OF IN COMPLIANCE WITH APPLICABLE LAWS OF THE STATE OF VERMONT.

PROJECT NAME: STATEWIDE - SOUTHWEST REGION










PROJECT NUMBER: STPG SIGN (32)

FILE NAME: 10b012.TS.DGN
PROJECT LEADER: A. GAMBLE
DESIGNED BY: J. KELLY
GENERAL NOTES

PLOT DATE: 03-SEP-2010
DRAWN BY: J. KELLY
CHECKED BY: A. GAMBLE
SHEET 2 OF 90


QUANTITY SHEET 1

SUMMARY OF ESTIMATED QUANTITIES														TOTALS			DESCRIPTIONS				DETAILED SUMMARY OF QUANTITIES		
														ROADWAY	GRAND TOTAL	FINAL	UNIT	ITEMS	ITEM NUMBER	ROUND	QUANTITIES	UNIT	ITEMS
														1	1		CY	TRENCH EXCAVATION OF EARTH, EXPLORATORY (N.A.B.I.)	204.22				
														30	30		HR	UNIFORMED TRAFFIC OFFICERS	630.10				
														500	500		HR	FLAGGERS	630.15				
														1	1		LS	MOBILIZATION/DEMOBILIZATION	635.11				
														1	1		LS	TRAFFIC CONTROL	641.10				
														2477.2	2477.2		SF	TRAFFIC SIGNS, TYPE A	675.20				
														5070	5070		LF	SQUARE TUBE SIGN POST AND ANCHOR	675.341				
														504	504		EACH	REMOVING SIGNS	675.50				
														25	25		EACH	ERECTING SALVAGED SIGNS	675.60				

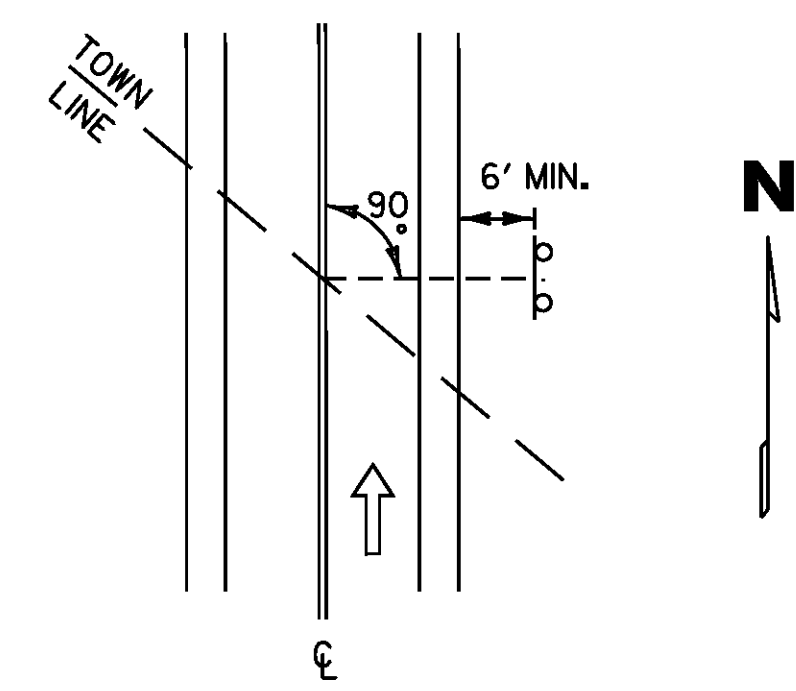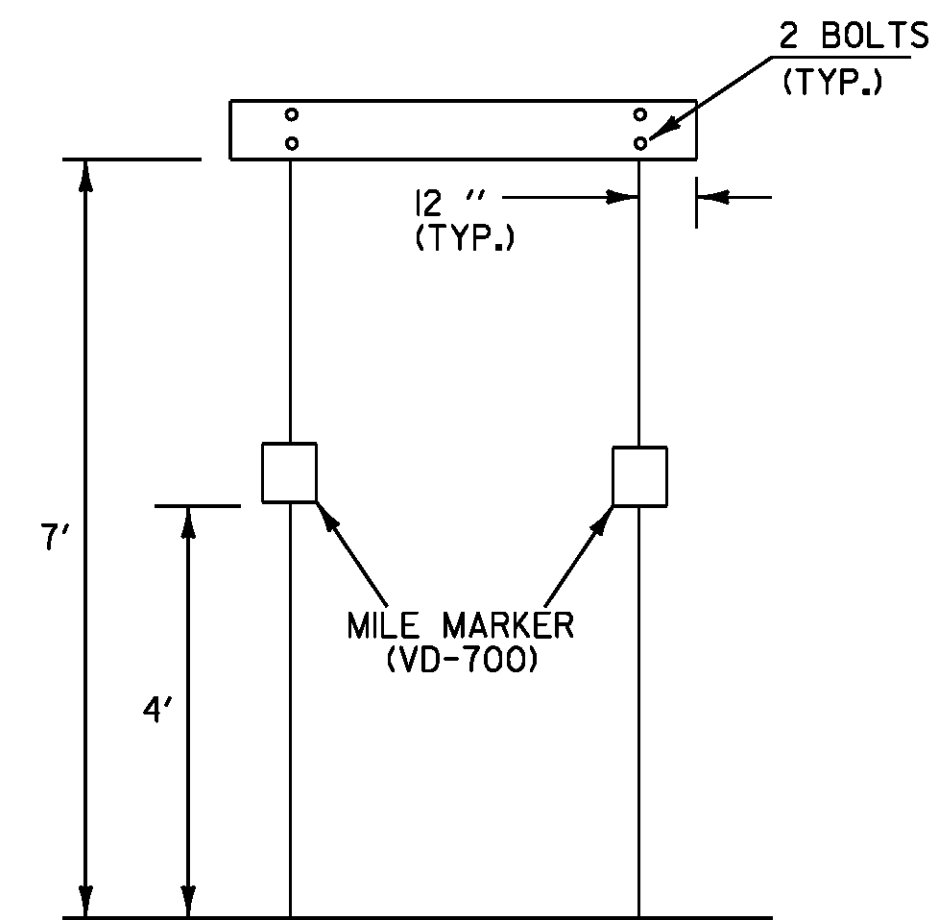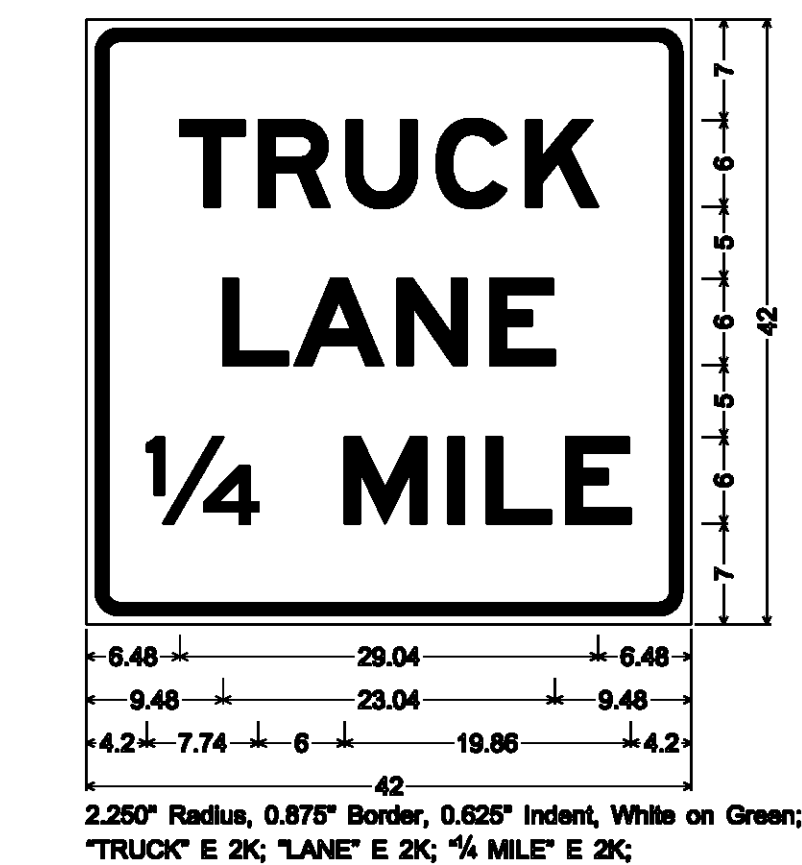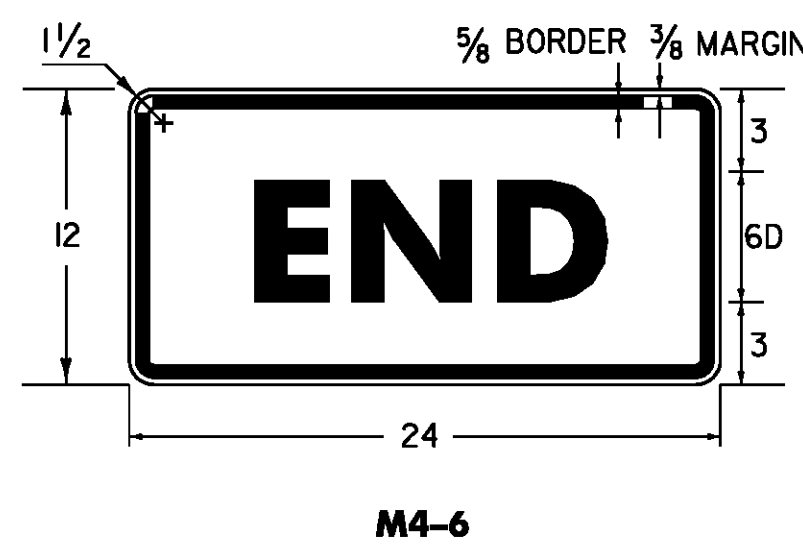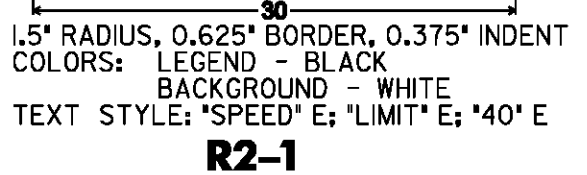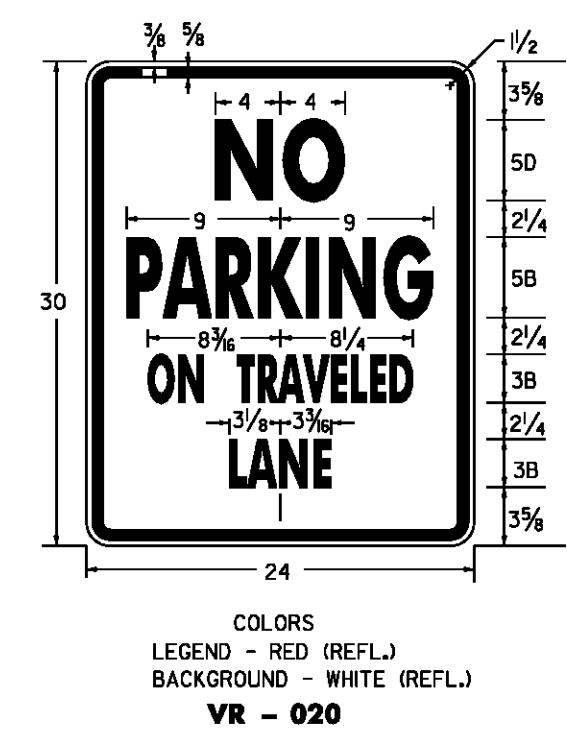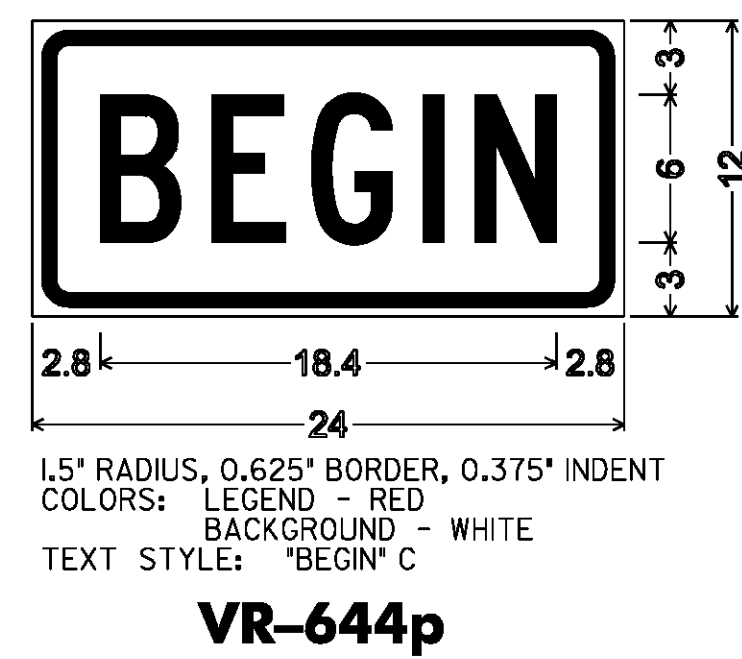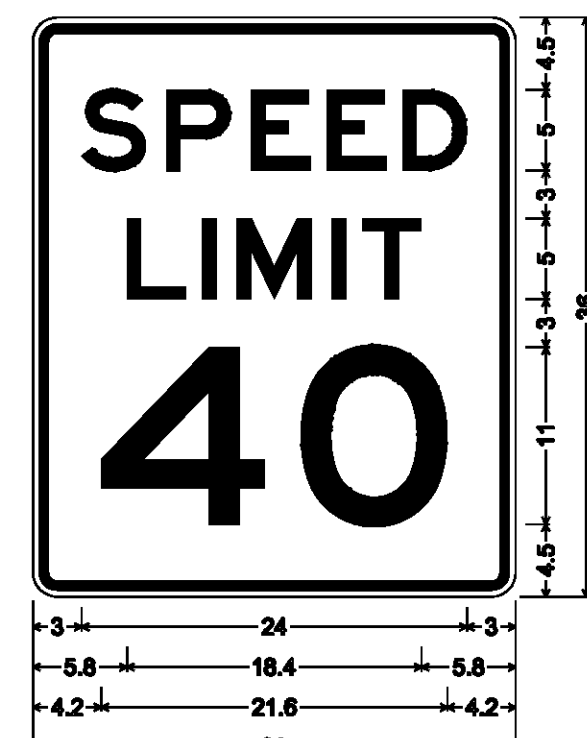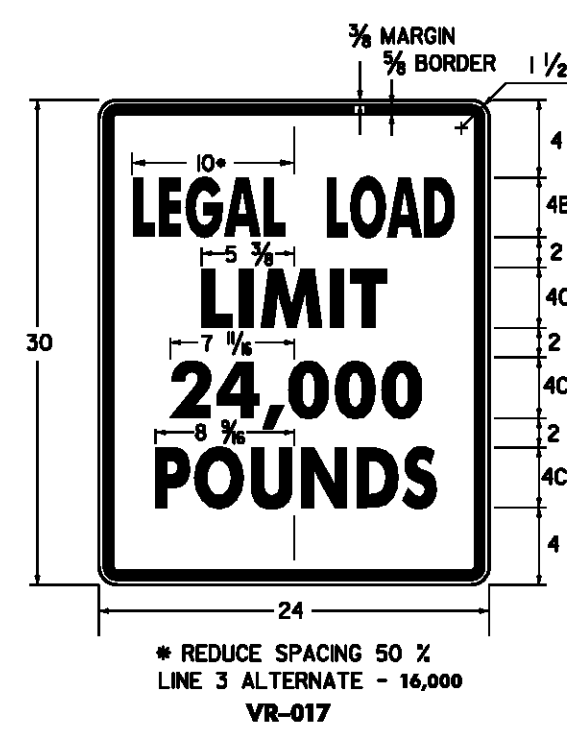


WHEN CROSSING COUNTY BOUNDARIES AN ADDITIONAL COUNTY LINE SIGN (VD-025) SHALL BE MOUNTED BELOW THE TOWN LINE SIGN MAINTAINING A SEVEN FOOT CLEARANCE.

THE SIGN SHALL BE MOUNTED PARALLEL WITH THE ROADWAY, NORMALLY ON RIGHT SIDE TRAVELING WEST TO EAST OR SOUTH TO NORTH.

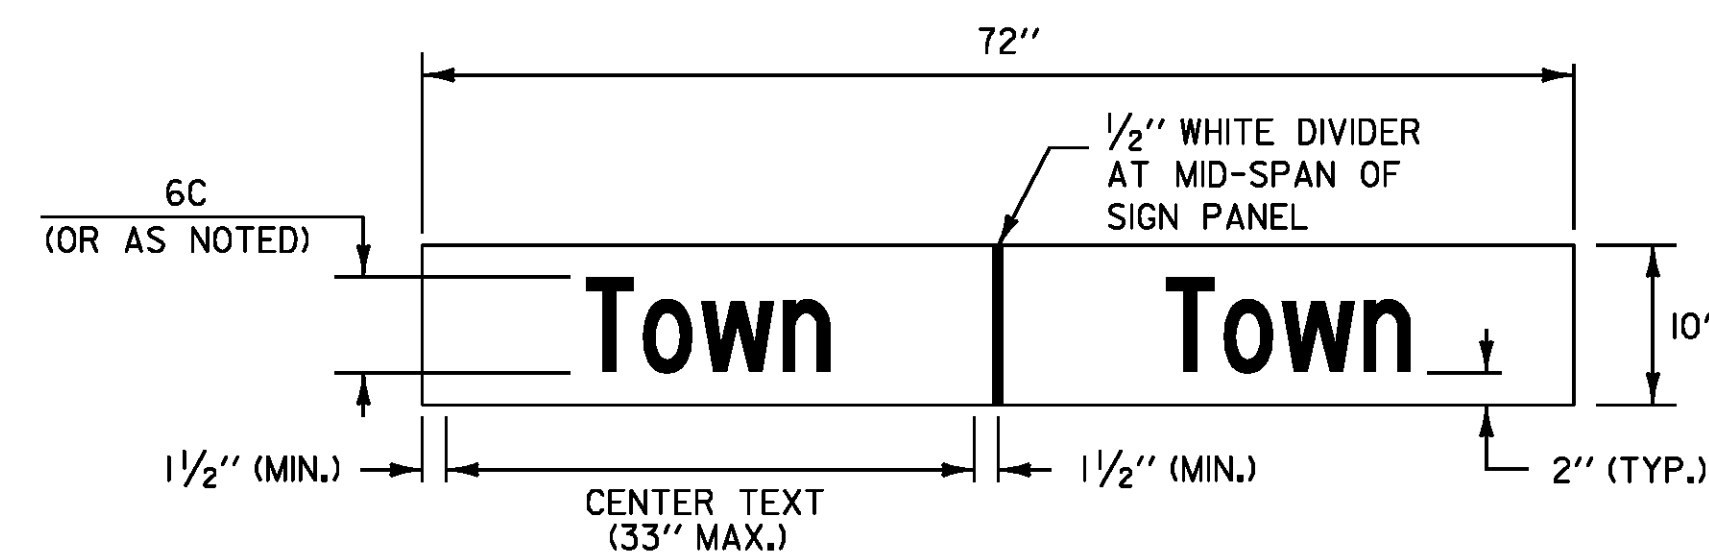

VD-024

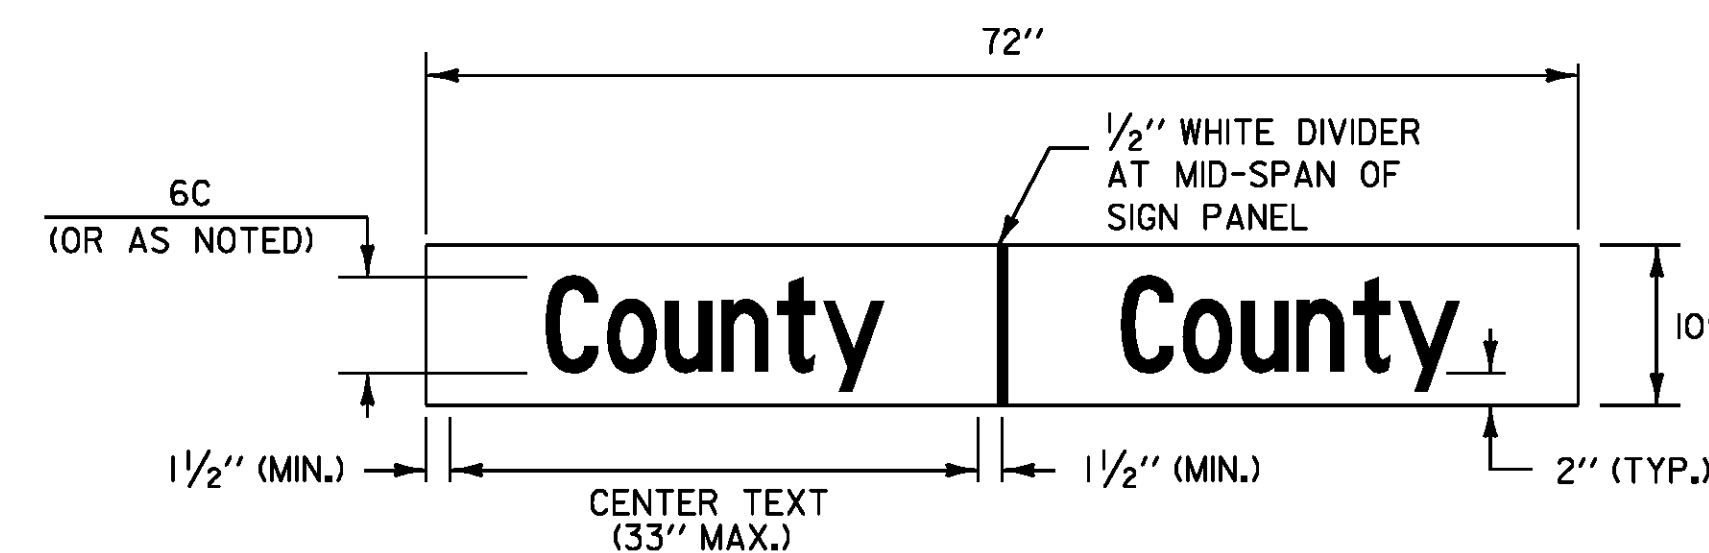

VD-025

TOWN NAMES		
TEXT	SERIES	DIMENSIONS
Bennington	B (5")	32.50
Danby	C (6")	22.00
Dorset	C (6")	22.25
Mount Tabor	B (5")	32.50
Shaftsbury	B (5")	29.00
Winhall	C (6")	26.25

COUNTY NAMES		
TEXT	SERIES	DIMENSIONS
Bennington Co.	B (5")	32.50
Windham Co.	B (5")	32.50


NOTES:

- WORD TO WORD SPACING FOR MULTIPLE TEXT TOWN NAMES IS ADJUSTABLE TO ACCOMMODATE DIMENSION REQUIREMENTS.
- DIMENSIONS SHOWN ARE APPROXIMATE AND MAY BE ADJUSTED SLIGHTLY TO ACCOMMODATE VARIOUS MANUFACTURER'S LETTER WIDTHS.
- ALL DIMENSIONS ARE IN INCHES UNLESS OTHERWISE NOTED


TOWN/COUNTY LINE SIGN NOTES:

- THE SIGN BASE MATERIAL SHALL BE HIGH DENSITY OVERLAID PLYWOOD 5/8 INCH THICK OR ALUMINUM SHEETING 0.125" MINIMUM THICKNESS. THE RETROREFLECTIVE MATERIAL SHALL BE SHEETING APPLIED TO THE ENTIRE BACKGROUND OF THE SIGN. THE LEGEND SHALL BE CUT-OUT RETROREFLECTIVE LEGEND. ALL RETROREFLECTIVE MATERIAL SHALL BE EQUAL TO OR EXCEEDING THE "THE AMERICAN SOCIETY OF TESTING AND MATERIALS" (ASTM) TYPE III.
- SIGNS SHALL HAVE A MINIMUM ASTM TYPE III SHEETING WITH A WHITE LEGEND ON A GREEN BACKGROUND.
- LEGEND SHALL CONFORM WITH THE STANDARD ALPHABETS FOR HIGHWAY SIGNS APPROVED BY THE NATIONAL JOINT COMMITTEE ON UNIFORM TRAFFIC CONTROL DEVICES. SIGNS SHALL BE FABRICATED IN UPPER/LOWER CASE TEXT AS SHOWN IN SIGN DETAIL.
- ALL SIGNS SHALL BE IN ACCORDANCE WITH "THE MANUAL ON UNIFORM TRAFFIC CONTROL DEVICES" (2009 MUTCD) AND THE "STANDARD HIGHWAY SIGNS" BOOK (2004 SHS) PUBLISHED BY THE FEDERAL HIGHWAY ADMINISTRATION (FHWA).


PROJECT NAME:	STATEWIDE - SOUTHWEST REGION
PROJECT NUMBER:	STPG SIGN (32)
FILE NAME:	10b012.TS.DGN
PROJECT LEADER:	A. GAMBLE
DESIGNED BY:	J. KELLY
SIGN DETAILS (I)	
PLOT DATE:	26-AUG-2010
DRAWN BY:	J. KELLY
CHECKED BY:	A. GAMBLE
SHEET	4 OF 90

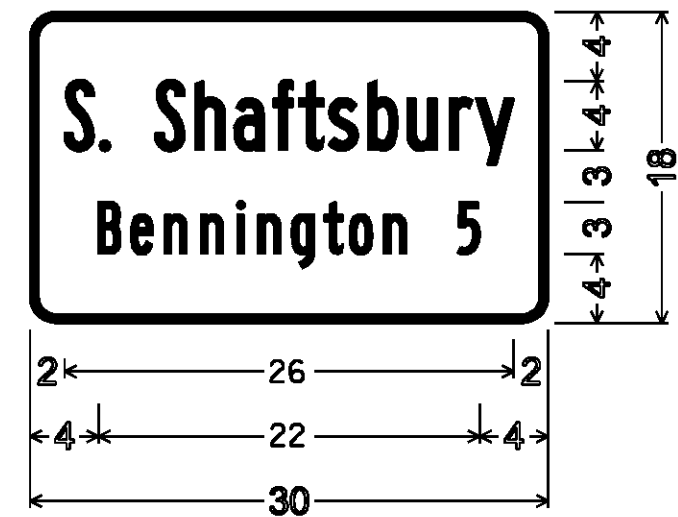


1.5" Radius, 0.5" Border, White on Green;
 "S. Shaftsbury" B, 26"
 "Bennington 5" B, 22"

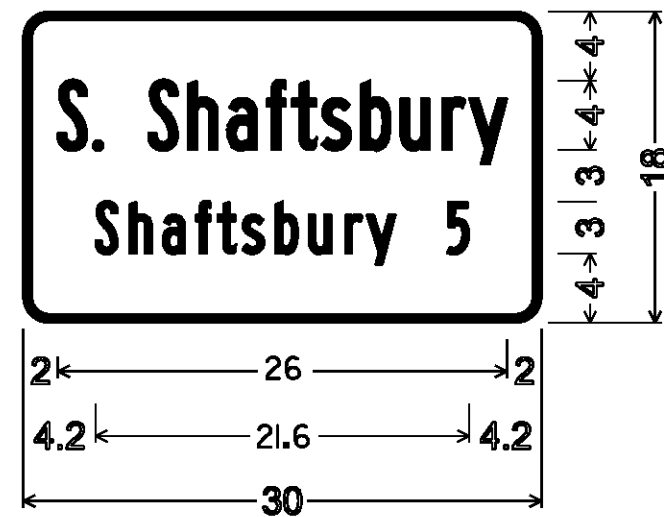


1.5" Radius, 0.5" Border, White on Green;
 "S. Shaftsbury" B, 26"
 "Shaftsbury 5" B, 21.6"

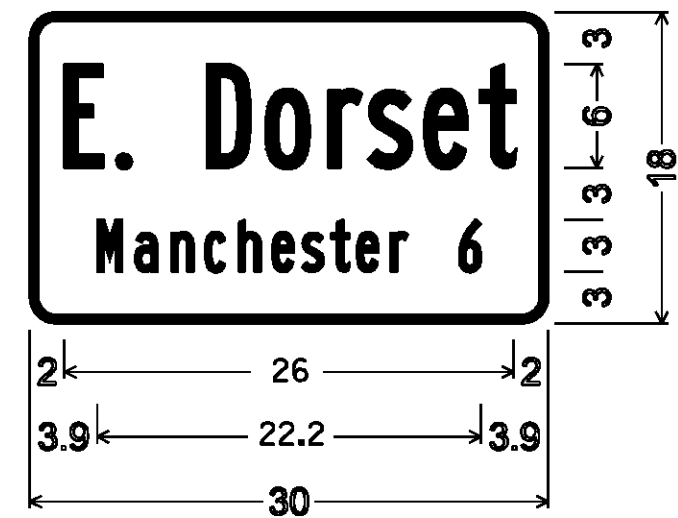


1.5" Radius, 0.5" Border, White on Green;
 "E. Dorset" B, 26"
 "Manchester 6" B, 22.2"

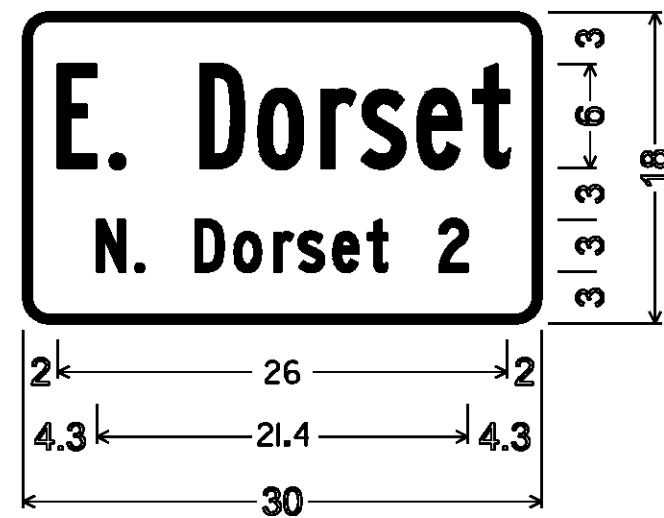


1.5" Radius, 0.5" Border, White on Green;
 "E. Dorset" B, 26"
 "N. Dorset 2" C, 21.4"

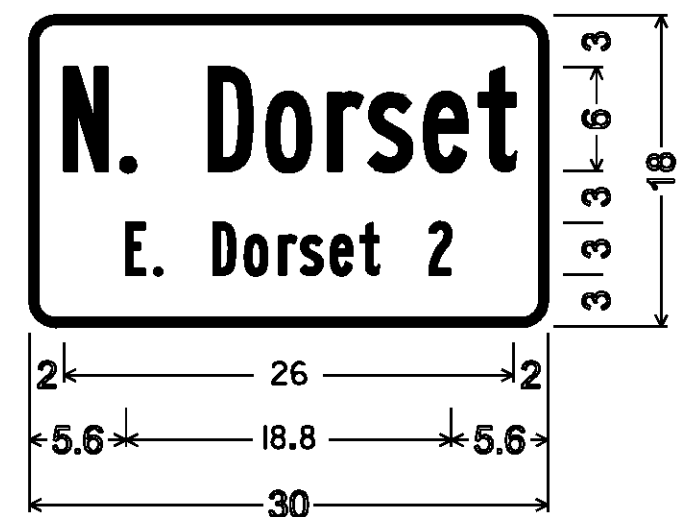


1.5" Radius, 0.5" Border, White on Green;
 "N. Dorset" B, 26"
 "E. Dorset 2" B, 18.8"

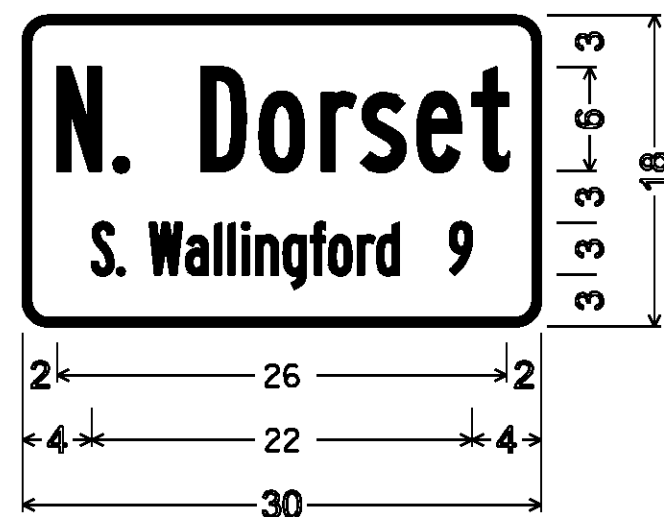


1.5" Radius, 0.5" Border, White on Green;
 "N. Dorset" B, 26"
 "S. Wallingford 9" B, 22"

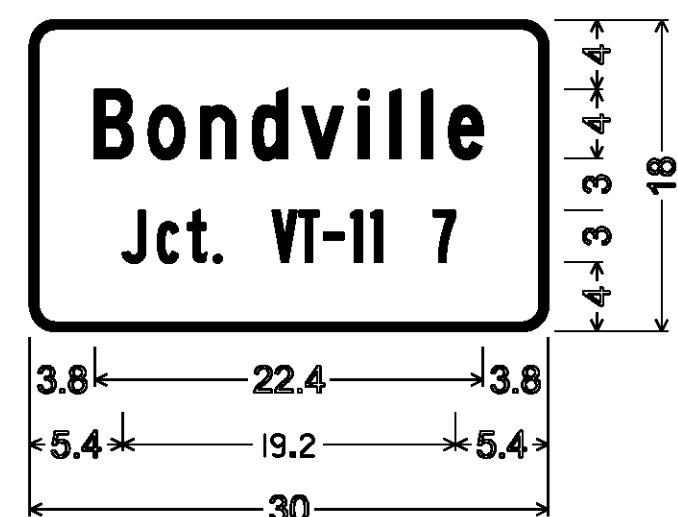

1.5" Radius, 0.5" Border, White on Green;
 "Bondville" C, 22.4"
 "Jct. VT-11 7" B, 19.2"

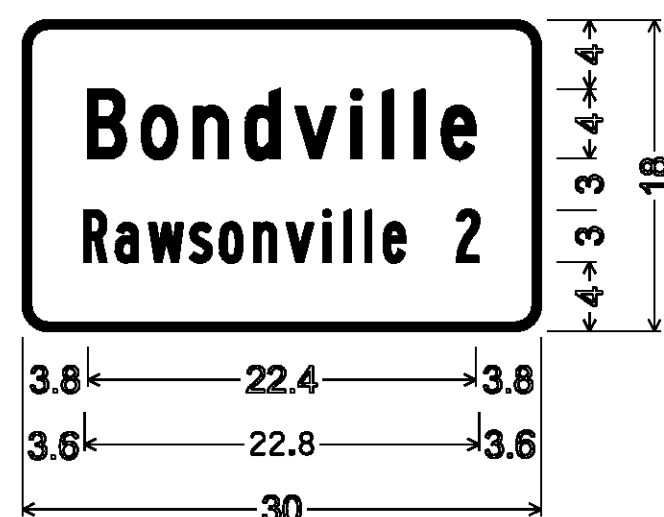


1.5" Radius, 0.5" Border, White on Green;
 "Bondville" C, 22.4"
 "Rawsonville 2" B, 22.8"

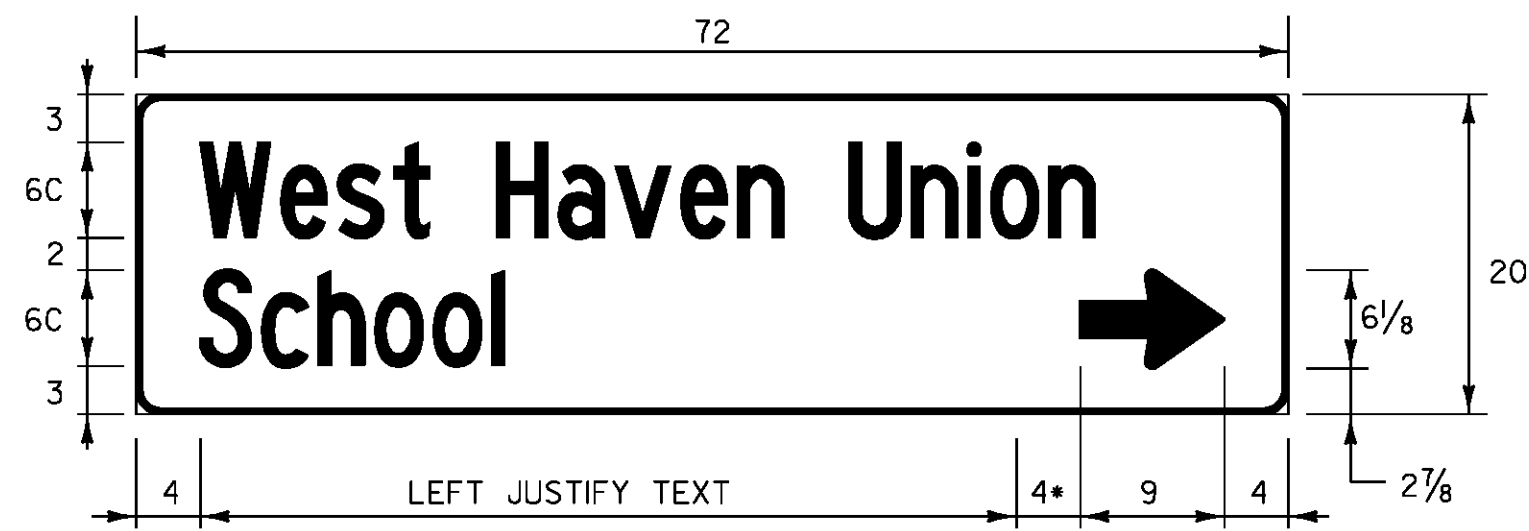


VDI-2 (R)

• MINIMUM DISTANCE BETWEEN ARROW AND TEXT

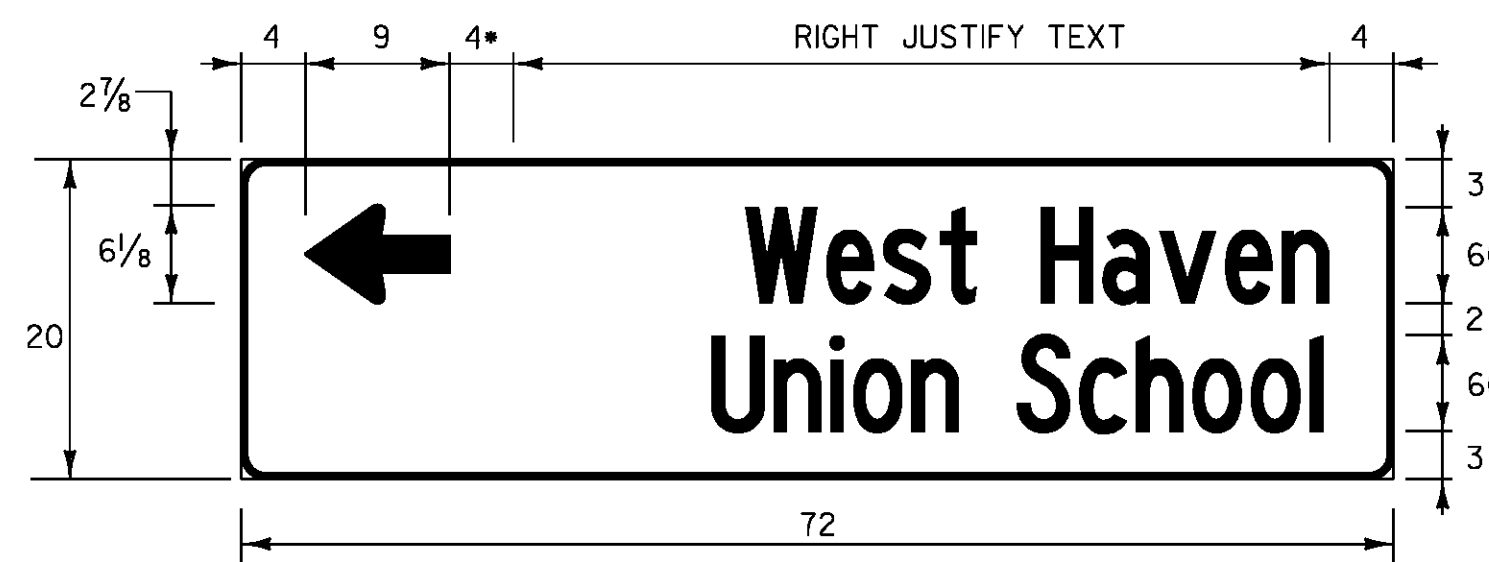


VDI-2 (L)


• MINIMUM DISTANCE BETWEEN ARROW AND TEXT

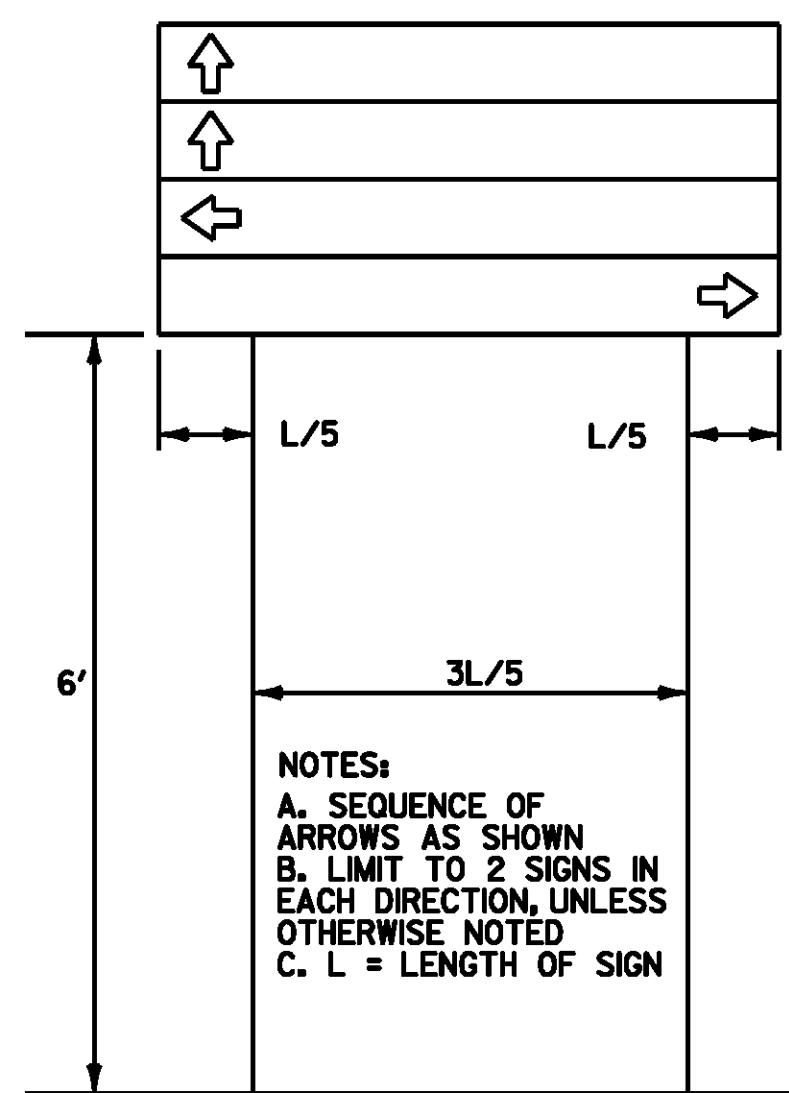

DESTINATION ASSEMBLY

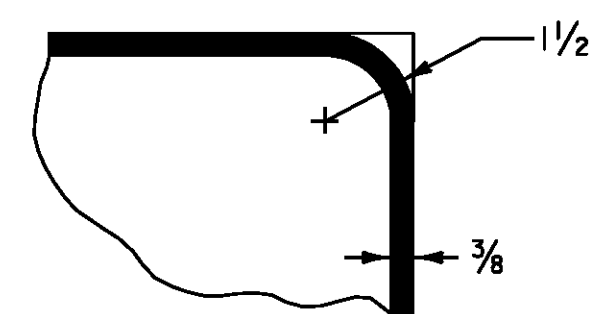

BORDER DETAIL

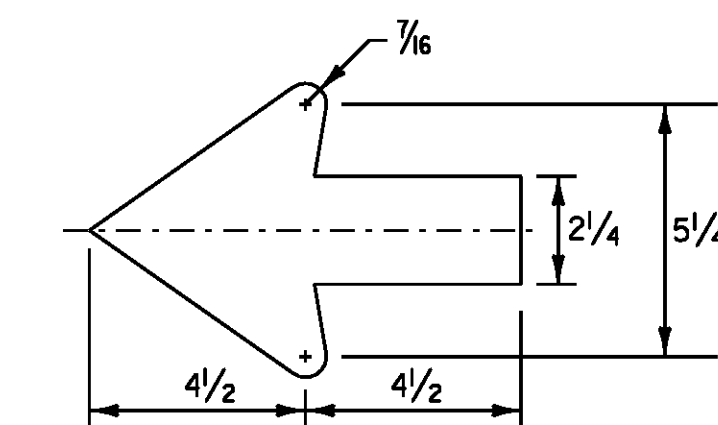

STANDARD 2.25" ARROW

**STANDARD DESTINATION SIGN NOTES
 D1-1, D1-1A, D1-2, D2-1**

THE DESTINATION SIGNS SHOWN ON THIS SHEET SHALL HAVE WHITE RETROREFLECTIVE ASTM TYPE III TEXT, ARROWS AND BORDERS ON A GREEN RETROREFLECTIVE ASTM TYPE III BACKGROUND. THE COLORS SHALL CONFORM WITH THE COLORS ADOPTED BY AASHTO AND APPROVED BY THE FHWA.




VDI-1




VDI-1a




VDI-1a

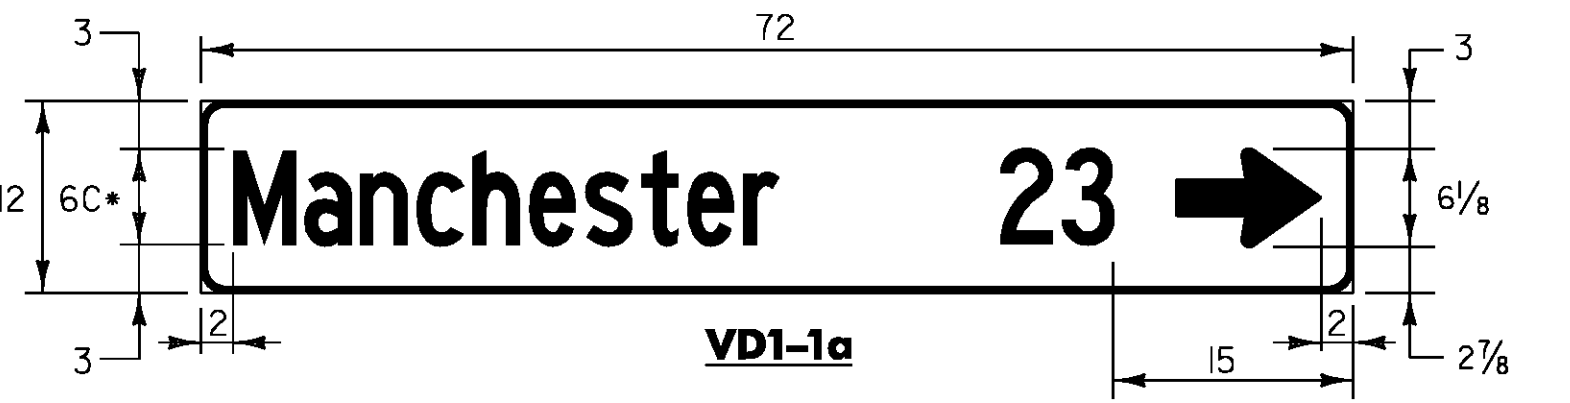


VDI-1a

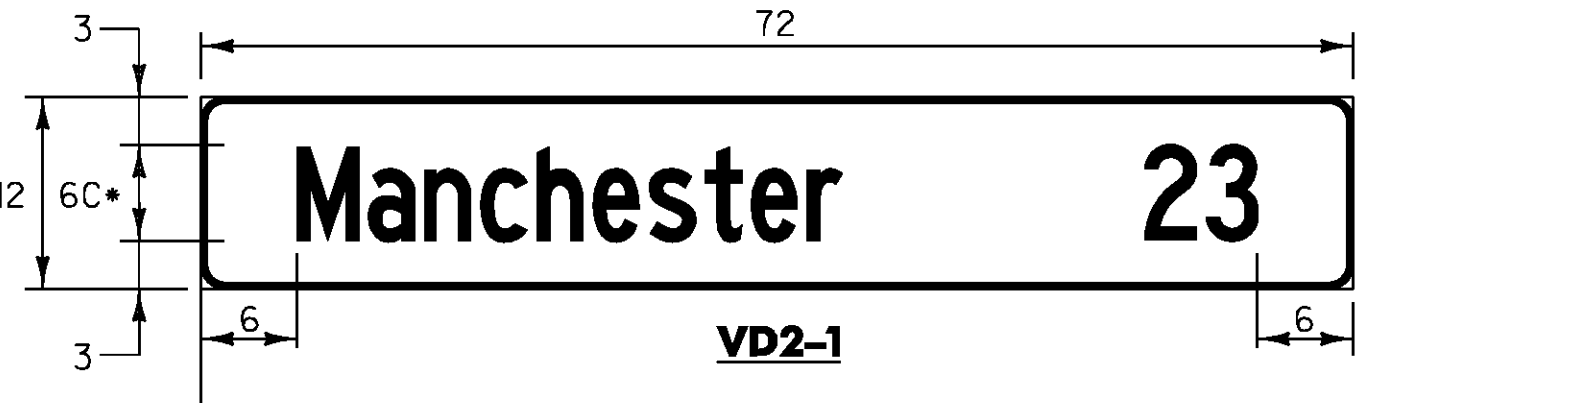

VD2-1

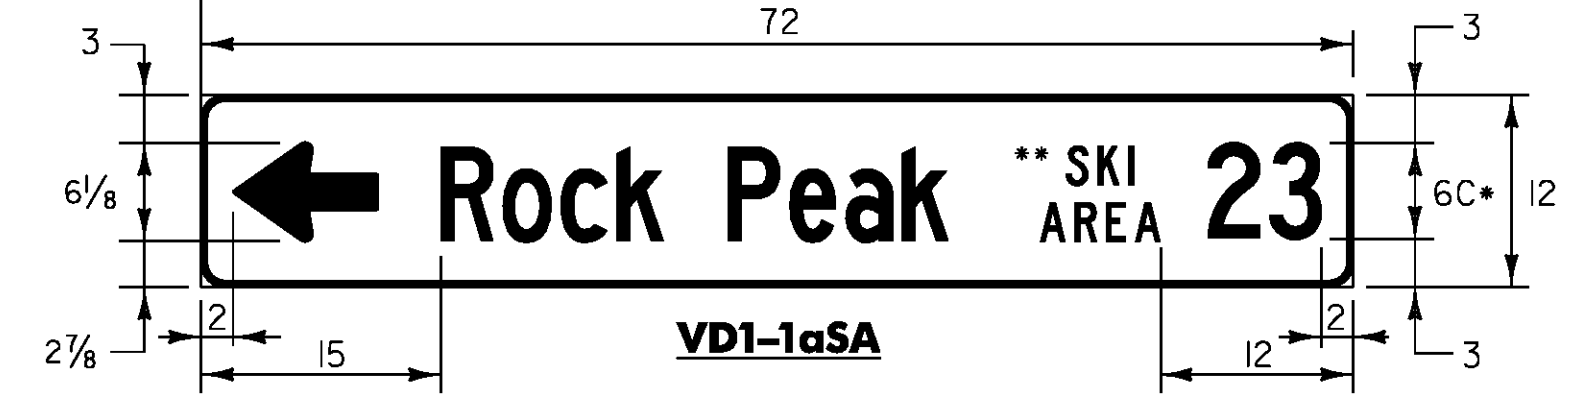

VDI-1aSA

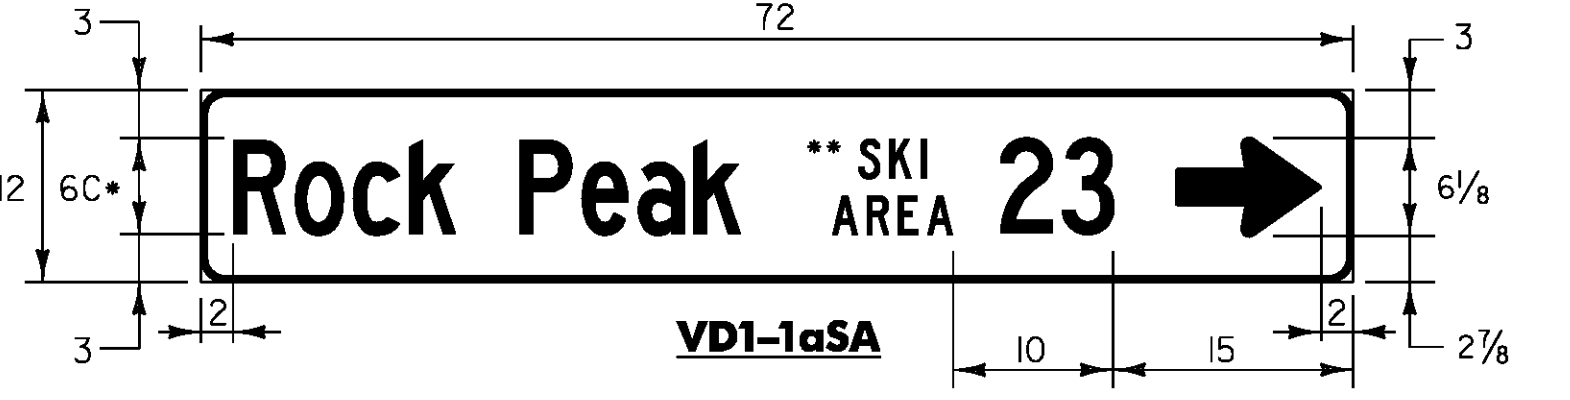


VDI-1aSA

• USE B FONT FOR LONGER DESTINATIONS.
 •• 'SKI AREA' TEXT IS 2.5" HIGH WITH 1" BETWEEN LINES.


ALL DIMENSIONS SHOWN IN INCHES UNLESS OTHERWISE NOTED.

PROJECT NAME:	STATEWIDE - SOUTHWEST REGION
PROJECT NUMBER:	STPG SIGN (32)
FILE NAME:	I06012.TS.DGN
PROJECT LEADER:	A. GAMBLE
DESIGNED BY:	J. KELLY
SIGN DETAILS (2)	
PLOT DATE:	26-AUG-2010
DRAWN BY:	J. KELLY
CHECKED BY:	A. GAMBLE
SHEET 5	OF 90

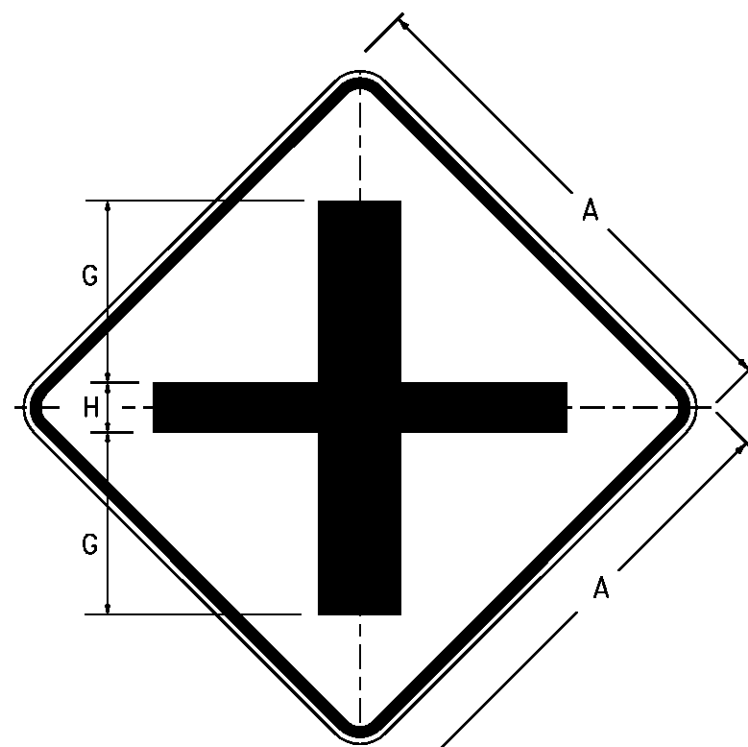


W2-1Mb
DIMENSIONS NOT SHOWN
FOR THIS DETAIL SHALL CONFORM
TO THE LATEST EDITION OF THE 2003 MUTCD
FOR SIGN DETAIL W2-1.
UNLESS OTHERWISE NOTED FOR THIS DETAIL

SIGN	DIMENSIONS (IN)		
	A	G	H
MIN & STD.	30	11	3
SPECIAL	36	13	4

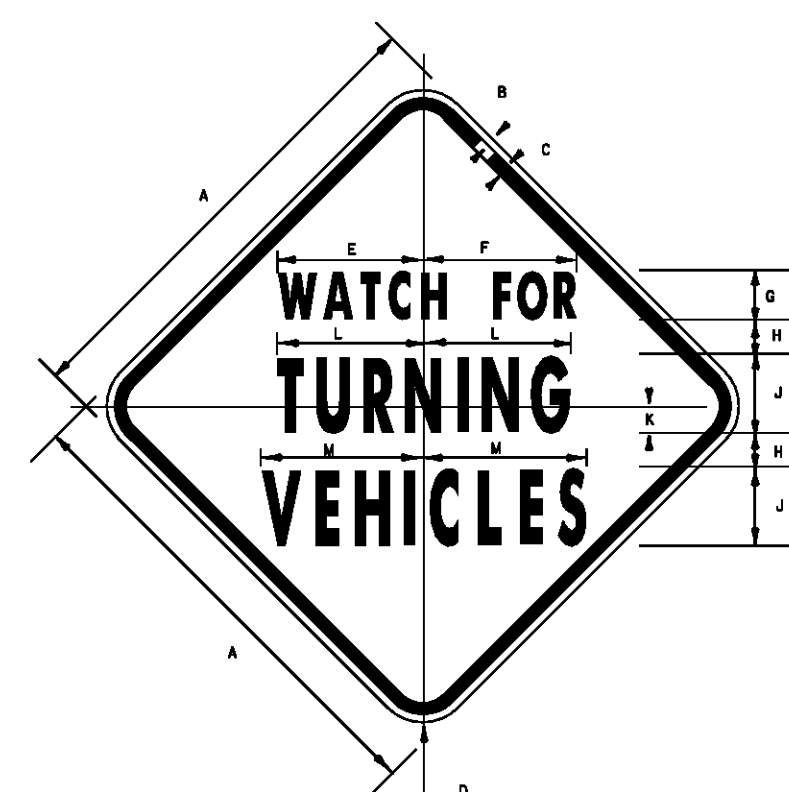

VW-205


SIGN	DIMENSIONS (INCHES)											
	A	B	C	D	E	F	G	H	J	K	L	M
MIN.	30	1/2	3/4	1 1/4	9 3/4	9 3/4	4 1/2	2	5 1/2	2	9 1/4	10 1/4
STD.	36	3/4	1	1 1/4	12	12	4 1/2	2 1/2	6	2	11 1/2	12 1/2
EXPIRY.	48	3/4	1 1/4	3	14 3/4	15 3/4	5 1/2	3 3/4	8 1/2	2 1/2	14 1/4	16 1/4

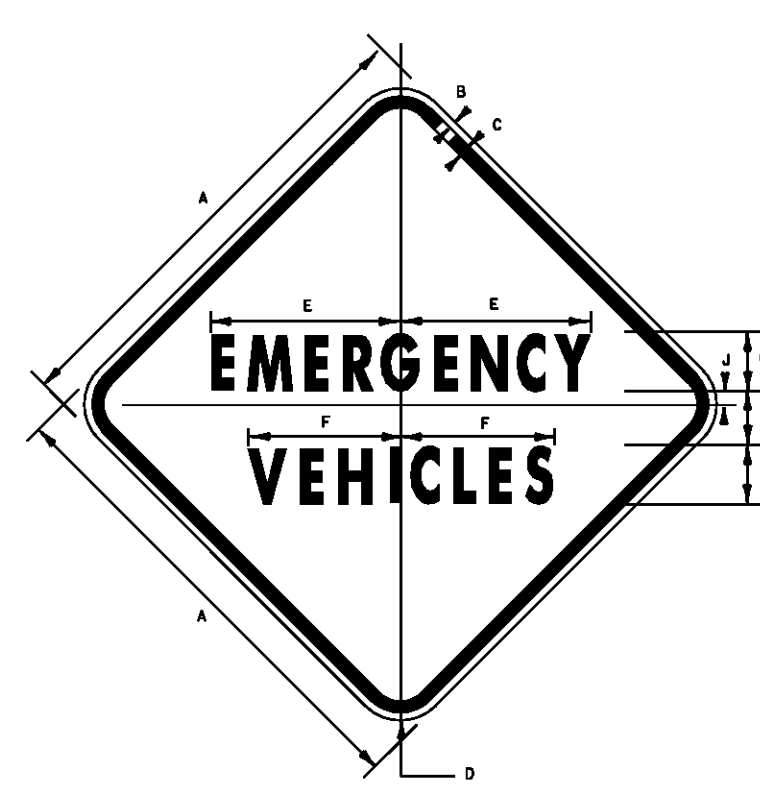

VW-544


• LETTER SPACING REDUCED 50%

SIGN	DIMENSIONS (INCHES)									
	A	B	C	D	E	F	G	H	J	K
MIN.	30	1/2	3/4	1 1/4	12 3/4	12 3/4	9 3/4	4 1/2	3 3/4	7 1/4
STD.	36	3/4	1	1 1/4	14 3/4	14 3/4	10 3/4	5 1/2	4	11
EXPIRY.	48	3/4	1 1/4	3	19 3/4	19 3/4	15 3/4	6 1/2	5 1/2	15 1/4

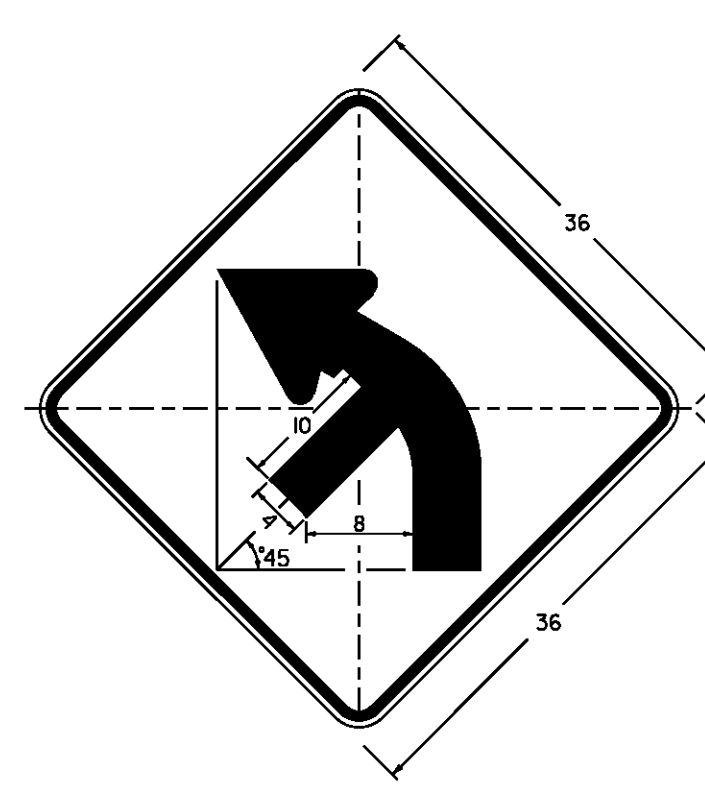


W1-2Mb L(R)

DIMENSIONS NOT SHOWN
FOR THIS DETAIL SHALL CONFORM
TO THE LATEST EDITION OF THE 2004
STANDARD HIGHWAY SIGN MANUAL
FOR SIGN DETAIL W1-2.
UNLESS OTHERWISE NOTED FOR THIS DETAIL

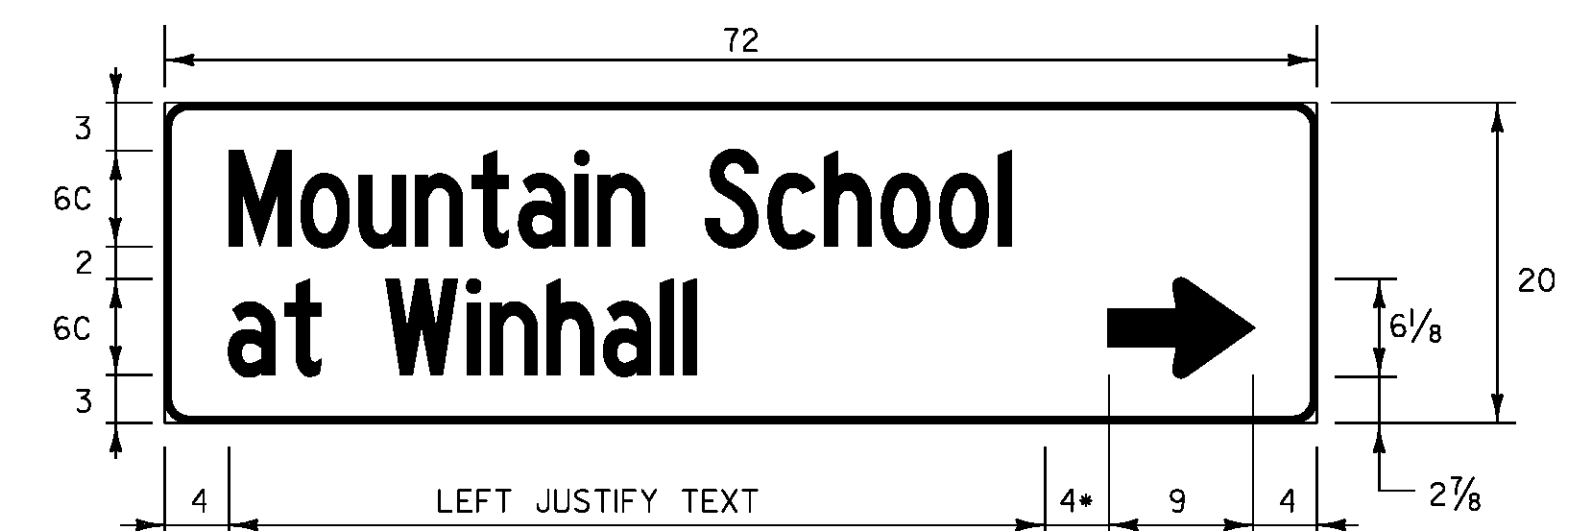


VDI-2 (R)

• MINIMUM DISTANCE BETWEEN ARROW AND TEXT

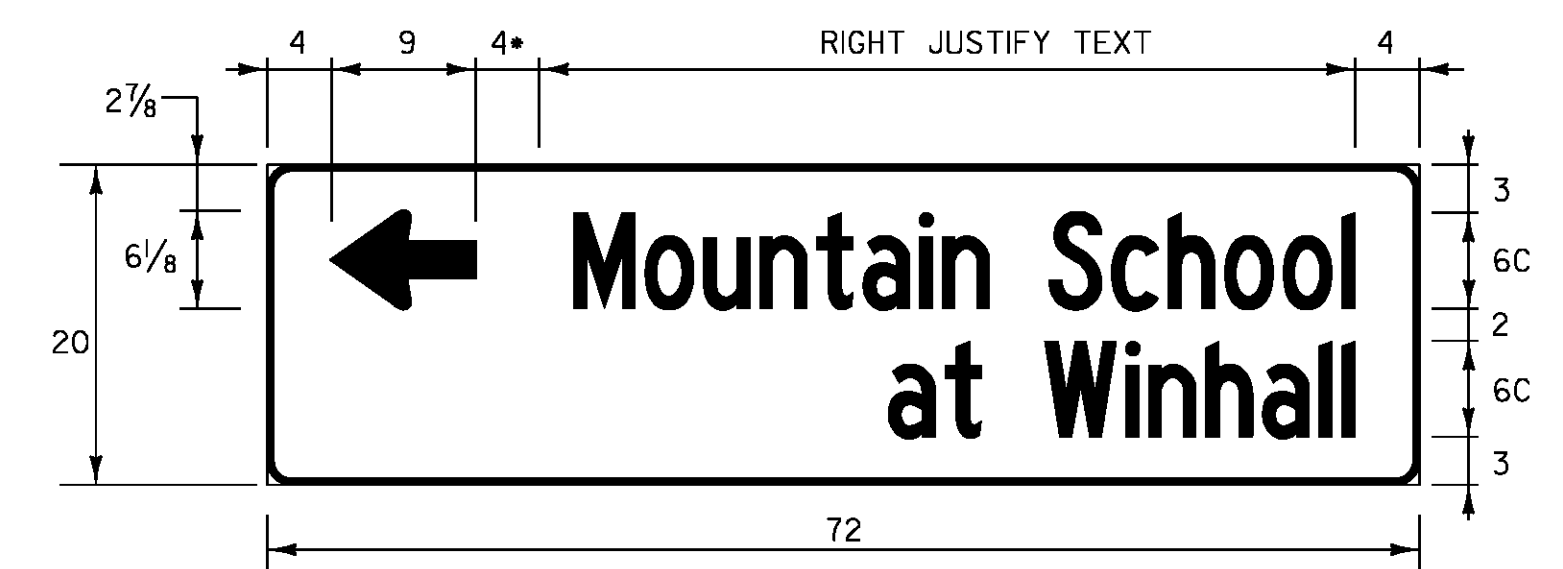


VDI-2 (L)

• MINIMUM DISTANCE BETWEEN ARROW AND TEXT

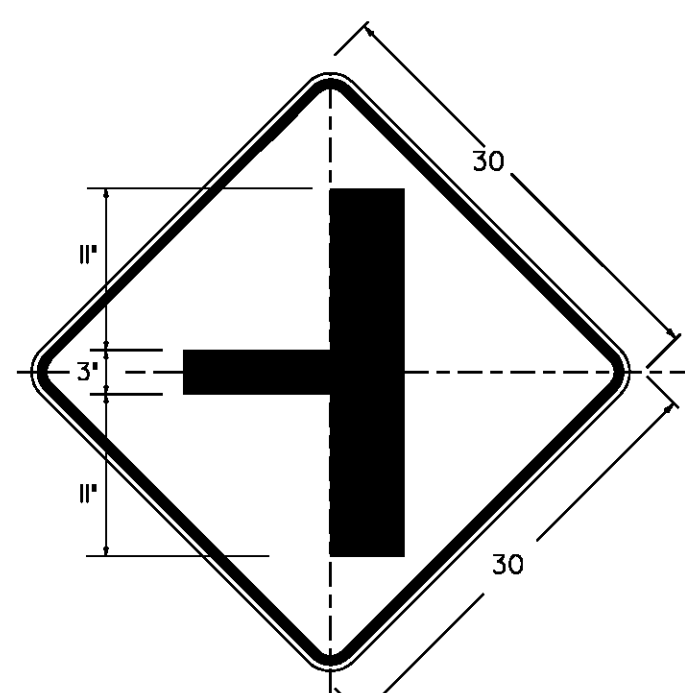


W2-2M L(R)
DIMENSIONS NOT SHOWN
FOR THIS DETAIL SHALL CONFORM
TO THE LATEST EDITION OF THE
2004 STANDARD HIGHWAY SIGN MANUAL
FOR SIGN DETAIL W2-2.
UNLESS OTHERWISE NOTED FOR THIS DETAIL

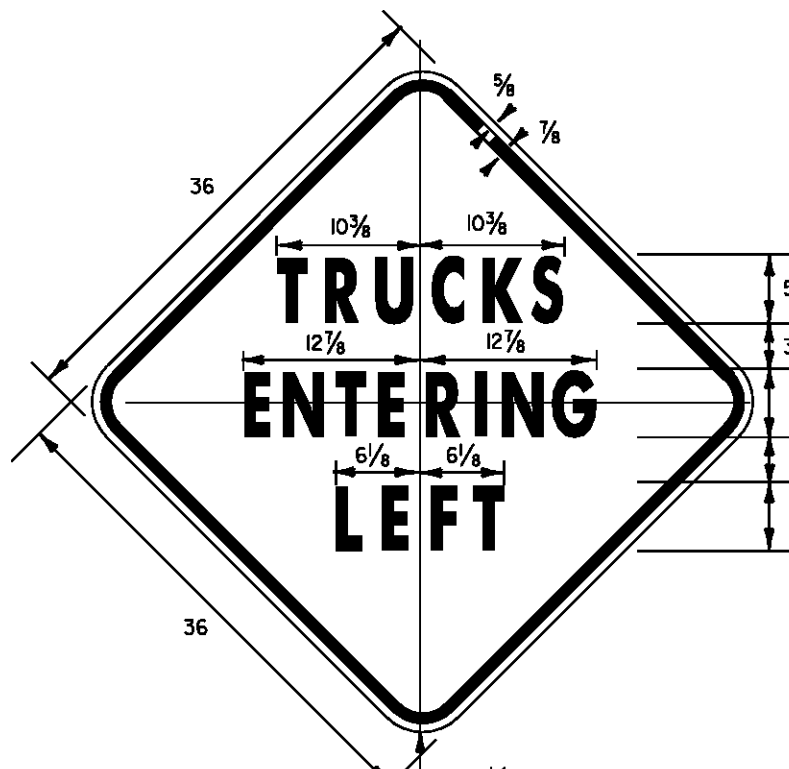


VW-084

1.875" RADIUS, 0.75" BORDER, 0.50" INDENT
COLORS: LEGEND - BLACK
BACKGROUND - YELLOW
TEXT STYLE: C

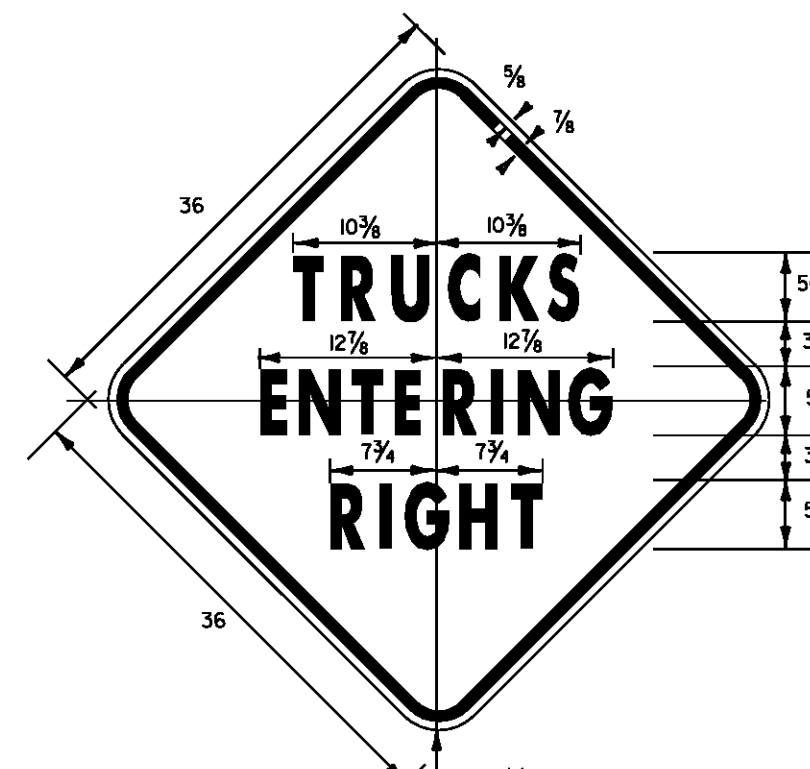


VW-081

1.875" RADIUS, 0.75" BORDER, 0.50" INDENT
COLORS: LEGEND - BLACK
BACKGROUND - YELLOW
TEXT STYLE: C

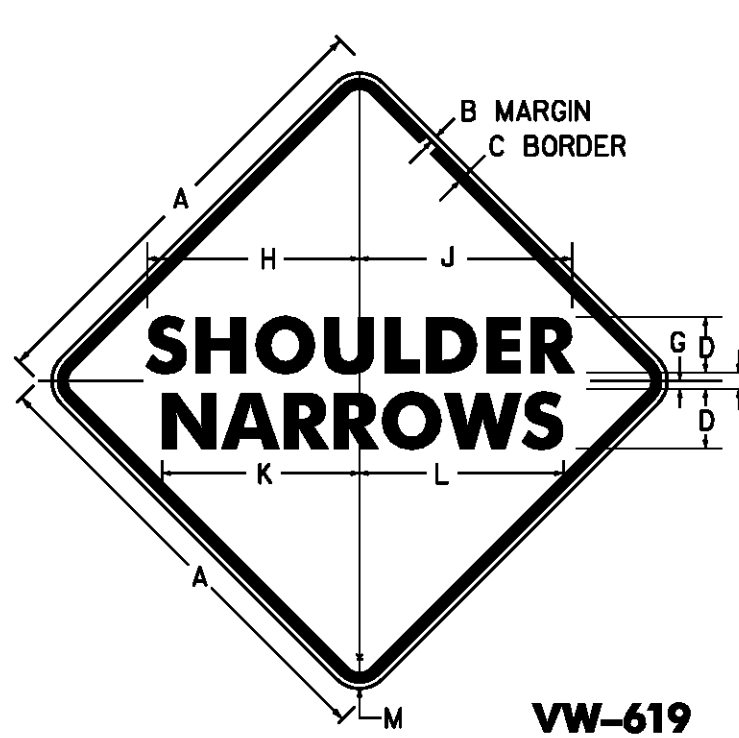


VW-619


SIGN	DIMENSIONS (INCHES)											
	A	B	C	D	E	F	G	H	J	K	L	M
MIN & STD.	36	3/4	1 1/4	3	6D	1	13 3/4	13 3/4	17 3/4	18 1/4	2 1/4	
EXPIRY.	48	3/4	1 1/4	7D	3 1/2	7D	1	23 3/4	23 3/4	27 3/4	3	

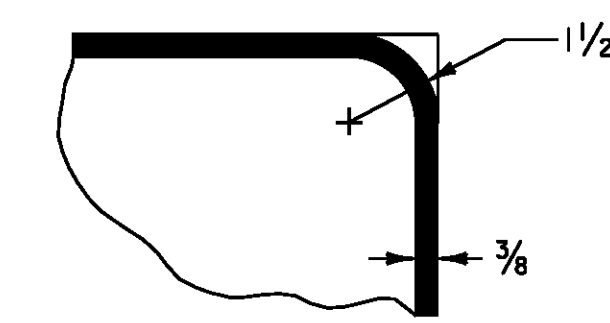


BORDER DETAIL
(FOR DESTINATION SIGN)

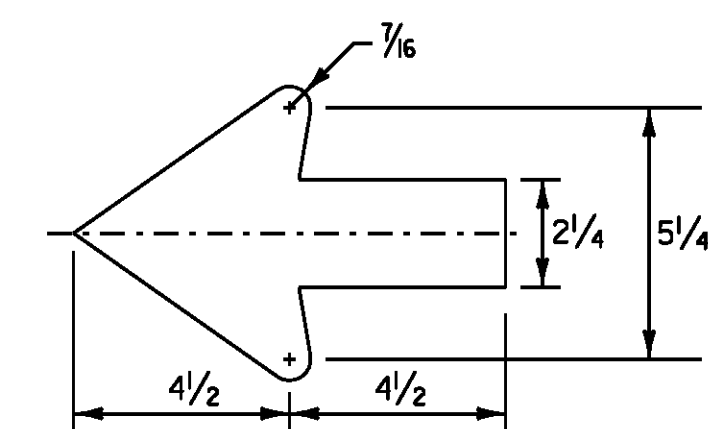


STANDARD 2.25" ARROW
(FOR DESTINATION SIGN)

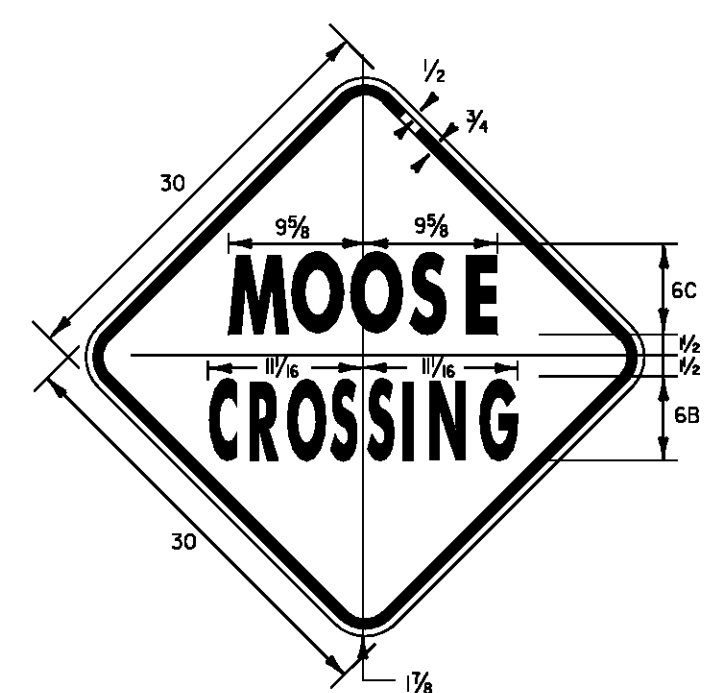


VW-000

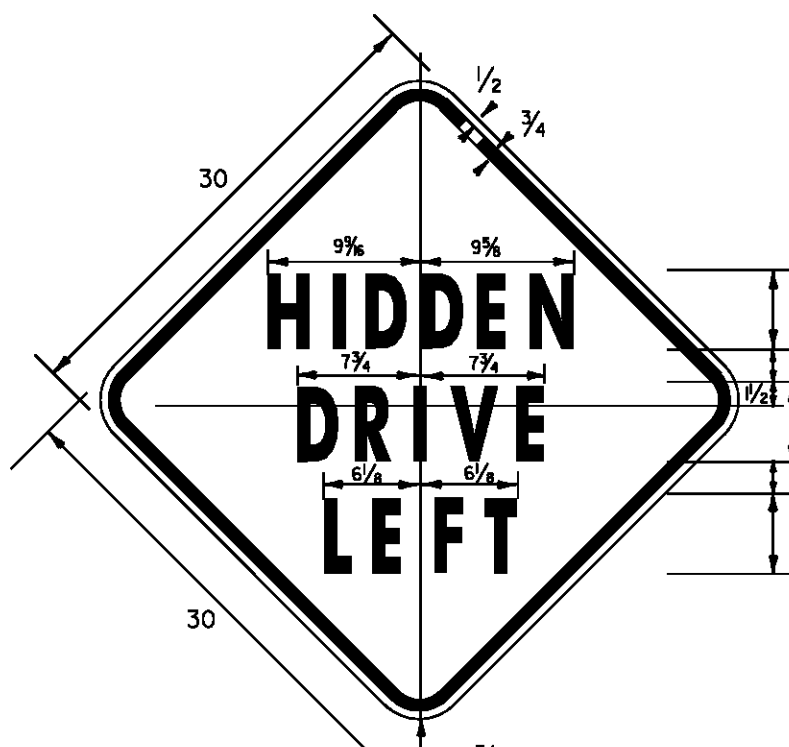

VW-133

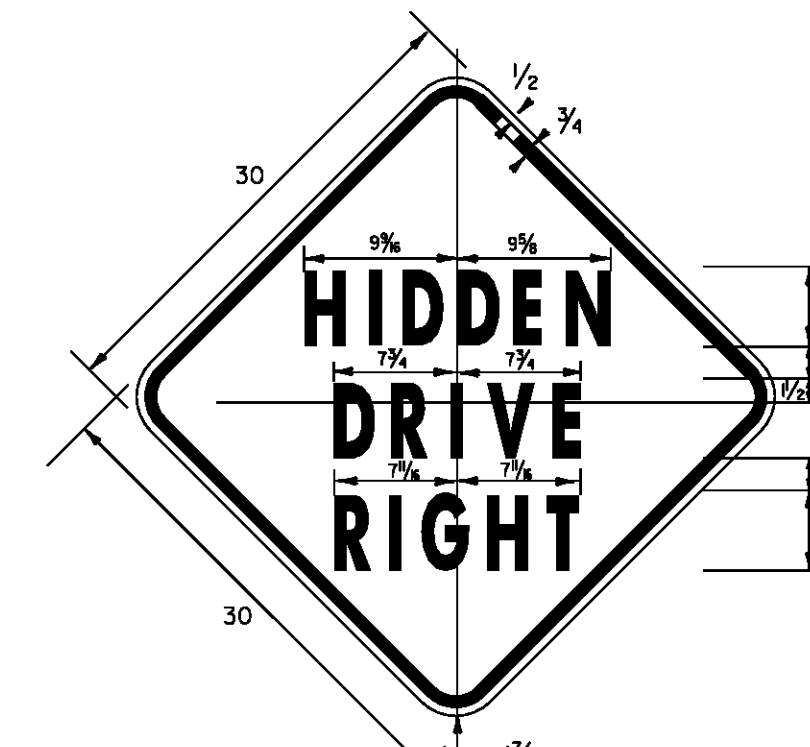

VW-054

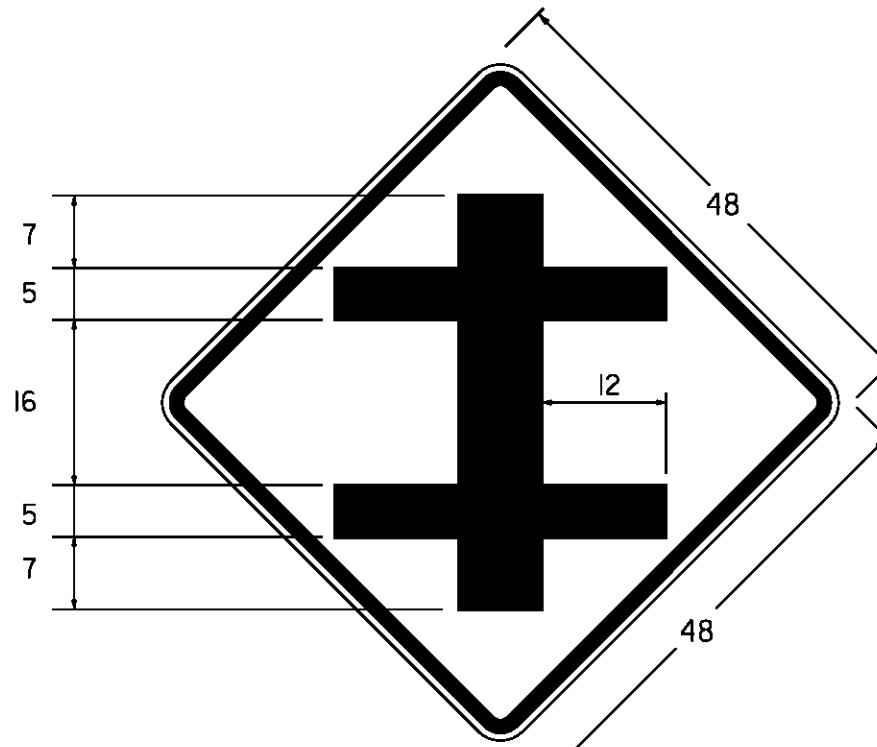

W2-1M

DIMENSIONS NOT SHOWN
FOR THIS DETAIL SHALL CONFORM
TO THE LATEST EDITION OF THE
2004 STANDARD HIGHWAY SIGN MANUAL
FOR SIGN DETAIL W2-1.
UNLESS OTHERWISE NOTED FOR THIS DETAIL


PROJECT NAME: STATEWIDE - SOUTHWEST REGION

PROJECT NUMBER: STPG SIGN (32)

FILE NAME: I0B012.TS.DGN
PROJECT LEADER: A. GAMBLE
DESIGNED BY: J. KELLY
SIGN DETAILS (3)

PLOT DATE: 03-SEP-2010
DRAWN BY: J. KELLY
CHECKED BY: A. GAMBLE
SHEET 6 OF 90


ROUTE MARKER ASSEMBLY FRAMES

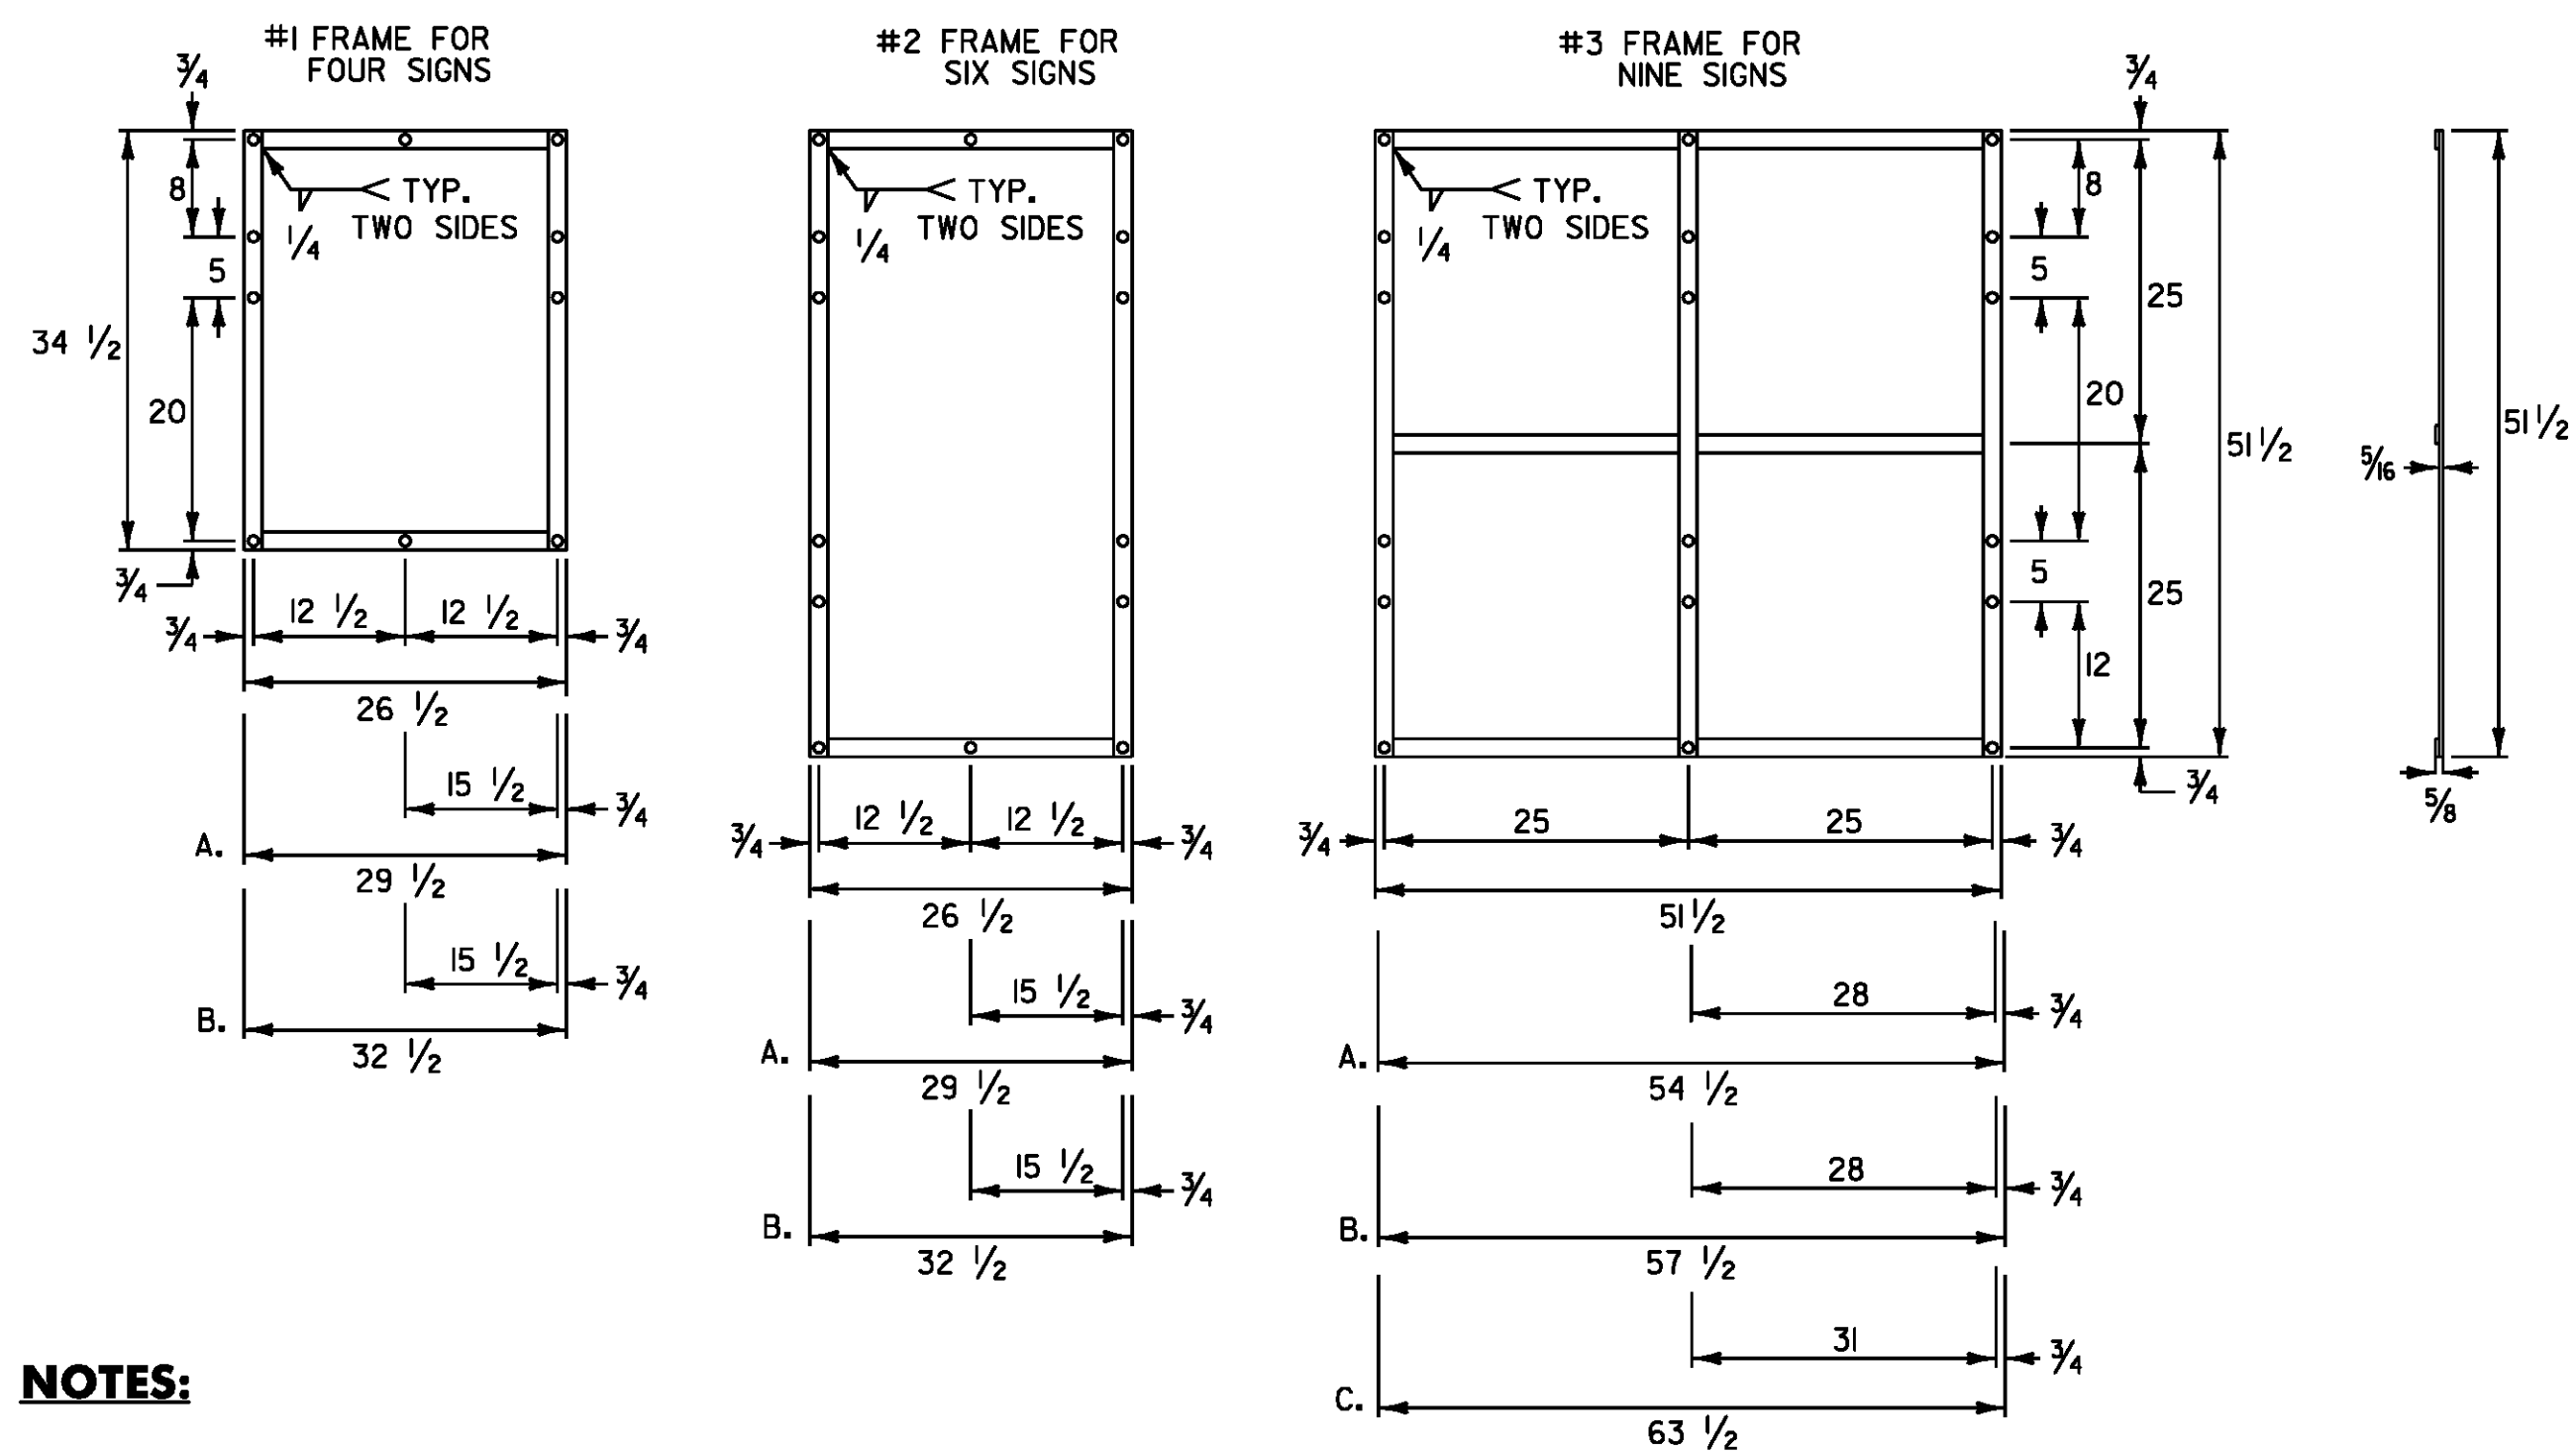

NOTES:

1. NOTES FOR #1 AND #2 FRAME:
 - A. WITH ONE 30 INCH THREE DIGIT SIGN
 - B. WITH TWO 30 INCH THREE DIGIT SIGNS
2. NOTES FOR #3 FRAME:
 - A. WITH ONE 30 INCH THREE DIGIT SIGN IN AN OUTSIDE POSITION.
 - B. WITH ONE 30 INCH THREE DIGIT SIGN IN THE CENTER POSITION OR TWO SUCH SIGNS IN THE OUTSIDE POSITIONS.
 - C. WITH THREE 30 INCH THREE DIGIT SIGNS.
3. ALL HOLES SHALL BE 7/16 INCH DIAMETER. FOR OTHER SIGN COMBINATIONS, THAN ABOVE, THE FRAME DIMENSIONS AND HOLE SPACING SHALL BE MODIFIED AS NECESSARY. THE FRAME SHALL BE PAINTED WITH ONE COAT OF PRIMER AND A SECOND COAT OF BLACK PAINT. THE PAINT SHALL BE OF THE TYPE USED ON EXTERIOR METAL SURFACES TO PREVENT METAL CORROSION.
4. STANDARD FRAMES SHALL BE 5/16 INCH x 1 1/2 INCH WELDED A-36 STEEL.
5. ALL DIMENSIONS SHOWN IN INCHES UNLESS OTHERWISE NOTED.

STANDARD MOUNTING OF ROUTE MARKER ASSEMBLIES

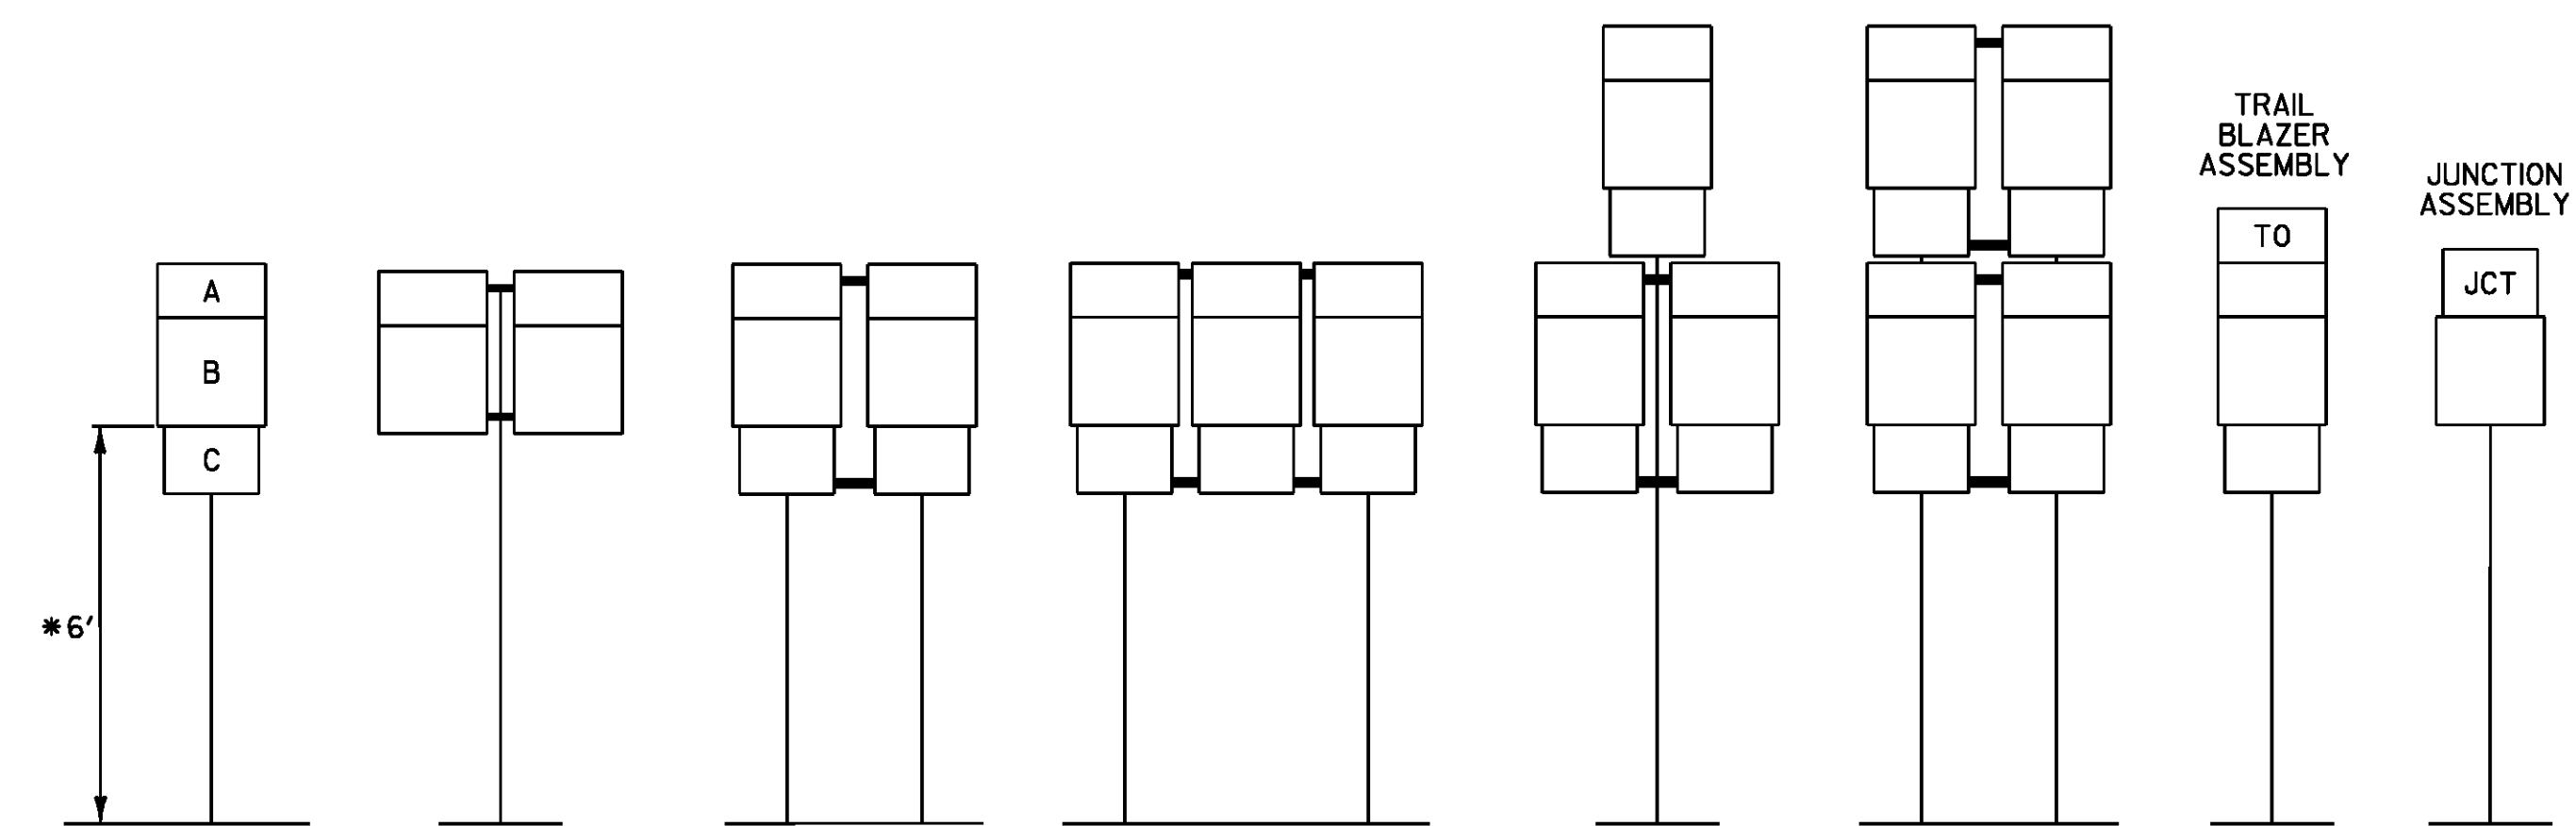

- A - CARDINAL DIRECTION MARKER
- B - ROUTE NUMBER
- C - ADVANCE TURN ARROW OR DIRECTIONAL ARROW

* WHERE PARKING OR PEDESTRIAN TRAFFIC WILL OCCUR IN THE IMMEDIATE VICINITY OF THESE SIGNS MINIMUM VERTICAL CLEARANCE SHALL BE INCREASED TO SEVEN FEET







INSTALLATION SEQUENCE:





IN MULTIPLE HORIZONTAL MOUNTINGS PLACE A ROUTE MARKER ASSEMBLY INDICATING A LEFT TURN ON THE LEFT SIDE OF THE ASSEMBLY; RIGHT TURN ON THE RIGHT SIDE. FOR VERTICALLY STACKED MOUNTINGS PLACE THE STRAIGHT THROUGH MOVE INDICATION ON TOP, THE LEFT OR RIGHT TURNS AS APPROPRIATE BENEATH.





NOTES:












1. ALL DIMENSIONS SHOWN IN INCHES UNLESS OTHERWISE NOTED.
2. VERTICAL FRAME MEMBERS SHALL LINE UP WITH SIGN POST ON WHICH THEY ARE MOUNTED.






PROJECT NAME: STATEWIDE - SOUTHWEST REGION	
PROJECT NUMBER: STPG SIGN (32)	
FILE NAME: IOB012.TS.DGN	PLOT DATE: 26-AUG-2010
PROJECT LEADER: A. GAMBLE	DRAWN BY: J. KELLY
DESIGNED BY: J. KELLY	CHECKED BY: A. GAMBLE
ROUTE MARKER ASSEMBLY	SHEET 7 OF 90





DIRECTION	MILEPOINT	LOCATION CODE (SHEET 2)	SIGN CODE	WIDTH (IN)	HEIGHT (IN)	SHEETING REMARKS	SIGN LEGEND	NEW SIGNS		EXISTING SIGNS				EXIST POST		NUMBER OF NEW POSTS	SQUARE STEEL (IN)			TUBULAR STEEL Ø (IN)				SIGN FRAME REQUIRED	REMARKS	SIGN DETAIL				
								"A"	"B"	RETAIN	SALVAGE FROM	SALVAGE TO	REMOVE	RETAIN	REMOVE		1.75	2.00	2.50	3.00	3.50	4.00	5.00			DETAIL IN SHS	DETAIL ON SHEET NUMBER	DETAIL ON STD SHEET NUMBER		
																	(LB / FT)			(LB / FT)										
SHAFTSBURY VT-7A							FY-FLUORESCENT YELLOW FYG-FLUORESCENT YELLOW GREEN																		"SHS"-STANDARD HIGHWAY SIGNS					
NB	0.001	C	VR-017	24	30																					TOWN LINE RD. (TH-35)				
		C	VR-017	24	30			5.00																					4	
NB	0.007	D	R1-1	30	30																					TOWN LINE RD. (TH-35)				
		D	R1-1	30	30			6.25																				X		
NB	0.163	A	R2-1	24	30		SPEED LIMIT 40			1																				
NB	0.305	A	VD-018	30	18																									
		A	VD-018	30	18			3.75																					5	
NB	0.355	A	R2-1	24	30																									
		A	R2-1	24	30			5.00																				X		
NB	0.608	A	R2-1	24	30																									
		A	R2-1	30	36			7.50																					5	
NB	0.693	A	W11-2FYG	30	30		PEDESTRIAN			1																				
		A	W16-9FYG	24	12		AHEAD			1																				
NB	0.751	C	VR-017	24	30																									
		C	VR-017	24	30			5.00																					4	
SIGN SUMMARY SHEET							SHEET TOTALS	32.50	0.00	3	0	0	6	0	0	6														
VERMONT AGENCY OF TRANSPORTATION							TOWN DIRECTIONAL TOTALS	269.1	0.0	15.0	5.0	5.0	62	0.0	0.0	44	660.0													
												PROJECT NAME: STATEWIDE - SOUTHWEST REGION		PROJECT NUMBER: STPG SIGN(32)					FILE NAME: SHAFTSBURY NB.XLS			PLOT DATE: 7/13/2010								
												PROJECT MANAGER: A. GAMBLE		DESIGNED BY: J. KELLY					DRAWN BY: J. KELLY			CHECKED BY: A. GAMBLE								
												SHAFTSBURY NORTHBOUND SHEET 1		SHEET 8					OF 90											







DIRECTION	MILEPOINT	LOCATION CODE (SHEET 2)	SIGN CODE	WIDTH (IN)	HEIGHT (IN)	SHEETING REMARKS	SIGN LEGEND	NEW SIGNS		EXISTING SIGNS				EXIST POST		NUMBER OF NEW POSTS	SQUARE STEEL (IN)			TUBULAR STEEL Ø (IN)				SIGN FRAME REQUIRED	REMARKS	SIGN DETAIL					
								"A"	"B"	RETAIN	SALVAGE FROM	SALVAGE TO	REMOVE	RETAIN	REMOVE		1.75 (LB / FT)	2.00	2.50	FOUNDATION	3.00	3.50	4.00			5.00	DETAIL IN SHS	DETAIL ON SHEET NUMBER	DETAIL ON STD SHEET NUMBER		
																														1.88	2.42
SHAFTSBURY VT-7A							FY-FLUORESCENT YELLOW FYG-FLUORESCENT YELLOW GREEN																		"SHS"-STANDARD HIGHWAY SIGNS						
NB	0.757	D	R1-1	30	30																			LEDGELY DR. (TH-63) 2 STREET SIGNS							
		D	R1-1	30	30			6.25																REINSTALL STREET NAME SIGNS ABOVE NEW SIGN (2)	X						
NB	0.756	A	W11-2FYG	30	30		PEDESTRIAN			1																					
		A	W16-7FYG	24	12		DIAGONAL DOWN ARROW			1																					
NB	0.899	A	S1-1FYG	30	30		SCHOOL			1																					
		A	W16-9FYG	24	12		AHEAD			1																					
NB	0.946	A	S1-1FYG	30	30		SCHOOL				1	1	1											RETAIN SIGNS AND REPLACE POST.							
		A	W16-7FYG	24	12		DIAGONAL DOWN ARROW				1	1	1																		
NB	0.951	C	VR-017	24	30																			BUCK HILL RD. (TH-6)							
		C	VR-017	24	30			5.00																			4				
NB	0.958	D	R1-1	30	30																			BUCK HILL RD. (TH-6)							
		D	R1-1	30	30			6.25																	X						
NB	1.044	A	M2-1S	21	15																										
		A	M1-5	24	24																										
		A	M2-1	21	15			2.19																GREEN ON WHITE ROUTE MARKERS			E-136B				
SIGN SUMMARY SHEET							SHEET TOTALS	19.69	0.00	4	4	2	4	2	9	0	0	4								PROJECT NAME: STATEWIDE - SOUTHWEST REGION PROJECT NUMBER: STPG SIGN(32)					
VERMONT AGENCY OF TRANSPORTATION							TOWN DIRECTIONAL TOTALS	269.1	0.0	15.0	5.0	5.0	62	0.0	0.0	44			660.0								FILE NAME: SHAFTSBURY NB.XLS PROJECT MANAGER: A. GAMBLE DESIGNED BY: J. KELLY SHAFTSBURY NORTHBOUND SHEET 2	PLOT DATE: 7/13/2010 DRAWN BY: J. KELLY CHECKED BY: A. GAMBLE SHEET 9 OF 90			







DIRECTION	MILEPOINT	LOCATION CODE (SHEET 2)	SIGN CODE	WIDTH (IN)	HEIGHT (IN)	SHEETING REMARKS	SIGN LEGEND	NEW SIGNS		EXISTING SIGNS				EXIST POST		NUMBER OF NEW POSTS	SQUARE STEEL (IN)			TUBULAR STEEL Ø (IN)				SIGN FRAME REQUIRED	REMARKS	SIGN DETAIL														
								"A"	"B"	RETAIN	SALVAGE FROM	SALVAGE TO	REMOVE	RETAIN	REMOVE		1.75	2.00	2.50	FOUNDATION	3.00	3.50	4.00			5.00	DETAIL IN SHS	DETAIL ON SHEET NUMBER	DETAIL ON STD SHEET NUMBER											
																	(LB / FT)				(LB / FT)																			
SHAFTSBURY VT-7A							FY-FLUORESCENT YELLOW FYG-FLUORESCENT YELLOW GREEN															"SHS"-STANDARD HIGHWAY SIGNS																		
		A	M1-5	24	24			4.00																														E-136B		
NB	1.157	A	D1-1A	72	10																																			
		A	D1-1A	72	10																																			
		A	D1-1A	72	10																																			
		A	D1-1M	72	10																																			
		A	D1-1A	72	12			6.00								2	15.0 15.75 X																						5	
		A	D1-1A	72	12			6.00																																5
		A	D1-1A	72	12			6.00																																5
		A	D1-1M	72	12			6.00																																5
NB	1.176	A	M3-4S	24	12																																			
		A	M1-5	24	24																																			
		A	M6-1S	21	15																																			
		A	M3-1S	24	12																																			
		A	VM-078S	24	12																																			
		A	M1-5	24	24																																			
SIGN SUMMARY SHEET							SHEET TOTALS	28.00	0.00	0	0	0	10	0	0	2	30 30.75																							
								SF	SF	EA	EA	EA	EA	EA	EA	EA	EA	EA	EA	EA	EA	EA	EA	EA	EA	EA	EA	EA	EA	EA	EA	EA	EA	EA	EA	EA	EA	EA	EA	
VERMONT AGENCY OF TRANSPORTATION							TOWN DIRECTIONAL TOTALS	269.1	0.0	15.0	5.0	5.0	62	0.0	0.0	44	660.0																							
												PROJECT NAME: STATEWIDE - SOUTHWEST REGION										PROJECT NUMBER: STPG SIGN(32)																		
												FILE NAME: SHAFTSBURY NB.XLS										PLOT DATE: 7/13/2010																		
												PROJECT MANAGER: A. GAMBLE										DRAWN BY: J. KELLY																		
												DESIGNED BY: J. KELLY										CHECKED BY: A. GAMBLE																		
												SHAFTSBURY NORTHBOUND SHEET 3										SHEET 10 OF 90																		













DIRECTION	MILEPOINT	LOCATION CODE (SHEET 2)	SIGN CODE	WIDTH (IN)	HEIGHT (IN)	SHEETING REMARKS	SIGN LEGEND	NEW SIGNS		EXISTING SIGNS				EXIST POST		NUMBER OF NEW POSTS	SQUARE STEEL (IN)			TUBULAR STEEL Ø (IN)				SIGN FRAME REQUIRED	REMARKS	SIGN DETAIL			
								"A"	"B"	RETAIN	SALVAGE FROM	SALVAGE TO	REMOVE	RETAIN	REMOVE		1.75	2.00	2.50	FOUNDATION	3.00	3.50	4.00			5.00	DETAIL IN SHS	DETAIL ON SHEET NUMBER	DETAIL ON STD SHEET NUMBER
																	(LB / FT)				(LB / FT)								
SHAFTSBURY VT-7A							FY-FLUORESCENT YELLOW FYG-FLUORESCENT YELLOW GREEN																"SHS"-STANDARD HIGHWAY SIGNS						
		A	D2-1	72	12		 	6.00																	5				
		A	M3-1	24	12		 	2.00																	GREEN ON WHITE ROUTE MARKERS			E-136B	
		A	VM-078	24	12		 	2.00																				E-136B	
		A	M1-5	24	24			4.00																			E-136B		
NB	1.377	A	R2-1	24	30							1																	
		A	R2-1	24	30			5.00							1	13.25	X								X				
NB	1.466	C	VR-017	24	30							1												AIRPORT RD. (TH-7)					
		C	VR-017	24	30			5.00							1	13.25	X									4			
NB	1.474	D	R1-1	30	30							1																	
		D	R1-1	30	30			6.25							1	13.25	X								X				
NB	1.482	A	R2-1	24	30							1																	
		A	R2-1	24	30			5.00							1	14.0	X								X				
NB	1.710	A	R2-1	24	30							1												SPEED TRANSITION POINT. INSTALL SIGN DIRECTLY ACROSS FROM SOUTHBOUND SL 40 SIGN.					
		A	R2-1	24	30			5.00							1	13.25	X								X				
NB	1.871	C	VM-607	24	36		KOREAN WAR MEMORIAL HIGHWAY				1	1	1											RETAIN SIGN AND REPLACE POST.					
SIGN SUMMARY SHEET							SHEET TOTALS	40.25	0.00	0	1	1	6	0	0	6		90	82.50						PROJECT NAME: STATEWIDE - SOUTHWEST REGION PROJECT NUMBER: STPG SIGN(32)				
VERMONT AGENCY OF TRANSPORTATION							TOWN DIRECTIONAL TOTALS	269.1	0.0	15.0	5.0	5.0	62	0.0	0.0	44		660.0							FILE NAME: SHAFTSBURY NB.XLS PROJECT MANAGER: A. GAMBLE DESIGNED BY: J. KELLY SHAFTSBURY NORTHBOUND SHEET 5	PLOT DATE: 7/13/2010 DRAWN BY: J. KELLY CHECKED BY: A. GAMBLE SHEET 12 OF 90			






DIRECTION	MILEPOINT	LOCATION CODE (SHEET 2)	SIGN CODE	WIDTH (IN)	HEIGHT (IN)	SHEETING REMARKS	SIGN LEGEND	NEW SIGNS		EXISTING SIGNS				EXIST POST		NUMBER OF NEW POSTS	SQUARE STEEL (IN)			TUBULAR STEEL Ø (IN)				SIGN FRAME REQUIRED	REMARKS	SIGN DETAIL			
								"A"	"B"	RETAIN	SALVAGE FROM	SALVAGE TO	REMOVE	RETAIN	REMOVE		1.75	2.00	2.50	FOUNDATION	3.00	3.50	4.00			5.00	DETAIL IN SHS	DETAIL ON SHEET NUMBER	DETAIL ON STD SHEET NUMBER
																	(LB / FT)				(LB / FT)								
SHAFTSBURY VT-7A							FY-FLUORESCENT YELLOW FYG-FLUORESCENT YELLOW GREEN																"SHS"-STANDARD HIGHWAY SIGNS						
NB	1.949	C	VR-017	24	30																								
		C	VR-017	24	30			5.00																		4			
NB	1.956	D	R1-1	30	30																								
		D	R1-1	30	30			6.25																X					
NB	2.273	A	VD-062AS	72	16		BUSINESS SIGN			1																			
		A	VD-062B	72	16		BUSINESS SIGN			1																			
NB	2.385	C	VR-017	24	30																								
		C	VR-017	24	30			5.00																		4			
NB	2.407	D	R1-1	30	30																								
		D	R1-1	30	30			6.25																X					
NB	2.519	A	W2-3MaL	30	30		LEFT SIDE ROAD (DOWN 45 DEG)			1																			
		A	W16-8	20	8		MYERS RD			1																			
NB	3.233	A	R2-1	24	30																								
		A	R2-1	24	30			5.00																X					
NB	3.390	A	W2-1M	30	30		MODIFIED CROSSROAD				1																		
SIGN SUMMARY SHEET							SHEET TOTALS	27.50	0.00	4	1	0	6 5	0	0	4	60 55.5								PROJECT NAME: STATEWIDE - SOUTHWEST REGION				
VERMONT AGENCY OF TRANSPORTATION							TOWN DIRECTIONAL TOTALS	269.1	0.0	15.0	5.0	5.0	62	0.0	0.0	44	660.0								PROJECT NUMBER: STPG SIGN(32)				
																							FILE NAME: SHAFTSBURY NB.XLS	PLOT DATE: 7/13/2010					
																								PROJECT MANAGER: A. GAMBLE	DRAWN BY: J. KELLY				
																								DESIGNED BY: J. KELLY	CHECKED BY: A. GAMBLE				
																								SHAFTSBURY NORTHBOUND SHEET 6	SHEET 13 OF 90				




DIRECTION	MILEPOINT	LOCATION CODE (SHEET 2)	SIGN CODE	WIDTH (IN)	HEIGHT (IN)	SHEETING REMARKS	SIGN LEGEND	NEW SIGNS		EXISTING SIGNS				EXIST POST		NUMBER OF NEW POSTS	SQUARE STEEL (IN)			TUBULAR STEEL Ø (IN)				SIGN FRAME REQUIRED	REMARKS	SIGN DETAIL					
								"A"	"B"	RETAIN	SALVAGE FROM	SALVAGE TO	REMOVE	RETAIN	REMOVE		1.75	2.00	2.50	FOUNDATION						DETAIL IN SHS	DETAIL ON SHEET NUMBER	DETAIL ON STD SHEET NUMBER			
																	(LB / FT)			3.00	3.50	4.00	5.00						(LB / FT)		
									1.88	2.42	3.35	7.60	9.00	10.80	14.60																
SHAFTSBURY VT-7A							FY-FLUORESCENT YELLOW FYG-FLUORESCENT YELLOW GREEN																"SHS"-STANDARD HIGHWAY SIGNS								
NB	3.440	A	W2-1M	30	30		MODIFIED CROSSROAD				1				1			14.75 X													
NB	3.530	C	VR-017	24	30																										
		C	VR-017	24	30			5.00							1			13.25 X									4				
NB	3.534	D	R1-1	30	30																										
		D	R1-1	30	30			6.25							1			13.25 X							X						
NB	4.101	A	W11-7	30	30		EQUESTRIAN																								
NB	4.604	A	S3-1	30	30		SCHOOL BUS STOP AHEAD																								
NB	4.733	A	VD-062AL	72	16		BUSINESS SIGN			1																					
		A	VD-062B	72	16		BUSINESS SIGN			1																					
NB	5.004	A	W1-2L	30	30		LEFT CURVE																								
		A	W13-1	18	18		40 MPH ADVISORY																								
NB	5.019	C	VR-017	24	30																										
		C	VR-017	24	30			5.00							1			13.25 X									4				
NB	5.026	D	R1-1	30	30																										
		D	R1-1	30	30			6.25							1			13.25 X							X						
SIGN SUMMARY SHEET							SHEET TOTALS	22.50	0.00	2	0	1	8	0	0	5			75	67.75						PROJECT NAME: STATEWIDE - SOUTHWEST REGION					
VERMONT AGENCY OF TRANSPORTATION							TOWN DIRECTIONAL TOTALS	269.1	0.0	15.0	5.0	5.0	62	0.0	0.0	44			660.0						PROJECT NUMBER: STPG SIGN(32)						
								SF	SF	EA	EA	EA	EA	EA	EA	EA			FT					FILE NAME: SHAFTSBURY NB.XLS							
																								PROJECT MANAGER: A. GAMBLE							
																								DESIGNED BY: J. KELLY							
																								SHAFTSBURY NORTHBOUND SHEET 7							
																								PLOT DATE: 7/13/2010							
																								DRAWN BY: J. KELLY							
																								CHECKED BY: A. GAMBLE							
																								SHEET 14 OF 90							


DIRECTION	MILEPOINT	LOCATION CODE (SHEET 2)	SIGN CODE	WIDTH (IN)	HEIGHT (IN)	SHEETING REMARKS	SIGN LEGEND	NEW SIGNS		EXISTING SIGNS				EXIST POST		NUMBER OF NEW POSTS	SQUARE STEEL (IN)			TUBULAR STEEL Ø (IN)				SIGN FRAME REQUIRED	REMARKS	SIGN DETAIL			
								"A"	"B"	RETAIN	SALVAGE FROM	SALVAGE TO	REMOVE	RETAIN	REMOVE		1.75	2.00	2.50	FOUNDATION	3.00	3.50	4.00			5.00	DETAIL IN SHS	DETAIL ON SHEET NUMBER	DETAIL ON STD SHEET NUMBER
																	(LB / FT)				(LB / FT)								
SHAFTSBURY VT-7A							FY-FLUORESCENT YELLOW FYG-FLUORESCENT YELLOW GREEN															"SHS"-STANDARD HIGHWAY SIGNS							
NB	5.146	A	W1-2L	30	30			6.25							1		15.5	X							X				
		A	W13-1	18	18			2.25																	X				
NB	5.186	A	W1-8	18	24		CHEVRON																				REINSTALL BR-7 PLAQUE. REMOVE AND DISCARD 5.20 MM.		
		A	N/A				BRIDGE 7 PLAQUE 			1	1																		
		A	W2-2RM	30	30			6.25							1		14.0	X									6		
NB	5.235	A	W1-8	18	24		CHEVRON																						
NB	5.256	A	W1-8	18	24		CHEVRON 																					INSTALL 475 FEET IN ADVANCE OF OLD DEPOT RD.	
		A	W11-8	30	30			6.25							1		15.0	X							X				
NB	5.306	A	W1-8	18	24		CHEVRON																						
NB	5.311	A	VR-928R	30	30																								
		A	VR-928R	30	30			6.25							1		14.75	X									E-145A		
NB	5.336	C	VR-017	24	30																							OLD DEPOT RD. (TH-1)	
		C	N/A	18	24		TOWN' SPEED ZONE AHEAD 																						
		C	VR-017	24	30			5.00							1		13.5	X									4		
NB	5.345	D	R1-1	30	30																							OLD DEPOT RD. (TH-1)	
SIGN SUMMARY SHEET							SHEET TOTALS		32.25	0.00	0	1	1	9	0	0	5	75	72.75						PROJECT NAME: STATEWIDE - SOUTHWEST REGION PROJECT NUMBER: STPG SIGN(32)				
VERMONT AGENCY OF TRANSPORTATION							TOWN DIRECTIONAL TOTALS		269.1	0.0	15.0	5.0	5.0	62	0.0	0.0	44	660.0							FILE NAME: SHAFTSBURY NB.XLS PLOT DATE: 7/13/2010 PROJECT MANAGER: A. GAMBLE DRAWN BY: J. KELLY DESIGNED BY: J. KELLY CHECKED BY: A. GAMBLE SHAFTSBURY NORTHBOUND SHEET 8 SHEET 15 OF 90				








DIRECTION	MILEPOINT	LOCATION CODE (SHEET 2)	SIGN CODE	WIDTH (IN)	HEIGHT (IN)	SHEETING REMARKS	SIGN LEGEND	NEW SIGNS		EXISTING SIGNS				EXIST POST		NUMBER OF NEW POSTS	SQUARE STEEL (IN)			TUBULAR STEEL Ø (IN)				SIGN FRAME REQUIRED	REMARKS	SIGN DETAIL		
								"A"	"B"	RETAIN	SALVAGE FROM	SALVAGE TO	REMOVE	RETAIN	REMOVE		1.75	2.00	2.50	3.00	3.50	4.00	5.00			DETAIL IN SHS	DETAIL ON SHEET NUMBER	DETAIL ON STD SHEET NUMBER
																	(LB / FT)			(LB / FT)								
									1.88	2.42	3.35	FOUNDATION	7.60	9.00	10.80	14.60												
SHAFTSBURY VT-7A							FY-FLUORESCENT YELLOW FYG-FLUORESCENT YELLOW GREEN																"SHS"-STANDARD HIGHWAY SIGNS					
SB	6.485	G	VR-017	24	30																		TIMBER TRAIL RD (TH-14)					
		G	VR-017	24	30			5.00																	4			
SB	6.481	H	R1-1	30	30																		TIMBER TRAIL RD (TH-14)					
		H	R1-1	30	30			6.25																X				
SB	6.172	F	W1-2R	30	30		RIGHT CURVE																REMOVE 6.70 MM.					
		F	W13-1	18	18		40 MPH ADVISORY																					
SB	6.123	F	W1-2R	30	30			6.25															INSTALL 360 FEET SOUTH OF EXISTING RIGHT CURVE SIGN	X				
		F	W13-1	18	18			2.25																X				
SB	5.566	F	VW-054L	30	30		HIDDEN DRIVE LEFT																					
		F	VW-407P				SCHOOL BUS ENTERING																					
SB	5.504	F	W11-8	30	30		FIRE ENGINE SYMBOL																					
		F	VW-054L	30	30			6.25																	6			
SB	5.400	F	W1-2R	30	30		RIGHT CURVE																					
		F	W11-8	30	30			6.25																X				
SB	5.338	F	W1-2R	30	30			6.25															INSTALL ACROSS FROM OLD DEPOT RD INTERSECTION.	X				
SIGN SUMMARY SHEET							SHEET TOTALS	38.50	0.00	0	0	0	8	0	0	5	75 73.75							PROJECT NAME: STATEWIDE - SOUTHWEST REGION				
VERMONT AGENCY OF TRANSPORTATION							TOWN DIRECTIONAL TOTALS	217.7	0.0	26.0	5.0	5.0	46	0.0	0.0	38	570.0							PROJECT NUMBER: STPG SIGN(32)				
								SF	SF	EA	EA	EA	EA	EA	EA	EA	FT							FILE NAME: SHAFTSBURY SB.XLS				
																								PROJECT MANAGER: A. GAMBLE				
																								DESIGNED BY: J. KELLY				
																								PLOT DATE: 7/13/2010				
																								DRAWN BY: J. KELLY				
																								CHECKED BY: A. GAMBLE				
																									SHEET 18 OF 90			

DIRECTION	MILEPOINT	LOCATION CODE (SHEET 2)	SIGN CODE	WIDTH (IN)	HEIGHT (IN)	SHEETING REMARKS	SIGN LEGEND	NEW SIGNS		EXISTING SIGNS				EXIST POST		NUMBER OF NEW POSTS	SQUARE STEEL (IN)			TUBULAR STEEL Ø (IN)				SIGN FRAME REQUIRED	REMARKS	SIGN DETAIL		
								"A"	"B"	RETAIN	SALVAGE FROM	SALVAGE TO	REMOVE	RETAIN	REMOVE		1.75	2.00	2.50	3.00	3.50	4.00	5.00			DETAIL IN SHS	DETAIL ON SHEET NUMBER	DETAIL ON STD SHEET NUMBER
																	(LB / FT)			(LB / FT)								
									1.88	2.42	3.35	FOUNDATION	7.60	9.00	10.80	14.60												
SHAFTSBURY VT-7A							FY-FLUORESCENT YELLOW FYG-FLUORESCENT YELLOW GREEN																"SHS"-STANDARD HIGHWAY SIGNS					
		F	W13-1	18	18			2.25																X				
																												
SB	5.282	F	VD-062AL	72	16		BUSINESS SIGN			1																		
		F	VD-062B	72	16		BUSINESS SIGN			1																		
SB	5.220	G	VR-017	24	30							1																
		G	VR-017	24	30			5.00						1		12.5	X								4			
SB	5.214	H	R1-1	30	30							1																
		H	R1-1	30	30			6.25						1		13.25	X							X				
SB	4.870	F	OM-3R	12	36		DELINEATOR REMOVED 	3.00						1		11.0	X							X				
SB	4.477	G	VR-017	24	30							1																
		G	VR-017	24	30			5.00						1		13.25	X								4			
SB	4.471	H	R1-1	30	30							1																
		H	R1-1	30	30			6.25						1		14.25	X							X				
SB	4.329	F	OM-3R	12	36		DELINEATOR REMOVED 	3.00						1		11.0	X							X				
SB	3.854	F	VW-059	30	30		HIDDEN DRIVE					1																
SB	3.741	F	R2-1	24	30							1																
SIGN SUMMARY SHEET							SHEET TOTALS	30.75	0.00	2	0	0	8	0	0	6												
VERMONT AGENCY OF TRANSPORTATION							TOWN DIRECTIONAL TOTALS	217.7	0.0	26.0	5.0	5.0	46	0.0	0.0	38	570.0											
															PROJECT NAME:	STATEWIDE - SOUTHWEST REGION												
															PROJECT NUMBER:	STPG SIGN(32)												
															FILE NAME:	SHAFTSBURY SB.XLS					PLOT DATE:	7/13/2010						
															PROJECT MANAGER:	A. GAMBLE					DRAWN BY:	J. KELLY						
															DESIGNED BY:	J. KELLY					CHECKED BY:	A. GAMBLE						
															SHAFTSBURY SOUTHBOUND SHEET 2										SHEET	19	OF	90




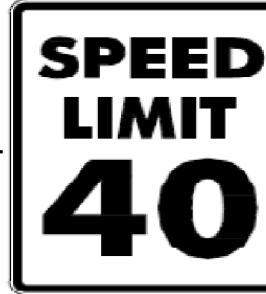

DIRECTION	MILEPOINT	LOCATION CODE (SHEET 2)	SIGN CODE	WIDTH (IN)	HEIGHT (IN)	SHEETING REMARKS	SIGN LEGEND	NEW SIGNS		EXISTING SIGNS				EXIST POST		NUMBER OF NEW POSTS	SQUARE STEEL (IN)			TUBULAR STEEL Ø (IN)				SIGN FRAME REQUIRED	REMARKS	SIGN DETAIL		
								"A"	"B"	RETAIN	SALVAGE FROM	SALVAGE TO	REMOVE	RETAIN	REMOVE		1.75	2.00	2.50	3.00	3.50	4.00	5.00			DETAIL IN SHS	DETAIL ON SHEET NUMBER	DETAIL ON STD SHEET NUMBER
																	(LB / FT)			(LB / FT)								
									1.88	2.42	3.35	FOUNDATION	7.60	9.00	10.80	14.60												
SHAFTSBURY VT-7A							FY-FLUORESCENT YELLOW FYG-FLUORESCENT YELLOW GREEN																"SHS"-STANDARD HIGHWAY SIGNS					
		F	R2-1	24	30			5.00																X				
SB	3.619	F	W2-1M	30	30		MODIFIED CROSSROAD			1																		
SB	3.502	G	VR-017	24	30								1															
		G	VR-017	24	30			5.00																	4			
SB	3.494	H	R1-1	30	30								1															
		H	R1-1	30	30			6.25																X				
SB	2.944	F	VD-062AS	72	16		BUSINESS SIGN			1																		
		F	VD-062B	72	16		BUSINESS SIGN			1																		
SB	2.672	F	W2-2MR	30	30		RIGHT SIDE ROAD (UP 45 DEG)			1																		
		F	W16-8	20	8		MYERS RD			1																		
SB	2.589	G	VR-017	24	30								1															
		G	VR-017	24	30			5.00																	4			
SB	2.587	H	R1-1	30	30								1															
		H	R1-1	30	30			6.25																X				
SB	1.800	F	W3-5	36	36		SPEED REDUCTION (40)			1																		
SIGN SUMMARY SHEET							SHEET TOTALS	27.50	0.00	6	0	0	4	0	0	5												
VERMONT AGENCY OF TRANSPORTATION							TOWN DIRECTIONAL TOTALS	217.7	0.0	26.0	5.0	5.0	46	0.0	0.0	38												
															PROJECT NAME: STATEWIDE - SOUTHWEST REGION													
															PROJECT NUMBER: STPG SIGN(32)													
															FILE NAME: SHAFTSBURY SB.XLS													
															PROJECT MANAGER: A. GAMBLE													
															DESIGNED BY: J. KELLY													
															SHAFTSBURY SOUTHBOUND SHEET 3													
															PLOT DATE: 7/13/2010													
															DRAWN BY: J. KELLY													
															CHECKED BY: A. GAMBLE													
															SHEET 20 OF 90													

DIRECTION	MILEPOINT	LOCATION CODE (SHEET 2)	SIGN CODE	WIDTH (IN)	HEIGHT (IN)	SHEETING REMARKS	SIGN LEGEND	NEW SIGNS		EXISTING SIGNS				EXIST POST		NUMBER OF NEW POSTS	SQUARE STEEL (IN)			TUBULAR STEEL Ø (IN)				SIGN FRAME REQUIRED	REMARKS	SIGN DETAIL			
								"A"	"B"	RETAIN	SALVAGE FROM	SALVAGE TO	REMOVE	RETAIN	REMOVE		1.75	2.00	2.50	FOUNDATION	3.00	3.50	4.00			5.00	DETAIL IN SHS	DETAIL ON SHEET NUMBER	DETAIL ON STD SHEET NUMBER
																	(LB / FT)				(LB / FT)								
SHAFTSBURY VT-7A							FY-FLUORESCENT YELLOW FYG-FLUORESCENT YELLOW GREEN																"SHS"-STANDARD HIGHWAY SIGNS						
SB	1.757	F	VD-018	30	18																								
		F	VD-018	30	18				3.75																		5		
SB	1.713	F	R2-1	30	36		SPEED LIMIT 40			1																			
SB	1.608	F	VD-062B	72	16		BUSINESS SIGN			1																			
		F	VD-062B	72	16		BUSINESS SIGN			1																			
		F	VD-062B	72	16		BUSINESS SIGN			1																			
SB	1.527	F	VW-205	30	30																								
		F	VW-205	36	36				9.00																		6		
SB	1.452	F	R2-1	30	36		SPEED LIMIT 35				1	1																	
SB	1.371	F	VD-062B	72	16		BUSINESS SIGN			1																			
SB	1.328	F	M2-1S	21	15																								
		F	M1-5	24	24																								
		F	M2-1	21	15				2.19																		E-136B		
		F	M1-5	24	24				4.00																		E-136B		
SB	1.255	G	VR-017	24	30		LEGAL LOAD 24,000 LBS			1																			
SIGN SUMMARY SHEET							SHEET TOTALS		18.94	0.00	6	1	1	5	0	0	5								PROJECT NAME: STATEWIDE - SOUTHWEST REGION				
VERMONT AGENCY OF TRANSPORTATION							TOWN DIRECTIONAL TOTALS		217.7	0.0	26.0	5.0	5.0	46	0.0	0.0	38								PROJECT NUMBER: STPG SIGN(32)				
																									FILE NAME: SHAFTSBURY SB.XLS				
																									PLOT DATE: 7/13/2010				
																									DRAWN BY: J. KELLY				
																									DESIGNED BY: J. KELLY				
																									CHECKED BY: A. GAMBLE				
																									SHAFTSBURY SOUTHBOUND SHEET 4				
																									SHEET 21 OF 90				


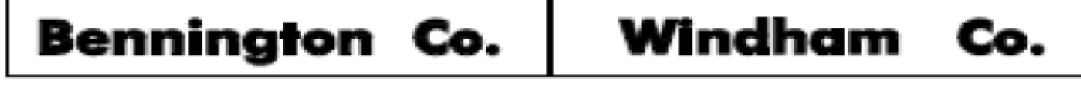
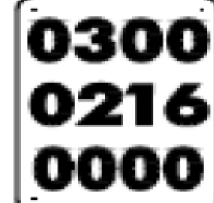





DIRECTION	MILEPOINT	LOCATION CODE (SHEET 2)	SIGN CODE	WIDTH (IN)	HEIGHT (IN)	SHEETING REMARKS	SIGN LEGEND	NEW SIGNS		EXISTING SIGNS				EXIST POST		NUMBER OF NEW POSTS	SQUARE STEEL (IN)			TUBULAR STEEL Ø (IN)				SIGN FRAME REQUIRED	REMARKS	SIGN DETAIL				
								"A"	"B"	RETAIN	SALVAGE FROM	SALVAGE TO	REMOVE	RETAIN	REMOVE		1.75	2.00	2.50	FOUNDATION	3.00	3.50	4.00			5.00	DETAIL IN SHS	DETAIL ON SHEET NUMBER	DETAIL ON STD SHEET NUMBER	
																	(LB / FT)				(LB / FT)									
SHAFTSBURY VT-7A							FY-FLUORESCENT YELLOW FYG-FLUORESCENT YELLOW GREEN															"SHS"-STANDARD HIGHWAY SIGNS								
SB	1.249	H	R1-1	30	30																									
		H	R1-1	30	30			6.25																X						
SB	1.241	F	D1-1A	72	12		DESTINATION SIGN			+																				
		F	D1-1A	72	12		DESTINATION SIGN			+																				
		F	D1-1M	72	12		DESTINATION SIGN			+																				
SB	1.215	F	M3-3S	24	12																									
		F	VM-078S	24	12																									
		F	M1-5	24	24																									
		F	M6-3S	21	15																									
		F	M3-4S	24	12																									
		F	M1-5	24	24																									
		F	M6-1S	21	15																									
		F	M3-3	24	12																									
		F	VM-078	24	12																									
		F	M1-5	24	24																									
SIGN SUMMARY SHEET							SHEET TOTALS	14.25	0.00	3	0	3	7	0	0	5								PROJECT NAME: STATEWIDE - SOUTHWEST REGION						
							SF	SF	EA	EA	EA	EA	EA	EA	EA	EA	FT							PROJECT NUMBER: STPG SIGN(32)						
VERMONT AGENCY OF TRANSPORTATION							TOWN DIRECTIONAL TOTALS	217.7	0.0	26.0	5.0	5.0	46	0.0	0.0	38			570.0						FILE NAME: SHAFTSBURY SB.XLS					
																									PLOT DATE: 7/13/2010					
																										DRAWN BY: J. KELLY				
																											DESIGNED BY: J. KELLY			
																											CHECKED BY: A. GAMBLE			
																												SHAFTSBURY SOUTHBOUND SHEET 5		
																												SHEET 22 OF 90		

DIRECTION	MILEPOINT	LOCATION CODE (SHEET 2)	SIGN CODE	WIDTH (IN)	HEIGHT (IN)	SHEETING REMARKS	SIGN LEGEND	NEW SIGNS		EXISTING SIGNS				EXIST POST		NUMBER OF NEW POSTS	SQUARE STEEL (IN)			TUBULAR STEEL Ø (IN)				SIGN FRAME REQUIRED	REMARKS	SIGN DETAIL		
								"A"	"B"	RETAIN	SALVAGE FROM	SALVAGE TO	REMOVE	RETAIN	REMOVE		1.75	2.00	2.50	3.00	3.50	4.00	5.00			DETAIL IN SHS	DETAIL ON SHEET NUMBER	DETAIL ON STD SHEET NUMBER
																	(LB / FT)			(LB / FT)								
SHAFTSBURY VT-7A							FY-FLUORESCENT YELLOW FYG-FLUORESCENT YELLOW GREEN																"SHS"-STANDARD HIGHWAY SIGNS					
			F M6-3	21	15			2.19																		E-136B		
			F M3-4S	24	12			2.00																		E-136B		
			F M1-5	24	24			4.00																		E-136B		
			F M6-1	21	15			2.19																		E-136B		
SB	1.159		F D2-1	72	10																							
			F M3-3S	24	12																							
			F VM-078S	24	12																							
			F M1-5	24	24																							
			F D2-1	72	12			6.00																				
			F M3-3	24	12			2																				
			F VM-078	24	12																							
			F M1-5	24	24																							
			F M3-3	24	12																							
			F VM-078	24	12																							
			F M1-5	24	24																							
			F M3-3	24	12																							
			F VM-078	24	12																							
			F M1-5	24	24																							
SB	1.133		F R2-1	24	30																							
			F R2-1	30	36																							
			F R2-1	30	36																							
SB	1.094		F D9-1	24	30		PHONE																					
SIGN SUMMARY SHEET							SHEET TOTALS	31.88	0.00	0	0	0	6	0	0	2												
VERMONT AGENCY OF TRANSPORTATION							TOWN DIRECTIONAL TOTALS	217.7	0.0	26.0	5.0	5.0	46	0.0	0.0	38												





PROJECT NAME: STATEWIDE - SOUTHWEST REGION
PROJECT NUMBER: STPG SIGN(32)
FILE NAME: SHAFTSBURY SB.XLS PLOT DATE: 7/13/2010
PROJECT MANAGER: A. GAMBLE DRAWN BY: J. KELLY
DESIGNED BY: J. KELLY CHECKED BY: A. GAMBLE
SHAFTSBURY SOUTHBOUND SHEET 6 SHEET 23 OF 90







DIRECTION	MILEPOINT	LOCATION CODE (SHEET 2)	SIGN CODE	WIDTH (IN)	HEIGHT (IN)	SHEETING REMARKS	SIGN LEGEND	NEW SIGNS		EXISTING SIGNS				EXIST POST		NUMBER OF NEW POSTS	SQUARE STEEL (IN)			TUBULAR STEEL Ø (IN)				SIGN FRAME REQUIRED	REMARKS	SIGN DETAIL		
								"A"	"B"	RETAIN	SALVAGE FROM	SALVAGE TO	REMOVE	RETAIN	REMOVE		1.75	2.00	2.50	3.00	3.50	4.00	5.00			DETAIL IN SHS	DETAIL ON SHEET NUMBER	DETAIL ON STD SHEET NUMBER
																	(LB / FT)			(LB / FT)								
									1.88	2.42	3.35	FOUNDATION	7.60	9.00	10.80	14.60												
SHAFTSBURY VT-7A							FY-FLUORESCENT YELLOW FYG-FLUORESCENT YELLOW GREEN																"SHS"-STANDARD HIGHWAY SIGNS					
SB	0.872	F	R2-1	24	30																							
		F	R2-1	24	30			5.00																REPLACE SIGN AND RETAIN SIGN POST.	X			
SB	0.759	F	W11-2FYG	30	30		PEDESTRIAN			1																		
		F	W16-7FYG	24	12		DIAGONAL ARROW			1																		
SB	0.603	G	VR-017	24	30																							
		G	VR-017	24	30			5.00																	4			
SB	0.597	H	R1-1	30	30																							
		H	R1-1	30	30			6.25																	X			
SB	0.594	F	R2-1	24	30																							
		F	R2-1	24	30			5.00																	X			
SB	0.357	F	R2-1	24	30		SPEED LIMIT 40			1																		
SB	0.319	F	VD-062B	72	16		BUSINESS SIGN			1																		
SB	0.220	F	VW-054R	30	30																							
		F	VW-054R	30	30			6.25																		6		
SB	0.108	F	S1-1FYG	36	36		SCHOOL				1	1	1															
SIGN SUMMARY SHEET							SHEET TOTALS	27.50	0.00	4	1	1	6 5	0	0	3												
VERMONT AGENCY OF TRANSPORTATION							TOWN DIRECTIONAL TOTALS	217.7	0.0	26.0	5.0	5.0	46	0.0	0.0	38												
															PROJECT NAME:	STATEWIDE - SOUTHWEST REGION												
															PROJECT NUMBER:	STPG SIGN(32)												
															FILE NAME:	SHAFTSBURY SB.XLS					PLOT DATE:	7/13/2010						
															PROJECT MANAGER:	A. GAMBLE					DRAWN BY:	J. KELLY						
															DESIGNED BY:	J. KELLY					CHECKED BY:	A. GAMBLE						
															SHAFTSBURY SOUTHBOUND SHEET 8										SHEET	25	OF	90




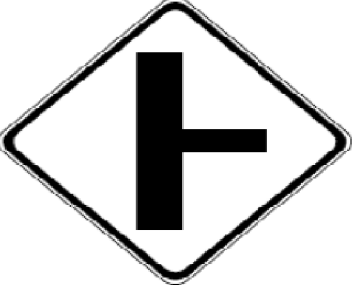




DIRECTION	MILEPOINT	LOCATION CODE (SHEET 2)	SIGN CODE	WIDTH (IN)	HEIGHT (IN)	SHEETING REMARKS	SIGN LEGEND	NEW SIGNS		EXISTING SIGNS				EXIST POST		NUMBER OF NEW POSTS	SQUARE STEEL (IN)			TUBULAR STEEL Ø (IN)				SIGN FRAME REQUIRED	REMARKS	SIGN DETAIL			
								"A"	"B"	RETAIN	SALVAGE FROM	SALVAGE TO	REMOVE	RETAIN	REMOVE		1.75	2.00	2.50	FOUNDATION	3.00	3.50	4.00			5.00	DETAIL IN SHS	DETAIL ON SHEET NUMBER	DETAIL ON STD SHEET NUMBER
																	(LB / FT)				(LB / FT)								
SHAFTSBURY VT-7A							FY-FLUORESCENT YELLOW FYG-FLUORESCENT YELLOW GREEN																"SHS"-STANDARD HIGHWAY SIGNS						
		F	W16-9FYG	24	10		AHEAD			1	1	1			2		14.25 14.75 X							RETAIN SIGNS AND REPLACE SIGN POSTS.					
SB	0.042	F	D1-1E	72	20		HILAND HALL SCHOOL			1																			
SB	0.006	G	VD-024	60	7.5		BENNINGTON / SHAFTSBURY TOWN LINE ASSEMBLY					1																	
SB	0.000	G	VD-024	72	10		<div style="display: flex; justify-content: space-around;"> <div style="border: 1px solid black; padding: 2px;">Bennington</div> <div style="border: 1px solid black; padding: 2px;">Shaftsbury</div> </div>	5.00							2		11.75 11.75 X								INSTALL DIRECTLY ACROSS ROAD FROM STONE WALL ALONG TH-35.		4		
		G	VD-700	6	10		<div style="border: 1px solid black; padding: 2px; display: inline-block;">0071 0202 0302</div>	0.42																	INSTALL ON LH POST BELOW BENNINGTON			E-138	
		G	VD-700	6	10		<div style="border: 1px solid black; padding: 2px; display: inline-block;">0071 0213 0000</div>	0.42																	INSTALL ON RH POST BELOW SHAFTSBURY			E-138	
SIGN SUMMARY SHEET							SHEET TOTALS		5.84	0.00	1	1	1	2 4	0	0	4												
VERMONT AGENCY OF TRANSPORTATION								SF	SF	EA	EA	EA	EA	EA	EA	EA	EA		FT										
TOWN DIRECTIONAL TOTALS							217.7	0.0	26.0	5.0	8.0 5.0	5.7 4.6	0.0	0.0	38			529.75 570.0											
																	PROJECT NAME: STATEWIDE - SOUTHWEST REGION			PROJECT NUMBER: STPG SIGN(32)									
																	FILE NAME: SHAFTSBURY SB.XLS			PLOT DATE: 7/13/2010									
																	PROJECT MANAGER: A. GAMBLE			DRAWN BY: J. KELLY									
																	DESIGNED BY: J. KELLY			CHECKED BY: A. GAMBLE									
																	SHAFTSBURY SOUTHBOUND SHEET 9			SHEET 26 OF 90									

DIRECTION	MILEPOINT	LOCATION CODE (SHEET 2)	SIGN CODE	WIDTH (IN)	HEIGHT (IN)	SHEETING REMARKS	SIGN LEGEND	NEW SIGNS		EXISTING SIGNS				EXIST POST		NUMBER OF NEW POSTS	SQUARE STEEL (IN)			TUBULAR STEEL Ø (IN)				SIGN FRAME REQUIRED	REMARKS	SIGN DETAIL		
								"A"	"B"	RETAIN	SALVAGE FROM	SALVAGE TO	REMOVE	RETAIN	REMOVE		1.75	2.00	2.50	3.00	3.50	4.00	5.00			DETAIL IN SHS	DETAIL ON SHEET NUMBER	DETAIL ON STD SHEET NUMBER
																	(LB / FT)			(LB / FT)								
WINHALL VT-30							FY-FLUORESCENT YELLOW FYG-FLUORESCENT YELLOW GREEN															"SHS"-STANDARD HIGHWAY SIGNS						
NB	10.086	A	VD-018	30	18		BONDVILLE / JCT VT-11 7																REMOVE BOTH OF THESE SIGN ASSEMBLIES FROM NORTH END OF JAMAICA.					
NB	10.106	A	R2-5A	24	30		REDUCED SPEED AHEAD																					
WINHALL VT-30																												
NB	0.000	C	VD-024	60	7.5																			2 ADDITIONAL MM REMOVED @ 0.000				
		C	VD-025	60	7.5																							
		C	VD-024	72	10			5.00																		4		
		C	VD-025	72	10			5.00																		4		
		C	VD-700	6	10			0.42																		E-138		
		C	VD-700	6	10			0.42																		E-138		
NB	0.015	A	W3-5	36	36			9.00																		X		
NB	0.065	A	VD-018	30	18			3.75																		5		
NB	0.130	A	R2-1	24	30																							
		A	R2-1	30	36			7.50																	X			
NB	0.160	C	VR-017	24	30																							
		C	VR-017	24	30			5.00																		4		
SIGN SUMMARY SHEET							SHEET TOTALS	36.09	0.00	0	0	0	8	0	0	7												
VERMONT AGENCY OF TRANSPORTATION							TOWN DIRECTIONAL TOTALS	456.7	0.0	5.0	3.0	3.0	79	0.0	0.0	51												






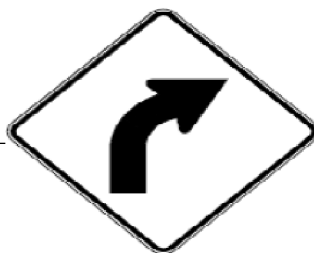


PROJECT NAME: STATEWIDE - SOUTHWEST REGION
PROJECT NUMBER: STPG SIGN(32)
FILE NAME: WINHALL NB.XLS PLOT DATE: 8/26/2010
PROJECT MANAGER: A. GAMBLE DRAWN BY: J. KELLY
DESIGNED BY: J. KELLY CHECKED BY: A. GAMBLE
WINHALL NORTHBOUND SHEET 1 SHEET 27 OF 90







DIRECTION	MILEPOINT	LOCATION CODE (SHEET 2)	SIGN CODE	WIDTH (IN)	HEIGHT (IN)	SHEETING REMARKS	SIGN LEGEND	NEW SIGNS		EXISTING SIGNS				EXIST POST		NUMBER OF NEW POSTS	SQUARE STEEL (IN)			TUBULAR STEEL Ø (IN)				SIGN FRAME REQUIRED	REMARKS	SIGN DETAIL		
								"A"	"B"	RETAIN	SALVAGE FROM	SALVAGE TO	REMOVE	RETAIN	REMOVE		1.75	2.00	2.50	3.00	3.50	4.00	5.00			DETAIL IN SHS	DETAIL ON SHEET NUMBER	DETAIL ON STD SHEET NUMBER
																	(LB / FT)			(LB / FT)								
WINHALL VT-30							FY-FLUORESCENT YELLOW FYG-FLUORESCENT YELLOW GREEN															"SHS"-STANDARD HIGHWAY SIGNS						
NB	0.165	D	R1-1	30	30			6.25								1	13.25 X							AMEDEN RD. (TH-22)	X			
NB	0.238	A	S3-4A	30	30		SCHOOL BUS TURN AROUND		1																			
NB	0.275	A	VR-020	24	30																			REPLACE SIGN AND RETAIN SIGN POST.			4	
		A	VR-020	24	30			5.00																				
NB	0.300	A	VD-062M	72	16		BUSINESS SIGN		1																			
		A	VD-062M	72	16		BUSINESS SIGN		1																			
		A	VD-062BM	72	16		BUSINESS SIGN		1																			
NB	0.314	A	D1-1S	72	10																							
		A	D1-1S	72	12			6.00								2	12.0 12.0 X										5	
NB	0.330	A	W11-2YG	30	30																							
		A	W16-9FYG	24	12																							
		A	W11-2	30	30	FYG		6.25								1	15.0 X								X			
		A	W16-9	24	12	FYG		2.00																	X			
NB	0.368	A	M3-1S	24	12		NORTH																					
		A	M1-5	24	24		VT-30																					
SIGN SUMMARY SHEET							SHEET TOTALS	25.50	0.00	4	0	0	6	0	0	4	60-52.25							PROJECT NAME: STATEWIDE - SOUTHWEST REGION				
VERMONT AGENCY OF TRANSPORTATION							TOWN DIRECTIONAL TOTALS	456.7	0.0	5.0	3.0	3.0	79	0.0	0.0	51	765.0						PROJECT NUMBER: STPG SIGN(32)	FILE NAME: WINHALL NB.XLS	PLOT DATE: 8/26/2010			
																						PROJECT MANAGER: A. GAMBLE	DRAWN BY: J. KELLY					
																						DESIGNED BY: J. KELLY	CHECKED BY: A. GAMBLE					
																						WINHALL NORTHBOUND SHEET 2	SHEET 28	OF 90				






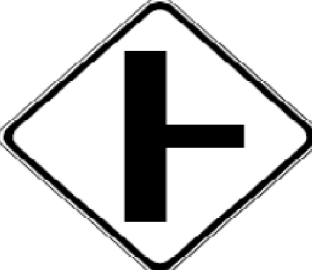


DIRECTION	MILEPOINT	LOCATION CODE (SHEET 2)	SIGN CODE	WIDTH (IN)	HEIGHT (IN)	SHEETING REMARKS	SIGN LEGEND	NEW SIGNS		EXISTING SIGNS				EXIST POST		NUMBER OF NEW POSTS	SQUARE STEEL (IN)			TUBULAR STEEL Ø (IN)				SIGN FRAME REQUIRED	REMARKS	SIGN DETAIL			
								"A"	"B"	RETAIN	SALVAGE FROM	SALVAGE TO	REMOVE	RETAIN	REMOVE		1.75	2.00	2.50	FOUNDATION	3.00	3.50	4.00			5.00	DETAIL IN SHS	DETAIL ON SHEET NUMBER	DETAIL ON STD SHEET NUMBER
																	(LB / FT)				(LB / FT)								
WINHALL VT-30							FY-FLUORESCENT YELLOW FYG-FLUORESCENT YELLOW GREEN																"SHS"-STANDARD HIGHWAY SIGNS						
		A	R2-1	24	30			5.00																	X				
NB	0.397	A	R2-1	24	30		SPEED LIMIT 30																						
		A	M3-1	24	12			2.00																			E-136B		
		A	M1-5	24	24			4.00																			E-136B		
NB	0.463	A	VD-062AS	72	16		BUSINESS SIGN			1																			
																													
NB	0.509	A	R2-1	24	30																								
		A	R2-1	24	30			5.00																	X				
NB	0.516	C	VR-017	24	30																								
		C	VR-017	24	30			5.00																		4			
NB	0.522	D	R1-1	30	30																								
		D	R1-1	30	30			6.25																	X				
NB	0.610	C	VR-017	24	30																								
		C	VR-017	24	30			5.00																		4			
		C	N/A				TOWN'S BUCKLE-UP SIGN																						
NB	0.617	D	R1-1	30	30																								
SIGN SUMMARY SHEET							SHEET TOTALS	32.25	0.00	1	0	0	7	0	0	3													
VERMONT AGENCY OF TRANSPORTATION							TOWN DIRECTIONAL TOTALS	456.7	0.0	5.0	3.0	3.0	79	0.0	0.0	51													
															PROJECT NAME:	STATEWIDE - SOUTHWEST REGION													
															PROJECT NUMBER:	STPG SIGN(32)													
															FILE NAME:	WINHALL NB.XLS				PLOT DATE:	8/26/2010								
															PROJECT MANAGER:	A. GAMBLE				DRAWN BY:	J. KELLY								
															DESIGNED BY:	J. KELLY				CHECKED BY:	A. GAMBLE								
																WINHALL NORTHBOUND SHEET 3				SHEET	29		OF	90					









DIRECTION	MILEPOINT	LOCATION CODE (SHEET 2)	SIGN CODE	WIDTH (IN)	HEIGHT (IN)	SHEETING REMARKS	SIGN LEGEND	NEW SIGNS		EXISTING SIGNS				EXIST POST		NUMBER OF NEW POSTS	SQUARE STEEL (IN)			TUBULAR STEEL Ø (IN)				SIGN FRAME REQUIRED	REMARKS	SIGN DETAIL		
								"A"	"B"	RETAIN	SALVAGE FROM	SALVAGE TO	REMOVE	RETAIN	REMOVE		1.75	2.00	2.50	3.00	3.50	4.00	5.00			DETAIL IN SHS	DETAIL ON SHEET NUMBER	DETAIL ON STD SHEET NUMBER
																	(LB / FT)			(LB / FT)								
WINHALL VT-30							FY-FLUORESCENT YELLOW FYG-FLUORESCENT YELLOW GREEN															"SHS"-STANDARD HIGHWAY SIGNS						
		D	R1-1	30	30			6.25															REPLACE SIGN AND RETAIN SIGN POST.	X				
NB	0.700	A	R2-1	24	30			5.00							1	14.5 X							INSTALL 50 FEET SOUTH OF EXISTING SPEED LIMIT 40 SIGN ASSEMBLY.	X				
NB	0.710	A	R2-1	24	30		SPEED LIMIT 40																					
NB	0.855	A	VW-544	30	30		EMERGENCY VEHICLES																					
NB	0.955	A	R2-1	24	30		SPEED LIMIT 40																					
		A	VW-544	30	30			6.25							1	14.5 X									6			
NB	1.000	A	W2-2R	30	30																							
		A	W2-2MR	30	30			6.25							1	14.0 X									6			
NB	1.057	A	S1-1	36	36																							
		A	W16-9FYG	24	10																							
		A	S1-1	36	36	FYG		9.00							1	14.0 X								X				
		A	S4-3P	24	8	FYG		1.33																X				
NB	1.113	A	D1-1E	72	20																							
		A	D1-1E	72	20			10.00							2	14.5 15.75 X								6				
NB	1.147	C	VR-017	24	30			5.00							1	13.5 X									4			
SIGN SUMMARY SHEET							SHEET TOTALS	49.08	0.00	0	0	0	8 7	0	0	7	105 100.75							PROJECT NAME: STATEWIDE - SOUTHWEST REGION PROJECT NUMBER: STPG SIGN(32)				
VERMONT AGENCY OF TRANSPORTATION							TOWN DIRECTIONAL TOTALS	456.7	0.0	5.0	3.0	3.0	79	0.0	0.0	51	765.0							FILE NAME: WINHALL NB.XLS PROJECT MANAGER: A. GAMBLE DESIGNED BY: J. KELLY WINHALL NORTHBOUND SHEET 4				
																							PLOT DATE: 8/26/2010 DRAWN BY: J. KELLY CHECKED BY: A. GAMBLE SHEET 30 OF 90					








DIRECTION	MILEPOINT	LOCATION CODE (SHEET 2)	SIGN CODE	WIDTH (IN)	HEIGHT (IN)	SHEETING REMARKS	SIGN LEGEND	NEW SIGNS		EXISTING SIGNS				EXIST POST		NUMBER OF NEW POSTS	SQUARE STEEL (IN)			TUBULAR STEEL Ø (IN)				SIGN FRAME REQUIRED	REMARKS	SIGN DETAIL		
								"A"	"B"	RETAIN	SALVAGE FROM	SALVAGE TO	REMOVE	RETAIN	REMOVE		1.75	2.00	2.50	FOUNDATION						DETAIL IN SHS	DETAIL ON SHEET NUMBER	DETAIL ON STD SHEET NUMBER
																	(LB / FT)			3.00	3.50	4.00	5.00					
									1.88	2.42	3.35	7.60	9.00	10.80	14.60													
WINHALL VT-30							FY-FLUORESCENT YELLOW FYG-FLUORESCENT YELLOW GREEN																"SHS"-STANDARD HIGHWAY SIGNS					
NB	1.157	D	R1-1	30	30																	SCHOOL RD. (TH-37)						
		D	R1-1	30	30			6.25														REPLACE SIGN AND RETAIN SIGN POST.	X					
NB	1.299	C	VR-017	24	30			5.00														SHORT RD. (TH-26)			4			
NB	1.306	D	R1-1	30	30																	SHORT RD. (TH-26)						
		D	R1-1	30	30			6.25														REPLACE SIGN AND RETAIN SIGN POST.	X					
NB	1.370	C	VR-017	24	30																	SHORT RD. (TH-26)						
		D	R1-1	30	30																							
		C	VR-017	24	30			5.00																	4			
		D	R1-1	30	30			6.25														INSTALL ON EASTERLY SIDE OF SHORT RD ON SEPARATE POST.	X					
NB	1.400	A	R2-1	24	30																							
		A	R2-1	24	30			5.00															X					
NB	1.750	A	VW-000	30	30			6.25														INSTALL 175 FEET NORTH OF STRATTON VIEW ACCESS. SOUTH SIDE OF POLE #82X/50T/148/475			6			
		A	W7-3A	24	18			3.00															X					
NB	2.335	C	VR-017	24	30																	STONEY HILL RD. (TH-12)						
		C	VR-017	24	30			5.00														REPLACE SIGN AND RETAIN SIGN POST.			4			
SIGN SUMMARY SHEET							SHEET TOTALS	48.00	0.00	0	0	0	6	0	0	5	75 69.25						PROJECT NAME: STATEWIDE - SOUTHWEST REGION					
								SF	SF	EA	EA	EA	EA	EA	EA	EA	FT						PROJECT NUMBER: STPG SIGN(32)					
VERMONT AGENCY OF TRANSPORTATION							TOWN DIRECTIONAL TOTALS	456.7	0.0	5.0	3.0	3.0	79	0.0	0.0	51	765.0						FILE NAME: WINHALL NB.XLS	PLOT DATE: 8/26/2010				
																						PROJECT MANAGER: A. GAMBLE	DRAWN BY: J. KELLY					
																						DESIGNED BY: J. KELLY	CHECKED BY: A. GAMBLE					
																						WINHALL NORTHBOUND SHEET 5	SHEET 31 OF 90					

DIRECTION	MILEPOINT	LOCATION CODE (SHEET 2)	SIGN CODE	WIDTH (IN)	HEIGHT (IN)	SHEETING REMARKS	SIGN LEGEND	NEW SIGNS		EXISTING SIGNS				EXIST POST		NUMBER OF NEW POSTS	SQUARE STEEL (IN)			TUBULAR STEEL Ø (IN)				SIGN FRAME REQUIRED	REMARKS	SIGN DETAIL		
								"A"	"B"	RETAIN	SALVAGE FROM	SALVAGE TO	REMOVE	RETAIN	REMOVE		1.75	2.00	2.50	3.00	3.50	4.00	5.00			DETAIL IN SHS	DETAIL ON SHEET NUMBER	DETAIL ON STD SHEET NUMBER
																	(LB / FT)			(LB / FT)								
									1.88	2.42	3.35	FOUNDATION	7.60	9.00	10.80	14.60												
WINHALL VT-30							FY-FLUORESCENT YELLOW FYG-FLUORESCENT YELLOW GREEN															"SHS"-STANDARD HIGHWAY SIGNS						
NB	2.343	D	R1-1	30	30																							
		D	R1-1	30	30			6.25															X					
NB	2.710	C	VR-017	24	30																							
		C	VR-017	24	30			5.00																4				
		C	N/A				TOWN'S NO PARKING SIGN																					
NB	2.717	D	R1-1	30	30																							
		D	R1-1	30	30			6.25							1	15.5	X						X					
NB	3.158	A	W1-5R	30	30																							
		A		24	18			3.00															X					
NB	3.196	A	W1-5L	30	30		LEFT WINDING ROAD 																					
		A	W1-2R	30	30			6.25															X					
NB	3.256	A	VW-060	30	30		HIDDEN DRIVES 																					
		A	VW-054R	30	30			6.25								1	15.25	X						6				
NB	4.000	A	W1-2L	30	30																							
		A	W1-2L	30	30			6.25															X					
SIGN SUMMARY SHEET							SHEET TOTALS	45.50 -42.50	0.00	0	-4	-4	6	0	0	3							PROJECT NAME: STATEWIDE - SOUTHWEST REGION PROJECT NUMBER: STPG SIGN(32)					
VERMONT AGENCY OF TRANSPORTATION							TOWN DIRECTIONAL TOTALS	456.7	0.0	5.0	2.0 -3.0	2.0 -3.0	79	0.0	0.0	51	765.0						FILE NAME: WINHALL NB.XLS PROJECT MANAGER: A. GAMBLE DESIGNED BY: J. KELLY WINHALL NORTHBOUND SHEET 6	PLOT DATE: 8/26/2010 DRAWN BY: J. KELLY CHECKED BY: A. GAMBLE SHEET 32 OF 90				

DIRECTION	MILEPOINT	LOCATION CODE (SHEET 2)	SIGN CODE	WIDTH (IN)	HEIGHT (IN)	SHEETING REMARKS	SIGN LEGEND	NEW SIGNS		EXISTING SIGNS				EXIST POST		NUMBER OF NEW POSTS	SQUARE STEEL (IN)			TUBULAR STEEL Ø (IN)				SIGN FRAME REQUIRED	REMARKS	SIGN DETAIL		
								"A"	"B"	RETAIN	SALVAGE FROM	SALVAGE TO	REMOVE	RETAIN	REMOVE		1.75	2.00	2.50	3.00	3.50	4.00	5.00			DETAIL IN SHS	DETAIL ON SHEET NUMBER	DETAIL ON STD SHEET NUMBER
																	(LB / FT)			(LB / FT)								
WINHALL VT-30							FY-FLUORESCENT YELLOW FYG-FLUORESCENT YELLOW GREEN															"SHS"-STANDARD HIGHWAY SIGNS						
NB	4.110	A	VW-054L	30	30																							
		A	VW-054L	30	30			6.25																	6			
NB	4.120	C	VR-017	24	30																							
		C	VR-017	24	30			5.00																	4			
		C	N/A				TOWN'S SPEED LIMIT 35			1	1	1																
NB	4.135	D	R1-1	30	30																							
		D	R1-1	30	30			6.25															X					
NB	4.282	C	VR-017	24	30																							
		C	VR-017	24	30			5.00																	4			
NB	4.290	D	R1-1	30	30																							
		D	R1-1	30	30			6.25															X					
NB	4.360	A	VW-054R	30	30		HIDDEN DRIVE RIGHT																					
NB	5.152	A	VW-054R	30	30		HIDDEN DRIVE RIGHT																					
NB	5.305	A	S3-1	30	30		* 																					
		A	S3-1	36	36	FYG		9.00															X					
SIGN SUMMARY SHEET							SHEET TOTALS	37.75	0.00	0	1	1	9	0	0	5								PROJECT NAME: STATEWIDE - SOUTHWEST REGION				
VERMONT AGENCY OF TRANSPORTATION							TOWN DIRECTIONAL TOTALS	456.7	0.0	5.0	3.0	3.0	79	0.0	0.0	51								PROJECT NUMBER: STPG SIGN(32)				
																							FILE NAME: WINHALL NB.XLS					
																								PLOT DATE: 8/26/2010				
																								DESIGNED BY: J. KELLY				
																								CHECKED BY: A. GAMBLE				
																								WINHALL NORTHBOUND SHEET 7				
																								SHEET 33 OF 90				

DIRECTION	MILEPOINT	LOCATION CODE (SHEET 2)	SIGN CODE	WIDTH (IN)	HEIGHT (IN)	SHEETING REMARKS	SIGN LEGEND	NEW SIGNS		EXISTING SIGNS				EXIST POST		NUMBER OF NEW POSTS	SQUARE STEEL (IN)			TUBULAR STEEL Ø (IN)				SIGN FRAME REQUIRED	REMARKS	SIGN DETAIL			
								"A"	"B"	RETAIN	SALVAGE FROM	SALVAGE TO	REMOVE	RETAIN	REMOVE		1.75	2.00	2.50	FOUNDATION	3.00	3.50	4.00			5.00	DETAIL IN SHS	DETAIL ON SHEET NUMBER	DETAIL ON STD SHEET NUMBER
																	(LB / FT)				(LB / FT)								
WINHALL VT-30							FY-FLUORESCENT YELLOW FYG-FLUORESCENT YELLOW GREEN															"SHS"-STANDARD HIGHWAY SIGNS							
NB	5.404	C	VR-017	24	30																								
		C	VR-017	24	30			5.00																	4				
NB	5.411	D	R1-1	30	30																								
		D	R1-1	30	30			6.25						1										X					
NB	5.685	C	VR-017	24	30																								
		C	VR-017	24	30			5.00						1											4				
NB	5.702	D	R1-1	30	30																								
		D	R1-1	30	30			6.25						1															
NB	5.790	A	S3-1	30	30		SCHOOL BUS STOP AHEAD *																						
		A	S3-1	36	36	FYG		9.00							2									X					
NB	5.840	A	W2-2R	30	30																								
		A	W2-2RM	30	30			6.25						1											6				
NB	5.907	C	VR-017	24	30																								
		C	VR-017	24	30			5.00																	4				
NB	5.921	D	R1-1	30	30																								
SIGN SUMMARY SHEET							SHEET TOTALS	42.75	0.00	0	0	0	8	0	0	5								PROJECT NAME: STATEWIDE - SOUTHWEST REGION					
VERMONT AGENCY OF TRANSPORTATION							TOWN DIRECTIONAL TOTALS	456.7	0.0	5.0	3.0	3.0	79	0.0	0.0	51								PROJECT NUMBER: STPG SIGN(32)					
								SF	SF	EA	EA	EA	EA	EA	EA	EA							FILE NAME: WINHALL NB.XLS	PLOT DATE: 8/26/2010					
																							PROJECT MANAGER: A. GAMBLE	DRAWN BY: J. KELLY					
																							DESIGNED BY: J. KELLY	CHECKED BY: A. GAMBLE					
																							WINHALL NORTHBOUND SHEET 8	SHEET 34 OF 90					








DIRECTION	MILEPOINT	LOCATION CODE (SHEET 2)	SIGN CODE	WIDTH (IN)	HEIGHT (IN)	SHEETING REMARKS	SIGN LEGEND	NEW SIGNS		EXISTING SIGNS				EXIST POST		NUMBER OF NEW POSTS	SQUARE STEEL (IN)			TUBULAR STEEL Ø (IN)				SIGN FRAME REQUIRED	REMARKS	SIGN DETAIL			
								"A"	"B"	RETAIN	SALVAGE FROM	SALVAGE TO	REMOVE	RETAIN	REMOVE		1.75	2.00	2.50	FOUNDATION	3.00	3.50	4.00			5.00	DETAIL IN SHS	DETAIL ON SHEET NUMBER	DETAIL ON STD SHEET NUMBER
																	(LB / FT)				(LB / FT)								
WINHALL VT-30							FY-FLUORESCENT YELLOW FYG-FLUORESCENT YELLOW GREEN																"SHS"-STANDARD HIGHWAY SIGNS						
		D	R1-1	30	30			6.25																REPLACE SIGN AND RETAIN SIGN POST.	X				
NB	6.735	A	D17-2	42	42			12.25							2										INSTALL 200 FEET NORTH OF EXISTING RIGHT CURVE SIGN ASSEMBLY		4		
NB	6.773	A	W1-2MR	30	30		MODIFIED RIGHT CURVE																						
		A	W13-1	18	18		35 MPH																						
		A	N/A				BRIDGE #48 MARKER				1	1			1	X													
NB	6.875	A	R4-6	24	30		TRUCK LANE 500 FEET																						
NB	6.890	A	W1-10R	36	36			9.00																					
		A	W13-1	18	18			2.25																					
NB	6.985	A	R4-3	24	30																								
		A	R4-3	24	30			5.00							1														
NB	7.143	A	W9-1	36	36			9.00																					
NB	7.193	A	W4-2R	36	36																								
		A	W4-2R	36	36			9.00							2														
NB	7.377	A	W2-4	30	30																								
		A	W16-2	24	18																								
SIGN SUMMARY SHEET							SHEET TOTALS	52.75	0.00	0	1	1	8	0	0	10													
VERMONT AGENCY OF TRANSPORTATION							TOWN DIRECTIONAL TOTALS	456.7	0.0	5.0	3.0	3.0	79	0.0	0.0	51													
															PROJECT NAME: STATEWIDE - SOUTHWEST REGION														
															PROJECT NUMBER: STPG SIGN(32)														
															FILE NAME: WINHALL NB.XLS														
															PROJECT MANAGER: A. GAMBLE														
															DESIGNED BY: J. KELLY														
															WINHALL NORTHBOUND SHEET 9														
															PLOT DATE: 8/26/2010														
															DRAWN BY: J. KELLY														
															CHECKED BY: A. GAMBLE														
															SHEET 35 OF 90														








DIRECTION	MILEPOINT	LOCATION CODE (SHEET 2)	SIGN CODE	WIDTH (IN)	HEIGHT (IN)	SHEETING REMARKS	SIGN LEGEND	NEW SIGNS		EXISTING SIGNS				EXIST POST		NUMBER OF NEW POSTS	SQUARE STEEL (IN)			TUBULAR STEEL Ø (IN)				SIGN FRAME REQUIRED	REMARKS	SIGN DETAIL		
								"A"	"B"	RETAIN	SALVAGE FROM	SALVAGE TO	REMOVE	RETAIN	REMOVE		1.75	2.00	2.50	3.00	3.50	4.00	5.00			DETAIL IN SHS	DETAIL ON SHEET NUMBER	DETAIL ON STD SHEET NUMBER
																	(LB / FT)			(LB / FT)								
WINHALL VT-30							FY-FLUORESCENT YELLOW FYG-FLUORESCENT YELLOW GREEN															"SHS"-STANDARD HIGHWAY SIGNS						
SB	7.650	E	R1-1	36	36																							
		E	R1-1	36	36				9.00																X			
SB	7.637	K	R1-2	30	30		   																					
		J	R5-1	30	30																							
		L	R6-1L	36	12																							
		L	R6-1R	36	12																							
		K	R1-2	36	36				3.89																X			
		J	R5-1	30	30				6.25																X			
		L	R6-1L	36	12				3.00																X			
		L	R6-1R	36	12			3.00																X				
SB	7.634	F	R1-2	30	30		 																					
		E	R5-1	30	30																							
		G	R6-1L	36	12																							
		F	R1-2	36	36				3.89																X			
		E	R5-1	30	30				6.25																X			
SIGN SUMMARY SHEET							SHEET TOTALS	35.28	0.00	0	0	0	8	0	0	4									PROJECT NAME: STATEWIDE - SOUTHWEST REGION			
								SF	SF	EA	EA	EA	EA	EA	EA	EA									PROJECT NUMBER: STPG SIGN(32)			
VERMONT AGENCY OF TRANSPORTATION							TOWN DIRECTIONAL TOTALS	457.6	0.0	6.0	0.0	0.0	81	0.0	0.0	65										FILE NAME: WINHALL SB.XLS		
																									PLOT DATE: 7/13/2010			
																									DRAWN BY: J. KELLY			
																									DESIGNED BY: J. KELLY			
																									CHECKED BY: A. GAMBLE			
																									WINHALL SOUTHBOUND SHEET 1			
																								SHEET 39 OF 90				

DIRECTION	MILEPOINT	LOCATION CODE (SHEET 2)	SIGN CODE	WIDTH (IN)	HEIGHT (IN)	SHEETING REMARKS	SIGN LEGEND	NEW SIGNS		EXISTING SIGNS				EXIST POST		NUMBER OF NEW POSTS	SQUARE STEEL (IN)			TUBULAR STEEL Ø (IN)				SIGN FRAME REQUIRED	REMARKS	SIGN DETAIL			
								"A"	"B"	RETAIN	SALVAGE FROM	SALVAGE TO	REMOVE	RETAIN	REMOVE		1.75	2.00	2.50	3.00	3.50	4.00	5.00			DETAIL IN SHS	DETAIL ON SHEET NUMBER	DETAIL ON STD SHEET NUMBER	
																	(LB / FT)			(LB / FT)									
WINHALL VT-30							FY-FLUORESCENT YELLOW FYG-FLUORESCENT YELLOW GREEN																"SHS"-STANDARD HIGHWAY SIGNS						
		G	R6-1L	36	12			3.00																		X			
SB	7.595	F	VR-041	24	24		THROUGH WAY BEGINS HERE						1		X														
		F	R2-1	24	30								1																
		F	R2-1	24	30				5.00																		X		
		E	VR-040	24	24			THROUGH WAY ENDS HERE						1															
SB	7.555	F	D2-1	72	10								1		X														
		F	D2-1S	72	10									1															
		F	D2-1	72	10									1															
		F	D2-1	72	12				6.00																			5	
		F	D2-1S	72	12				6.00																			5	
		F	D2-1	72	12				6.00																			5	
		F	M3-3	24	12				2.00																			E-136B	
		F	M1-5	24	24				4.00																			E-136B	
SB	7.513	E	W3-1	36	36								1		X														
		E	W3-1	36	36				9.00																		X		
SIGN SUMMARY SHEET							SHEET TOTALS	41.00	0.00	0	0	0	7	0	0	5													
VERMONT AGENCY OF TRANSPORTATION							TOWN DIRECTIONAL TOTALS	457.6	0.0	6.0	0.0	0.0	81	0.0	0.0	65													

PROJECT NAME: STATEWIDE - SOUTHWEST REGION
PROJECT NUMBER: STPG SIGN(32)
FILE NAME: WINHALL SB.XLS
PROJECT MANAGER: A. GAMBLE
DESIGNED BY: J. KELLY
WINHALL SOUTHBOUND SHEET 2

PLOT DATE: 7/13/2010
DRAWN BY: J. KELLY
CHECKED BY: A. GAMBLE
SHEET 40 OF 90




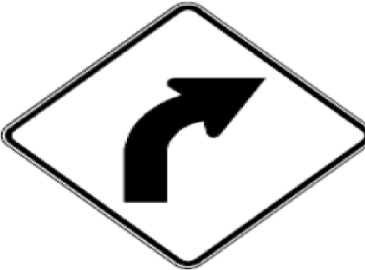





DIRECTION	MILEPOINT	LOCATION CODE (SHEET 2)	SIGN CODE	WIDTH (IN)	HEIGHT (IN)	SHEETING REMARKS	SIGN LEGEND	NEW SIGNS		EXISTING SIGNS				EXIST POST		NUMBER OF NEW POSTS	SQUARE STEEL (IN)			TUBULAR STEEL Ø (IN)				SIGN FRAME REQUIRED	REMARKS	SIGN DETAIL										
								"A"	"B"	RETAIN	SALVAGE FROM	SALVAGE TO	REMOVE	RETAIN	REMOVE		1.75	2.00	2.50	3.00	3.50	4.00	5.00			DETAIL IN SHS	DETAIL ON SHEET NUMBER	DETAIL ON STD SHEET NUMBER								
																	(LB / FT)			(LB / FT)																
WINHALL VT-30							FY-FLUORESCENT YELLOW FYG-FLUORESCENT YELLOW GREEN															"SHS"-STANDARD HIGHWAY SIGNS														
SB	7.465	F	M3-3	24	12		SOUTH																													
		F	M1-5A	24	24		ROUTE 30																													
SB	7.260	F	W7-1B	30	30			6.25																												
SB	7.140	F	W1-2ML	30	30		MODIFIED LEFT CURVE																													
SB	7.074	A	W1-10L	36	36			9.00																												
		A	W13-1	18	18			2.25																												
SB	7.052	F	W1-8	18	24		CHEVRON																													
		E	W1-8	18	24		CHEVRON																													
SB	7.040	E	W1-6	48	24			8.00																												
SB	7.020	F	W1-8	18	24		CHEVRON																													
		E	W1-8	18	24		CHEVRON																													
SB	6.980	F	W1-6	48	24			8.00																												
		E	W1-6	48	24			8.00																												
SB	6.978	G	VR-017	24	30			5.00																												
SB	6.937	H	R1-1	30	30																															
SIGN SUMMARY SHEET							SHEET TOTALS	46.50	0.00	0	0	0	8	0	0	10	139.75																			
VERMONT AGENCY OF TRANSPORTATION							TOWN DIRECTIONAL TOTALS	457.6	0.0	6.0	0.0	0.0	81	0.0	0.0	65	975.0																			
																					PROJECT NAME:	STATEWIDE - SOUTHWEST REGION														
																					PROJECT NUMBER:	STPG SIGN(32)														
																					FILE NAME:	WINHALL SB.XLS														
																					PROJECT MANAGER:	A. GAMBLE														
																					DESIGNED BY:	J. KELLY														
																					WINHALL SOUTHBOUND SHEET 3															
																					PLOT DATE:	7/13/2010														
																					DRAWN BY:	J. KELLY														
																					CHECKED BY:	A. GAMBLE														
																					SHEET	41														
																					OF	90														








DIRECTION	MILEPOINT	LOCATION CODE (SHEET 2)	SIGN CODE	WIDTH (IN)	HEIGHT (IN)	SHEETING REMARKS	SIGN LEGEND	NEW SIGNS		EXISTING SIGNS				EXIST POST		NUMBER OF NEW POSTS	SQUARE STEEL (IN)			TUBULAR STEEL Ø (IN)				SIGN FRAME REQUIRED	REMARKS	SIGN DETAIL		
								"A"	"B"	RETAIN	SALVAGE FROM	SALVAGE TO	REMOVE	RETAIN	REMOVE		(LB / FT)			(LB / FT)						DETAIL IN SHS	DETAIL ON SHEET NUMBER	DETAIL ON STD SHEET NUMBER
																	1.75	2.00	2.50	3.00	3.50	4.00	5.00					
WINHALL VT-30							FY-FLUORESCENT YELLOW FYG-FLUORESCENT YELLOW GREEN															"SHS"-STANDARD HIGHWAY SIGNS						
		H	R1-1	30	30			6.25																X				
SB	6.932	F	W1-6	48	24			8.00																X		INSTALL 25 FEET SOUTH OF STOP SIGN.		
SB	6.930	F	W1-8	18	24		CHEVRON																					
		E	W1-8	18	24		CHEVRON																					
SB	6.907	F	W1-8	18	24		CHEVRON																					
SB	6.857	G	VR-017	24	30																							
		G	VR-017	24	30			5.00																	4	WINHALL WOOD RD. (TH-30)		
SB	6.786	H	R1-1	30	30																							
		H	R1-1	30	30			6.25																X		WINHALL WOOD RD. (TH-30)		
SB	6.800	F	VW-000	30	30		MOOSE CROSSING																					
		F	W7-3A	24	18		NEXT 5 MILES																					
SB	6.772	F	VW-000	30	30			6.25																		6		
		F	W7-3A	24	18			3.00																X				
SB	6.640	G	VR-017	24	30																							
		G	VR-017	24	30			5.00																	4	SIGNAL HILL RD. (TH-40)		
SIGN SUMMARY SHEET							SHEET TOTALS	39.75	0.00	0	0	0	8	0	0	7												
VERMONT AGENCY OF TRANSPORTATION							TOWN DIRECTIONAL TOTALS	457.6	0.0	6.0	0.0	0.0	81	0.0	0.0	65												

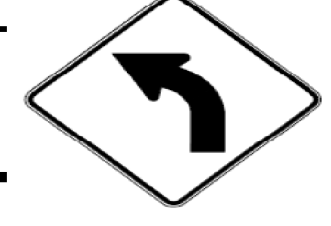

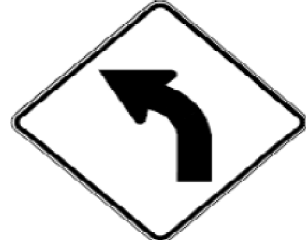





PROJECT NAME: STATEWIDE - SOUTHWEST REGION
PROJECT NUMBER: STPG SIGN(32)
FILE NAME: WINHALL SB.XLS
PROJECT MANAGER: A. GAMBLE
DESIGNED BY: J. KELLY
WINHALL SOUTHBOUND SHEET 4



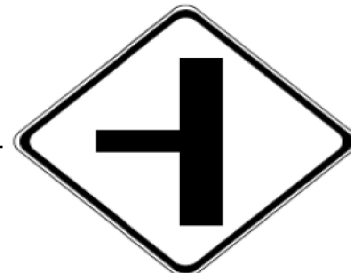

PLOT DATE: 7/13/2010
DRAWN BY: J. KELLY
CHECKED BY: A. GAMBLE
SHEET 42 OF 90

DIRECTION	MILEPOINT	LOCATION CODE (SHEET 2)	SIGN CODE	WIDTH (IN)	HEIGHT (IN)	SHEETING REMARKS	SIGN LEGEND	NEW SIGNS		EXISTING SIGNS				EXIST POST		NUMBER OF NEW POSTS	SQUARE STEEL (IN)			TUBULAR STEEL Ø (IN)				SIGN FRAME REQUIRED	REMARKS	SIGN DETAIL		
								"A"	"B"	RETAIN	SALVAGE FROM	SALVAGE TO	REMOVE	RETAIN	REMOVE		1.75	2.00	2.50	FOUNDATION	3.00	3.50	4.00			5.00	DETAIL IN SHS	DETAIL ON SHEET NUMBER
WINHALL VT-30							FY-FLUORESCENT YELLOW FYG-FLUORESCENT YELLOW GREEN																"SHS"-STANDARD HIGHWAY SIGNS					
SB	6.630	H	R1-1	30	30																			SIGNAL HILL RD. (TH-40)				
		H	R1-1	30	30			6.25								1	13.25 X							REMOVE 0665 MILE POINT SIGN.	X			
SB	6.091	F	S3-1	30	30		SCHOOL BUS STOP AHEAD																					
SB	6.039	F	W2-2L	30	30		LEFT SIDE ROAD																					
SB	6.018	F	S3-1	36	36	FYG		9.00							2	15.0 X 14.5 X								INSTALL 375 FEET SOUTH OF EXISTING SCHOOL BUS STOP AHEAD SIGN ASSEMBLY.	X			
SB	5.980	F	W2-2LM	30	30			6.25							1	15.5 X									INSTALL 300 FEET SOUTH OF EXISTING SIDE ROAD WARNING SIGN ASSEMBLY.		4	
SB	5.691	F	S3-1	30	30		SCHOOL BUS STOP AHEAD																					
SB	5.542	G	VR-017	24	30																							
		G	VR-017	24	30			5.00							1	13.25 X												4
SB	5.536	H	R1-1	30	30																							
		H	R1-1	30	30			6.25							1	13.25 X											X	
SB	5.205	G	W2-2R	30	30		RIGHT SIDE ROAD																					
SB	5.140	G	W2-2RM	30	30			6.25							1	14.0 X									INSTALL 350 FEET SOUTH OF EXISTING SIDE ROAD SIGN ASSEMBLY.		4	
SB	5.059	G	VR-017	24	30																				CAPEN RD. (TH-24)			
		G	VR-017	24	30			5.00																	REPLACE SIGN AND RETAIN SIGN POST.		4	
SIGN SUMMARY SHEET							SHEET TOTALS	44.00	0.00	0	0	0	8	0	0	7	405	98.75							PROJECT NAME: STATEWIDE - SOUTHWEST REGION			
								SF	SF	EA	EA	EA	EA	EA	EA	EA	FT								PROJECT NUMBER: STPG SIGN(32)			
VERMONT AGENCY OF TRANSPORTATION							TOWN DIRECTIONAL TOTALS	457.6	0.0	6.0	0.0	0.0	81	0.0	0.0	65	975.0								FILE NAME: WINHALL_SB.XLS	PLOT DATE: 7/13/2010		
																								PROJECT MANAGER: A. GAMBLE	DRAWN BY: J. KELLY			
																								DESIGNED BY: J. KELLY	CHECKED BY: A. GAMBLE			
																								WINHALL SOUTHBOUND SHEET 5	SHEET 43 OF 90			

DIRECTION	MILEPOINT	LOCATION CODE (SHEET 2)	SIGN CODE	WIDTH (IN)	HEIGHT (IN)	SHEETING REMARKS	SIGN LEGEND	NEW SIGNS		EXISTING SIGNS				EXIST POST		NUMBER OF NEW POSTS	SQUARE STEEL (IN)			TUBULAR STEEL Ø (IN)				SIGN FRAME REQUIRED	REMARKS	SIGN DETAIL			
								"A"	"B"	RETAIN	SALVAGE FROM	SALVAGE TO	REMOVE	RETAIN	REMOVE		1.75	2.00	2.50	FOUNDATION	3.00	3.50	4.00			5.00	DETAIL IN SHS	DETAIL ON SHEET NUMBER	DETAIL ON STD SHEET NUMBER
																	(LB / FT)				(LB / FT)								
WINHALL VT-30							FY-FLUORESCENT YELLOW FYG-FLUORESCENT YELLOW GREEN																"SHS"-STANDARD HIGHWAY SIGNS						
SB	5.051	H	R1-1	30	30																								
		H	R1-1	30	30			6.25																	X				
SB	4.769	G	VR-017	24	30																								
		G	VR-017	24	30			5.00																		4			
SB	4.758	H	R1-1	30	30																								
		H	R1-1	30	30			6.25																	X				
SB	4.353	F	W1-2R	30	30		RIGHT CURVE 																						
SB	4.282	F	W1-2R	30	30			6.25																	X				
SB	4.007	F	W7-1B	30	30																								
		F	W7-1B	30	30			6.25																	X				
		F	W7-3A	24	18			3.00																					
SB	3.955	F	W1-5L	30	30																								
		F	W1-5L	30	30			6.25																	X				
		F	W7-3A	24	18			3.00																					
SB	3.905	F	W1-2L	30	30			6.25																	X				
SIGN SUMMARY SHEET							SHEET TOTALS	48.50	0.00	0	0	0	6	0	0	4									PROJECT NAME: STATEWIDE - SOUTHWEST REGION				
								SF	SF	EA	EA	EA	EA	EA	EA	EA									PROJECT NUMBER: STPG SIGN(32)				
VERMONT AGENCY OF TRANSPORTATION							TOWN DIRECTIONAL TOTALS	457.6	0.0	6.0	0.0	0.0	81	0.0	0.0	65									FILE NAME: WINHALL SB.XLS	PLOT DATE: 7/13/2010			
																								DESIGNED BY: J. KELLY	CHECKED BY: A. GAMBLE				
																								WINHALL SOUTHBOUND SHEET 6	SHEET 44	OF 90			








DIRECTION	MILEPOINT	LOCATION CODE (SHEET 2)	SIGN CODE	WIDTH (IN)	HEIGHT (IN)	SHEETING REMARKS	SIGN LEGEND	NEW SIGNS		EXISTING SIGNS				EXIST POST		NUMBER OF NEW POSTS	SQUARE STEEL (IN)			TUBULAR STEEL Ø (IN)				SIGN FRAME REQUIRED	REMARKS	SIGN DETAIL			
								"A"	"B"	RETAIN	SALVAGE FROM	SALVAGE TO	REMOVE	RETAIN	REMOVE		1.75	2.00	2.50	FOUNDATION	3.00	3.50	4.00			5.00	DETAIL IN SHS	DETAIL ON SHEET NUMBER	DETAIL ON STD SHEET NUMBER
																	(LB / FT)				(LB / FT)								
WINHALL VT-30							FY-FLUORESCENT YELLOW FYG-FLUORESCENT YELLOW GREEN																"SHS"-STANDARD HIGHWAY SIGNS						
SB	3.454	F	VW-054R	30	30		HIDDEN DRIVE RIGHT																						
		F	S3-1	30	30		SCHOOL BUS STOP AHEAD																						
		F	S3-1	36	36	FYG	 	9.00																	X				
SB	3.416	F	W1-2L	30	30			6.25																	X				
SB	3.398	F	W1-8	18	24		CHEVRON																						
SB	3.385	F	W1-6	48	24			8.00																	X				
SB	3.341	F	W1-8	18	24		CHEVRON																						
SB	1.610	G	VR-017	24	30																								
		G	VR-017	24	30			5.00																		4			
SB	1.589	H	R1-1	30	30																								
		H	R1-1	30	30			6.25																	X				
SB	1.584	G	VR-017	24	30																								
		G	VR-017	24	30			5.00																		4			
SB	1.575	H	R1-1	30	30																								
		H	R1-1	30	30			6.25																	X				
SIGN SUMMARY SHEET							SHEET TOTALS	45.75	0.00	0	0	0	8	0	0	6									PROJECT NAME: STATEWIDE - SOUTHWEST REGION PROJECT NUMBER: STPG SIGN(32)				
VERMONT AGENCY OF TRANSPORTATION							TOWN DIRECTIONAL TOTALS	457.6	0.0	6.0	0.0	0.0	81	0.0	0.0	65										FILE NAME: WINHALL SB.XLS PROJECT MANAGER: A. GAMBLE DESIGNED BY: J. KELLY WINHALL SOUTHBOUND SHEET 7	PLOT DATE: 7/13/2010 DRAWN BY: J. KELLY CHECKED BY: A. GAMBLE SHEET 45 OF 90		



DIRECTION	MILEPOINT	LOCATION CODE (SHEET 2)	SIGN CODE	WIDTH (IN)	HEIGHT (IN)	SHEETING REMARKS	SIGN LEGEND	NEW SIGNS		EXISTING SIGNS				EXIST POST		NUMBER OF NEW POSTS	SQUARE STEEL (IN)			TUBULAR STEEL Ø (IN)				SIGN FRAME REQUIRED	REMARKS	SIGN DETAIL						
								"A"	"B"	RETAIN	SALVAGE FROM	SALVAGE TO	REMOVE	RETAIN	REMOVE		1.75	2.00	2.50	FOUNDATION	3.00	3.50	4.00			5.00	DETAIL IN SHS	DETAIL ON SHEET NUMBER	DETAIL ON STD SHEET NUMBER			
																	(LB / FT)				(LB / FT)											
WINHALL VT-30							FY-FLUORESCENT YELLOW FYG-FLUORESCENT YELLOW GREEN																"SHS"-STANDARD HIGHWAY SIGNS									
SB	1.540	F	R2-5A	24	30		REDUCED SPEED AHEAD 																									
SB	1.500	F	W3-5	36	36			9.00																			INSTALL 200 FEET SOUTH OF EXISTING REDUCED SPEED AHEAD ASSEMBLY.	X				
SB	1.400	F	R2-1	24	30																											
		F	R2-1	30	36			7.50																						4		
SB	1.350	F	W2-2L	30	30																											
		F	W2-2LM	30	30			6.25																						6		
SB	1.243	F	S1-1	36	36																											
		F	W16-9FYG	24	10																											
		F	S1-1	36	36	FYG		9.00																							X	
		F	S4-3P	24	8	FYG		1.33																						X		
SB	1.190	F	D1-1E	72	20																											
		F	D1-1E	72	20			10.00																							6	
SB	1.140	F	VW-544	30	30																											
		F	VW-544	30	30			6.25																							6	
SB	1.000	F	R2-1	24	30																											
SIGN SUMMARY SHEET							SHEET TOTALS	49.33	0.00	0	0	0	0	0	0	9																
VERMONT AGENCY OF TRANSPORTATION							TOWN DIRECTIONAL TOTALS	457.6	0.0	6.0	0.0	0.0	81	0.0	0.0	65																
															PROJECT NAME: STATEWIDE - SOUTHWEST REGION																	
															PROJECT NUMBER: STPG SIGN(32)																	
															FILE NAME: WINHALL SB.XLS		PLOT DATE: 7/13/2010															
															PROJECT MANAGER: A. GAMBLE		DRAWN BY: J. KELLY															
															DESIGNED BY: J. KELLY		CHECKED BY: A. GAMBLE															
															WINHALL SOUTHBOUND SHEET 8		SHEET 46 OF 90															





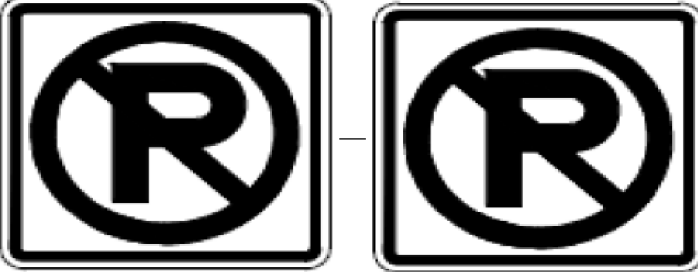
DIRECTION	MILEPOINT	LOCATION CODE (SHEET 2)	SIGN CODE	WIDTH (IN)	HEIGHT (IN)	SHEETING REMARKS	SIGN LEGEND	NEW SIGNS		EXISTING SIGNS				EXIST POST		NUMBER OF NEW POSTS	SQUARE STEEL (IN)			TUBULAR STEEL Ø (IN)				SIGN FRAME REQUIRED	REMARKS	SIGN DETAIL			
								"A"	"B"	RETAIN	SALVAGE FROM	SALVAGE TO	REMOVE	RETAIN	REMOVE		1.75	2.00	2.50	FOUNDATION	3.00	3.50	4.00			5.00	DETAIL IN SHS	DETAIL ON SHEET NUMBER	DETAIL ON STD SHEET NUMBER
																	(LB / FT)				(LB / FT)								
WINHALL VT-30							FY-FLUORESCENT YELLOW FYG-FLUORESCENT YELLOW GREEN															"SHS"-STANDARD HIGHWAY SIGNS							
		F	R2-1	24	30			5.00																	X				
SB	0.910	F	VD-062BM	72	16		BUSINESS SIGN			1																			
SB	0.910	F	VD-062M	72	16		BUSINESS SIGN			1																			
SB	0.910	F	VD-062M	72	16		BUSINESS SIGN			1																			
SB	0.857	F	R2-5A	24	30		REDUCED SPEED AHEAD 					1																	
		F	W3-5	36	36			9.00																		X			
SB	0.810	F	VD-018	30	18							1																	
		F	VD-018	30	18			3.75																			5		
SB	0.760	F	VD-062AS	72	16		BUSINESS SIGN			1																			
SB	0.711	F	R2-1	24	30							1																	
SB	0.700	F	R2-1	30	36																						4		
SB	0.566	F	W11-2YG	30	30																								
		F	W16-9FYG	24	12																								
		F	W11-2	30	30	FYG																				X			
		F	W16-9	24	12	FYG																				X			
SIGN SUMMARY SHEET							SHEET TOTALS	33.50	0.00	4	0	0	5	0	0	5													
								SF	SF	EA	EA	EA	EA	EA	EA	EA													
VERMONT AGENCY OF TRANSPORTATION							TOWN DIRECTIONAL TOTALS	457.6	0.0	6.0	0.0	0.0	81	0.0	0.0	65													






PROJECT NAME: STATEWIDE - SOUTHWEST REGION
PROJECT NUMBER: STPG SIGN(32)
FILE NAME: WINHALL_SB.XLS PLOT DATE: 7/13/2010
PROJECT MANAGER: A. GAMBLE DRAWN BY: J. KELLY
DESIGNED BY: J. KELLY CHECKED BY: A. GAMBLE
WINHALL SOUTHBOUND SHEET 9 SHEET 47 OF 90

DIRECTION	MILEPOINT	LOCATION CODE (SHEET 2)	SIGN CODE	WIDTH (IN)	HEIGHT (IN)	SHEETING REMARKS	SIGN LEGEND	NEW SIGNS		EXISTING SIGNS				EXIST POST		NUMBER OF NEW POSTS	SQUARE STEEL (IN)			TUBULAR STEEL Ø (IN)				SIGN FRAME REQUIRED	REMARKS	SIGN DETAIL		
								"A"	"B"	RETAIN	SALVAGE FROM	SALVAGE TO	REMOVE	RETAIN	REMOVE		(LB / FT)			(LB / FT)						DETAIL IN SHS	DETAIL ON SHEET NUMBER	DETAIL ON STD SHEET NUMBER
																	1.75	2.00	2.50	3.00	3.50	4.00	5.00					
WINHALL VT-30							FY-FLUORESCENT YELLOW FYG-FLUORESCENT YELLOW GREEN															"SHS"-STANDARD HIGHWAY SIGNS						
SB	0.521	F	R2-1	24	30																							
		F	R2-1	24	30			5.00															X					
SB	0.480	F	S3-4A	30	30		SCHOOL BUS TURN AROUND			1																		
SB	0.445	F	W11-2YG	30	30																							
		F	W16-7FYG	24	12																							
		E	W11-2YG	30	30																							
		E	W16-7FYG	24	12																							
		F	W11-2	30	30	FYG																						
		F	W16-7pL	24	12	FYG		6.25														1	15.0 X		X			
		E	W11-2	30	30	FYG		2.00																				
		E	W16-7pR	24	12	FYG		6.25																				
		E	W16-7pR	24	12	FYG	2.00																					
SB	0.390	F	D1-1S	72	10																							
		F	D1-1S	72	12			6.00														2	12.0 12.25 X			5		
SB	0.373	G	VR-017	24	30																							
		G	VR-017	24	30			5.00																				
SIGN SUMMARY SHEET							SHEET TOTALS	32.50	0.00	1	0	0	7	0	0	3							PROJECT NAME: STATEWIDE - SOUTHWEST REGION					
VERMONT AGENCY OF TRANSPORTATION							TOWN DIRECTIONAL TOTALS	457.6	0.0	6.0	0.0	0.0	81	0.0	0.0	65							PROJECT NUMBER: STPG SIGN(32)					
																						FILE NAME: WINHALL SB.XLS						
																							DESIGNED BY: J. KELLY					
																							PLOT DATE: 7/13/2010					
																							PROJECT MANAGER: A. GAMBLE					
																							DRAWN BY: J. KELLY					
																							CHECKED BY: A. GAMBLE					
																							WINHALL SOUTHBOUND SHEET 10					
																							SHEET 48 OF 90					

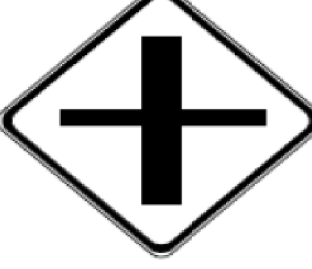DIRECTION	MILEPOINT	LOCATION CODE (SHEET 2)	SIGN CODE	WIDTH (IN)	HEIGHT (IN)	SHEETING REMARKS	SIGN LEGEND	NEW SIGNS		EXISTING SIGNS				EXIST POST		NUMBER OF NEW POSTS	SQUARE STEEL (IN)			TUBULAR STEEL Ø (IN)				SIGN FRAME REQUIRED	REMARKS	SIGN DETAIL			
								"A"	"B"	RETAIN	SALVAGE FROM	SALVAGE TO	REMOVE	RETAIN	REMOVE		1.75	2.00	2.50	FOUNDATION	3.00	3.50	4.00			5.00	DETAIL IN SHS	DETAIL ON SHEET NUMBER	DETAIL ON STD SHEET NUMBER
																	(LB / FT)				(LB / FT)								
WINHALL VT-30							FY-FLUORESCENT YELLOW FYG-FLUORESCENT YELLOW GREEN																"SHS"-STANDARD HIGHWAY SIGNS						
SB	0.360	H	R1-1	30	30																								
		H	R1-1	30	30			6.25																	X				
SB	0.355	F	M3-3S	24	12																								
		F	M1-5	24	24																								
		F	M3-3	24	12			2.00																		E-136B			
		F	M1-5	24	24			4.00																		E-136B			
SB	0.340	F	VR-020	24	30																								
		F	VR-020	24	30			5.00																		4			
SB	0.270	F	R2-1	24	30																								
		F	R2-1	24	30			5.00																	X				
SB	0.265	F	OM-3R	12	36			3.00																	X				
SB	0.152	G	VR-017	24	30																								
		G	VR-017	24	30			5.00																		4			
SB	0.145	H	R1-1	30	30																								
		H	R1-1	30	30			6.25																	X				
SIGN SUMMARY SHEET							SHEET TOTALS	36.50	0.00	0	0	0	7	0	0	4	-60.51							PROJECT NAME: STATEWIDE - SOUTHWEST REGION					
VERMONT AGENCY OF TRANSPORTATION							TOWN DIRECTIONAL TOTALS	457.6	0.0	6.0	0.0	0.0	81	0.0	0.0	65	975.0							PROJECT NUMBER: STPG SIGN(32)					
								SF	SF	EA	EA	EA	EA	EA	EA	EA	FT							FILE NAME: WINHALL SB.XLS	PLOT DATE: 7/13/2010				
																								PROJECT MANAGER: A. GAMBLE	DRAWN BY: J. KELLY				
																								DESIGNED BY: J. KELLY	CHECKED BY: A. GAMBLE				
																								WINHALL SOUTHBOUND SHEET 11	SHEET 49 OF 90				








DIRECTION	MILEPOINT	LOCATION CODE (SHEET 2)	SIGN CODE	WIDTH (IN)	HEIGHT (IN)	SHEETING REMARKS	SIGN LEGEND	NEW SIGNS		EXISTING SIGNS				EXIST POST		NUMBER OF NEW POSTS	SQUARE STEEL (IN)			TUBULAR STEEL Ø (IN)				SIGN FRAME REQUIRED	REMARKS	SIGN DETAIL			
								"A"	"B"	RETAIN	SALVAGE FROM	SALVAGE TO	REMOVE	RETAIN	REMOVE		1.75	2.00	2.50	3.00	3.50	4.00	5.00			DETAIL IN SHS	DETAIL ON SHEET NUMBER	DETAIL ON STD SHEET NUMBER	
																	(LB / FT)			(LB / FT)									
WINHALL VT-30							FY-FLUORESCENT YELLOW FYG-FLUORESCENT YELLOW GREEN																"SHS"-STANDARD HIGHWAY SIGNS						
SB	0.130	F	R2-1	24	30																								
		F	R2-1	24	30			5.00								1			13.75							X			
SB	0.065	F	VD-062AS	72	16		BUSINESS SIGN			1																			
SB	4.140	F	VW-054R	30	30			6.25							1			14.5									SIGN AFTER PROJECT LET		
SIGN SUMMARY SHEET							SHEET TOTALS	11.25 5.00	0.00	1	0	0	1	0	0	2 4			45	28.25				PROJECT NAME: STATEWIDE - SOUTHWEST REGION					
VERMONT AGENCY OF TRANSPORTATION							TOWN DIRECTIONAL TOTALS	463.85 457.6	0.0	6.0	0.0	0.0	82 81	0.0	0.0	66 65			923.25 975.0				PROJECT NUMBER: STPG SIGN(32)	FILE NAME: WINHALL SB.XLS	PLOT DATE: 7/13/2010				
																							PROJECT MANAGER: A. GAMBLE	DRAWN BY: J. KELLY					
																								DESIGNED BY: J. KELLY	CHECKED BY: A. GAMBLE				
																								WINHALL SOUTHBOUND SHEET 12	SHEET 50	OF 90			










DIRECTION	MILEPOINT	LOCATION CODE (SHEET 2)	SIGN CODE	WIDTH (IN)	HEIGHT (IN)	SHEETING REMARKS	SIGN LEGEND	NEW SIGNS		EXISTING SIGNS			EXIST POST		NUMBER OF NEW POSTS	SQUARE STEEL (IN)			TUBULAR STEEL Ø (IN)				SIGN FRAME REQUIRED	REMARKS	SIGN DETAIL				
								"A"	"B"	RETAIN	SALVAGE FROM	SALVAGE TO	REMOVE	RETAIN		REMOVE	1.75	2.00	2.50	FOUNDATION	3.00	3.50			4.00	5.00	DETAIL IN SHS	DETAIL ON SHEET NUMBER	DETAIL ON STD SHEET NUMBER
																	(LB / FT)				(LB / FT)								
DORSET US-7							FY-FLUORESCENT YELLOW FYG-FLUORESCENT YELLOW GREEN																"SHS"-STANDARD HIGHWAY SIGNS						
NB	1.765	A	VD-018	30	18																								
		A	VD-018	30	18																				5				
NB	1.867	A	W11-2	30	30																								
		A	W11-2	30	30	FYG																		X					
		A	W16-9P	24	12	FYG																		X					
NB	1.954	A	W2-1M	30	30																								
			W2-1M	36	36																				6				
NB	1.995	A	D1-1	72	10																								
						POST OFFICE ==>																							
NB	2.054	A	R8-3A	24	24																								
		A	VR-644P	24	12																								
		A	VR-644P	24	12																								
		A	R8-3	24	24																								
NB	2.094	A	R8-3A	24	24																								
		B	R8-3A	24	24																								
		A	R8-3	24	24																								
SIGN SUMMARY SHEET							SHEET TOTALS	31.00	0.00	1	0	0	7	0	0	1													
VERMONT AGENCY OF TRANSPORTATION							TOWN DIRECTIONAL TOTALS	163.8	0.0	1.0	1.0	1.0	32	0.0	0.0	24													
															PROJECT NAME: STATEWIDE - SOUTHWEST REGION			PROJECT NUMBER: STPG SIGN(32)			FILE NAME: DORSET NB.XLS			PLOT DATE: 7/13/2010					
															DESIGNED BY: J. KELLY			DRAWN BY: J. KELLY			CHECKED BY: A. GAMBLE			SHEET 51 OF 90					








DIRECTION	MILEPOINT	LOCATION CODE (SHEET 2)	SIGN CODE	WIDTH (IN)	HEIGHT (IN)	SHEETING REMARKS	SIGN LEGEND	NEW SIGNS		EXISTING SIGNS			EXIST POST		NUMBER OF NEW POSTS	SQUARE STEEL (IN)			TUBULAR STEEL Ø (IN)				SIGN FRAME REQUIRED	REMARKS	SIGN DETAIL				
								"A"	"B"	RETAIN	SALVAGE FROM	SALVAGE TO	REMOVE	RETAIN		REMOVE	1.75	2.00	2.50	FOUNDATION	3.00	3.50			4.00	5.00	DETAIL IN SHS	DETAIL ON SHEET NUMBER	DETAIL ON STD SHEET NUMBER
																	(LB / FT)				(LB / FT)								
DORSET US-7							FY-FLUORESCENT YELLOW FYG-FLUORESCENT YELLOW GREEN																"SHS"-STANDARD HIGHWAY SIGNS						
			B	R8-3	24	24		4.00																	X				
NB	2.103		C	VR-017	24	30						1	X																
			C	VR-017	24	30		5.00																		4			
NB	2.111		D	R1-1	30	30						1	X																
			D	R1-1	30	30		6.25																X					
				N/A			TOWN'S STREET NAME SIGN			X																			
NB	2.121		A	R8-3A	24	24						1	X																
			A	M4-6P	24	12						1																	
			A	M4-6	24	12		2.00						1	14.25 X											4			
			A	R8-3	24	24		4.00															X						
NB	2.148		A	M3-1	24	12						1	X																
			A	M1-4	24	24						1																	
			A	M3-1	24	12		2.00																X					
			A	M1-4	24	24		4.00															X						
NB	2.268		A	R2-1	24	30						1	X																
SIGN SUMMARY SHEET							SHEET TOTALS	27.25	0.00	0	0	0	7	0	0	1			45-14.25										
VERMONT AGENCY OF TRANSPORTATION							TOWN DIRECTIONAL TOTALS	163.8	0.0	1.0	1.0	1.0	32	0.0	0.0	24			360.0										

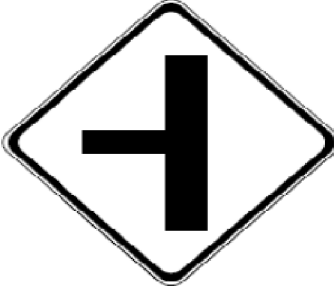

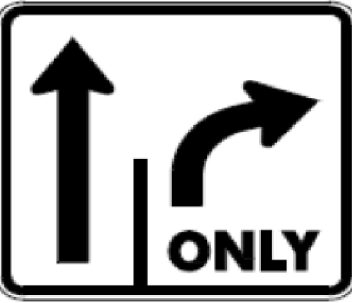



PROJECT NAME: STATEWIDE - SOUTHWEST REGION
PROJECT NUMBER: STPG SIGN(32)
FILE NAME: DORSET NB.XLS
PROJECT MANAGER: A. GAMBLE
DESIGNED BY: J. KELLY
DORSET NORTHBOUND SHEET 2

PLOT DATE: 7/13/2010
DRAWN BY: J. KELLY
CHECKED BY: A. GAMBLE
SHEET 52 OF 90

DIRECTION	MILEPOINT	LOCATION CODE (SHEET 2)	SIGN CODE	WIDTH (IN)	HEIGHT (IN)	SHEETING REMARKS	SIGN LEGEND	NEW SIGNS		EXISTING SIGNS				EXIST POST		NUMBER OF NEW POSTS	SQUARE STEEL (IN)			TUBULAR STEEL Ø (IN)				SIGN FRAME REQUIRED	REMARKS	SIGN DETAIL		
								"A"	"B"	RETAIN	SALVAGE FROM	SALVAGE TO	REMOVE	RETAIN	REMOVE		1.75	2.00	2.50	3.00	3.50	4.00	5.00			DETAIL IN SHS	DETAIL ON SHEET NUMBER	DETAIL ON STD SHEET NUMBER
																	(LB / FT)			(LB / FT)								
									1.88	2.42	3.35	FOUNDATION	7.60	9.00	10.80	14.60												
DORSET US-7							FY-FLUORESCENT YELLOW FYG-FLUORESCENT YELLOW GREEN																"SHS"-STANDARD HIGHWAY SIGNS					
		A	R2-1	24	30			5.00																X				
NB	2.635	A	N/A	30	30		(HORSE SHOW - SEASONAL SIGN)			X																		
NB	2.796	C	VR-023B	24	30		\$500 FINE FOR THROWING TRASH ON HIGHWAYS.						1															
NB	3.484	A	OM-3R	12	36								1															
		A	OM-3R	12	36			3.00																X				
NB	3.514	B	OM-3L	12	36								1															
		B	OM-3L	12	36			3.00																X				
NB	3.630	A	W11-3	30	30			6.25																	X			
		A	W7-3A	24	18			3.00																	X			
NB	3.693	C	VR-017	24	30								1															
		C	VR-017	24	30			5.00																	4			
NB	3.701	D	R1-1	30	30								1															
		D	R1-1	30	30			6.25																X				
			N/A				TOWN'S STREET NAME SIGN				1	1	1															
NB	3.716	A	M3-1	24	12			2.00																X				
SIGN SUMMARY SHEET							SHEET TOTALS	33.50	0.00	0	1	1	6	0	0	7												
VERMONT AGENCY OF TRANSPORTATION							TOWN DIRECTIONAL TOTALS	163.8	0.0	1.0	1.0	1.0	32	0.0	0.0	24												
															PROJECT NAME: STATEWIDE - SOUTHWEST REGION													
															PROJECT NUMBER: STPG SIGN(32)													
															FILE NAME: DORSET NB.XLS													
															PROJECT MANAGER: A. GAMBLE													
															DESIGNED BY: J. KELLY													
															DORSET NORTHBOUND SHEET 3													
															PLOT DATE: 7/13/2010													
															DRAWN BY: J. KELLY													
															CHECKED BY: A. GAMBLE													
															SHEET 53 OF 90													




DIRECTION	MILEPOINT	LOCATION CODE (SHEET 2)	SIGN CODE	WIDTH (IN)	HEIGHT (IN)	SHEETING REMARKS	SIGN LEGEND	NEW SIGNS		EXISTING SIGNS				EXIST POST		NUMBER OF NEW POSTS	SQUARE STEEL (IN)			TUBULAR STEEL Ø (IN)				SIGN FRAME REQUIRED	REMARKS	SIGN DETAIL		
								"A"	"B"	RETAIN	SALVAGE FROM	SALVAGE TO	REMOVE	RETAIN	REMOVE		1.75	2.00	2.50	3.00	3.50	4.00	5.00			DETAIL IN SHS	DETAIL ON SHEET NUMBER	DETAIL ON STD SHEET NUMBER
																	(LB / FT)			(LB / FT)								
									1.88	2.42	3.35	FOUNDATION	7.60	9.00	10.80	14.60												
DORSET US-7							FY-FLUORESCENT YELLOW FYG-FLUORESCENT YELLOW GREEN																"SHS"-STANDARD HIGHWAY SIGNS					
		A	M1-4	24	24																			X				
NB	3.754	A	R2-1	24	30			4.00																				
NB	4.615	A	VD-018	30	18								1	X														
		A	VD-018	30	18			3.75																	5			
NB	4.693	A	R2-1	24	30								1	X														
NB	4.700	A	R2-1	30	36			7.50								1		15.5	X							4		
NB	4.877	A	VW-619	30	30			6.25								1		15.25	X							6		
NB	4.916	A	R2-1	24	30								1	X														
		A	R2-1	24	30			5.00							1		13.25	X						X				
NB	4.968	A	OM-3R	12	36								1	X														
		A	OM-3R	12	36			3.00							1		11.0	X						X				
NB	5.020	B	OM-3L	12	36								1	X														
		B	OM-3L	12	36			3.00							1		11.0	X						X				
NB	5.067	A	W2-2LM	30	30								1	X														
		A	W2-2LM	30	30			6.25																				
SIGN SUMMARY SHEET							SHEET TOTALS		43.75	0.00	0	0	0	6	0	0	6	90.80.75			PROJECT NAME: STATEWIDE - SOUTHWEST REGION							
VERMONT AGENCY OF TRANSPORTATION							TOWN DIRECTIONAL TOTALS		163.8	0.0	1.0	1.0	1.0	32	0.0	0.0	24	360.0			PROJECT NUMBER: STPG SIGN(32)							
									SF	SF	EA	EA	EA	EA	EA	EA	EA	FT			FILE NAME: DORSET NB.XLS							
																					PLOT DATE: 7/13/2010							
																					DRAWN BY: J. KELLY							
																					DESIGNED BY: J. KELLY							
																					CHECKED BY: A. GAMBLE							
																					SHEET 54 OF 90							






DIRECTION	MILEPOINT	LOCATION CODE (SHEET 2)	SIGN CODE	WIDTH (IN)	HEIGHT (IN)	SHEETING REMARKS	SIGN LEGEND	NEW SIGNS		EXISTING SIGNS			EXIST POST		NUMBER OF NEW POSTS	SQUARE STEEL (IN)			TUBULAR STEEL Ø (IN)				SIGN FRAME REQUIRED	REMARKS	SIGN DETAIL				
								"A"	"B"	RETAIN	SALVAGE FROM	SALVAGE TO	REMOVE	RETAIN		REMOVE	1.75	2.00	2.50	FOUNDATION	3.00	3.50			4.00	5.00	DETAIL IN SHS	DETAIL ON SHEET NUMBER	DETAIL ON STD SHEET NUMBER
																	(LB / FT)				(LB / FT)								
DORSET US-7							FY-FLUORESCENT YELLOW FYG-FLUORESCENT YELLOW GREEN															"SHS"-STANDARD HIGHWAY SIGNS							
		F	VR-921R	30	30			6.25															REPLACE SIGN AND RETAIN SIGN POST.			E-145A			
SB	5.212	G	VR-017	24	30							1	X										SWEENEY LN (TH-15)						
		G	VR-017	24	30			5.00															REPLACE SIGN AND RETAIN SIGN POST.		4				
	5.201	H	R1-1	30	30							1	X										SWEENEY LN (TH-15)						
		H	R1-1	30	30			6.25															REPLACE SIGN AND RETAIN SIGN POST.	X					
SB	5.167	F	M3-3	24	12							1	X																
		F	M1-4	24	12							1																	
		F	M3-3	24	12			2.00															REPLACE BLACK ON WHITE ROUTE MARKERS AND RETAIN SIGN POST.	X					
		F	M1-4	24	12			4.00																	X				
SB	5.125	F	R2-1	24	30							1	X										REPLACE SIGN AND RETAIN SIGN POST.						
		F	R2-1	24	30			5.00																X					
SB	5.028	F	W11-3	30	30							1	X																
		F	W7-3A	24	18							1																	
		F	W11-3	30	30			6.25						1	15.5	X								X					
		F	W7-3A	24	18			3.00																X					
SIGN SUMMARY SHEET							SHEET TOTALS	37.75	0.00	0	0	0	7	0	0	1	15	15.5											
VERMONT AGENCY OF TRANSPORTATION							TOWN DIRECTIONAL TOTALS	206.7	0.0	5.0	1.0	1.0	47	0.0	0.0	21	315.0												
PROJECT NAME: STATEWIDE - SOUTHWEST REGION																					PROJECT NUMBER: STPG SIGN(32)								
FILE NAME: DORSET SB.XLS																					PLOT DATE: 7/13/2010								
PROJECT MANAGER: A. GAMBLE																					DRAWN BY: J. KELLY								
DESIGNED BY: J. KELLY																					CHECKED BY: A. GAMBLE								
DORSET SOUTHBOUND SHEET 2																					SHEET 57 OF 90								

DIRECTION	MILEPOINT	LOCATION CODE (SHEET 2)	SIGN CODE	WIDTH (IN)	HEIGHT (IN)	SHEETING REMARKS	SIGN LEGEND	NEW SIGNS		EXISTING SIGNS				EXIST POST		NUMBER OF NEW POSTS	SQUARE STEEL (IN)			TUBULAR STEEL Ø (IN)				SIGN FRAME REQUIRED	REMARKS	SIGN DETAIL								
								"A"	"B"	RETAIN	SALVAGE FROM	SALVAGE TO	REMOVE	RETAIN	REMOVE		1.75	2.00	2.50	FOUNDATION	3.00	3.50	4.00			5.00	DETAIL IN SHS	DETAIL ON SHEET NUMBER	DETAIL ON STD SHEET NUMBER					
																	(LB / FT)				(LB / FT)													
DORSET US-7							FY-FLUORESCENT YELLOW FYG-FLUORESCENT YELLOW GREEN																"SHS"-STANDARD HIGHWAY SIGNS											
SB	2.175	F	W11-2	30	30	FYG		6.25							1		15.5 X												X					
		F	W16-9P	24	12	FYG		2.00																				X						
SB	2.116	F	R8-3A	24	24																													
		F	VR-644P	24	12																													
		F	VR-644P	24	12			2.00							1		14.25 X													4				
		F	R8-3	24	24			4.00																			X							
SB	2.111	G	VR-017	24	30																													
		H	R1-1	30	30																													
			N/A				TOWN'S STREET NAME SIGN																											
		G	VR-017	24	30			5.00							1		13.75 X															4		
		H	R1-1	30	30			6.25																			X							
SB	2.104	H	R1-1	30	30																													
		H	R1-1	30	30			6.25							1		13.25 X										X							
SB	2.051	F	R8-3A	24	24																													
		F	M4-6P	24	12																													
SIGN SUMMARY SHEET							SHEET TOTALS	31.75	0.00	0	1	1	8	0	0	4		60 56.75																
VERMONT AGENCY OF TRANSPORTATION							TOWN DIRECTIONAL TOTALS	206.7	0.0	5.0	1.0	1.0	47	0.0	0.0	21		315.0																

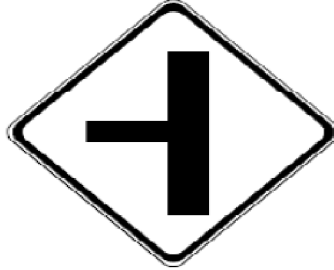

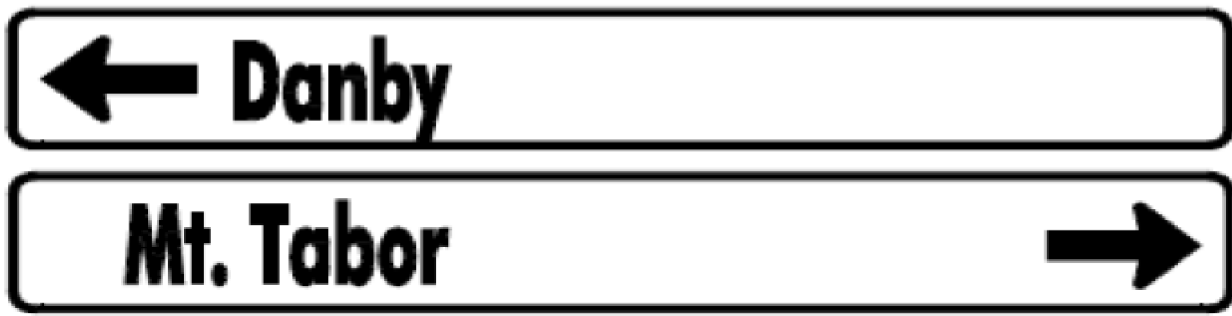
PROJECT NAME: STATEWIDE - SOUTHWEST REGION
PROJECT NUMBER: STPG SIGN(32)
FILE NAME: DORSET SB.XLS PLOT DATE: 7/13/2010
PROJECT MANAGER: A. GAMBLE DRAWN BY: J. KELLY
DESIGNED BY: J. KELLY CHECKED BY: A. GAMBLE
DORSET SOUTHBOUND SHEET 5 SHEET 60 OF 90









DIRECTION	MILEPOINT	LOCATION CODE (SHEET 2)	SIGN CODE	WIDTH (IN)	HEIGHT (IN)	SHEETING REMARKS	SIGN LEGEND	NEW SIGNS		EXISTING SIGNS				EXIST POST		NUMBER OF NEW POSTS	SQUARE STEEL (IN)			TUBULAR STEEL Ø (IN)				SIGN FRAME REQUIRED	REMARKS	SIGN DETAIL			
								"A"	"B"	RETAIN	SALVAGE FROM	SALVAGE TO	REMOVE	RETAIN	REMOVE		1.75	2.00	2.50	3.00	3.50	4.00	5.00			DETAIL IN SHS	DETAIL ON SHEET NUMBER	DETAIL ON STD SHEET NUMBER	
																	(LB / FT)			(LB / FT)									
DORSET US-7							FY-FLUORESCENT YELLOW FYG-FLUORESCENT YELLOW GREEN															"SHS"-STANDARD HIGHWAY SIGNS							
			M1-5	24	24			4.00																			E-136B		
SB	1.779	F	D1-1A	72	10																								
		F	D1-1A	72	10																								
		F	D1-1A	72	10																								
		F	D1-1A	72	10																								
		F	D1-1A	72	12		↑ Arlington 17	6.00						2	15.5	16.75											5		
		F	D1-1A	72	12		↑ Bennington 29	6.00																			5		
		F	D1-1A	72	12		Manchester Ctr 5 ↗	6.00																			5		
		F	D1-1A	72	12		Manchester 6 ↗	6.00																			5		
SIGN SUMMARY SHEET							SHEET TOTALS		28.00	0.00	0	0	0	4	0	0	2	30 32.25							PROJECT NAME: STATEWIDE - SOUTHWEST REGION				
VERMONT AGENCY OF TRANSPORTATION							TOWN DIRECTIONAL TOTALS		206.7	0.0	5.0	1.0	1.0	48	0.0	0.0	21	294.5 315.0							FILE NAME: DORSET SB.XLS	PLOT DATE: 7/13/2010			
																							PROJECT NUMBER: STPG SIGN(32)	PROJECT MANAGER: A. GAMBLE	DRAWN BY: J. KELLY				
																							DESIGNED BY: J. KELLY	CHECKED BY: A. GAMBLE	SHEET 62 OF 90				

DIRECTION	MILEPOINT	LOCATION CODE (SHEET 2)	SIGN CODE	WIDTH (IN)	HEIGHT (IN)	SHEETING REMARKS	SIGN LEGEND	NEW SIGNS		EXISTING SIGNS				EXIST POST		NUMBER OF NEW POSTS	SQUARE STEEL (IN)			TUBULAR STEEL Ø (IN)				SIGN FRAME REQUIRED	REMARKS	SIGN DETAIL				
								"A"	"B"	RETAIN	SALVAGE FROM	SALVAGE TO	REMOVE	RETAIN	REMOVE		1.75	2.00	2.50	3.00	3.50	4.00	5.00			DETAIL IN SHS	DETAIL ON SHEET NUMBER	DETAIL ON STD SHEET NUMBER		
																	(LB / FT)			(LB / FT)										
									1.88	2.42	3.35	FOUNDATION	7.60	9.00	10.80	14.60														
MOUNT TABOR US-7							FY-FLUORESCENT YELLOW FYG-FLUORESCENT YELLOW GREEN																"SHS"-STANDARD HIGHWAY SIGNS							
NB	1.579	A	M3-1	24	12																									
		A	M1-4	24	24																									
		A	M3-1	24	12			2.00																	X		INSTALL NEW BLACK ON WHITE ROUTE MARKERS AND RETAIN SIGN POST.			
		A	M1-4	24	24			4.00																	X					
NB	1.627	A	R2-1	24	30																									
		A	R2-1	24	30			5.00																	X		REPLACE SIGN AND RETAIN SIGN POST.			
NB	1.838	A	W2-2ML	30	30		LEFT SIDE ROAD W/SMALL SIDE																							
	1.915	A	W2-2ML	30	30			6.25						1																6
NB	2.021	A	M3-1	24	12		NORTH																							
		A	M1-4	24	24		US 7																							
NB	2.062	A	R2-1	24	30		SPEED LIMIT 50																							
NB	2.440	A	R2-5A	24	30		REDUCED SPEED AHEAD																							
NB	2.478	A	VD-062B	72	16		BUSINESS SIGN																							
NB	2.525	A	VD-062B	72	16		BUSINESS SIGN																							
NB	2.572	A	VD-062AS	72	16		BUSINESS SIGN																							
SIGN SUMMARY SHEET							SHEET TOTALS	17.25	0.00	3	0	0	8	0	0	1	15													
VERMONT AGENCY OF TRANSPORTATION							TOWN DIRECTIONAL TOTALS	134.1	0.0	7.0	2.0	2.0	29	0.0	0.0	18	270.0													
																		PROJECT NAME:	STATEWIDE - SOUTHWEST REGION											
																		PROJECT NUMBER:	STPG SIGN(32)											
																		FILE NAME:	MOUNT TABOR NB.XLS			PLOT DATE:	8/26/2010							
																		PROJECT MANAGER:	A. GAMBLE			DRAWN BY:	J. KELLY							
																		DESIGNED BY:	J. KELLY			CHECKED BY:	A. GAMBLE							
																		MOUNT TABOR NORTHBOUND SHEET 2									SHEET	64	OF	90

DIRECTION	MILEPOINT	LOCATION CODE (SHEET 2)	SIGN CODE	WIDTH (IN)	HEIGHT (IN)	SHEETING REMARKS	SIGN LEGEND	NEW SIGNS		EXISTING SIGNS			EXIST POST		NUMBER OF NEW POSTS	SQUARE STEEL (IN)			TUBULAR STEEL Ø (IN)				SIGN FRAME REQUIRED	REMARKS	SIGN DETAIL				
								"A"	"B"	RETAIN	SALVAGE FROM	SALVAGE TO	REMOVE	RETAIN		REMOVE	1.75	2.00	2.50	FOUNDATION	3.00	3.50			4.00	5.00	DETAIL IN SHS	DETAIL ON SHEET NUMBER	DETAIL ON STD SHEET NUMBER
																	(LB / FT)				(LB / FT)								
MOUNT TABOR US-7							FY-FLUORESCENT YELLOW FYG-FLUORESCENT YELLOW GREEN															"SHS"-STANDARD HIGHWAY SIGNS							
NB	2.863	A	D1-1	72	10																								
		A	D1-1	72	10																								
		A	D1-1	72	12																								
		A	D1-1	72	12																								
NB	2.931	C	VR-017	24	30																								
		C	VR-017	24	30																								
NB	2.938	D	R1-1	30	30																								
		D	R1-1	30	30																								
			N/A																										
							TOWN'S STREET NAME SIGN			1	1	1																	
NB	2.986	A	M3-1	24	12																								
		A	M1-4	24	24																								
		A	M3-1	24	12																								
		A	M1-4	24	24																								
NB	2.992	A	OM-3R	12	36																								
		A	OM-3R	12	36																								
SIGN SUMMARY SHEET							SHEET TOTALS	32.25	0.00	0	1	1	8	0	0	5													
VERMONT AGENCY OF TRANSPORTATION							TOWN DIRECTIONAL TOTALS	134.1	0.0	7.0	2.0	2.0	29	0.0	0.0	18													



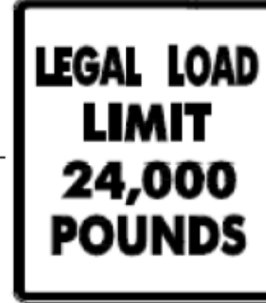



PROJECT NAME: STATEWIDE - SOUTHWEST REGION
PROJECT NUMBER: STPG SIGN(32)
FILE NAME: MOUNT TABOR NB.XLS PLOT DATE: 8/26/2010
PROJECT MANAGER: A. GAMBLE DRAWN BY: J. KELLY
DESIGNED BY: J. KELLY CHECKED BY: A. GAMBLE
MOUNT TABOR NORTHBOUND SHEET 4 SHEET 66 OF 90






DIRECTION	MILEPOINT	LOCATION CODE (SHEET 2)	SIGN CODE	WIDTH (IN)	HEIGHT (IN)	SHEETING REMARKS	SIGN LEGEND	NEW SIGNS		EXISTING SIGNS				EXIST POST		NUMBER OF NEW POSTS	SQUARE STEEL (IN)			TUBULAR STEEL Ø (IN)				SIGN FRAME REQUIRED	REMARKS	SIGN DETAIL		
								"A"	"B"	RETAIN	SALVAGE FROM	SALVAGE TO	REMOVE	RETAIN	REMOVE		1.75	2.00	2.50	FOUNDATION						DETAIL IN SHS	DETAIL ON SHEET NUMBER	DETAIL ON STD SHEET NUMBER
																	(LB / FT)			3.00	3.50	4.00	5.00					
MOUNT TABOR US-7							FY-FLUORESCENT YELLOW FYG-FLUORESCENT YELLOW GREEN																"SHS"-STANDARD HIGHWAY SIGNS					
NB	3.009	B	OM-3L	12	36																							
		B	OM-3L	12	36			3.00										11.0						X				
NB	3.155	A	R2-1	24	30		SPEED LIMIT 50																					
NB	3.180	A	R2-1	24	30		 	5.00											15.5						X			
		B	R2-1	30	36			7.50																		4		
NB	3.180	A	R2-1	24	30					I																		
		B	R2-1	30	36					I																		
NB	3.190	A	R2-1	24	30																							
		B	R2-1	30	36																							
SB	3.180	F	R2-1	30	36																							
		F	R2-1	30	36																							
SB	3.190	F	R2-1	30	36																							
		F	R2-1	30	36																							
SIGN SUMMARY SHEET							SHEET TOTALS	15.50	0.00	0	0	0	0	0	0	0	0	0	0	0	0	0	0	0	PROJECT NAME: STATEWIDE - SOUTHWEST REGION			
								SF	SF	EA	EA	EA	EA	EA	EA	EA	EA	EA	EA	EA	EA	EA	EA	EA	PROJECT NUMBER: STPG SIGN(32)			
VERMONT AGENCY OF TRANSPORTATION							TOWN DIRECTIONAL TOTALS	134.1	0.0	7.0	5.0	5.0	37	0.0	0.0	19	274.0	270.0								FILE NAME: MOUNT TABOR NB.XLS PLOT DATE: 8/26/2010		
																									PROJECT MANAGER: A. GAMBLE DRAWN BY: J. KELLY			
																									DESIGNED BY: J. KELLY CHECKED BY: A. GAMBLE			
																									MOUNT TABOR NORTHBOUND SHEET 5 SHEET 67 OF 90			

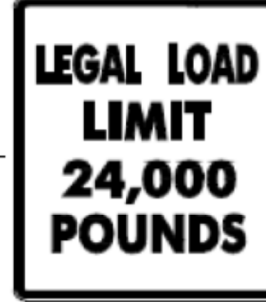

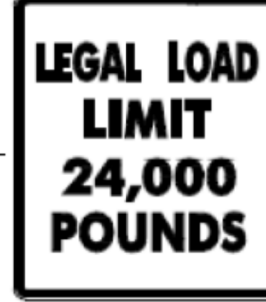




DIRECTION	MILEPOINT	LOCATION CODE (SHEET 2)	SIGN CODE	WIDTH (IN)	HEIGHT (IN)	SHEETING REMARKS	SIGN LEGEND	NEW SIGNS		EXISTING SIGNS				EXIST POST		NUMBER OF NEW POSTS	SQUARE STEEL (IN)			TUBULAR STEEL Ø (IN)				SIGN FRAME REQUIRED	REMARKS	SIGN DETAIL				
								"A"	"B"	RETAIN	SALVAGE FROM	SALVAGE TO	REMOVE	RETAIN	REMOVE		1.75	2.00	2.50	FOUNDATION	3.00	3.50	4.00			5.00	DETAIL IN SHS	DETAIL ON SHEET NUMBER	DETAIL ON STD SHEET NUMBER	
																	(LB / FT)				(LB / FT)									
MOUNT TABOR US-7							FY-FLUORESCENT YELLOW FYG-FLUORESCENT YELLOW GREEN																"SHS"-STANDARD HIGHWAY SIGNS							
SB	2.733	F	M3-3	24	12																									
		F	M1-4	24	24																									
		F	M3-3	24	12			2.00										15.5								X				
		F	M1-4	24	24			4.00																	X					
SB	2.620	F	R2-1	24	30		 	5.00										15.0							X			INSTALL 60 FEET NORTH OF EXISTING AND DIRECTLY ACROSS FROM THE NEW NB SL-45 SIGN ASSEMBLY.		
		E	R2-1	30	36			7.50																				4		
SB	2.609	F	R2-1	24	30																							REMOVE 2.60 MM SIGN.		
SB	2.102	F	W2-2RM	30	30		RIGHT SIDE ROAD W/SMALL SIDE 																							
	2.032	F	W2-2RM	30	30		 	6.25											15.5										6	
SB	1.977	G	VR-017	24	30			5.00																					4	
SB	1.966	H	R1-1	30	30																									
		H	R1-1	30	30			6.25																	X					
		N/A					TOWN'S STREET NAME SIGN				1	1	1																	
SB	1.850	G	VR-023B	24	30		\$500 FINE FOR THROWING TRASH ON HIGHWAYS																							
SB	1.642	F	W10-3L	36	36		LEFT SIDE ROAD W/TRACKS																							
SIGN SUMMARY SHEET							SHEET TOTALS	36.00	0.00	1	1	1	7	0	0	5														
VERMONT AGENCY OF TRANSPORTATION							TOWN DIRECTIONAL TOTALS	173.3	0.0	7.0	2.0	2.0	32	0.0	0.0	17														
								SF	SF	EA	EA	EA	EA	EA	EA	EA														









PROJECT NAME: STATEWIDE - SOUTHWEST REGION
PROJECT NUMBER: STPG SIGN(32)
FILE NAME: MOUNT TABOR SB.XLS
PROJECT MANAGER: A. GAMBLE
DESIGNED BY: J. KELLY
MOUNT TABOR SOUTHBOUND SHEET 3





PLOT DATE: 8/26/2010
DRAWN BY: J. KELLY
CHECKED BY: A. GAMBLE
SHEET 70 OF 90




DIRECTION	MILEPOINT	LOCATION CODE (SHEET 2)	SIGN CODE	WIDTH (IN)	HEIGHT (IN)	SHEETING REMARKS	SIGN LEGEND	NEW SIGNS		EXISTING SIGNS				EXIST POST		NUMBER OF NEW POSTS	SQUARE STEEL (IN)			TUBULAR STEEL Ø (IN)				SIGN FRAME REQUIRED	REMARKS	SIGN DETAIL			
								"A"	"B"	RETAIN	SALVAGE FROM	SALVAGE TO	REMOVE	RETAIN	REMOVE		1.75	2.00	2.50	FOUNDATION	3.00	3.50	4.00			5.00	DETAIL IN SHS	DETAIL ON SHEET NUMBER	DETAIL ON STD SHEET NUMBER
																	(LB / FT)				(LB / FT)								
MOUNT TABOR US-7							FY-FLUORESCENT YELLOW FYG-FLUORESCENT YELLOW GREEN																"SHS"-STANDARD HIGHWAY SIGNS						
SB	1.283	G	VR-017	24	30																								
		G	VR-017	24	30			5.00																		4			
SB	1.286	H	R1-1	30	30																								
		H	R1-1	30	30			6.25																	X				
SB	1.224	G	VR-017	24	30																								
		G	VR-017	24	30			5.00																		4			
SB	1.215	H	R1-1	30	30																								
		H	R1-1	30	30			6.25																	X				
SB	1.206	F	M3-3	24	12		SOUTH																						
SB	1.157	F	R2-1	24	30																								
		F	R2-1	24	30			5.00																	X				
SB	0.970	F	W10-2L	36	36		CROSSROAD W/TRACKS LEFT			1																			
SB	0.901	F	VD-062B	72	16		BUSINESS SIGN			1																			
SB	0.834	G	VR-017	24	30																								
		G	VR-017	24	30			5.00																		4			
SIGN SUMMARY SHEET							SHEET TOTALS	32.50	0.00	2	0	0	7	0	0	0	0								PROJECT NAME: STATEWIDE - SOUTHWEST REGION				
VERMONT AGENCY OF TRANSPORTATION							TOWN DIRECTIONAL TOTALS	173.3	0.0	7.0	2.0	2.0	32	0.0	0.0	17	255.0								PROJECT NUMBER: STPG SIGN(32)				
								SF	SF	EA	EA	EA	EA	EA	EA	EA	FT								FILE NAME: MOUNT TABOR SB.XLS				
																									PLOT DATE: 8/26/2010				
																									DRAWN BY: J. KELLY				
																									DESIGNED BY: J. KELLY				
																									CHECKED BY: A. GAMBLE				
																									MOUNT TABOR SOUTHBOUND SHEET 4				
																									SHEET 71 OF 90				






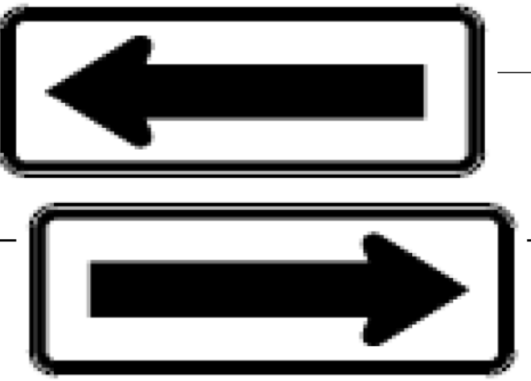

DIRECTION	MILEPOINT	LOCATION CODE (SHEET 2)	SIGN CODE	WIDTH (IN)	HEIGHT (IN)	SHEETING REMARKS	SIGN LEGEND	NEW SIGNS		EXISTING SIGNS			EXIST POST		NUMBER OF NEW POSTS	SQUARE STEEL (IN)			TUBULAR STEEL Ø (IN)				SIGN FRAME REQUIRED	REMARKS	SIGN DETAIL			
								"A"	"B"	RETAIN	SALVAGE FROM	SALVAGE TO	REMOVE	RETAIN		REMOVE	1.75	2.00	2.50	3.00	3.50	4.00			5.00	DETAIL IN SHS	DETAIL ON SHEET NUMBER	DETAIL ON STD SHEET NUMBER
																	(LB / FT)			(LB / FT)								
MOUNT TABOR US-7							FY-FLUORESCENT YELLOW FYG-FLUORESCENT YELLOW GREEN																"SHS"-STANDARD HIGHWAY SIGNS					
SB	0.826	H	R1-1	30	30																							
		H	R1-1	30	30			6.25																X				
SB	0.719	G	VR-017	24	30																							
		G	VR-017	24	30			5.00							1	15.5	X								4			
		G	N/A	18	24		TOWN'S SPEED LIMIT 30 SIGN			1	1	I																
SB	0.713	H	R1-1	30	30																							
		H	R1-1	30	30			6.25							1	13.5	X							X				
SB	0.677	F	M3-3	24	12																							
		F	M1-4	24	24																							
		F	M3-3	24	12			2.00																X				
		F	M1-4	24	24			4.00																X				
SB	0.633	F	R2-1	24	30																							
		F	R2-1	24	30			5.00																X				
SB	3.025	F	DI-I	72	12		DANBY →	6.00																				
SB	1.224	G	VR-017	24	30		LLL	—			I	I	I				14.25	X										
SIGN SUMMARY SHEET							SHEET TOTALS	34.50 28.50	0.00	0	2 4	2 4	9 6	0	0	3 2	30-43.25							PROJECT NAME: STATEWIDE - SOUTHWEST REGION				
								SF	SF	EA	EA	EA	EA	EA	EA	EA	FT							PROJECT NUMBER: STPG SIGN(32)				
VERMONT AGENCY OF TRANSPORTATION							TOWN DIRECTIONAL TOTALS	179.25 173.3	0.0	7.0	5.0 2.0	5.0 2.0	38 32	0.0	0.0	19 17	274.0 266.0							FILE NAME: MOUNT TABOR SB.XLS	PLOT DATE: 8/26/2010			
																								DESIGNED BY: J. KELLY	CHECKED BY: A. GAMBLE	DRAWN BY: J. KELLY	SHEET 72 OF 90	

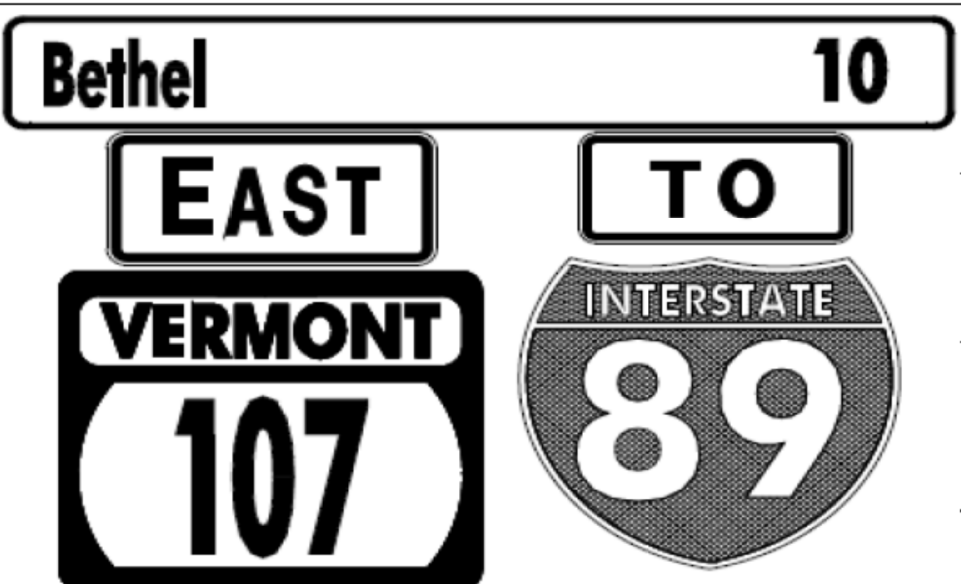




DIRECTION	MILEPOINT	LOCATION CODE (SHEET 2)	SIGN CODE	WIDTH (IN)	HEIGHT (IN)	SHEETING REMARKS	SIGN LEGEND	NEW SIGNS		EXISTING SIGNS				EXIST POST		NUMBER OF NEW POSTS	SQUARE STEEL (IN)			TUBULAR STEEL Ø (IN)				SIGN FRAME REQUIRED	REMARKS	SIGN DETAIL		
								"A"	"B"	RETAIN	SALVAGE FROM	SALVAGE TO	REMOVE	RETAIN	REMOVE		1.75	2.00	2.50	3.00	3.50	4.00	5.00			DETAIL IN SHS	DETAIL ON SHEET NUMBER	DETAIL ON STD SHEET NUMBER
																	(LB / FT)			(LB / FT)								
DANBY US-7							FY-FLUORESCENT YELLOW FYG-FLUORESCENT YELLOW GREEN															"SHS"-STANDARD HIGHWAY SIGNS						
NB	0.000	C	VD-024	60	7.5																							
		C	VD-024	72	10		Danby	Mt. Tabor																	4			
		C	VD-700	6	10				5.00														INSTALL ON LH POST BELOW DANBY		E-138			
		C	VD-700	6	10				0.42														INSTALL ON RH POST BELOW MT. TABOR		E-138			
NB	0.600	A	VW-619	36	36				9.00														INSTALL AT 0.60 MILE MARKER.		6			
NB	0.700	A	VW-205	36	36				9.00														INSTALL 525 FEET NORTH OF NEW SHOULDER NARROWS SIGN		6			
NB	1.260	B	VW-205	48	48		WATCH FOR TURNING VEHICLES																REMOVE 0125 MILE MARKER					
NB	1.577	A	M3-1	24	12																							
		A	M1-4	18	18																							
		A	M3-1	24	12				2.00															X				
		A	M1-4	18	18				4.00														REPLACE BLACK ON WHITE ROUTE MARKERS AND RETAIN SIGN POST.	X				
NB	1.663	A	R2-1	24	30																							
		A	R2-1	24	30				5.00														REPLACE SIGN AND RETAIN SIGN POST.	X				
NB	2.088	A	VW-081L	30	30																							
		A	VW-081L	30	30				6.25																6			
SIGN SUMMARY SHEET							SHEET TOTALS				41.09	0.00	0	0	0	8 6	0	0	7	405	100.75							
VERMONT AGENCY OF TRANSPORTATION							TOWN DIRECTIONAL TOTALS				50.1	0.0	0.0	0.0	0.0	7	0.0	0.0	9	135.0								
																	PROJECT NAME: STATEWIDE - SOUTHWEST REGION			PROJECT NUMBER: STPG SIGN(32)								
																	FILE NAME: DANBY NB.XLS			PLOT DATE: 7/13/2010								
																	PROJECT MANAGER: A. GAMBLE			DRAWN BY: J. KELLY								
																	DESIGNED BY: J. KELLY			CHECKED BY: A. GAMBLE								
																	DANBY NORTHBOUND SHEET 1			SHEET 73 OF 90								







DIRECTION	MILEPOINT	LOCATION CODE (SHEET 2)	SIGN CODE	WIDTH (IN)	HEIGHT (IN)	SHEETING REMARKS	SIGN LEGEND	NEW SIGNS		EXISTING SIGNS				EXIST POST		NUMBER OF NEW POSTS	SQUARE STEEL (IN)			TUBULAR STEEL Ø (IN)				SIGN FRAME REQUIRED	REMARKS	SIGN DETAIL			
								"A"	"B"	RETAIN	SALVAGE FROM	SALVAGE TO	REMOVE	RETAIN	REMOVE		1.75	2.00	2.50	FOUNDATION	3.00	3.50	4.00			5.00	DETAIL IN SHS	DETAIL ON SHEET NUMBER	DETAIL ON STD SHEET NUMBER
																	(LB / FT)				(LB / FT)								
DANBY US-7							FY-FLUORESCENT YELLOW FYG-FLUORESCENT YELLOW GREEN																"SHS"-STANDARD HIGHWAY SIGNS						
SB	2.355	F	VW-081R	30	30																								
		F	VW-081R	30	30			6.25																		6			
SB	1.785	F	R2-1	24	30			5.00																		X			
SB	1.445	G	VR-017	24	30																								
		G	VR-017	24	30			5.00																		4			
SB	1.437	H	R1-1	30	30																								
		H	R1-1	30	30			6.25																		X			
SB	1.253	F	VW-205	48	48																								
		F	VW-205	36	36			9.00																		6			
SB	1.044	G	VR-017	24	30																								
		G	VR-017	24	30			5.00																		4			
SB	1.025	H	R1-1	30	30																								
		H	R1-1	30	30			6.25																		X			
SB	1.014	F	M3-3	24	12																								
			M1-4	24	24																								
SIGN SUMMARY SHEET							SHEET TOTALS		42.75	0.00	0	0	0	8	0	0	8								PROJECT NAME: STATEWIDE - SOUTHWEST REGION				
							SF	SF	EA	EA	EA	EA	EA	EA	EA	EA	EA								PROJECT NUMBER: STPG SIGN(32)				
VERMONT AGENCY OF TRANSPORTATION							TOWN DIRECTIONAL TOTALS		65.0	0.0	0.0	0.0	0.0	11	0.0	0.0	12									FILE NAME: DANBY SB.XLS			
																									PLOT DATE: 7/13/2010				
																									DRAWN BY: J. KELLY				
																									CHECKED BY: A. GAMBLE				
																									SHEET 75 OF 90				





DIRECTION	MILEPOINT	LOCATION CODE (SHEET 2)	SIGN CODE	WIDTH (IN)	HEIGHT (IN)	SHEETING REMARKS	SIGN LEGEND	NEW SIGNS		EXISTING SIGNS				EXIST POST		NUMBER OF NEW POSTS	SQUARE STEEL (IN)			TUBULAR STEEL Ø (IN)				SIGN FRAME REQUIRED	REMARKS	SIGN DETAIL				
								"A"	"B"	RETAIN	SALVAGE FROM	SALVAGE TO	REMOVE	RETAIN	REMOVE		1.75	2.00	2.50	FOUNDATION						DETAIL IN SHS	DETAIL ON SHEET NUMBER	DETAIL ON STD SHEET NUMBER		
																	(LB / FT)			3.00	3.50	4.00	5.00						(LB / FT)	
DANBY US-7							FY-FLUORESCENT YELLOW FYG-FLUORESCENT YELLOW GREEN																"SHS"-STANDARD HIGHWAY SIGNS							
			M3-3	24	12			2.00								1	14.0	X							BLACK ON WHITE ROUTE MARKERS	X				
			M1-4	24	24			4.00																		X				
SB	0.942	F	R2-1	24	30							1			X															
SB	0.910	F	R2-1	24	30			5.00								1	14.25	X							INSTALL 160 FEET SOUTH OF EXISTING SPEED LIMIT 50 SIGN.	X				
SB	0.432	G	VR-017	24	30							1			X															
			G	VR-017	24	30			5.00							1	13.25	X										4		
SB	0.422	H	R1-1	30	30							1			X															
			H	R1-1	30	30			6.25							1	13.25	X									X			
SIGN SUMMARY SHEET							SHEET TOTALS	22.25	0.00	0	0	0	3	0	0	4	60 54.75											PROJECT NAME: STATEWIDE - SOUTHWEST REGION		
VERMONT AGENCY OF TRANSPORTATION							TOWN DIRECTIONAL TOTALS	65.0	0.0	0.0	0.0	0.0	11	0.0	0.0	12	165.25 180.0											PROJECT NUMBER: STPG SIGN(32)		
								SF	SF	EA	EA	EA	EA	EA	EA	EA	FT										FILE NAME: DANBY SB.XLS	PLOT DATE: 7/13/2010		
																											PROJECT MANAGER: A. GAMBLE	DRAWN BY: J. KELLY		
																											DESIGNED BY: J. KELLY	CHECKED BY: A. GAMBLE		
																											DANBY SOUTHBOUND SHEET 2	SHEET 76 OF 90		

DIRECTION	MILEPOINT	LOCATION CODE (SHEET 2)	SIGN CODE	WIDTH (IN)	HEIGHT (IN)	SHEETING REMARKS	SIGN LEGEND	NEW SIGNS		EXISTING SIGNS				EXIST POST		NUMBER OF NEW POSTS	SQUARE STEEL (IN)			TUBULAR STEEL Ø (IN)				SIGN FRAME REQUIRED	REMARKS	SIGN DETAIL		
								"A"	"B"	RETAIN	SALVAGE FROM	SALVAGE TO	REMOVE	RETAIN	REMOVE		1.75	2.00	2.50	FOUNDATION						DETAIL IN SHS	DETAIL ON SHEET NUMBER	DETAIL ON STD SHEET NUMBER
																	(LB / FT)			3.00	3.50	4.00	5.00					
STOCKBRIDGE VT-107							FY-FLUORESCENT YELLOW FYG-FLUORESCENT YELLOW GREEN																"SHS"-STANDARD HIGHWAY SIGNS					
EB	0.055	A	D2-1	72	10																							
			M3-2	24	12																							
			M1-5A	30	24																							
			M4-5I	24	12																							
			M1-1	24	24																							
			D2-1	72	12																							
			M3-2	24	12																							
			M1-5	30	24																							
			M4-5	24	12																							
			M1-1	24	24																							
EB	0.110	A	R2-1	24	30																							
		A	R2-1	24	30																							
EB	0.207	A	VW-619	30	30																							
		A	VW-619	36	36																							
EB	0.265	A	VD-062B	72	16		BUSINESS SIGN			1																		
SIGN SUMMARY SHEET							SHEET TOTALS		33.00	0.00	1	0	0	7	0	0	5	-75-78.25			PROJECT NAME: STATEWIDE - SOUTHWEST REGION							
VERMONT AGENCY OF TRANSPORTATION							TOWN DIRECTIONAL TOTALS		131.8	0.0	24.0	1.0	1.0	23	0.0	0.0	19	285.0			PROJECT NUMBER: STPG SIGN(32)							
																						FILE NAME: STOCKBRIDGE EB.XLS						
																						PLOT DATE: 7/13/2010						
																						DRAWN BY: J. KELLY						
																						DESIGNED BY: J. KELLY						
																						CHECKED BY: A. GAMBLE						
																						STOCKBRIDGE EASTBOUND SHEET 1						
																						SHEET 77 OF 90						


DIRECTION	MILEPOINT	LOCATION CODE (SHEET 2)	SIGN CODE	WIDTH (IN)	HEIGHT (IN)	SHEETING REMARKS	SIGN LEGEND	NEW SIGNS		EXISTING SIGNS				EXIST POST		NUMBER OF NEW POSTS	SQUARE STEEL (IN)			TUBULAR STEEL Ø (IN)				SIGN FRAME REQUIRED	REMARKS	SIGN DETAIL			
								"A"	"B"	RETAIN	SALVAGE FROM	SALVAGE TO	REMOVE	RETAIN	REMOVE		1.75	2.00	2.50	FOUNDATION	3.00	3.50	4.00			5.00	DETAIL IN SHS	DETAIL ON SHEET NUMBER	DETAIL ON STD SHEET NUMBER
																	(LB / FT)				(LB / FT)								
STOCKBRIDGE VT-107							FY-FLUORESCENT YELLOW FYG-FLUORESCENT YELLOW GREEN																"SHS"-STANDARD HIGHWAY SIGNS						
EB	4.240	A	S3-1	30	30																								
EB	5.085	A	VW-619	30	30																								
		A	VW-619	36	36			9.00							2			15.0 15.5 X								6			
EB	5.148	A	VW-054R	30	30																								
		A	VW-054R	30	30			6.25							1			15.0 X								6			
EB	5.426	A	W1-4L	30	30		LEFT REVERSE CURVE																						
EB	5.485	A	W1-4L	30	30			6.25							1			15.0 X							X				
EB	6.460	A	W1-2L	30	30	FY		6.25							1			15.5 X							X				
		A	W13-1	18	18	FY		2.25																	X				
EB	6.524	A	W1-6	48	24																								
		B	W1-6	48	24																								
		A	W1-6	48	24	FY		8.00							2			13.25 13.0 X							X				
		B	W1-6	48	24	FY		8.00																	X				
WB	0.490	F	VW-054R	30	30			6.25							1			14.5 X											
SIGN SUMMARY SHEET							SHEET TOTALS		52.25 46.00	0.00	0	0	0	6	0	0	8		405.16.75				PROJECT NAME: STATEWIDE - SOUTHWEST REGION PROJECT NUMBER: STPG SIGN(32)						
VERMONT AGENCY OF TRANSPORTATION							TOWN DIRECTIONAL TOTALS		138 131.8	0.0	24.0	1.0	1.0	24 23	0.0	0.0	20 19		295.0 286.0				FILE NAME: STOCKBRIDGE EB.XLS PLOT DATE: 7/13/2010 PROJECT MANAGER: A. GAMBLE DRAWN BY: J. KELLY DESIGNED BY: J. KELLY CHECKED BY: A. GAMBLE STOCKBRIDGE EASTBOUND SHEET 5 SHEET 81 OF 90						

DIRECTION	MILEPOINT	LOCATION CODE (SHEET 2)	SIGN CODE	WIDTH (IN)	HEIGHT (IN)	SHEETING REMARKS	SIGN LEGEND	NEW SIGNS		EXISTING SIGNS				EXIST POST		NUMBER OF NEW POSTS	SQUARE STEEL (IN)			TUBULAR STEEL Ø (IN)				SIGN FRAME REQUIRED	REMARKS	SIGN DETAIL			
								"A"	"B"	RETAIN	SALVAGE FROM	SALVAGE TO	REMOVE	RETAIN	REMOVE		1.75	2.00	2.50	FOUNDATION	3.00	3.50	4.00			5.00	DETAIL IN SHS	DETAIL ON SHEET NUMBER	DETAIL ON STD SHEET NUMBER
																	(LB / FT)				(LB / FT)								
STOCKBRIDGE VT-107							FY-FLUORESCENT YELLOW FYG-FLUORESCENT YELLOW GREEN																"SHS"-STANDARD HIGHWAY SIGNS						
WB	6.625	F	W1-2R	30	30		 																						
		F	W13-1	18	18																								
		F	W1-2R	30	30	FY			6.25																X				
		F	W13-1	18	18	FY			2.25																X				
WB	6.050	F	W1-4L	30	30		LEFT REVERSE CURVE																						
																													
WB	5.955	F	W1-4L	30	30				6.25																X				
WB	4.563	F	S3-1	30	30		SCHOOL BUS STOP AHEAD																						
WB	4.490	F	VD-062B	72	16		BUSINESS SIGN			1																			
		F	VD-062AS	72	16		BUSINESS SIGN			1																			
WB	4.407	G	VR-017	24	30																								
		G	VR-017	24	30				5.00																			4	
WB	4.396	H	R1-1	30	30																								
		H	R1-1	30	30				6.25																X				
WB	4.320	F	VW-619	30	30		SHOULDER NARROWS																						
WB	4.203	F	W1-2L	30	30		MODIFIED LEFT CURVE																						
SIGN SUMMARY SHEET							SHEET TOTALS		26.00	0.00	2	0	0	8	0	0	2								PROJECT NAME: STATEWIDE - SOUTHWEST REGION				
									SF	SF	EA	EA	EA	EA	EA	EA	EA								PROJECT NUMBER: STPG SIGN(32)				
VERMONT AGENCY OF TRANSPORTATION							TOWN DIRECTIONAL TOTALS		151.3	0.0	22.0	0.0	0.0	35	0.0	0.0	20	300.0							FILE NAME: STOCKBRIDGE WB.XLS				
																									PLOT DATE: 7/13/2010				
																									DRAWN BY: J. KELLY				
																									CHECKED BY: A. GAMBLE				
																									DESIGNED BY: J. KELLY				
																									STOCKBRIDGE WESTBOUND SHEET 1				
																									SHEET 82 OF 90				

DIRECTION	MILEPOINT	LOCATION CODE (SHEET 2)	SIGN CODE	WIDTH (IN)	HEIGHT (IN)	SHEETING REMARKS	SIGN LEGEND	NEW SIGNS		EXISTING SIGNS				EXIST POST		NUMBER OF NEW POSTS	SQUARE STEEL (IN)			TUBULAR STEEL Ø (IN)				SIGN FRAME REQUIRED	REMARKS	SIGN DETAIL			
								"A"	"B"	RETAIN	SALVAGE FROM	SALVAGE TO	REMOVE	RETAIN	REMOVE		1.75	2.00	2.50	FOUNDATION	3.00	3.50	4.00			5.00	DETAIL IN SHS	DETAIL ON SHEET NUMBER	DETAIL ON STD SHEET NUMBER
																	(LB / FT)				(LB / FT)								
STOCKBRIDGE VT-107							FY-FLUORESCENT YELLOW FYG-FLUORESCENT YELLOW GREEN															"SHS"-STANDARD HIGHWAY SIGNS							
WB	2.650	H	R1-1	30	30																								
		H	R1-1	30	30			6.25															X						
WB	2.646	F	W1-2MR	30	30		MODIFIED RIGHT CURVE																						
		F	W13-1	18	18		40 MPH ADVISORY																						
WB	2.635	F	W8-5	30	30			6.25															X						
		F	W7-3A	24	18			3.00															X						
WB	2.570	F	W8-5	30	30		SLIPPERY WHEN WET SYMBOL																						
		F	W7-3A	24	18		NEXT 2 MILES																						
		F	W1-10R	36	36			9.00															X						
		F	W13-1	18	18			2.25															X						
WB	2.542	F	M3-4	24	12		WEST																						
		F	M1-5A	30	24		ROUTE 107																						
WB	2.483	F	M3-4	24	12			2.00																	E-136B				
		F	M1-5A	30	24			5.00																	E-136B				
WB	2.450	F	R2-1	24	30																								
SIGN SUMMARY SHEET							SHEET TOTALS	33.75	0.00	0	0	0	8	0	0	5	75 75.75						PROJECT NAME: STATEWIDE - SOUTHWEST REGION						
VERMONT AGENCY OF TRANSPORTATION							TOWN DIRECTIONAL TOTALS	151.3	0.0	22.0	0.0	0.0	35	0.0	0.0	20	300.0						PROJECT NUMBER: STPG SIGN(32)						
								SF	SF	EA	EA	EA	EA	EA	EA	EA	FT						FILE NAME: STOCKBRIDGE WB.XLS	PLOT DATE: 7/13/2010					
																							PROJECT MANAGER: A. GAMBLE	DRAWN BY: J. KELLY					
																							DESIGNED BY: J. KELLY	CHECKED BY: A. GAMBLE					
																							STOCKBRIDGE WESTBOUND SHEET 4	SHEET 85 OF 90					

DIRECTION	MILEPOINT	LOCATION CODE (SHEET 2)	SIGN CODE	WIDTH (IN)	HEIGHT (IN)	SHEETING REMARKS	SIGN LEGEND	NEW SIGNS		EXISTING SIGNS				EXIST POST		NUMBER OF NEW POSTS	SQUARE STEEL (IN)			TUBULAR STEEL Ø (IN)				SIGN FRAME REQUIRED	REMARKS	SIGN DETAIL		
								"A"	"B"	RETAIN	SALVAGE FROM	SALVAGE TO	REMOVE	RETAIN	REMOVE		1.75	2.00	2.50	FOUNDATION						DETAIL IN SHS	DETAIL ON SHEET NUMBER	DETAIL ON STD SHEET NUMBER
																	(LB / FT)			3.00	3.50	4.00	5.00					
STOCKBRIDGE VT-107							FY-FLUORESCENT YELLOW FYG-FLUORESCENT YELLOW GREEN																"SHS"-STANDARD HIGHWAY SIGNS					
			F	R2-1	24	30		5.00																	X			
WB	1.330		F	W1-5L	30	30																						
WB	1.235		F	W1-2L	30	30		6.25																	X		INSTALL 500 FEET WEST OF WINDING ROAD SIGN ASSEMBLY.	
WB	0.963		F	W1-4R	30	30	RIGHT REVERSE CURVE																					
WB	0.834		F	VD-062B	72	16	BUSINESS SIGN			1																		
WB	0.161		F	M2-1	21	15																						
			F	M1-5A	30	24																						
			F	M4-6	24	12																						
			F	M1-5A	30	24																						
			F	M2-1	21	15		2.19															#1B		7	E-136B		
			F	M1-5	30	24		5.00																		E-136B		
			F	M4-6	24	12		2.00																X				
			F	M1-5	30	24		5.00																		E-136B		
WB	0.112		F	D1-1A	72	10	<--- (45 DEG) PITTSFIELD 3			1																		
			F	D1-1A	72	10	<--- (45 DEG) KILLINGTON 11			1																		
SIGN SUMMARY SHEET							SHEET TOTALS		25.44	0.00	3	0	0	6	0	0	2											
VERMONT AGENCY OF TRANSPORTATION									SF	SF	EA	EA	EA	EA	EA	EA	EA											
TOWN DIRECTIONAL TOTALS							151.3	0.0	22.0	0.0	0.0	35	0.0	0.0	20			300.0										
																	PROJECT NAME: STATEWIDE - SOUTHWEST REGION											
																	PROJECT NUMBER: STPG SIGN(32)											
																	FILE NAME: STOCKBRIDGE WB.XLS	PLOT DATE: 7/13/2010										
																	PROJECT MANAGER: A. GAMBLE	DRAWN BY: J. KELLY										
																	DESIGNED BY: J. KELLY	CHECKED BY: A. GAMBLE										
																	STOCKBRIDGE WESTBOUND SHEET 5	SHEET 86	OF	90								

DIRECTION	MILEPOINT	LOCATION CODE (SHEET 2)	SIGN CODE	WIDTH (IN)	HEIGHT (IN)	SHEETING REMARKS	SIGN LEGEND	NEW SIGNS		EXISTING SIGNS				EXIST POST		NUMBER OF NEW POSTS	SQUARE STEEL (IN)			TUBULAR STEEL Ø (IN)				SIGN FRAME REQUIRED	REMARKS	SIGN DETAIL									
								"A"	"B"	RETAIN	SALVAGE FROM	SALVAGE TO	REMOVE	RETAIN	REMOVE		1.75	2.00	2.50	FOUNDATION	3.00	3.50	4.00			5.00	DETAIL IN SHS	DETAIL ON SHEET NUMBER	DETAIL ON STD SHEET NUMBER						
																	(LB / FT)				(LB / FT)														
STOCKBRIDGE VT-107							FY-FLUORESCENT YELLOW FYG-FLUORESCENT YELLOW GREEN																"SHS"-STANDARD HIGHWAY SIGNS												
		F	D1-1A	72	10		<--- (45 DEG) RUTLAND 22			1																									
		F	D1-1A	72	10		ROCHESTER 9 --->			1																									
WB	0.059	F	M3-3	24	12							1																							
		F	M1-5A	30	24							1																							
		F	M6-3	21	15		UP ARROW					1																							
		F	M3-1	24	12							1																							
		F	M1-5A	30	24							1																							
		F	M6-1	21	15							1																							
		F	M3-3	24	12									2			17.0 17.25 X						#2B			7	E-136B								
		F	M1-5	30	24																														
		F	M6-2L	21	15																														
		F	M3-1	24	12																														
		F	M1-5	30	24																														
		F	M6-1	21	15																														
SIGN SUMMARY SHEET							SHEET TOTALS											PROJECT NAME: STATEWIDE - SOUTHWEST REGION PROJECT NUMBER: STPG SIGN(32)																	
VERMONT AGENCY OF TRANSPORTATION							18.38	0.00	2	0	0	6	0	0	2																				
							SF	SF	EA	EA	EA	EA	EA	EA	EA																				
TOWN DIRECTIONAL TOTALS							151.3	0.0	22.0	0.0	0.0	35	0.0	0.0	20																				

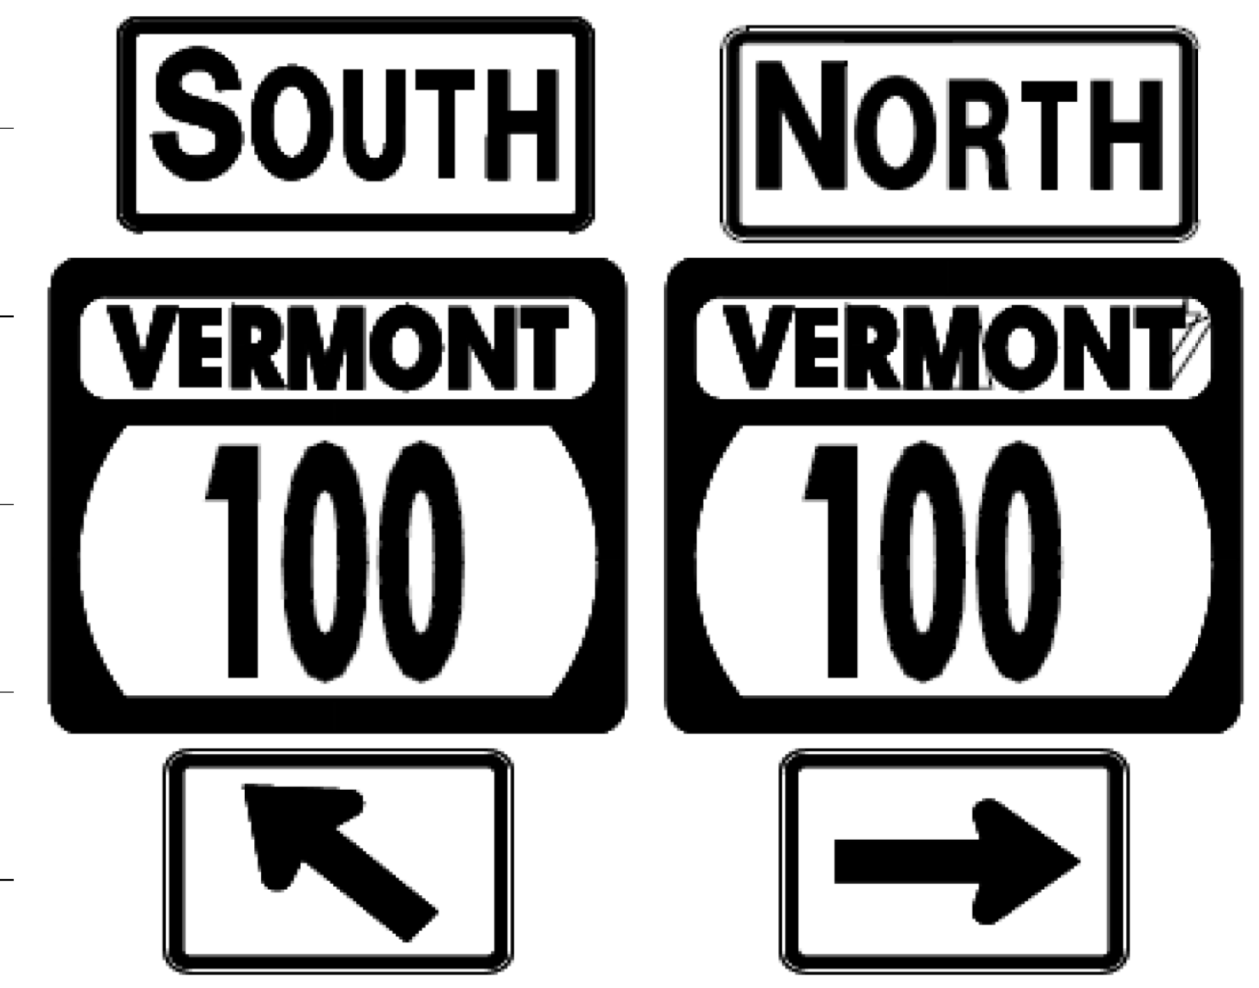

PROJECT NAME: STATEWIDE - SOUTHWEST REGION
 PROJECT NUMBER: STPG SIGN(32)
 FILE NAME: STOCKBRIDGE WB.XLS
 PROJECT MANAGER: A. GAMBLE
 DESIGNED BY: J. KELLY
 STOCKBRIDGE WESTBOUND SHEET 6
 PLOT DATE: 7/13/2010
 DRAWN BY: J. KELLY
 CHECKED BY: A. GAMBLE
 SHEET 87 OF 90

Table 6H-2. Meaning of Symbols on Typical Application Diagrams

	Arrow panel
	Arrow panel support or trailer (shown facing down)
	Changeable message sign or support trailer
	Channelizing device
	Crash Cushion
	Direction of temporary traffic detour
	Direction of traffic
	Flagger
	High level warning device (Flag tree)
	Luminaire
	Pavement markings that should be removed for a long term project
	Sign (shown facing left)
	Surveyor
	Temporary barrier
	Temporary barrier with warning lights
	Traffic or Pedestrian signal
	Truck mounted attenuator
	Type III Barricade
	Warning lights
	Work space
	Work vehicle

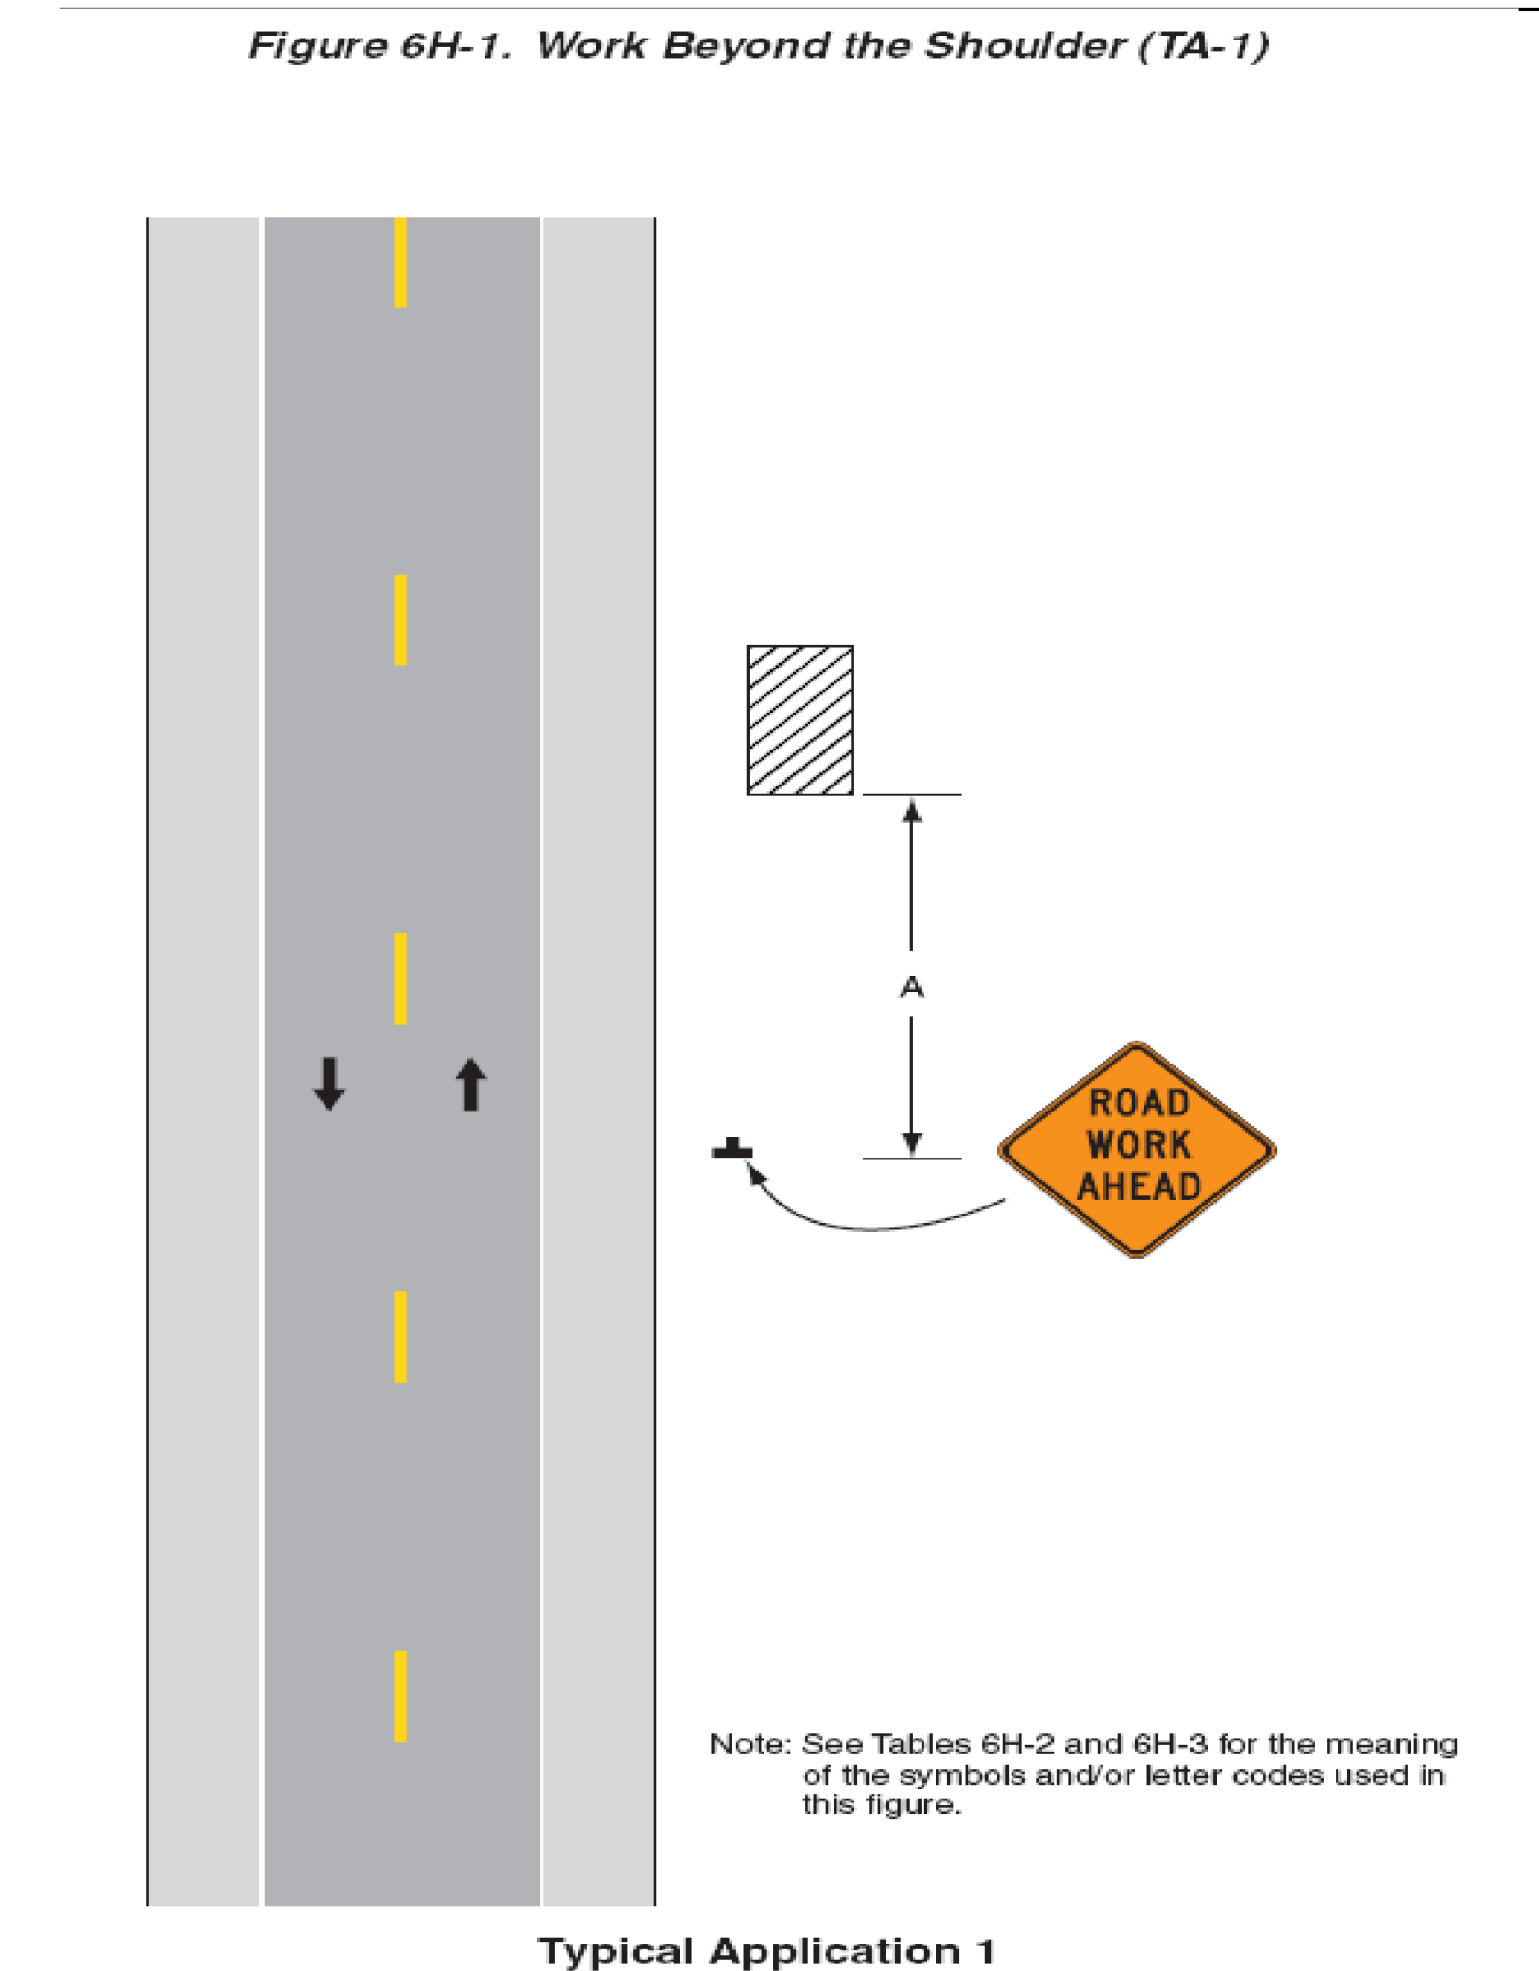
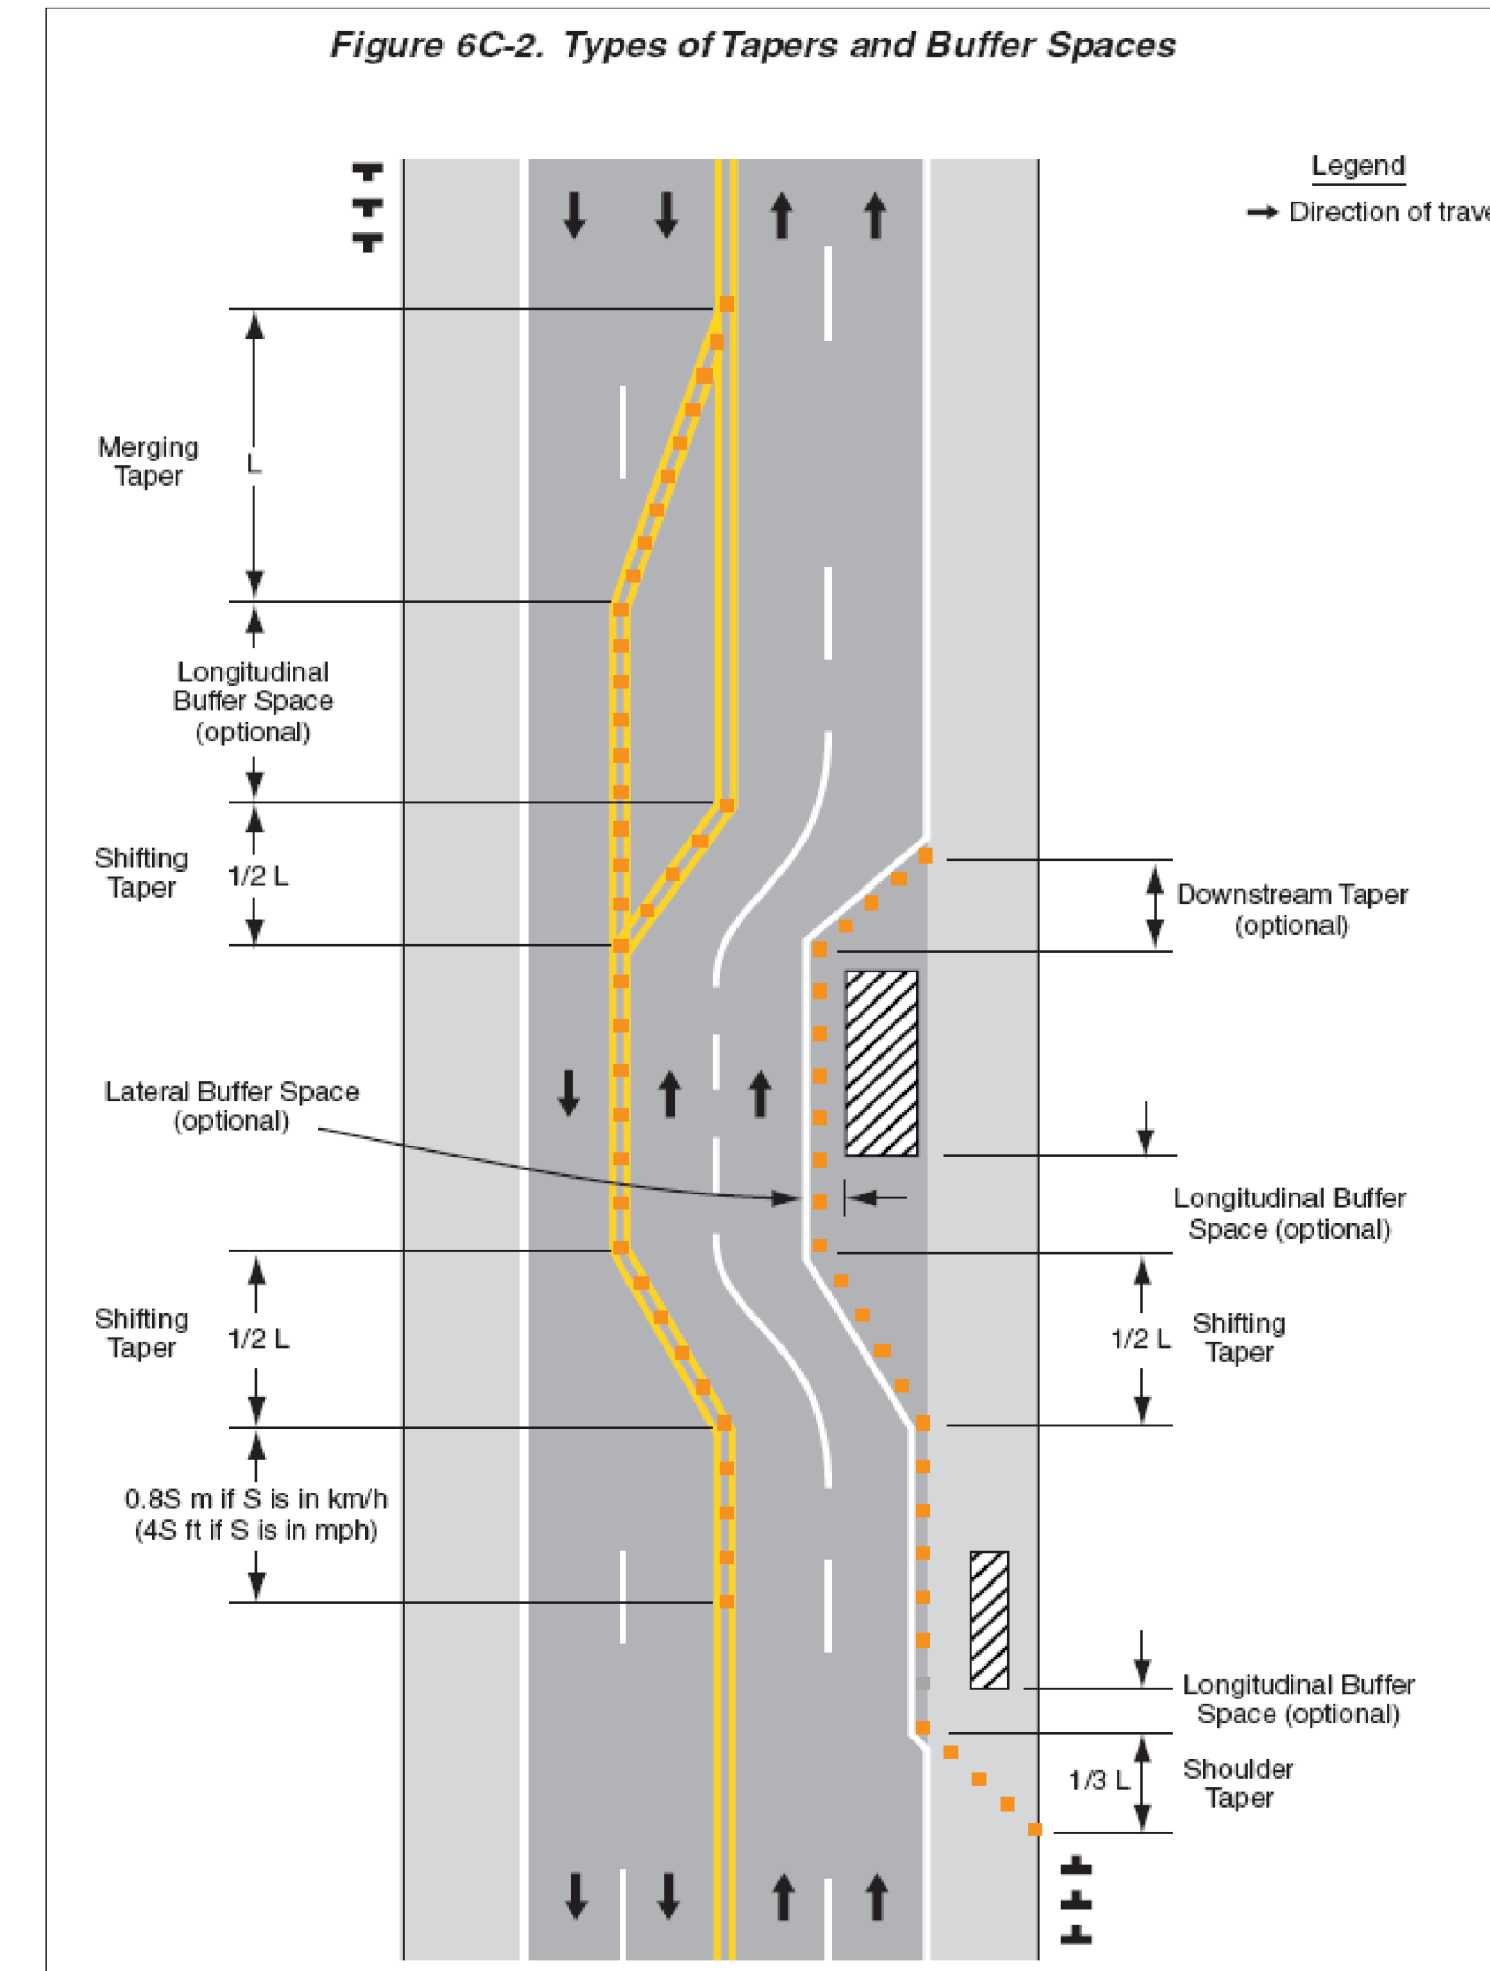
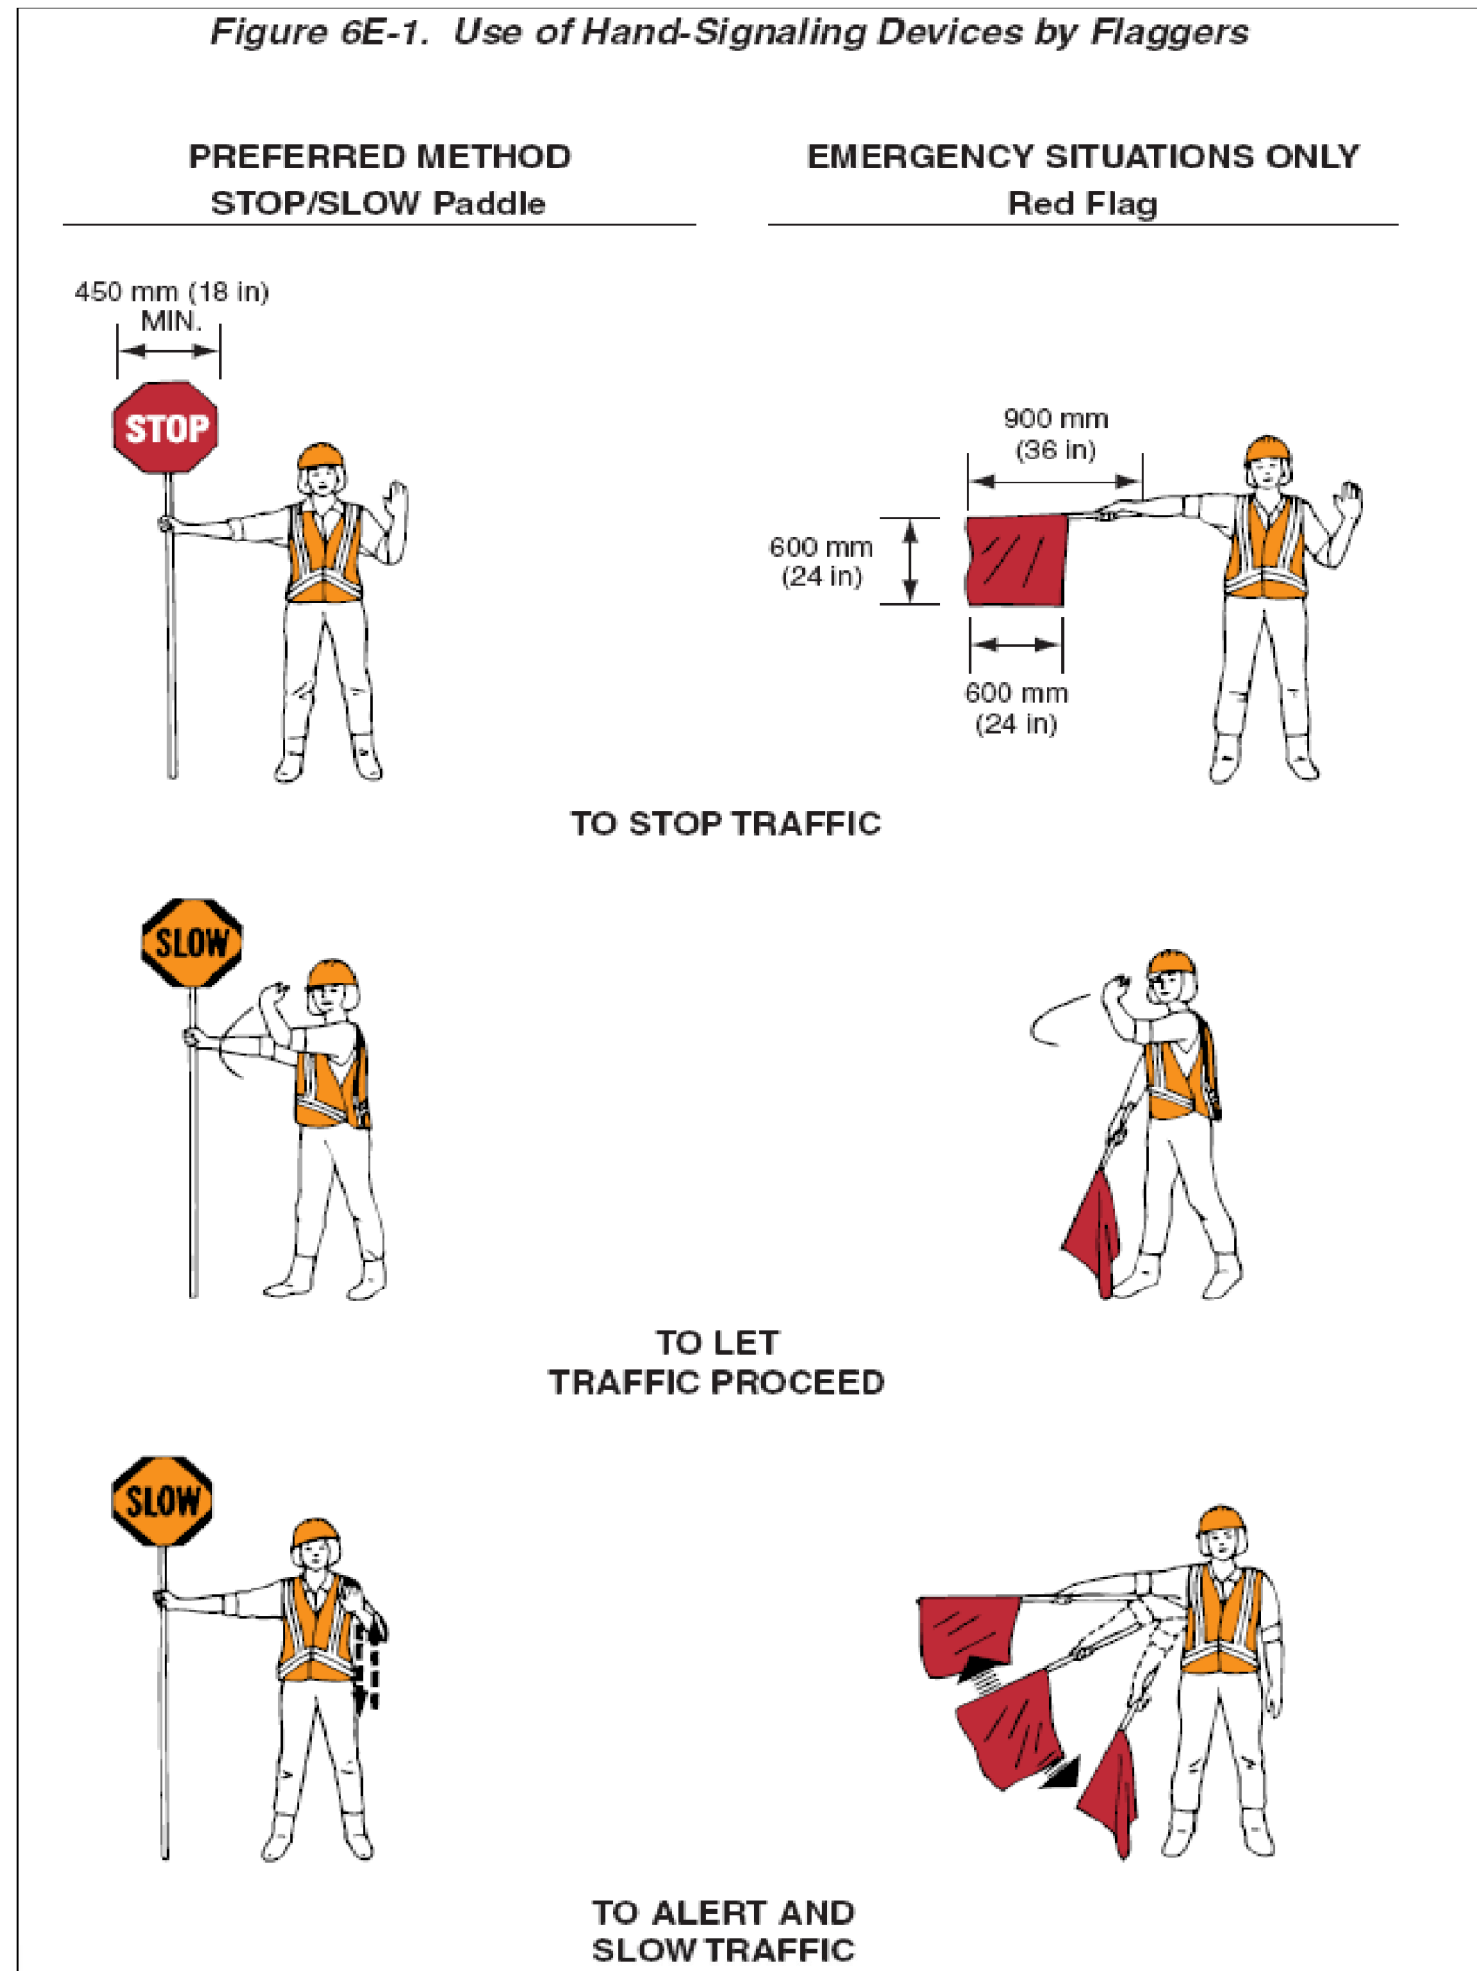


Table 6C-3. Taper Length Criteria for Temporary Traffic Control Zones

Type of Taper	Taper Length (L)*
Merging Taper	at least L
Shifting Taper	at least 0.5L
Shoulder Taper	at least 0.33L
One-Lane, Two-Way Traffic Taper	30 m (100 ft) maximum
Downstream Taper	30 m (100 ft) per lane

Table 6C-1. Recommended Advance Warning Sign Minimum Spacing

Road Type	Distance Between Signs**		
	A	B	C
Urban (low speed)*	100 feet	100 feet	100 feet
Urban (high speed)*	350 feet	350 feet	350 feet
Rural	500 feet	500 feet	500 feet
Expressway / Freeway	1,000 feet	1,500 feet	2,640 feet


* Speed category to be determined by the highway agency
 ** The column headings A, B, and C are the dimensions shown in Figures 6H-1 through 6H-46. The A dimension is the distance from the transition or point of restriction to the first sign. The B dimension is the distance between the first and second signs. The C dimension is the distance between the second and third signs. (The "first sign" is the sign in a three-sign series that is closest to the TTC zone. The "third sign" is the sign that is furthest upstream from the TTC zone.)

Table 6C-4. Formulas for Determining Taper Lengths

Speed Limit (S)	Taper Length (L) Meters	Speed Limit (S)	Taper Length (L) Feet
60 km/h or less	$L = \frac{WS^2}{155}$	40 mph or less	$L = \frac{WS^2}{60}$
70 km/h or more	$L = \frac{WS}{1.6}$	45 mph or more	$L = WS$

Where: L = taper length in meters (feet)
 W = width of offset in meters (feet)
 S = posted speed limit, or off-peak 85th-percentile speed prior to work starting, or the anticipated operating speed in km/h (mph)

Figure 6F-7. Channelizing Devices (Sheet 1 of 2)

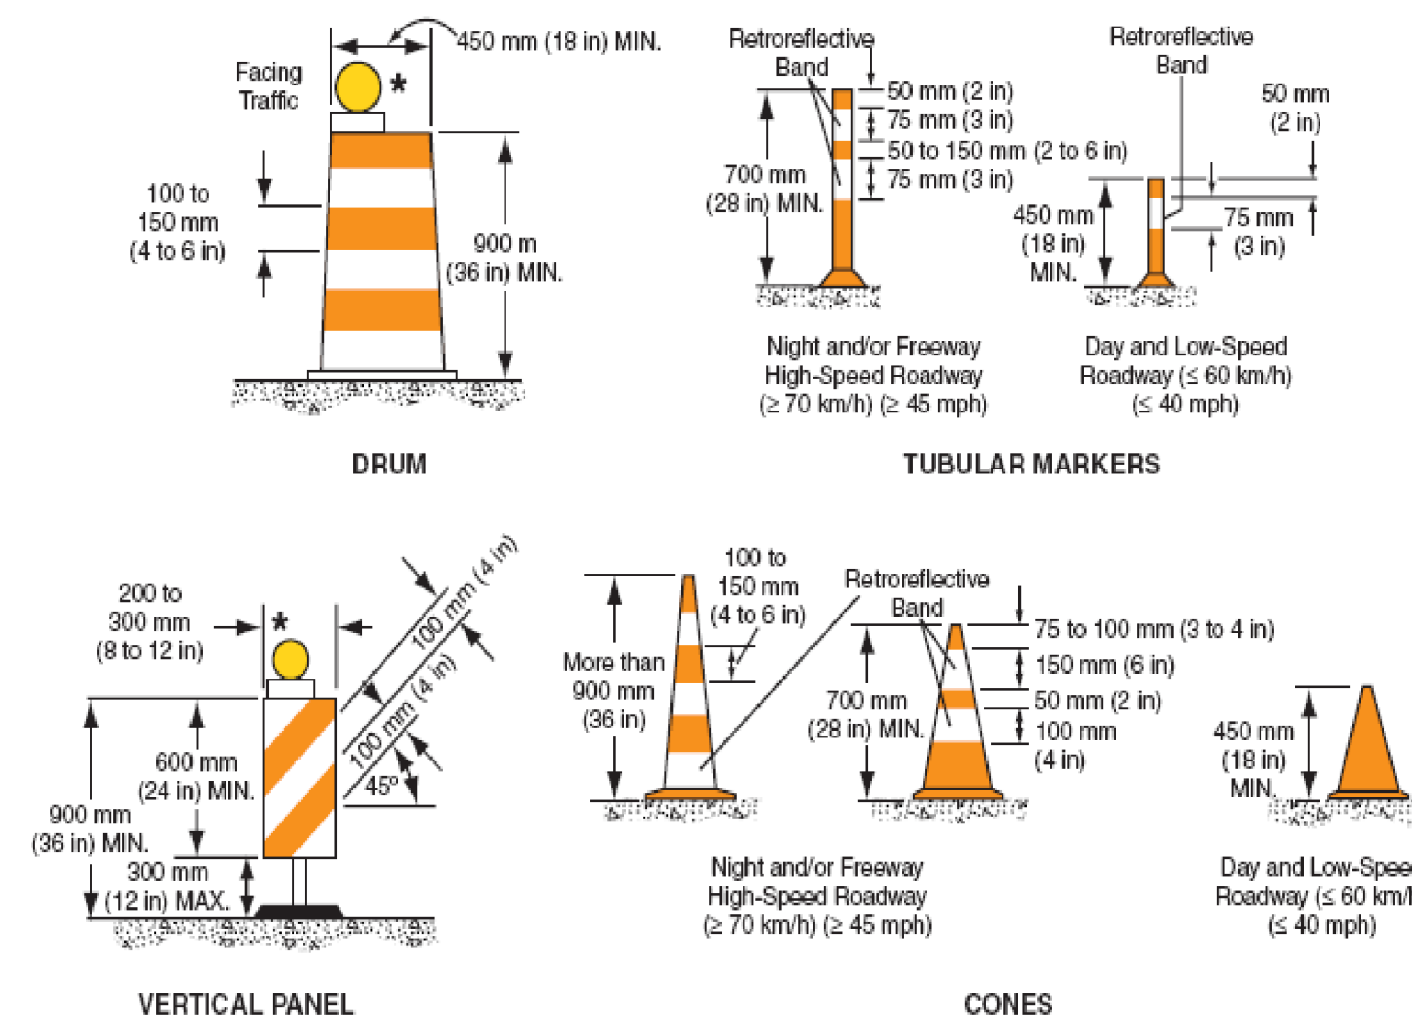

Note: If drums, cones, or tubular markers are used to channelize pedestrians, they shall be located such that there are no gaps between the bases of the devices, in order to create a continuous bottom, and the height of each individual drum, cone, or tubular marker shall be no less than 900 mm (36 in) to be detectable to users of long canes.

TEMPORARY TRAFFIC CONTROL NOTES

- ALL TEMPORARY TRAFFIC CONTROL SHALL BE IN ACCORDANCE WITH THESE PROJECT PLANS, APPLICABLE VTRANS E-SERIES STANDARD DRAWINGS, AND THE MANUAL ON UNIFORM TRAFFIC CONTROL DEVICES (MUTCD), DATED 2009, AND ITS LATEST REVISIONS, OR AS DIRECTED BY THE RESIDENT ENGINEER. IF THE CONTRACTOR DOES NOT WISH TO FOLLOW THE TEMPORARY TRAFFIC CONTROL PROVIDED, HE/SHE MAY SUBMIT AN ALTERNATE PROPOSAL AT THE PRE-CONSTRUCTION MEETING IMPLEMENTING THE PROPOSED CHANGES FOR REVIEW AND APPROVAL BY THE RESIDENT ENGINEER.
- THE CONTRACTOR MUST PROVIDE ACCESS THROUGH THE WORK ZONE FOR EMERGENCY VEHICLES AT ALL TIMES.
- THE CONTRACTOR SHALL CONDUCT THE WORK AT ALL TIMES IN SUCH A MANNER AND IN SUCH SEQUENCE SO AS TO ENSURE THE LEAST INTERFERENCE WITH TRAFFIC OCCURS.
- SIGNS SHALL ONLY BE VISIBLE TO MOTORIST AT THE TIMES WHEN THE MESSAGE IS PERTINENT, I.E. A "FLAGGER AHEAD" SIGN SHALL ONLY BE VISIBLE TO MOTORIST WHEN THE FLAGGER IS ACTUALLY PRESENT PERFORMING THEIR DUTIES.
- PAYMENT FOR CONSTRUCTION SIGNING WILL BE MADE UNDER CONTRACT ITEM 641.00 TRAFFIC CONTROL.

PROJECT NAME: STATEWIDE - SOUTHWEST REGION

PROJECT NUMBER: STPG SIGN (32)

FILE NAME: I0B012_TS.DGN
 PROJECT LEADER: A. GAMBLE
 DESIGNED BY: J. KELLY
 TRAFFIC CONTROL I

PLOT DATE: 03-SEP-2010
 DRAWN BY: J. KELLY
 CHECKED BY: A. GAMBLE
 SHEET 89 OF 90

Figure 6H-3. Work on Shoulders (TA-3)

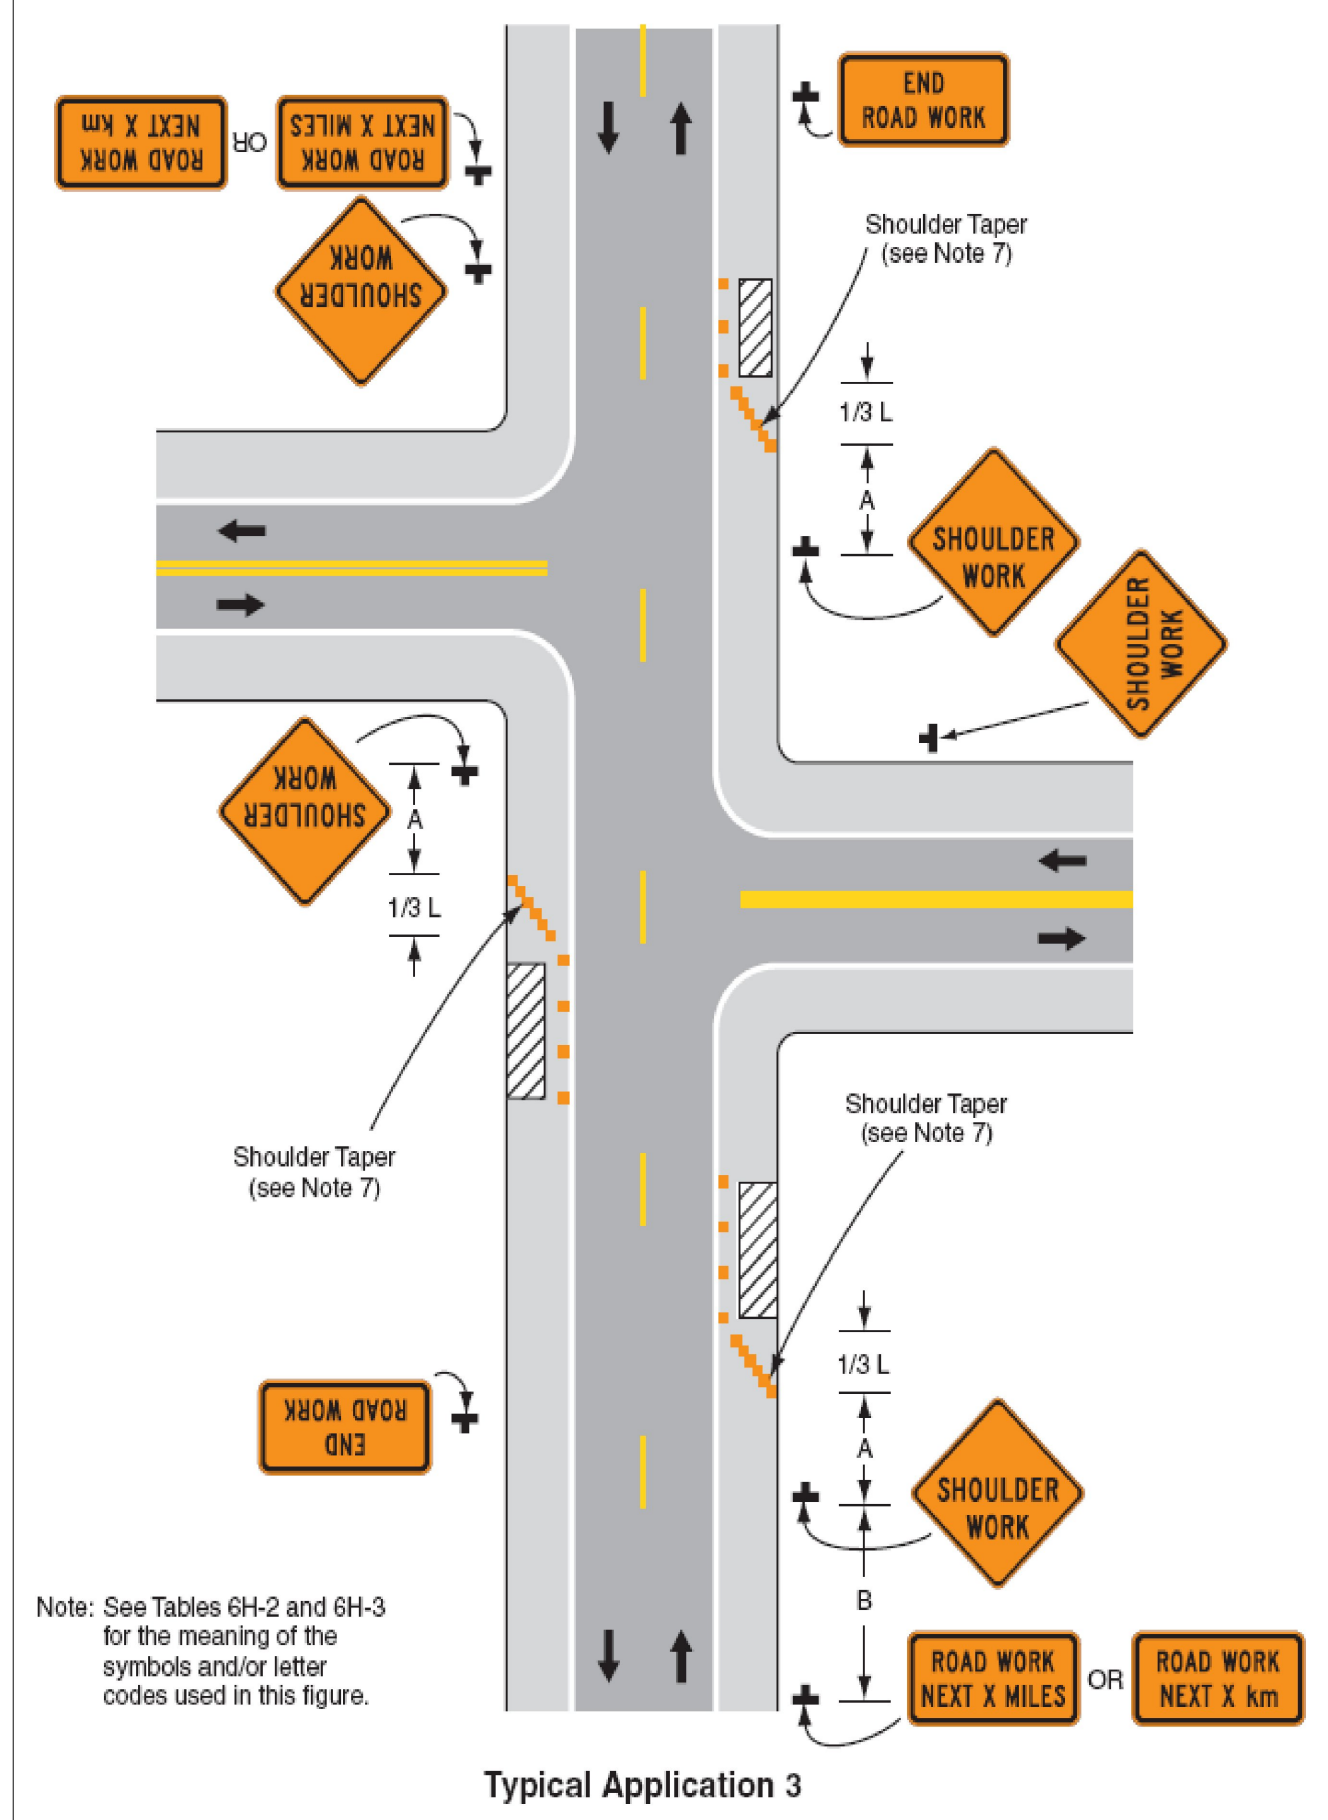


Figure 6H-4. Short-Duration or Mobile Operation on Shoulder (TA-4)

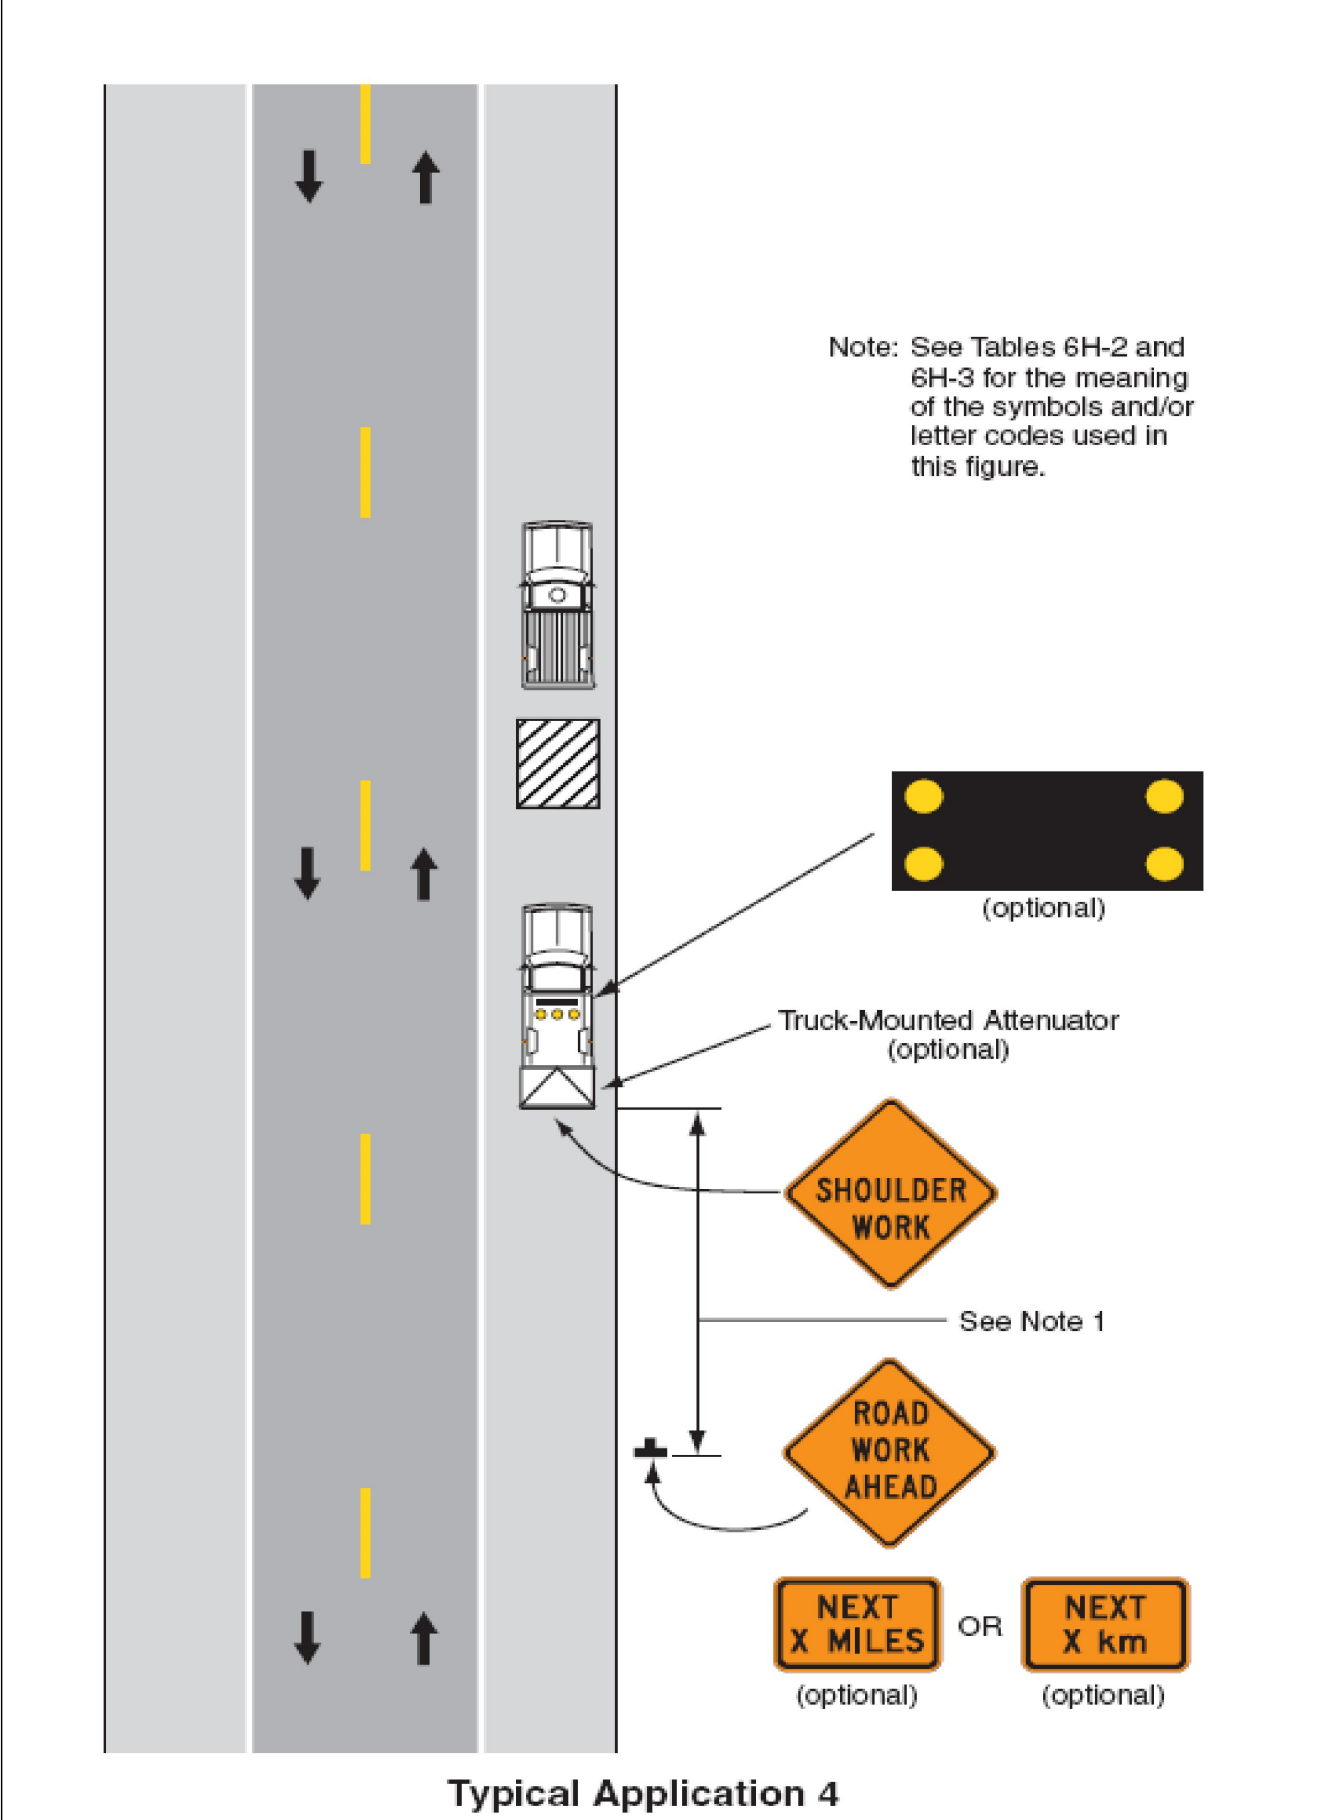


Figure 6H-6. Shoulder Work with Minor Encroachment (TA-6)

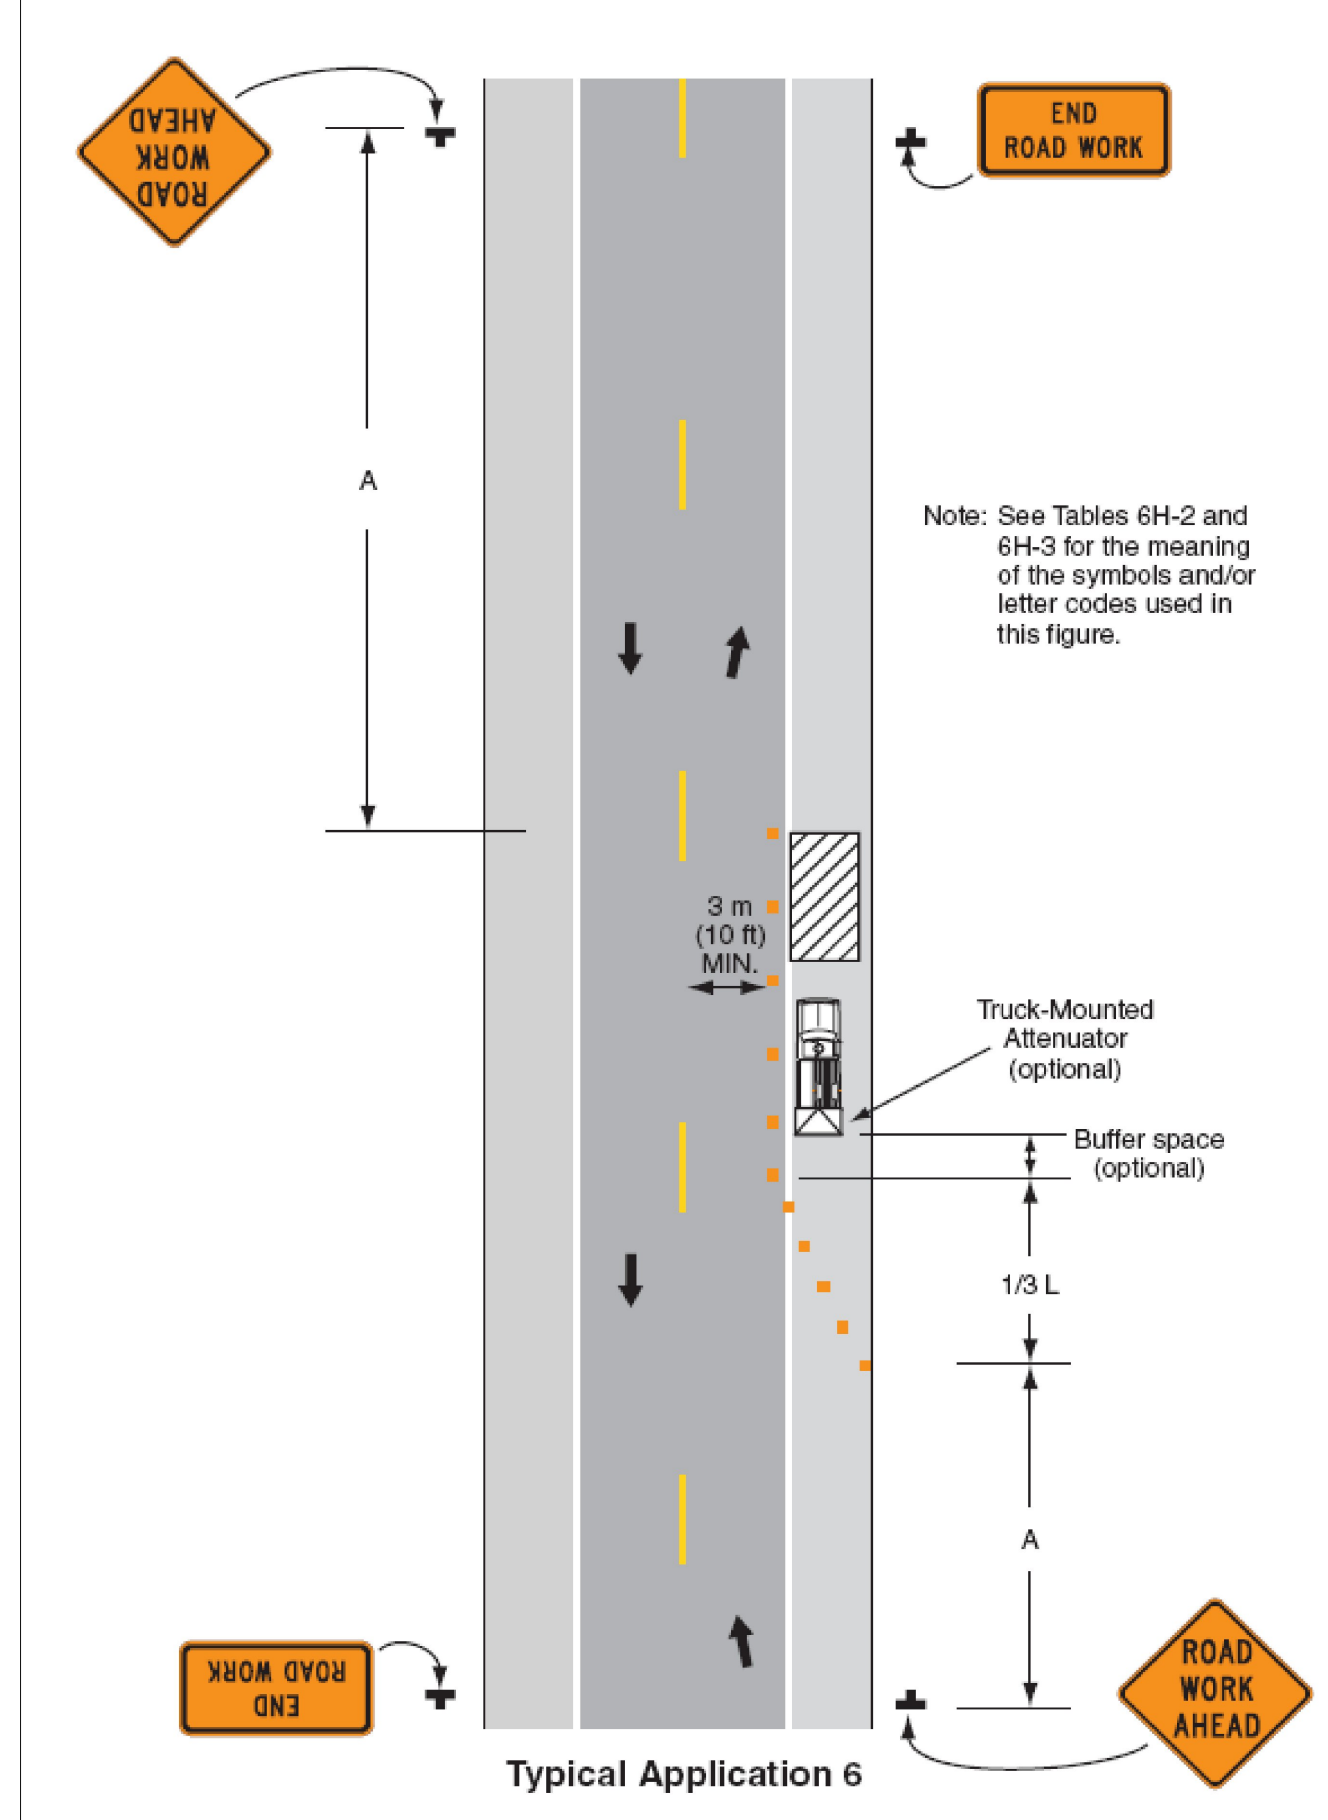


Figure 6H-10. Lane Closure on Two-Lane Road Using Flaggers (TA-10)

