


**INDEX OF SHEETS**


SEE SHEET 2

STATE OF VERMONT  
AGENCY OF TRANSPORTATION

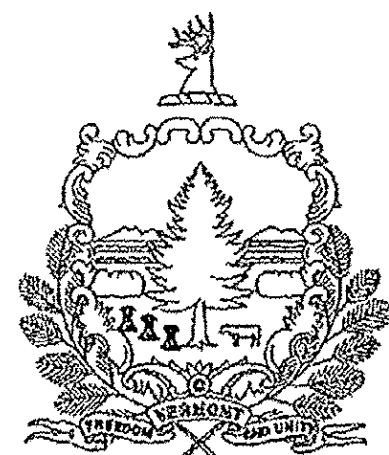

PROPOSED IMPROVEMENT  
BRIDGE PROJECT

TOWNS OF ALBURGH, VT AND ROUSES POINT, NY  
COUNTIES OF GRAND ISLE, VT & CLINTON, NY  
U.S. ROUTE NO. 2 (PRINCIPAL ARTERIAL), BRIDGE NO. 1  
PROJECT BHF MEMB(24)

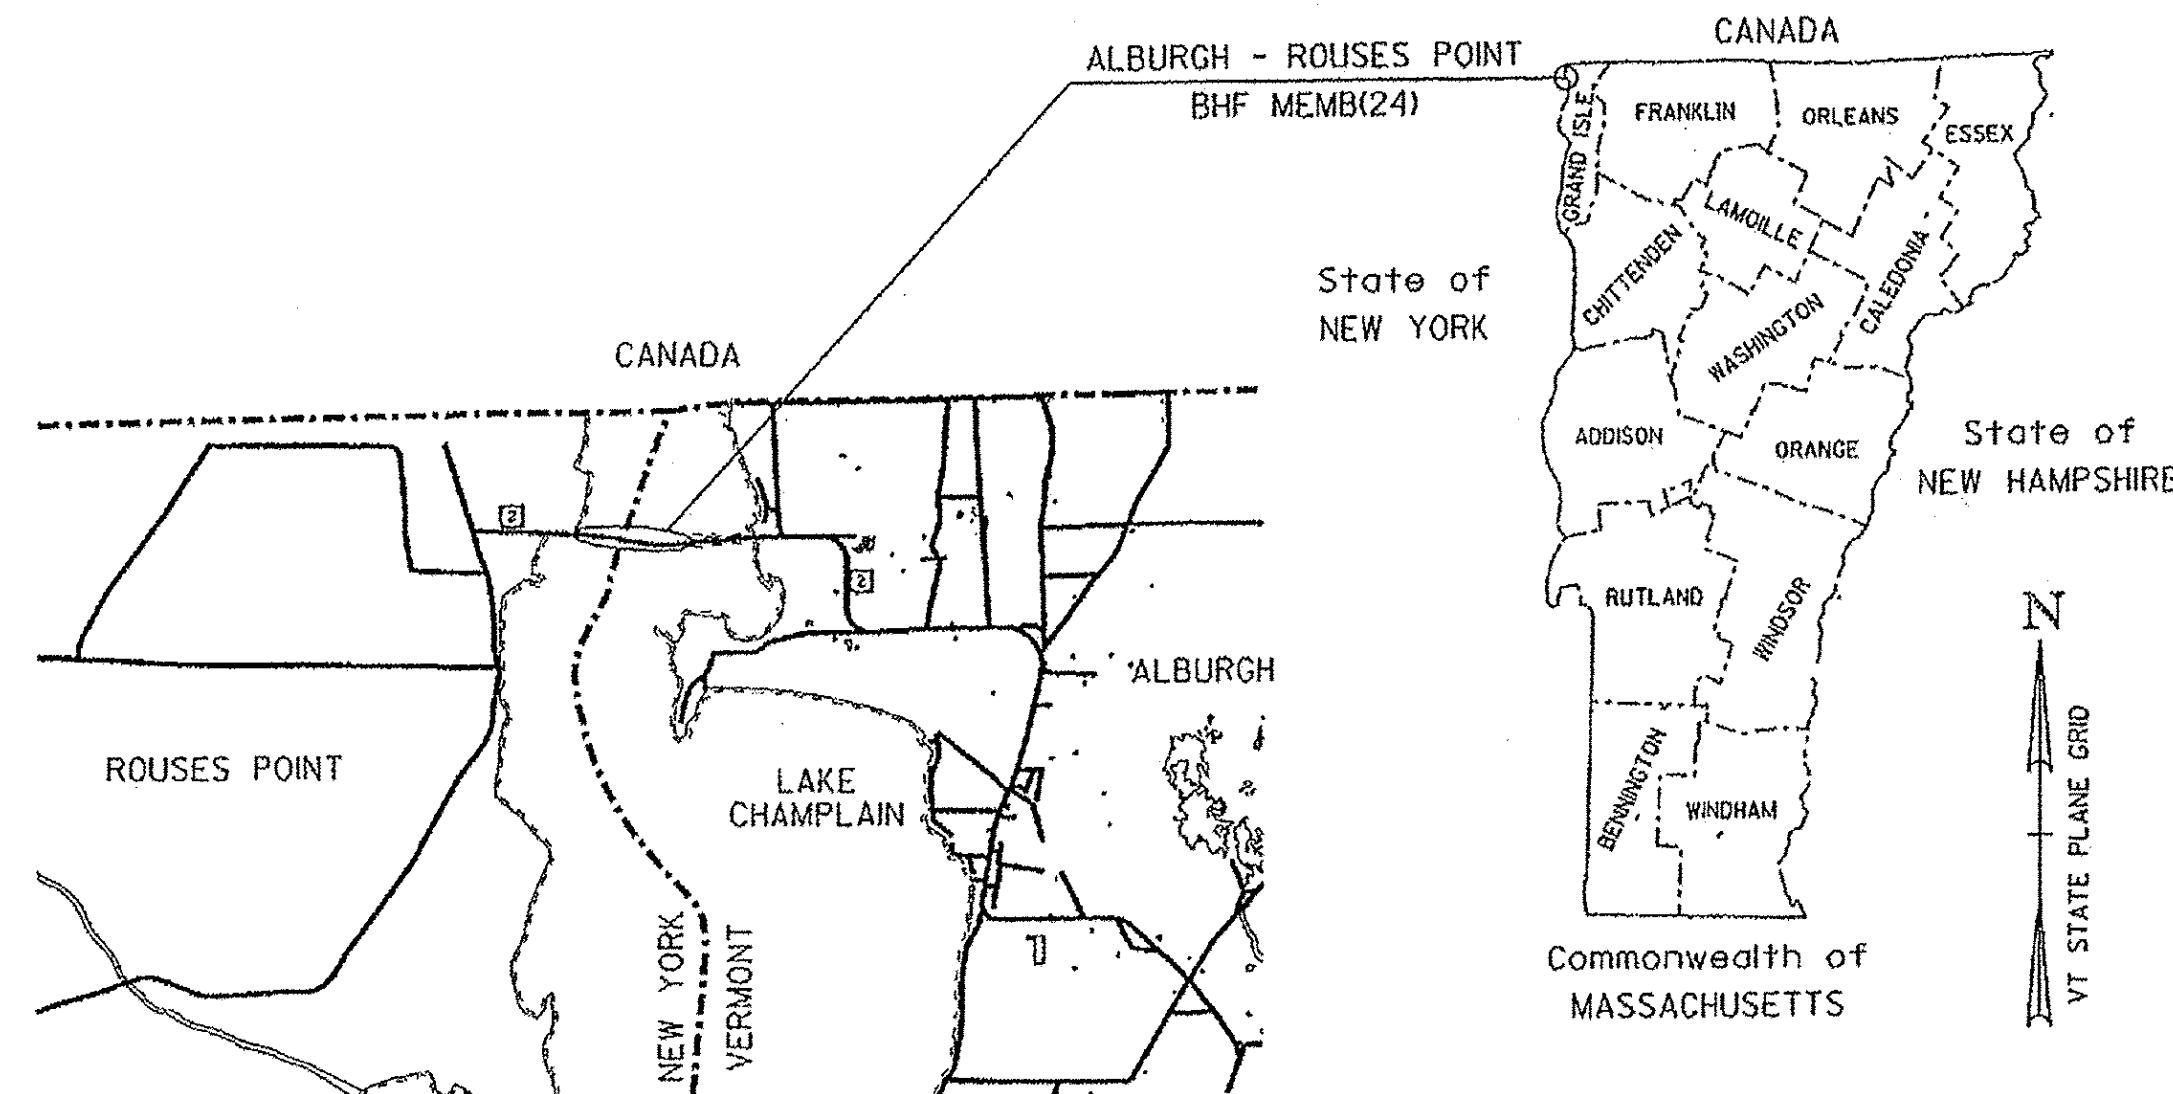

LOCATION MAP  
NOT TO SCALE

**RECORD PLANS**

CONTRACTOR: PECKHAM ROAD CORP. - WHITE PLAINS, NY

RESIDENT ENGINEER: GREG WILCOX

CONSTRUCTION BEGAN: APRIL 24, 2012

CONSTRUCTION COMPLETE: OCTOBER 19, 2012

RECORD PLANS BY: GREG WILCOX & JENNA HYDE

I HEREBY CERTIFY THAT ALL THE CONSTRUCTION REQUIRED BY THIS SET OF DRAWINGS HAS BEEN ACCOMPLISHED AS INDICATED HEREIN.

BY: *[Signature]* RESIDENT ENGINEER  
DATE: 3/11/15 Greg Wilcox

NOTE: Any further information concerning final quantities, amounts or other details relative to this project may be found at Central Files in the electronic archives.

**TRAFFIC DATA**

1985 ADT	2350
1985 DHV	330
2005 ADT	3190
2005 DHV	445
2009 ADT	4100
2009 DHV	460
T	12%
D	57% (E.B.)
V	50 MPH

PROJECT LOCATION: BEGINNING AT A POINT ON U.S. ROUTE 2 APPROXIMATELY 0.3 MILES WESTERLY OF THE NY-VT STATE LINE AND EXTENDING EASTERLY 0.8 MILES.

LENGTH OF STRUCTURE: 4056.17'

LENGTH OF ROADWAY: 150.00'

PROJECT DESCRIPTION: THIS PROJECT INVOLVES REMOVING AND REPLACING THE MEMBRANE WATERPROOFING AND BITUMINOUS CONCRETE PAVEMENT ON THE BRIDGE AND ITS VT APPROACH AND REMOVING AND REPLACING THE BRIDGE EXPANSION JOINTS ALONG WITH MINOR RELATED WORK.

LENGTH OF PROJECT: 4206.17'

QUALITY ASSURANCE PROGRAM: LEVEL 1




SURVEYED BY : N/A  
SURVEYED DATE : N/A

**DATUM**

VERTICAL N/A  
HORIZONTAL N/A

**CONVENTIONAL SYMBOLS**

COUNTY LINE	
TOWN LINE	
LIMITS OF ACCESS	
POINT OF ACCESS	
FENCE LINE	
STONE WALL	
TRAVELED WAY	
GUARD RAIL	
RAILROAD	
SURVEY LINE	
CULVERT	
POWER POLE	
TELEPHONE POLE	
TREES	
CONTROL OF ACCESS	
PROPERTY LINE	
R.O.W. TAKING LINE	
SLOPE RIGHTS	
TOP OF CUT	
TOE OF SLOPE	

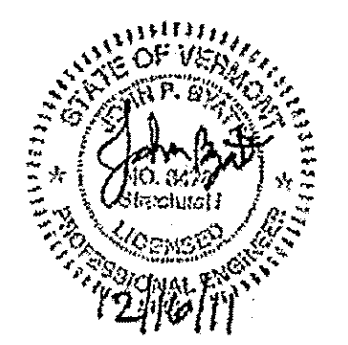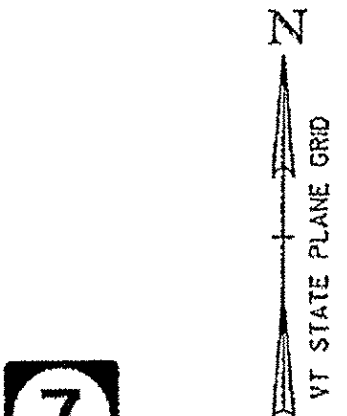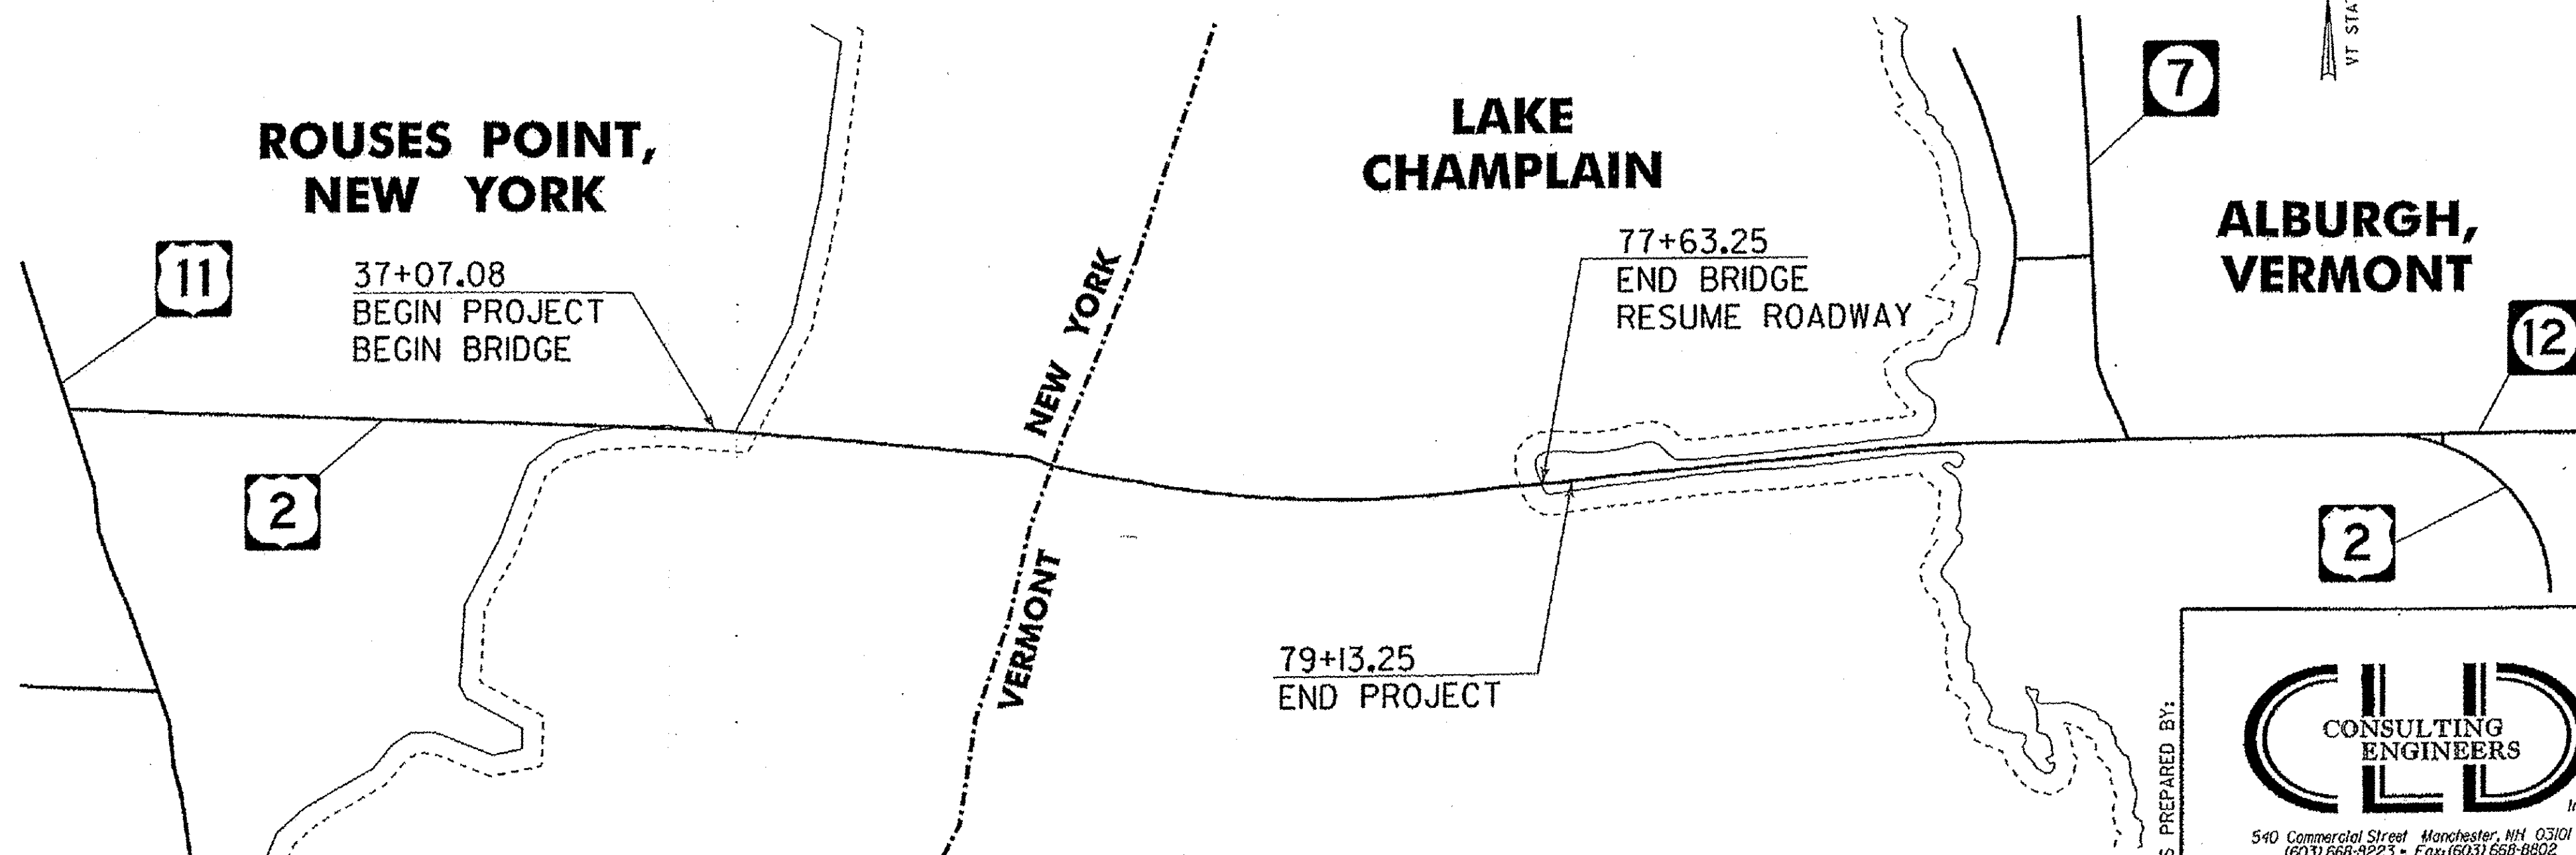

THESE PLANS ARE SUBJECT TO SUCH ENGINEERING CHANGES AS MAY BE REQUIRED BY THE FEDERAL HIGHWAY ADMINISTRATION OR THE DIRECTOR OF PROGRAM DEVELOPMENT.

CONSTRUCTION IS TO BE CARRIED ON IN ACCORDANCE WITH THESE PLANS AND THE STANDARD SPECIFICATIONS FOR CONSTRUCTION DATED 2006, AS APPROVED BY THE FEDERAL HIGHWAY ADMINISTRATION ON JUNE 15, 2006 FOR USE ON THIS PROJECT, INCLUDING ALL SUBSEQUENT REVISIONS AND SUCH REVISED SPECIFICATIONS AND SPECIAL PROVISIONS AS ARE INCORPORATED IN THESE PLANS.

PLANS PREPARED BY:

CLD CONSULTING ENGINEERS Inc.  
540 Commercial Street, Manchester, NH 03101  
100.31.668-8223 • Fax: (603) 668-8802  
email: clde@cldeengineers.com • www.cldeengineers.com  
Milne • New Hampshire • Vermont

DEPARTMENT OF TRANSPORTATION  
FEDERAL HIGHWAY ADMINISTRATION

APPROVED: *[Signature]* DATE: 1/9/12

DIRECTOR OF PROGRAM DEVELOPMENT

APPROVED: *[Signature]* DATE: 12-19-11

PROJECT MANAGER: SHERWARD FARNSWORTH

PROJECT NAME: ALBURGH - ROUSES POINT  
PROJECT NUMBER: BHF MEMB(24)  
(RE-ADVERTISED)

SHEET 1 OF 50 SHEETS