


- NOTES:**
1. INDICATES AREA ALONG DECK AND UP FACE OF CURB FOR PLACEMENT OF TWO COATS OF MEMBRANE AND GRITS.
 2. MEMBRANE AND BLAST CLEANING SHALL BE INCLUDED IN THE UNIT PRICE BID FOR SHEET MEMBRANE WATERPROOFING, TORCH APPLIED.
 3. TORCH APPLIED MEMBRANE WATERPROOFING SHALL EXTEND TO FACE OF CURB AS SHOWN.
 4. IN ADDITION TO THE REQUIREMENTS OF SUBSECTION 519.04, BLAST CLEAN 2 1/2\"/>

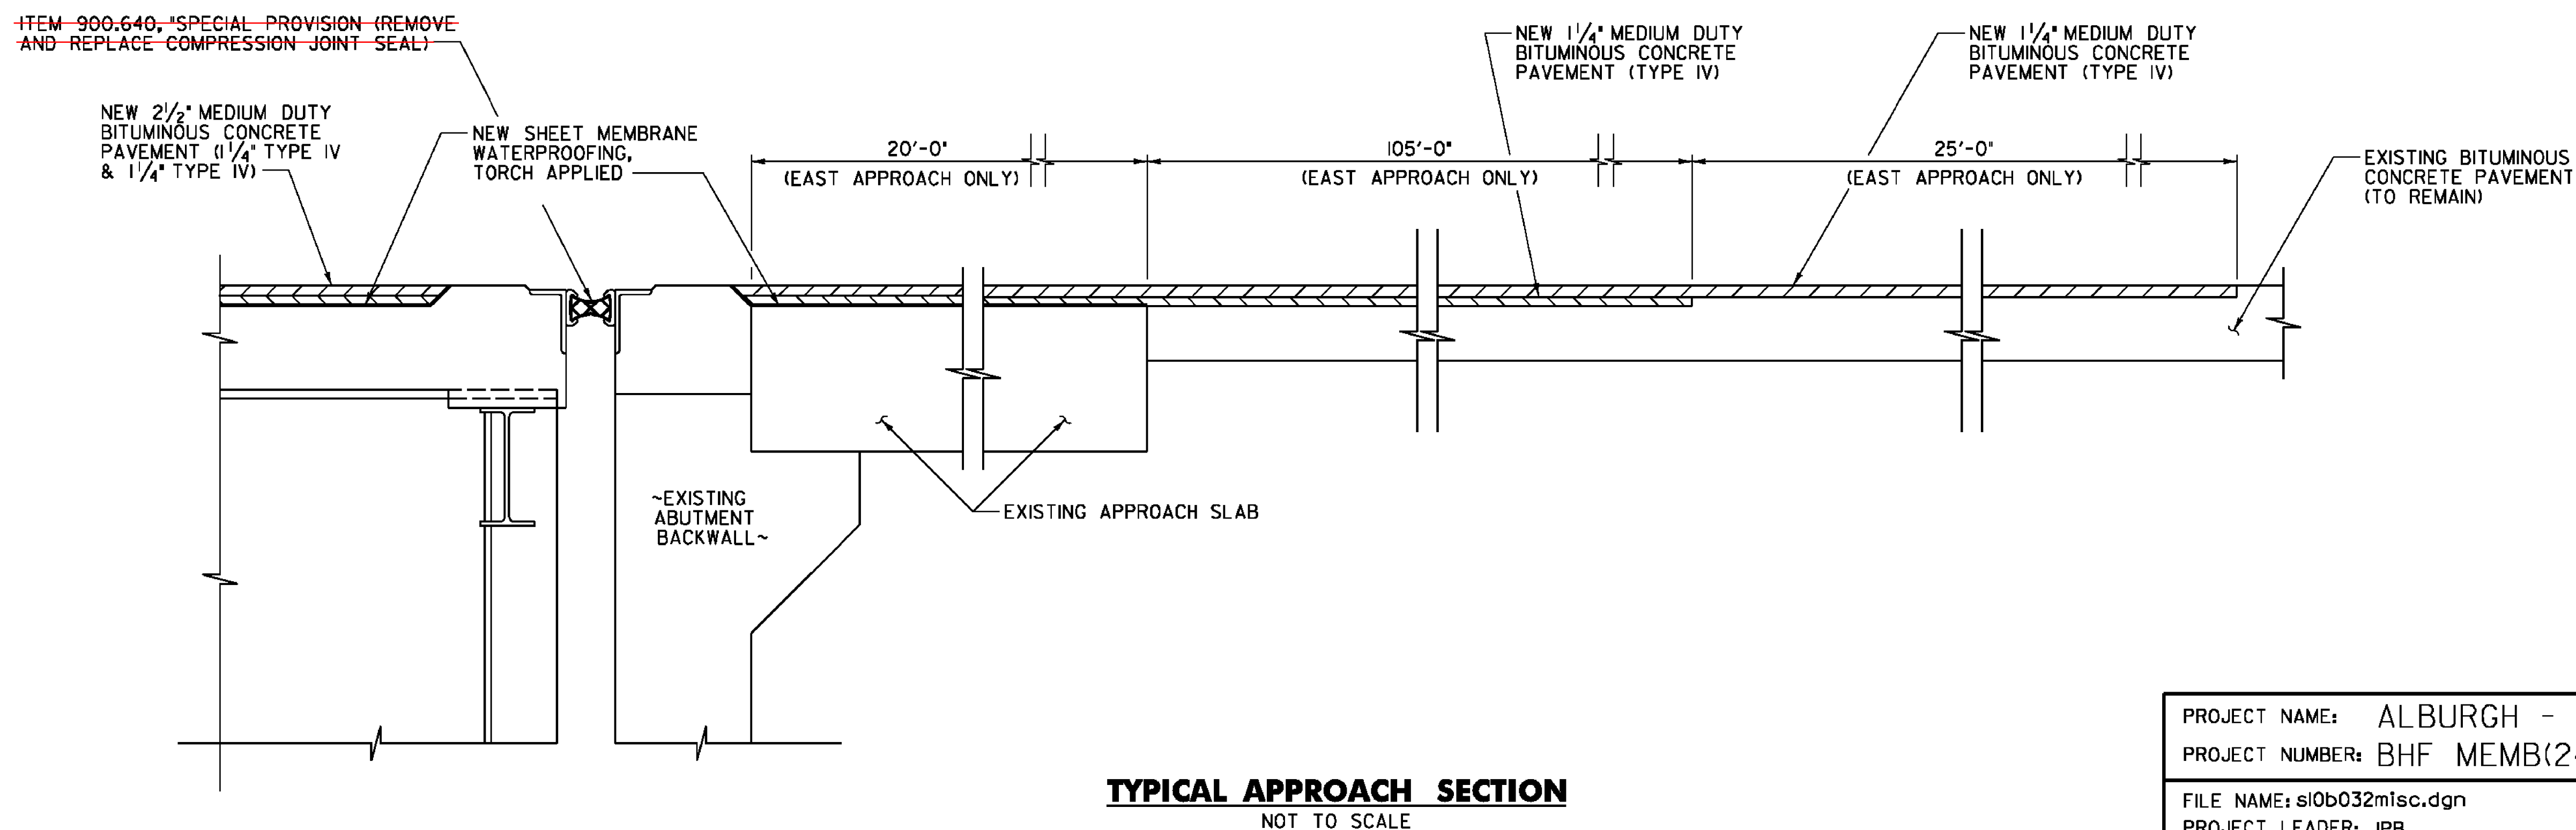

| | | |
|--------------------------------------|------------------------------|-----------------------|
| PROJECT NAME: ALBURGH - ROUSES POINT | FILE NAME: s10b032misc.dgn | PLOT DATE: 12/23/2011 |
| PROJECT NUMBER: BHF MEMB(24) | PROJECT LEADER: JPB | DRAWN BY: MWS |
| | DESIGNED BY: SRB | CHECKED BY: JPB |
| | MISCELLANEOUS DETAILS | SHEET 9 OF 50 |