


PLAN  
Scale: 1" = 50'

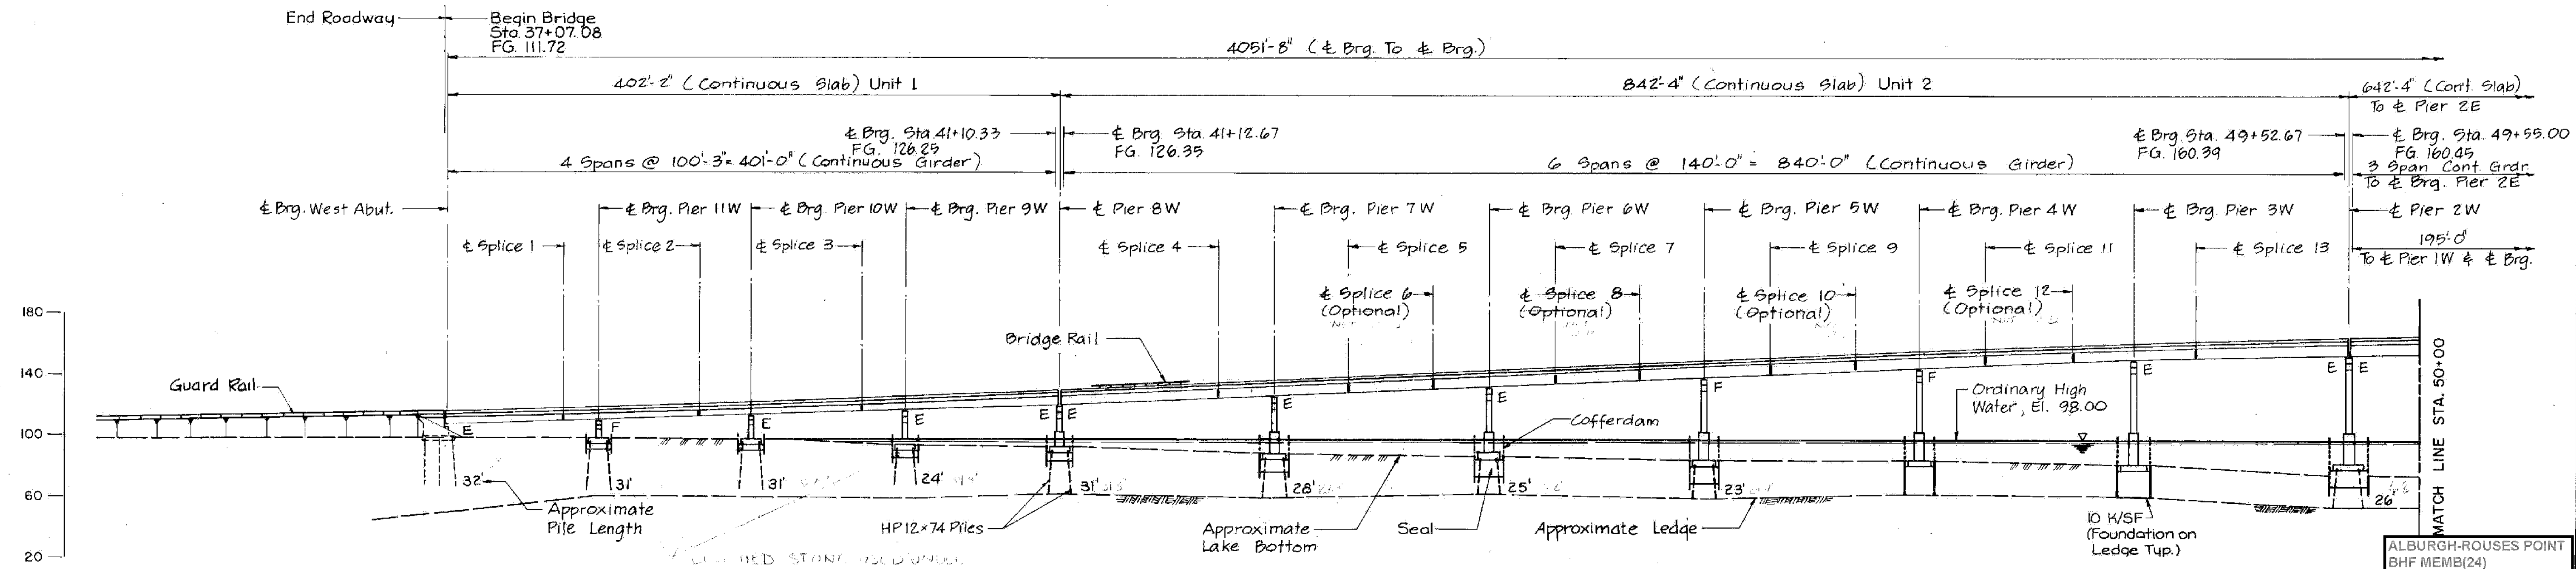

ELEVATION  
Scale: 1" = 50'

NOTE:  
1. Elevation are located along Profile Grade Line which is called out as 'grade' in the Bridge Typical Section on the Preliminary Information Sheet SS.

ALBURGH ROUSES POINT  
BHF MEMB(24)  
SHEET 18 OF 50  
FOR REFERENCE ONLY

<b>STATE OF VERMONT</b>	
<b>AGENCY OF TRANSPORTATION</b>	
TOWN OF ROUSES POINT N.Y. - ALBURGH VT.	Bridge No. 1
HIGHWAY NO. ROUTE 2	Log Sta. 0+00
	Surv. Sta.
BRIDGE PLAN AND ELEVATION (1)	
(STEEL ALTERNATE)	
Designed by S.M.	Drawn by S.Z. & A.B.M.
Checked by S.H.R.	Bridge Design Supervisor
date 2-17-84	C.J.M./S.M. date 2-17-84
PROJECT ROUSES POINT BRIDGE REPLACEMENT	PROJECT NO. BRF 028-1(III)
Bridge Sheet No. SS25	Sheet of

