



PLAN
Scale: 1" = 50'

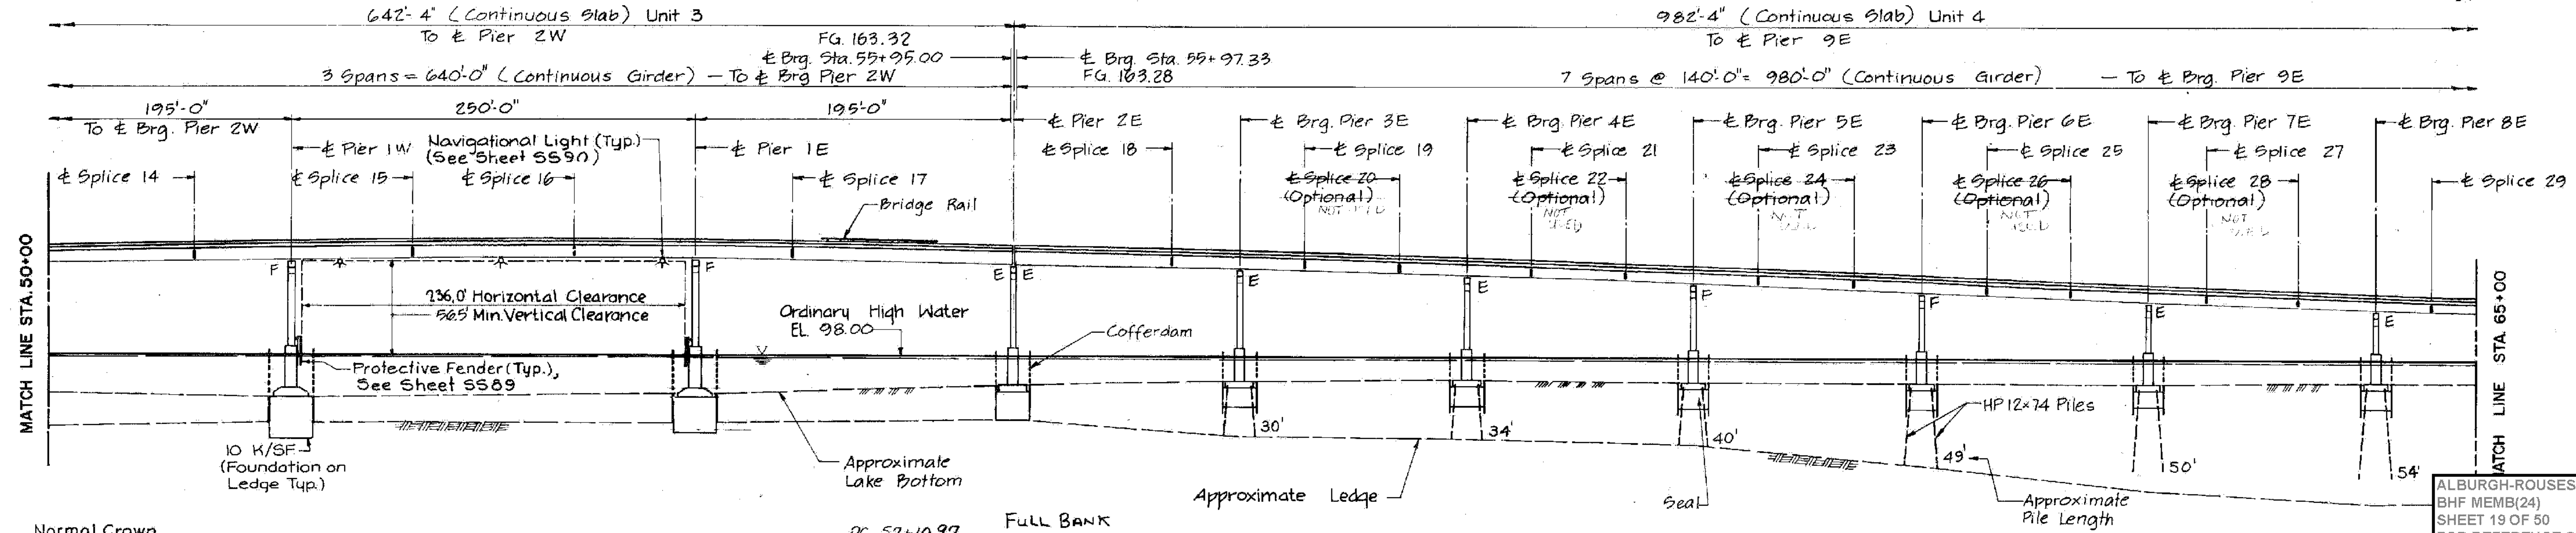

ELEVATION
Scale: 1" = 50'

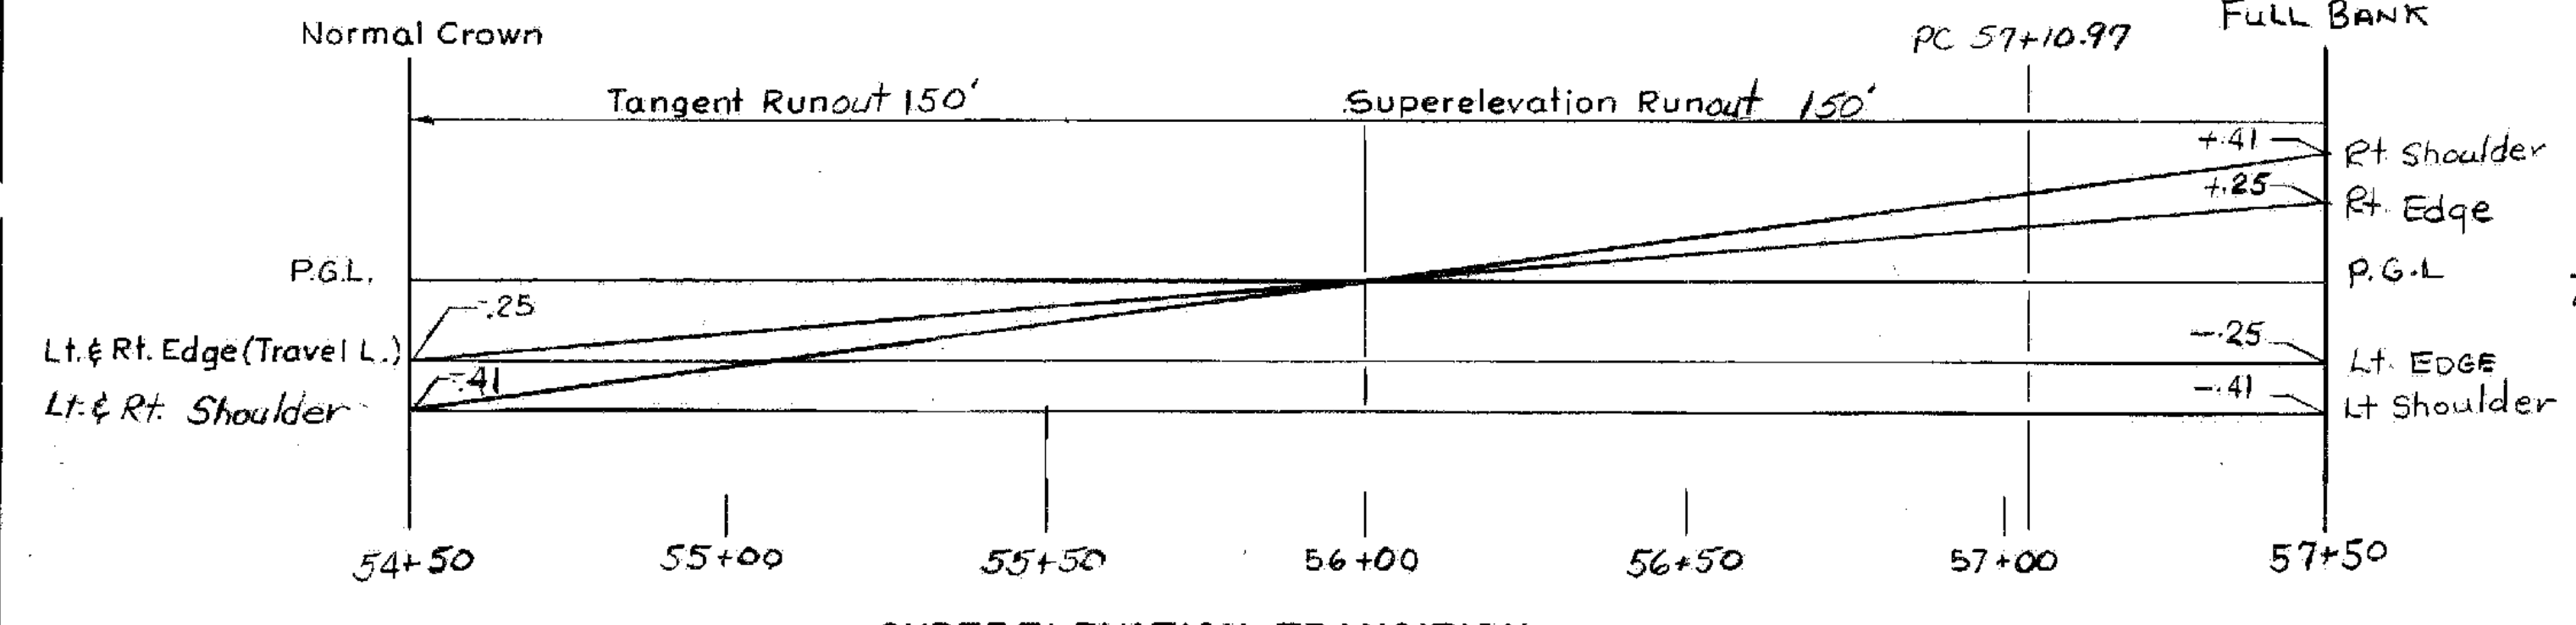

SUPERELEVATION TRANSITION

ALBURGH-ROUSES POINT
BHF MEMB(24)
SHEET 19 OF 50
FOR REFERENCE ONLY

**STATE OF VERMONT
AGENCY OF TRANSPORTATION**

TOWN OF ROUSES POINT N.Y.-ALBURGH VT.	Bridge No. 1
HIGHWAY NO. ROUTE 2	Log Sta. 0+00
	Surv. Sta.
BRIDGE PLAN AND ELEVATION (2)	
(STEEL ALTERNATE)	
Designed by S. M.	Drawn by S. Z. & A. B. M.
Checked by S.H.R.	Bridge Design Supervisor
date 2-17-84	C.J.M./S.M. date 2-17-84
PROJECT ROUSES POINT BRIDGE REPLACEMENT	PROJECT NO. BRF 028-1(111)
Bridge Sheet No. SS26	Sheet of



BRUNING 44.13.140151