


PLAN
scale: 1"=50'

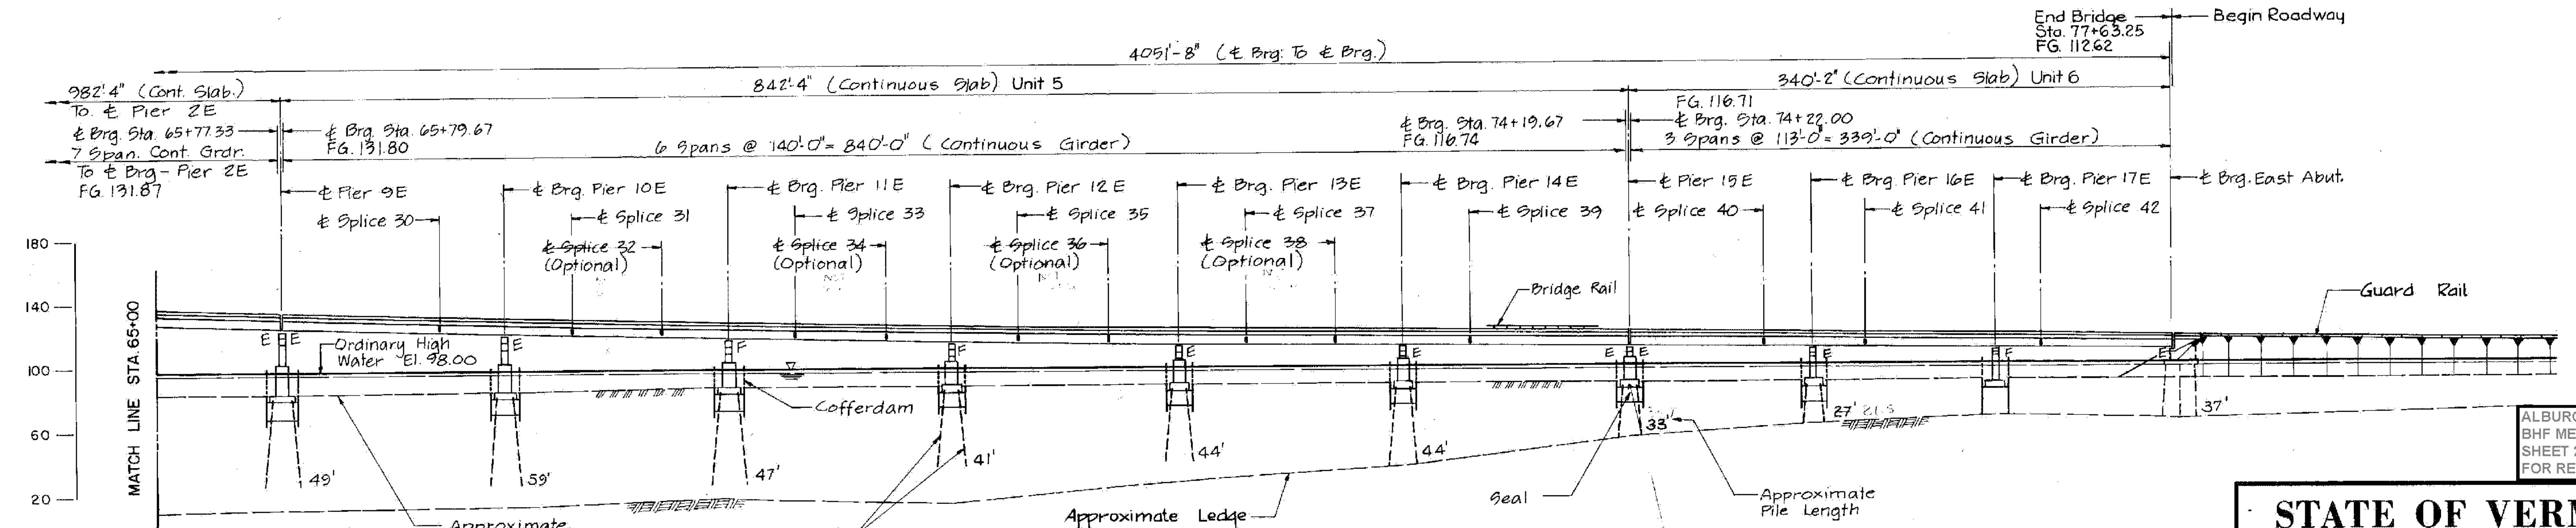

ELEVATION
scale: 1"=50'

ALBURGH-ROUSES POINT
BHF MEMB(24)
SHEET 20 OF 50
FOR REFERENCE ONLY

STATE OF VERMONT	
AGENCY OF TRANSPORTATION	
TOWN OF ROUSES POINT N.Y. — ALBURG VT.	Bridge No. 1
HIGHWAY NO. ROUTE 2	Log Sta. 0+00
BRIDGE PLAN AND ELEVATION (3)	
(STEEL ALTERNATE)	
Designed by S.M.	Drawn by S.Z. & B.P.
Checked by S.H.R. date 2-17-84	Bridge Design Supervisor C.J.M./S.M. date 2-17-84
PROJECT ROUSES POINT BRIDGE REPLACEMENT	PROJECT NO. BRF 028-1(11)
Bridge Sheet No. SS27	Sheet of

