



DECK PLAN - SPANS 5 THRU 8  
UNIT 2  
1" = 20'

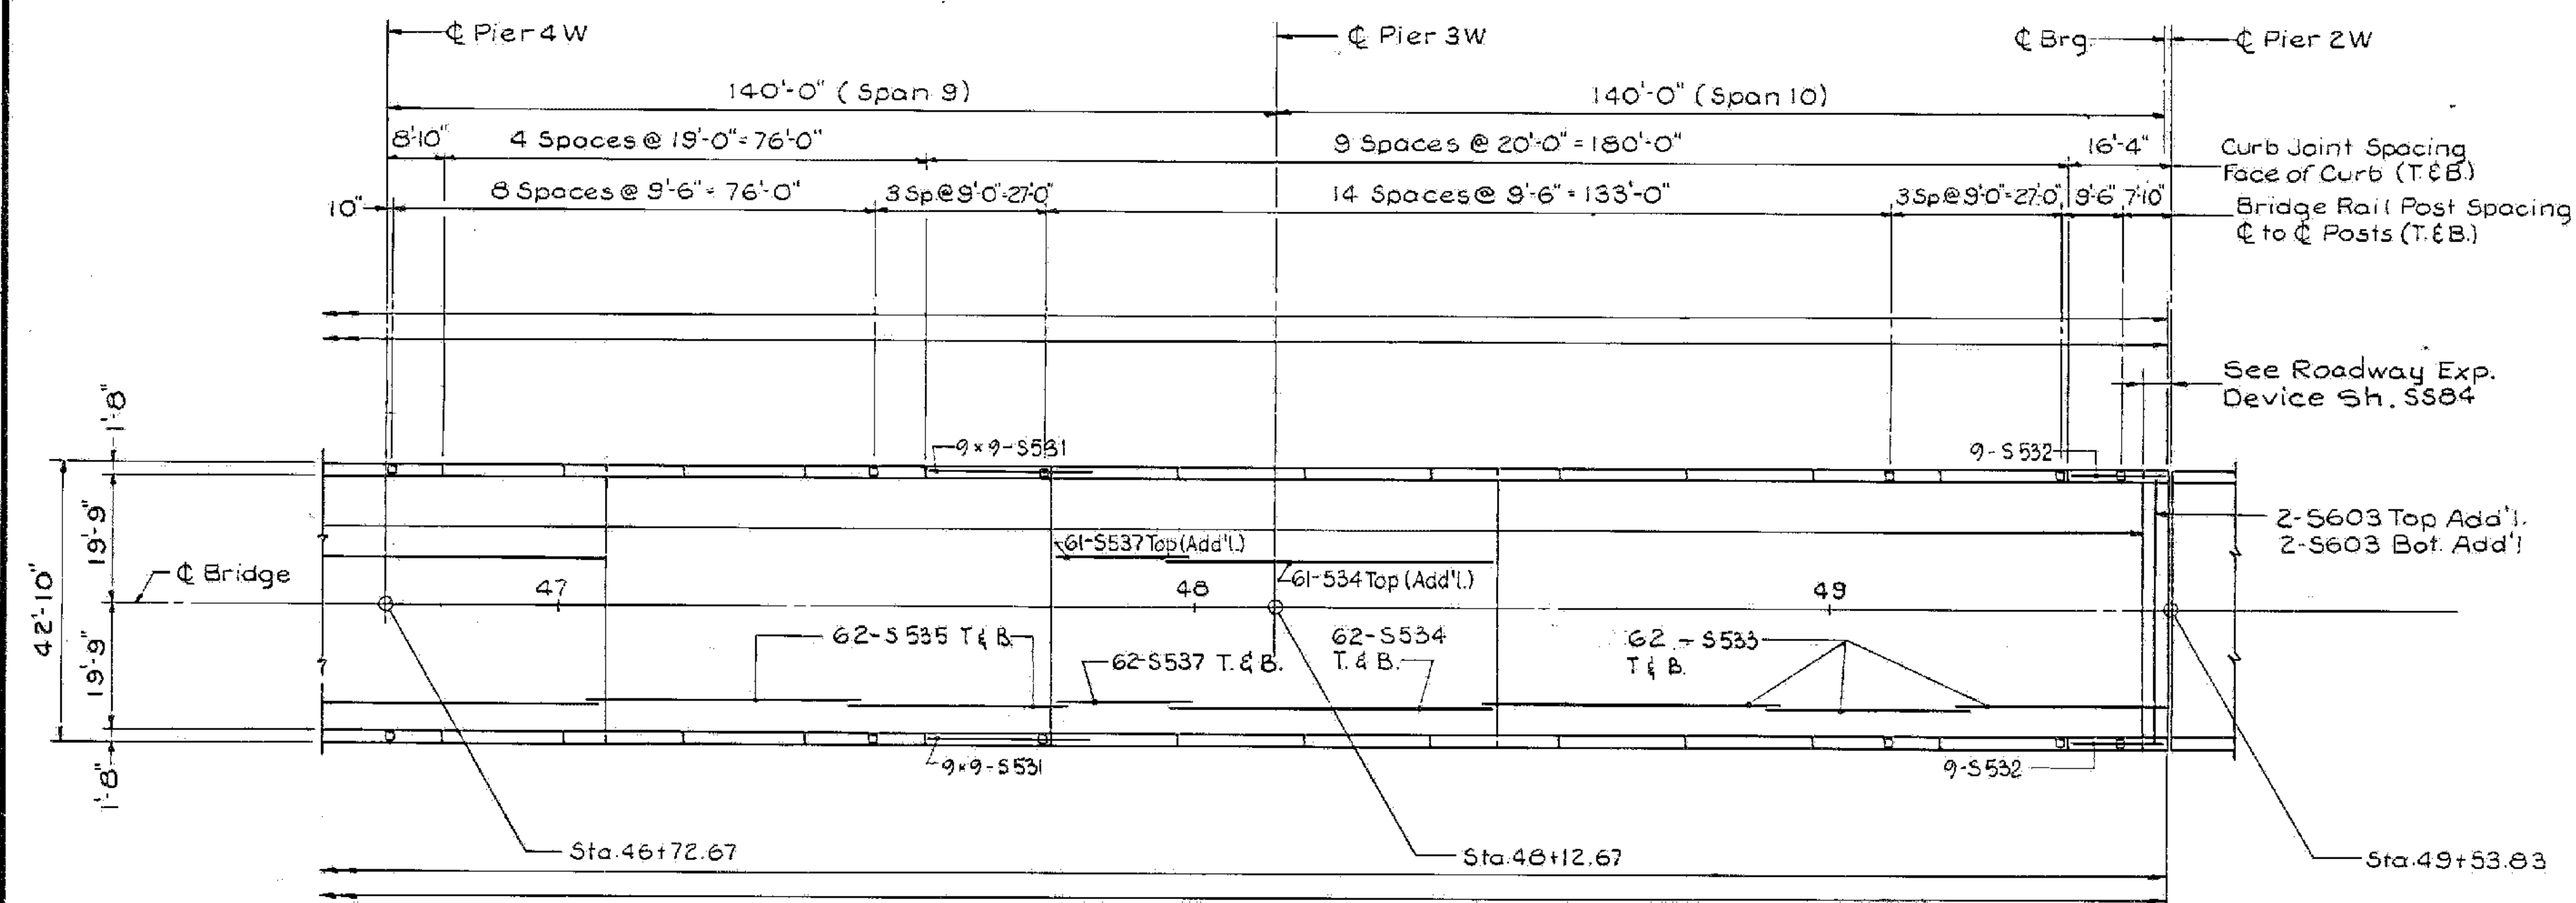

DECK PLAN SPANS 9 & 10  
UNIT 2  
1" = 20'

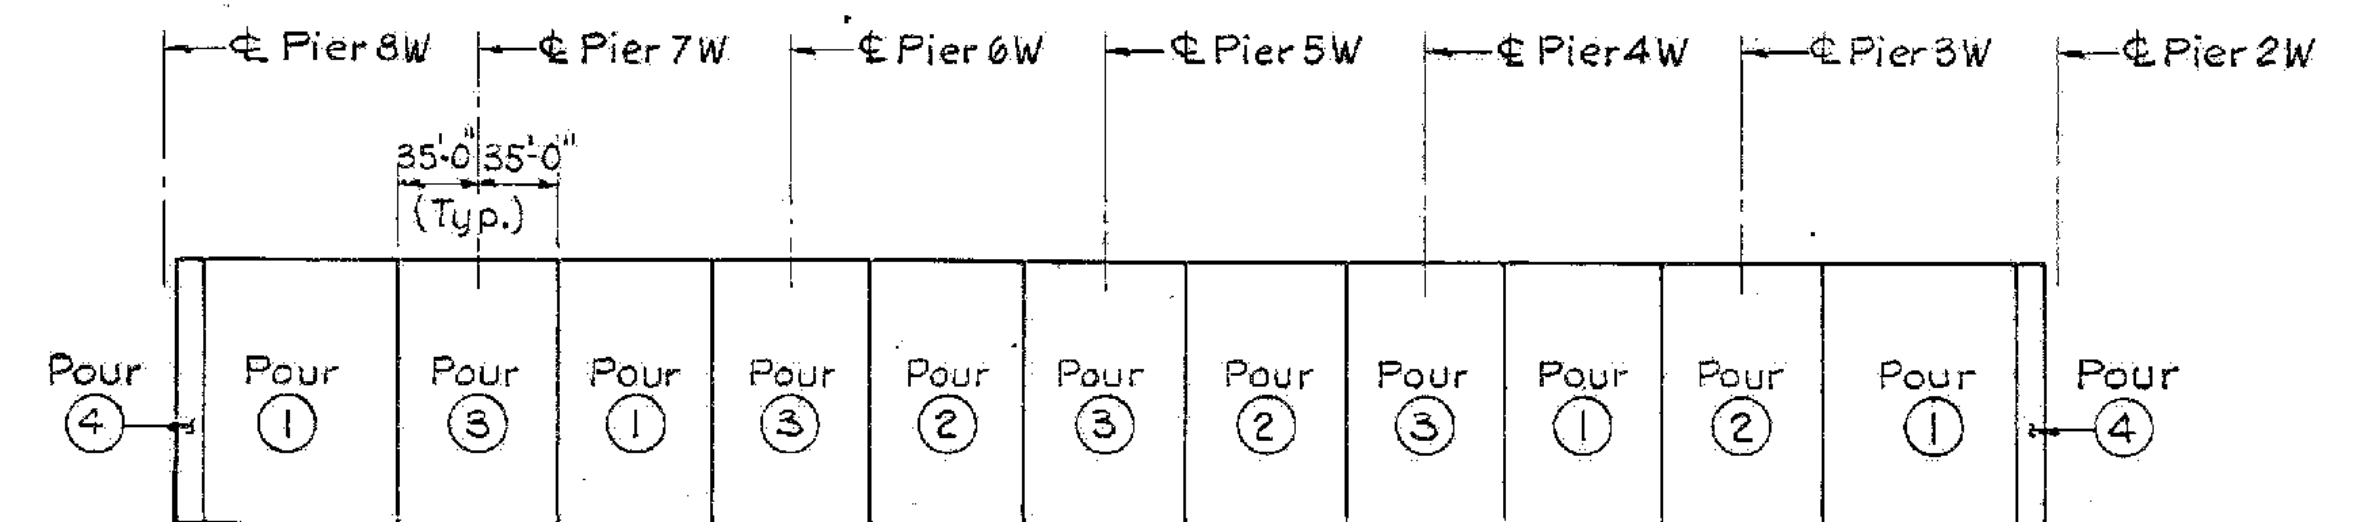

DECK SLAB PLACEMENT SEQUENCE  
No Scale

NOTES:

1. For Deck Slab Placements Notes See Sheet SS77.

ALBURGH-ROUSES POINT  
BHF MEMB(24)  
SHEET 40 OF 50  
FOR REFERENCE ONLY

STATE OF VERMONT  
AGENCY OF TRANSPORTATION

TOWN OF ROUSES POINT N.Y. - ALBURG VT,	Bridge No. 1
HIGHWAY NO. ROUTE 2	Log Sta. 0+00 Surv. Sta.

DECK PLAN - UNIT 2 (STEEL ALTERNATE)	
Designed by J.S.J.	Drawn by R.D.F
Checked by B.J.B. date 10-4-84	Bridge Design Supervisor C.J.M./S.M. date 10-31-84
PROJECT ROUSES POINT BRIDGE REPLACEMENT	PROJECT NO. BRF028-1 (11)
Bridge Sheet No. SS78	Sheet of

