



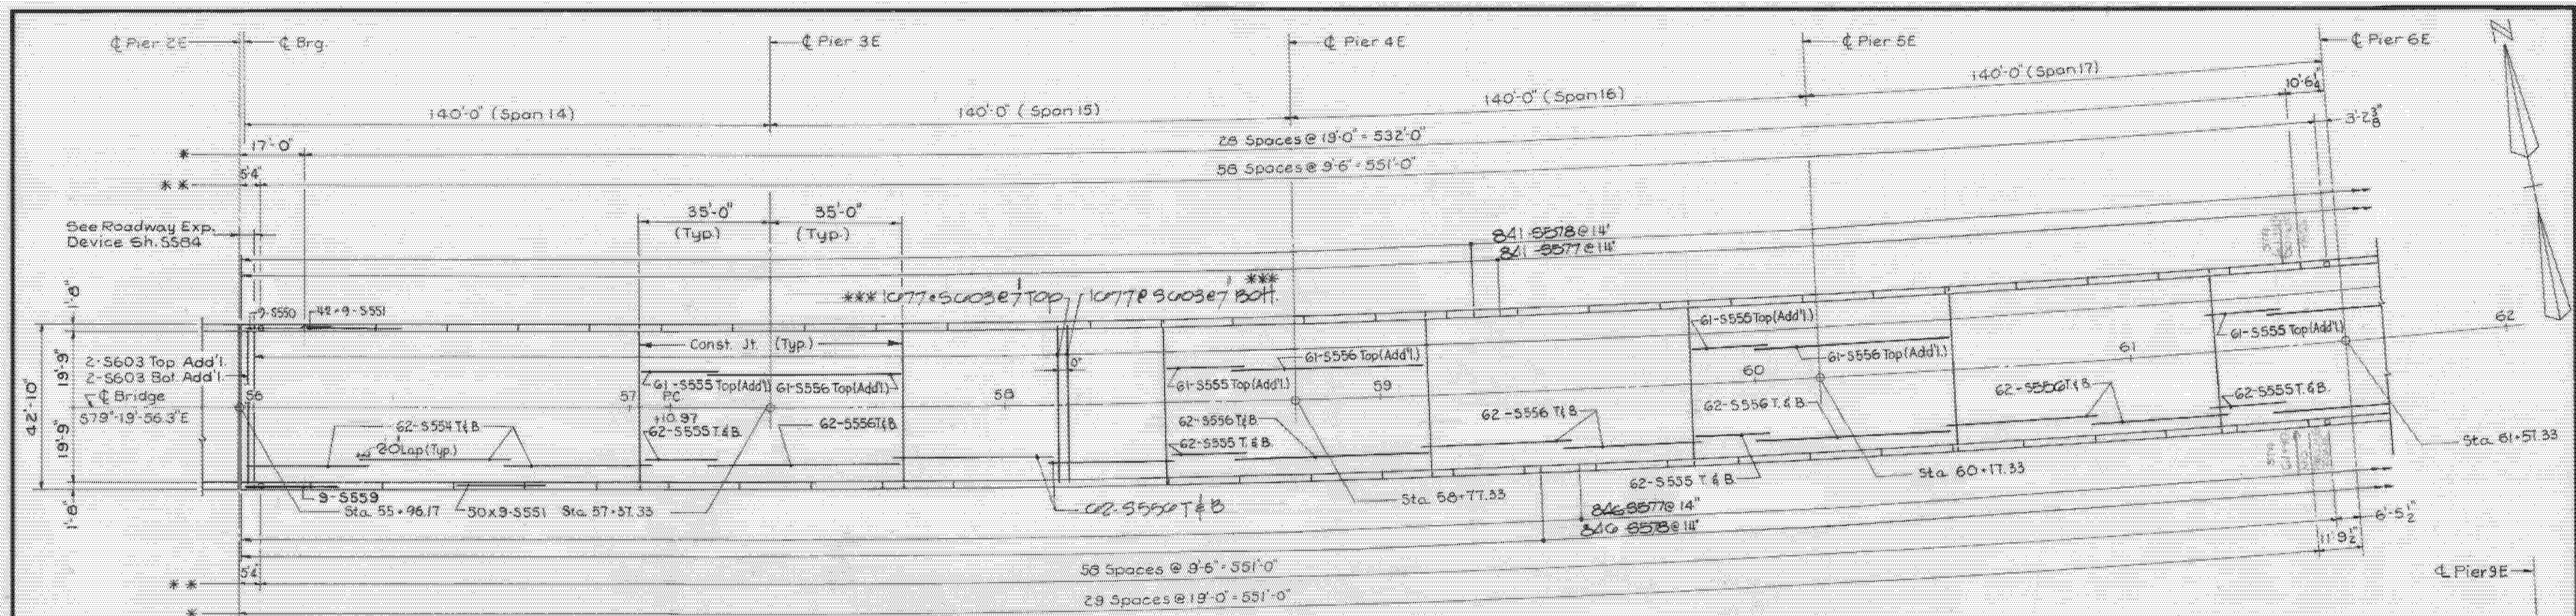


DECK PLAN - SPANS 14 THRU 17
UNIT 4
1"=20'

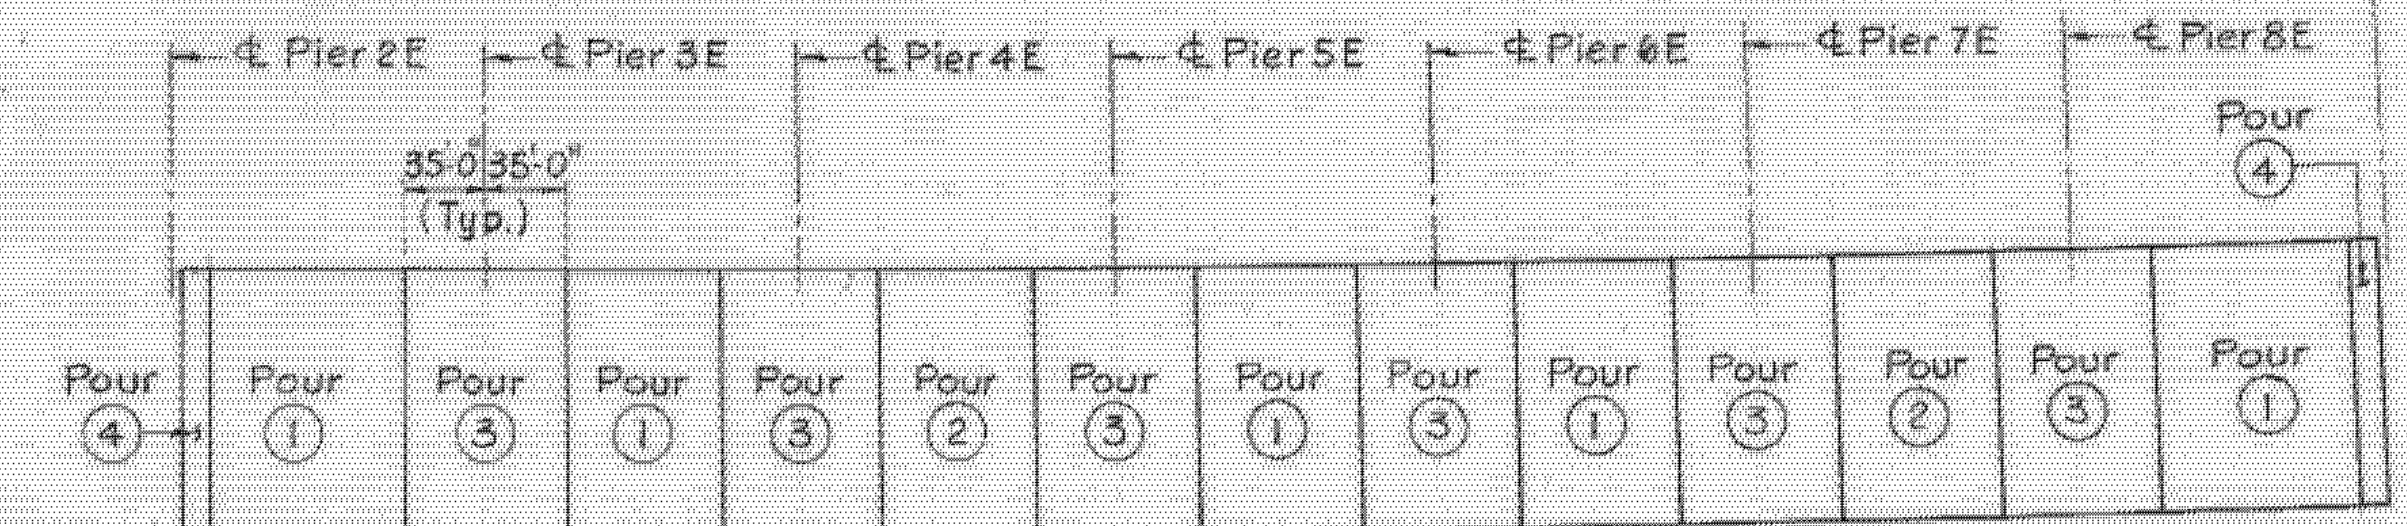

DECK SLAB PLACEMENT SEQUENCE
No Scale

- NOTES:
- * Curb Joint Spacing, Along ϕ of Rail Posts
 - ** Bridge Rail Post Spacing, @ to ϕ Posts
 - *** Transverse Bars Placed Radially
 - For Deck Slab Placements Notes See Sheet S577.

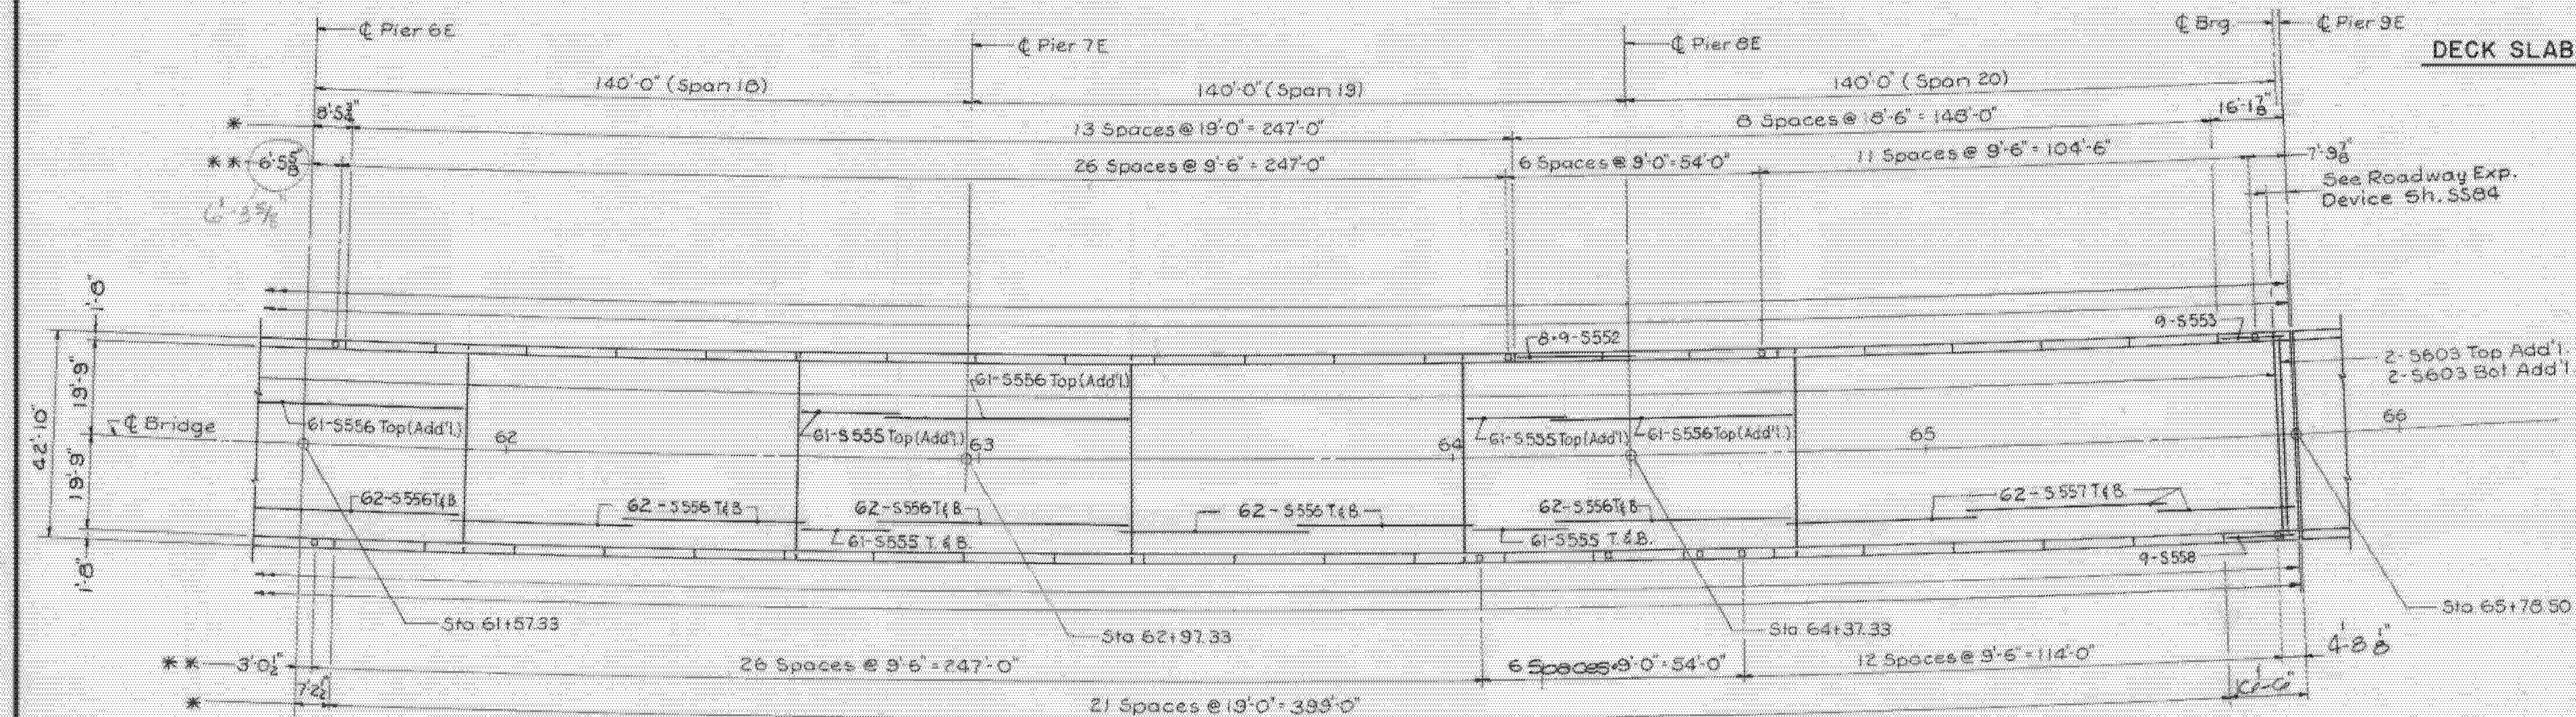

DECK PLAN - SPANS 18 THRU 20
UNIT 4
1"=20'

ALBURGH-ROUSES POINT
BHF MEMB(24)
SHEET 42 OF 50
FOR REFERENCE ONLY

**STATE OF VERMONT
AGENCY OF TRANSPORTATION**

TOWN OF ROUSES POINT NY - ALBURGH VT. Bridge No. 1
HIGHWAY NO. ROUTE 2 Log Sta. 0+00
Surv. Sta.

DECK PLAN - UNIT 4
(STEEL ALTERNATE)
Designed by J.S.J. Drawn by R.D.F.
Checked by B.J.B. Bridge Design Supervisor
date 10-4-84 C.J.M./S.M. date 10-31-84
PROJECT NO. BRF028-1 (II)
Bridge Sheet No. S580 Sheet of

HNTB
HOWARD NEEDLES TAMMEN & BERGENDOFF