


DECK PLAN-SPANS 21 THRU 24  
UNIT 5  
1" = 20'

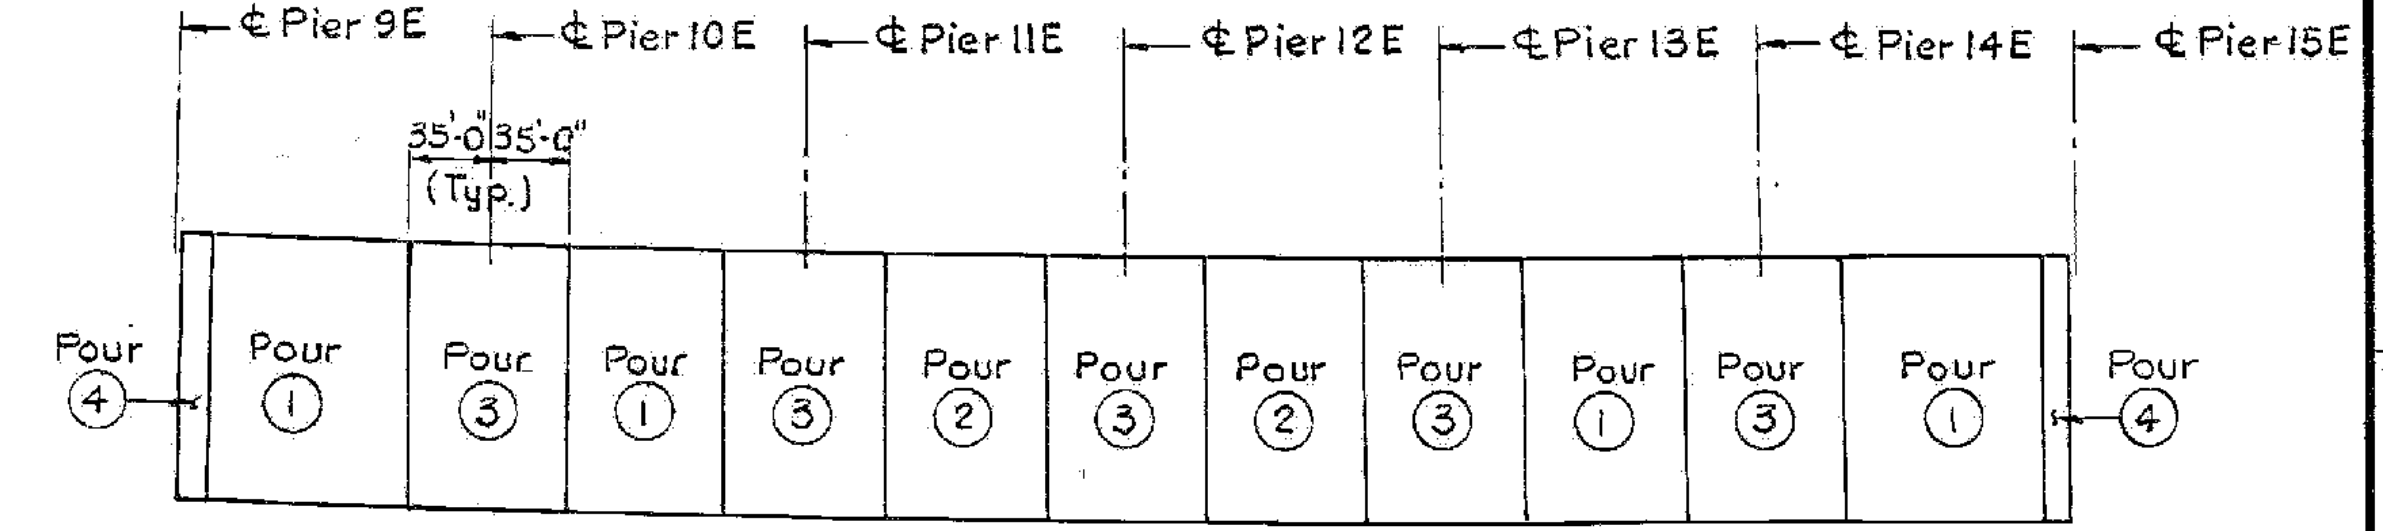


DECK SLAB PLACEMENT SEQUENCE

No Scale

NOTES

- \* Curb Joint Spacing, Along  $\phi$  of Rail Posts.
- \*\* Bridge Rail Post Spacing  $\phi$  to  $\phi$  Posts
- \*\*\* Transverse Bars Placed Radially
- For Deck Slab Placements Notes See Sheet S577.

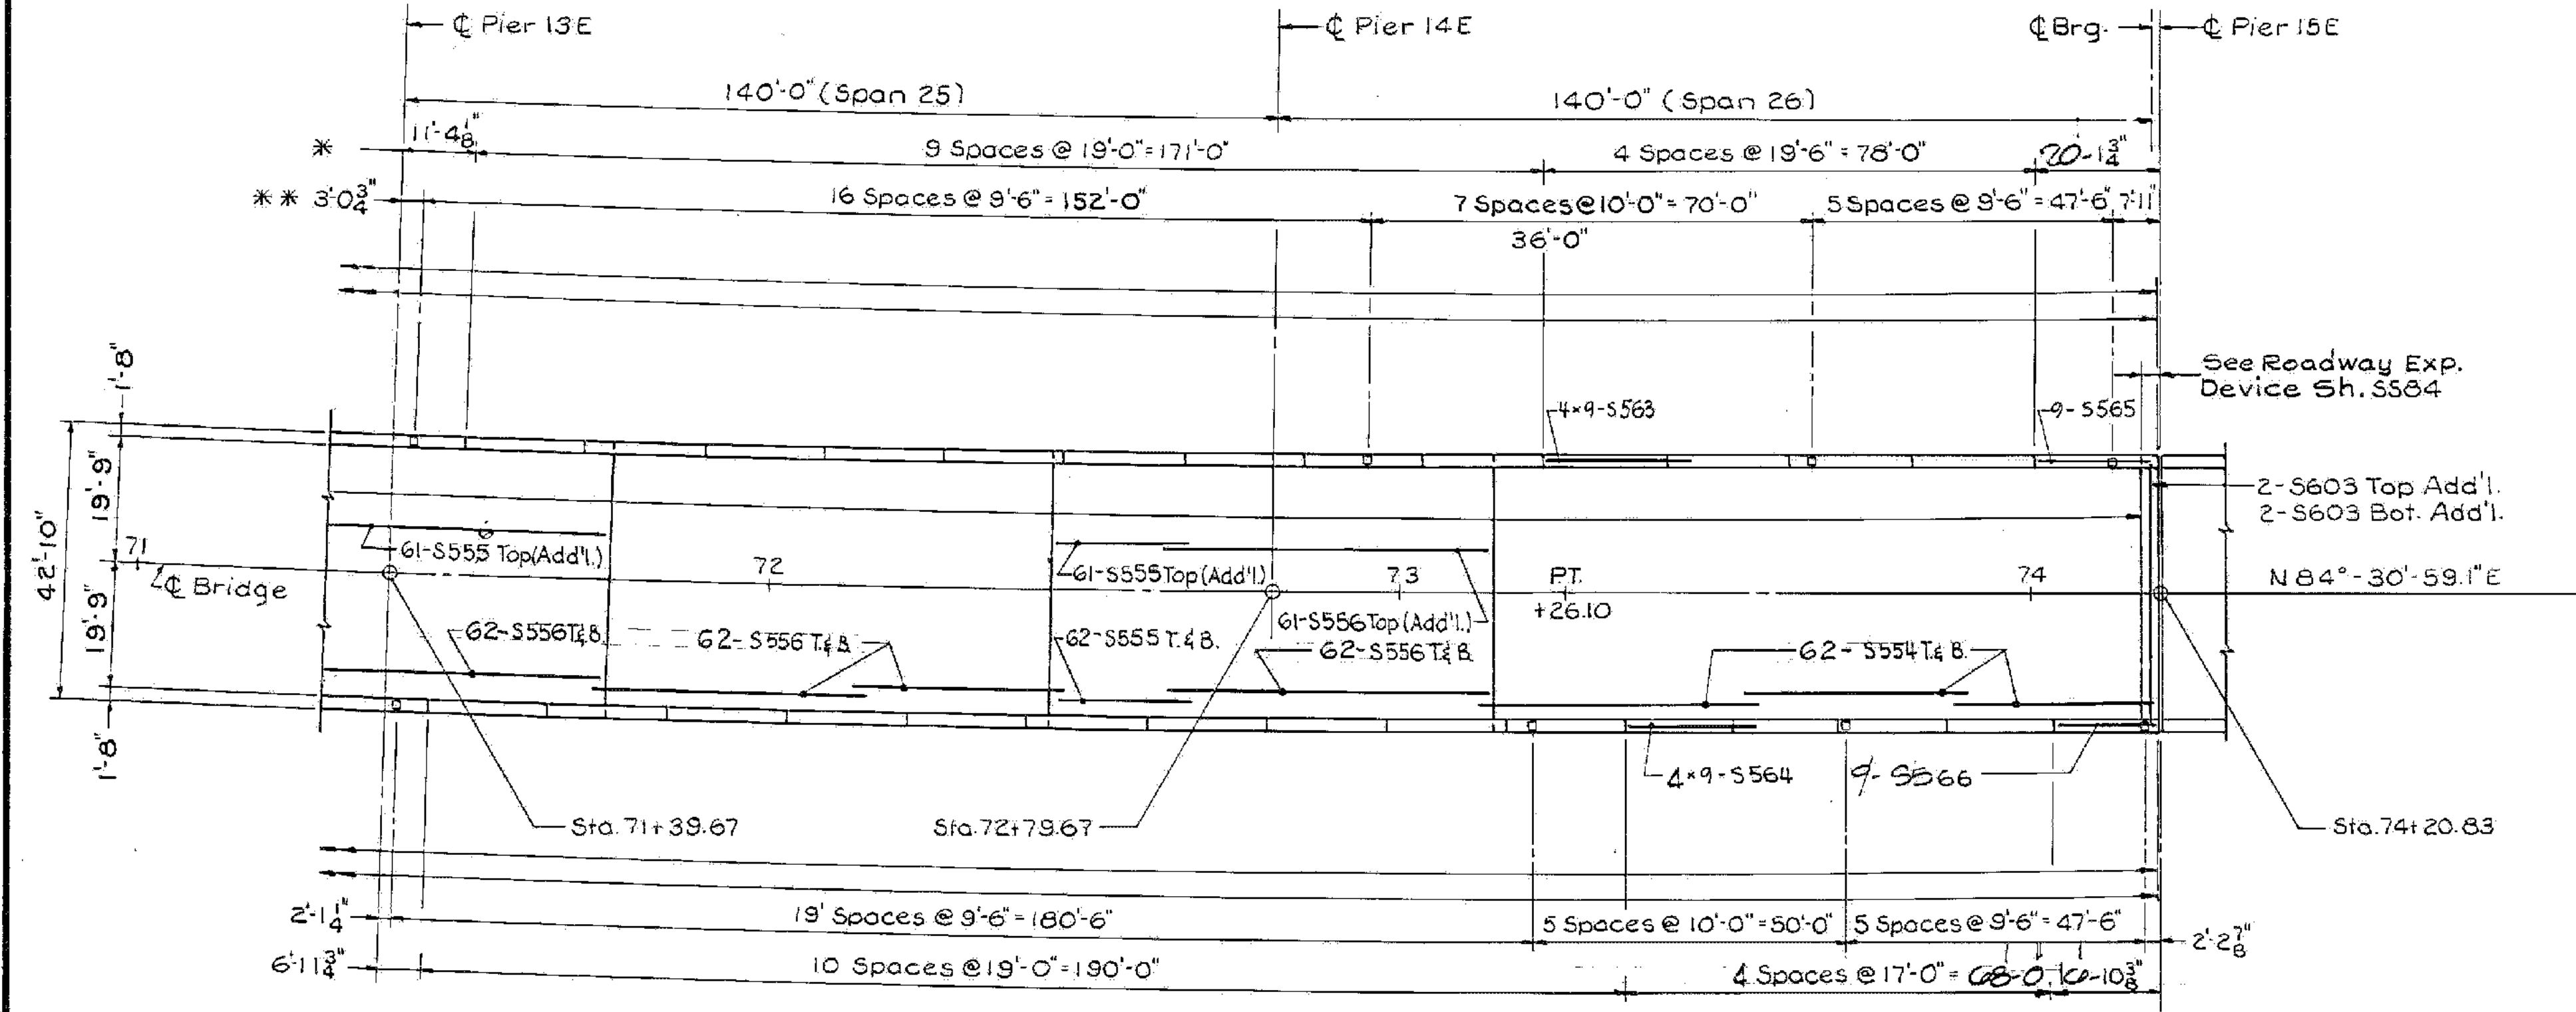

DECK PLAN-SPANS 25 & 26  
UNIT 5  
1" = 20'

ALBURGH-ROUSES POINT  
BHF MEMB(24)  
SHEET 43 OF 50  
FOR REFERENCE ONLY

STATE OF VERMONT  
AGENCY OF TRANSPORTATION

TOWN OF ROUSES POINT N.Y. - ALBURG VT.	Bridge No. 1
HIGHWAY NO. ROUTE 2	Log Sta. 0+00
	Surv. Sta.

DECK PLAN - UNIT 5  
(STEEL ALTERNATE)

Designed by J.S.J.	Drawn by R.D.F.
Checked by B.J.B.	Bridge Design Supervisor
date 10-4-84	C.J.M./S.M. date 10-31-84

PROJECT ROUSES POINT BRIDGE REPLACEMENT	PROJECT NO. BRF 028-1(11)
Bridge Sheet No. S581	Sheet of

