




BULB OUT DETAILS

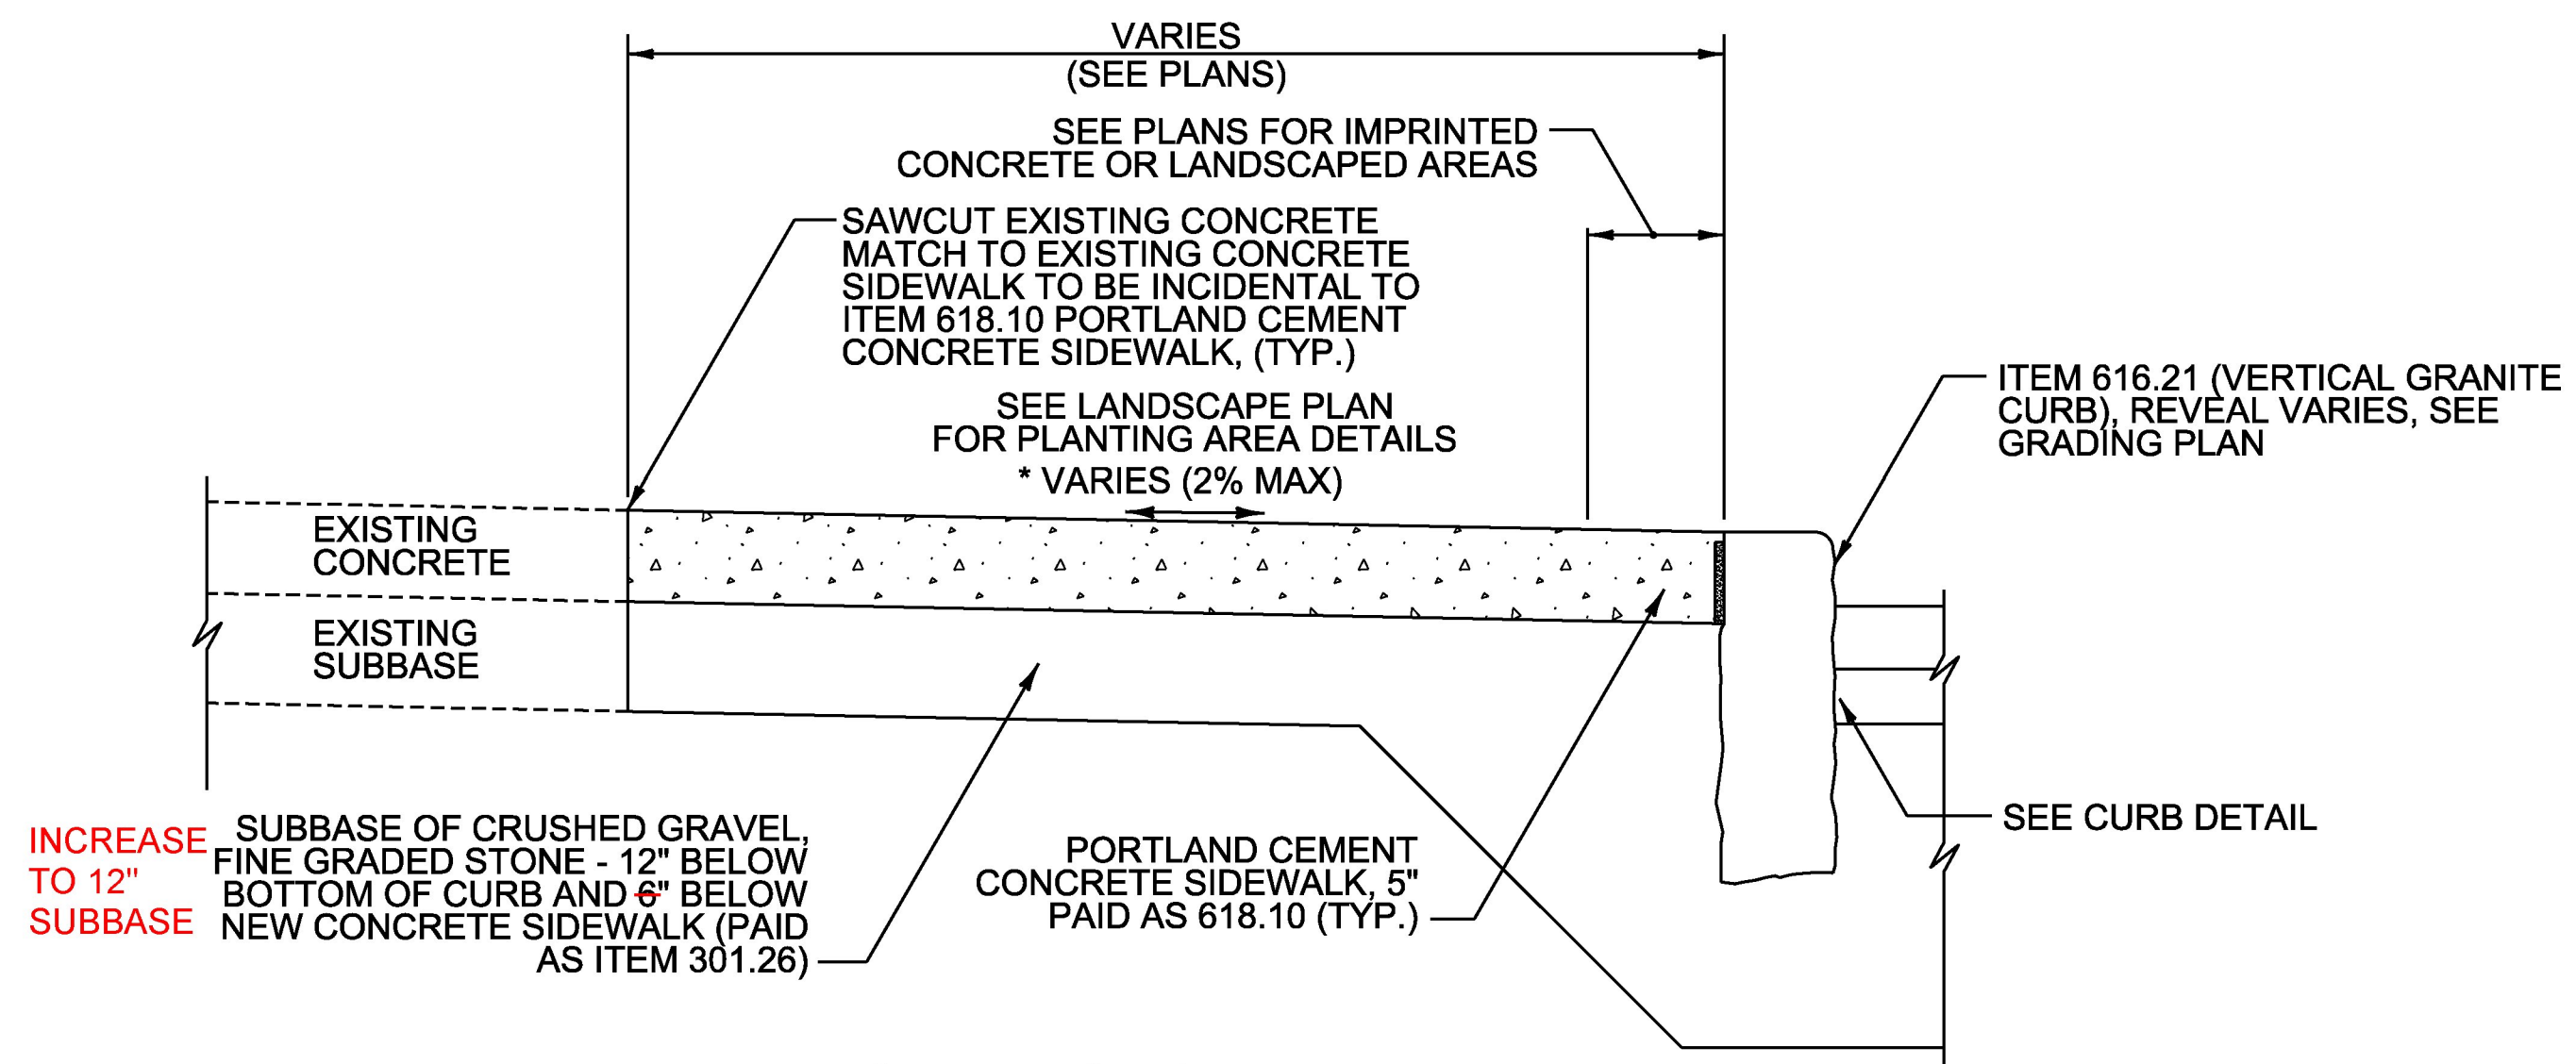


NORTHWEST QUADRANT
NOT TO SCALE
* NOT TO EXCEED 2%, SEE GRADING PLAN

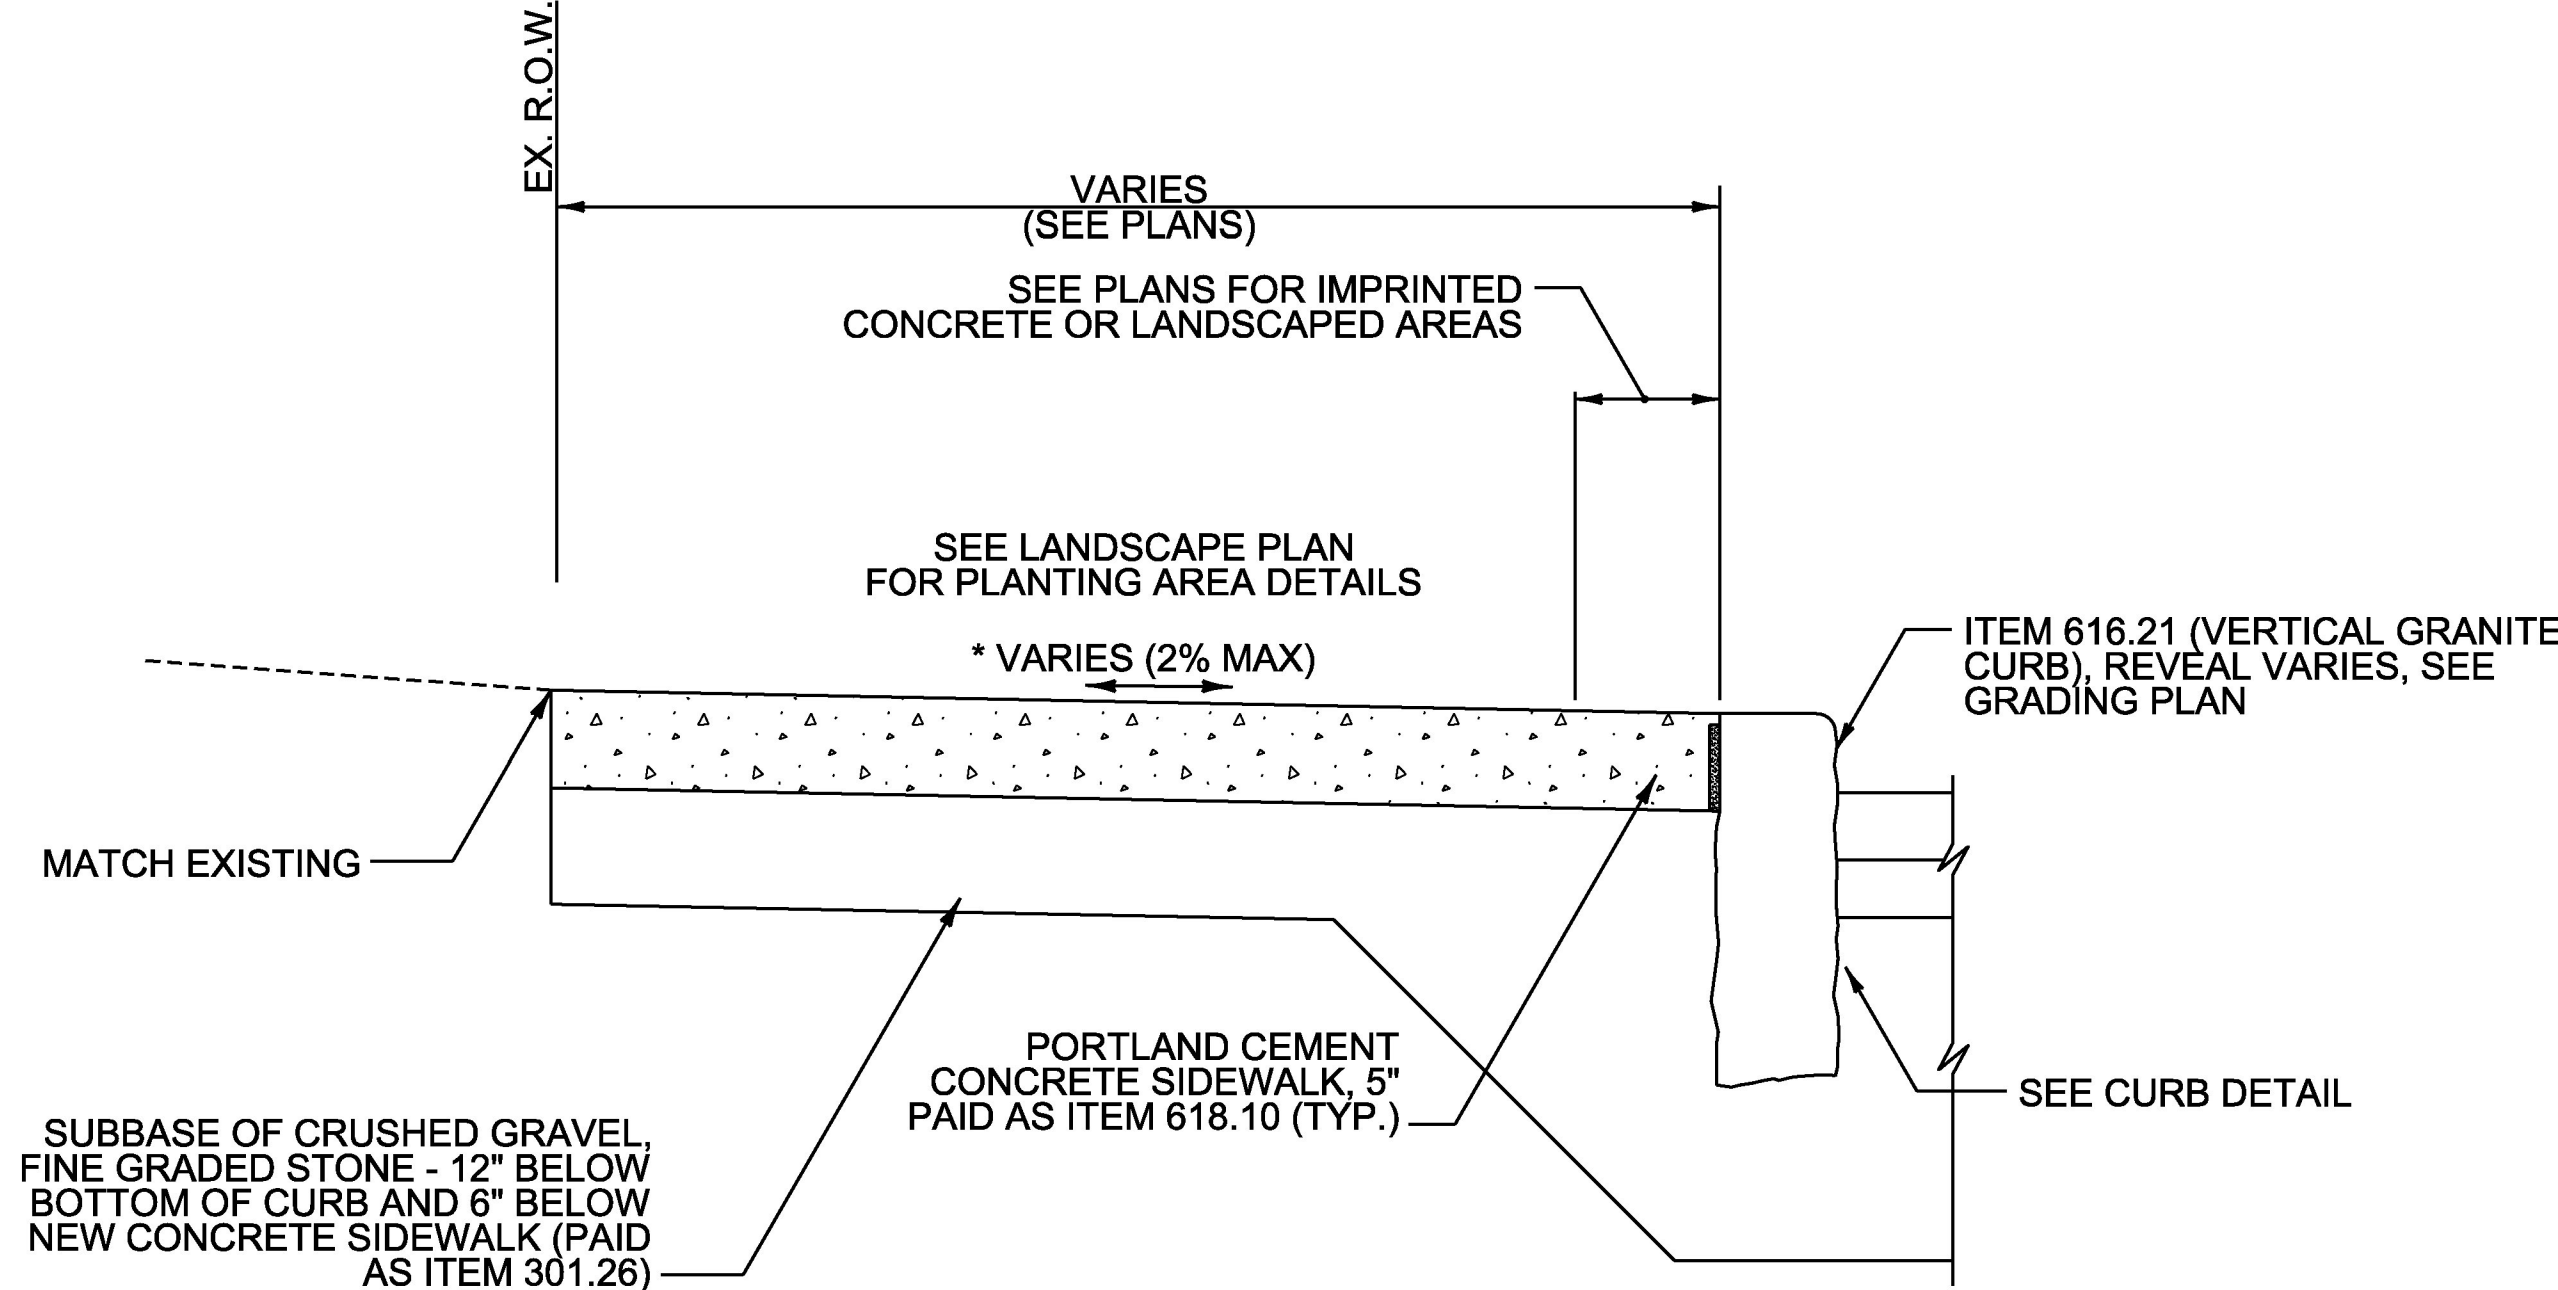

NORTHEAST QUADRANT
NOT TO SCALE
* NOT TO EXCEED 2%, SEE GRADING PLAN

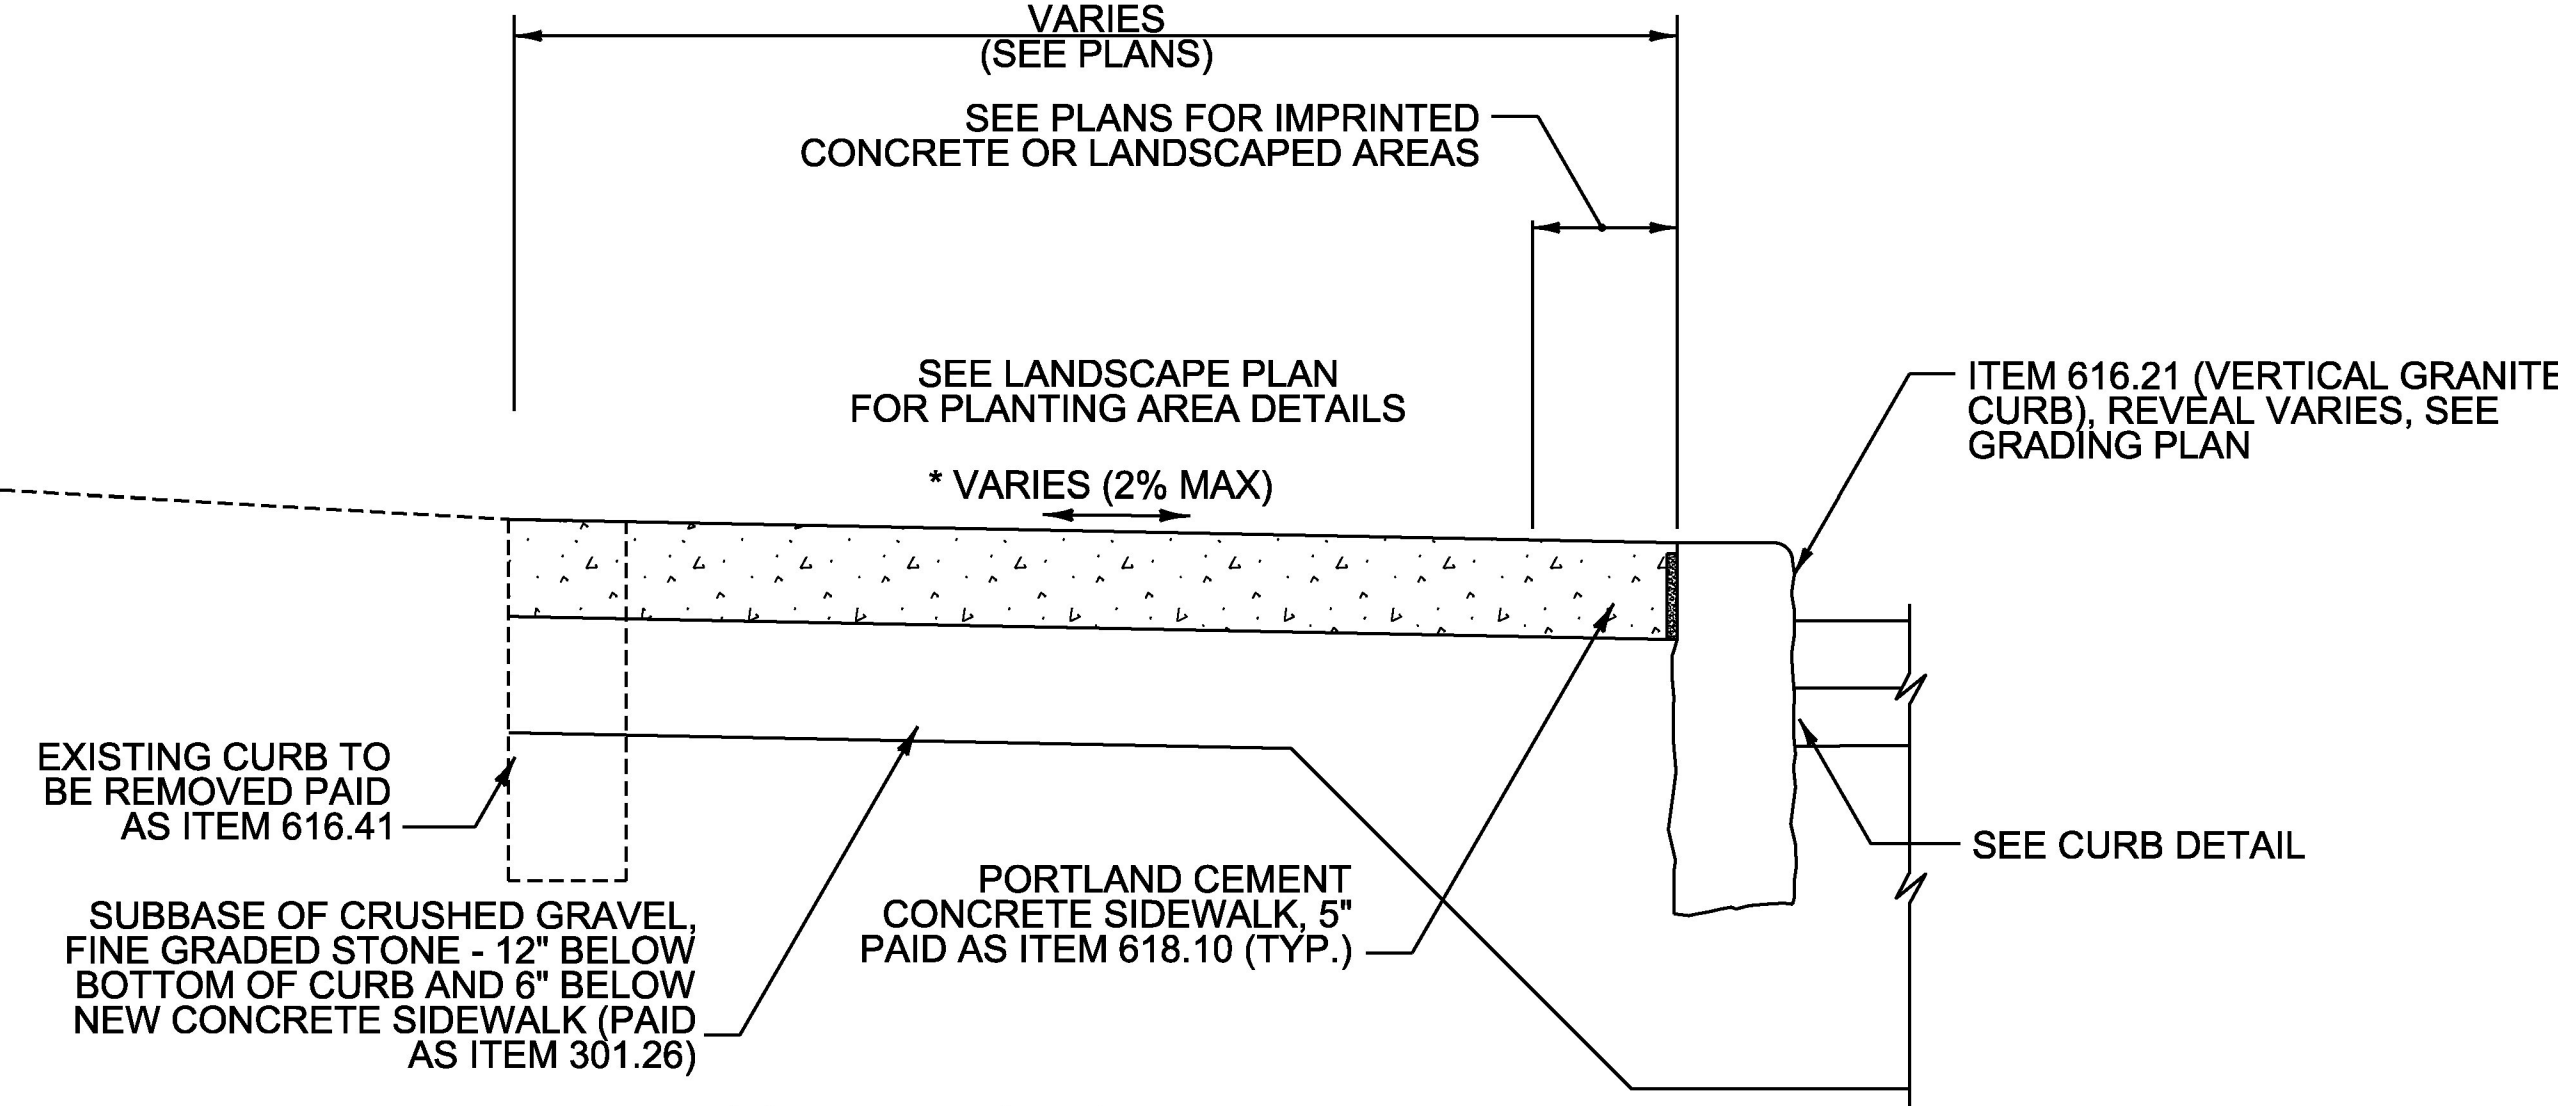

SOUTHWEST QUADRANT
NOT TO SCALE
* NOT TO EXCEED 2%, SEE GRADING PLAN

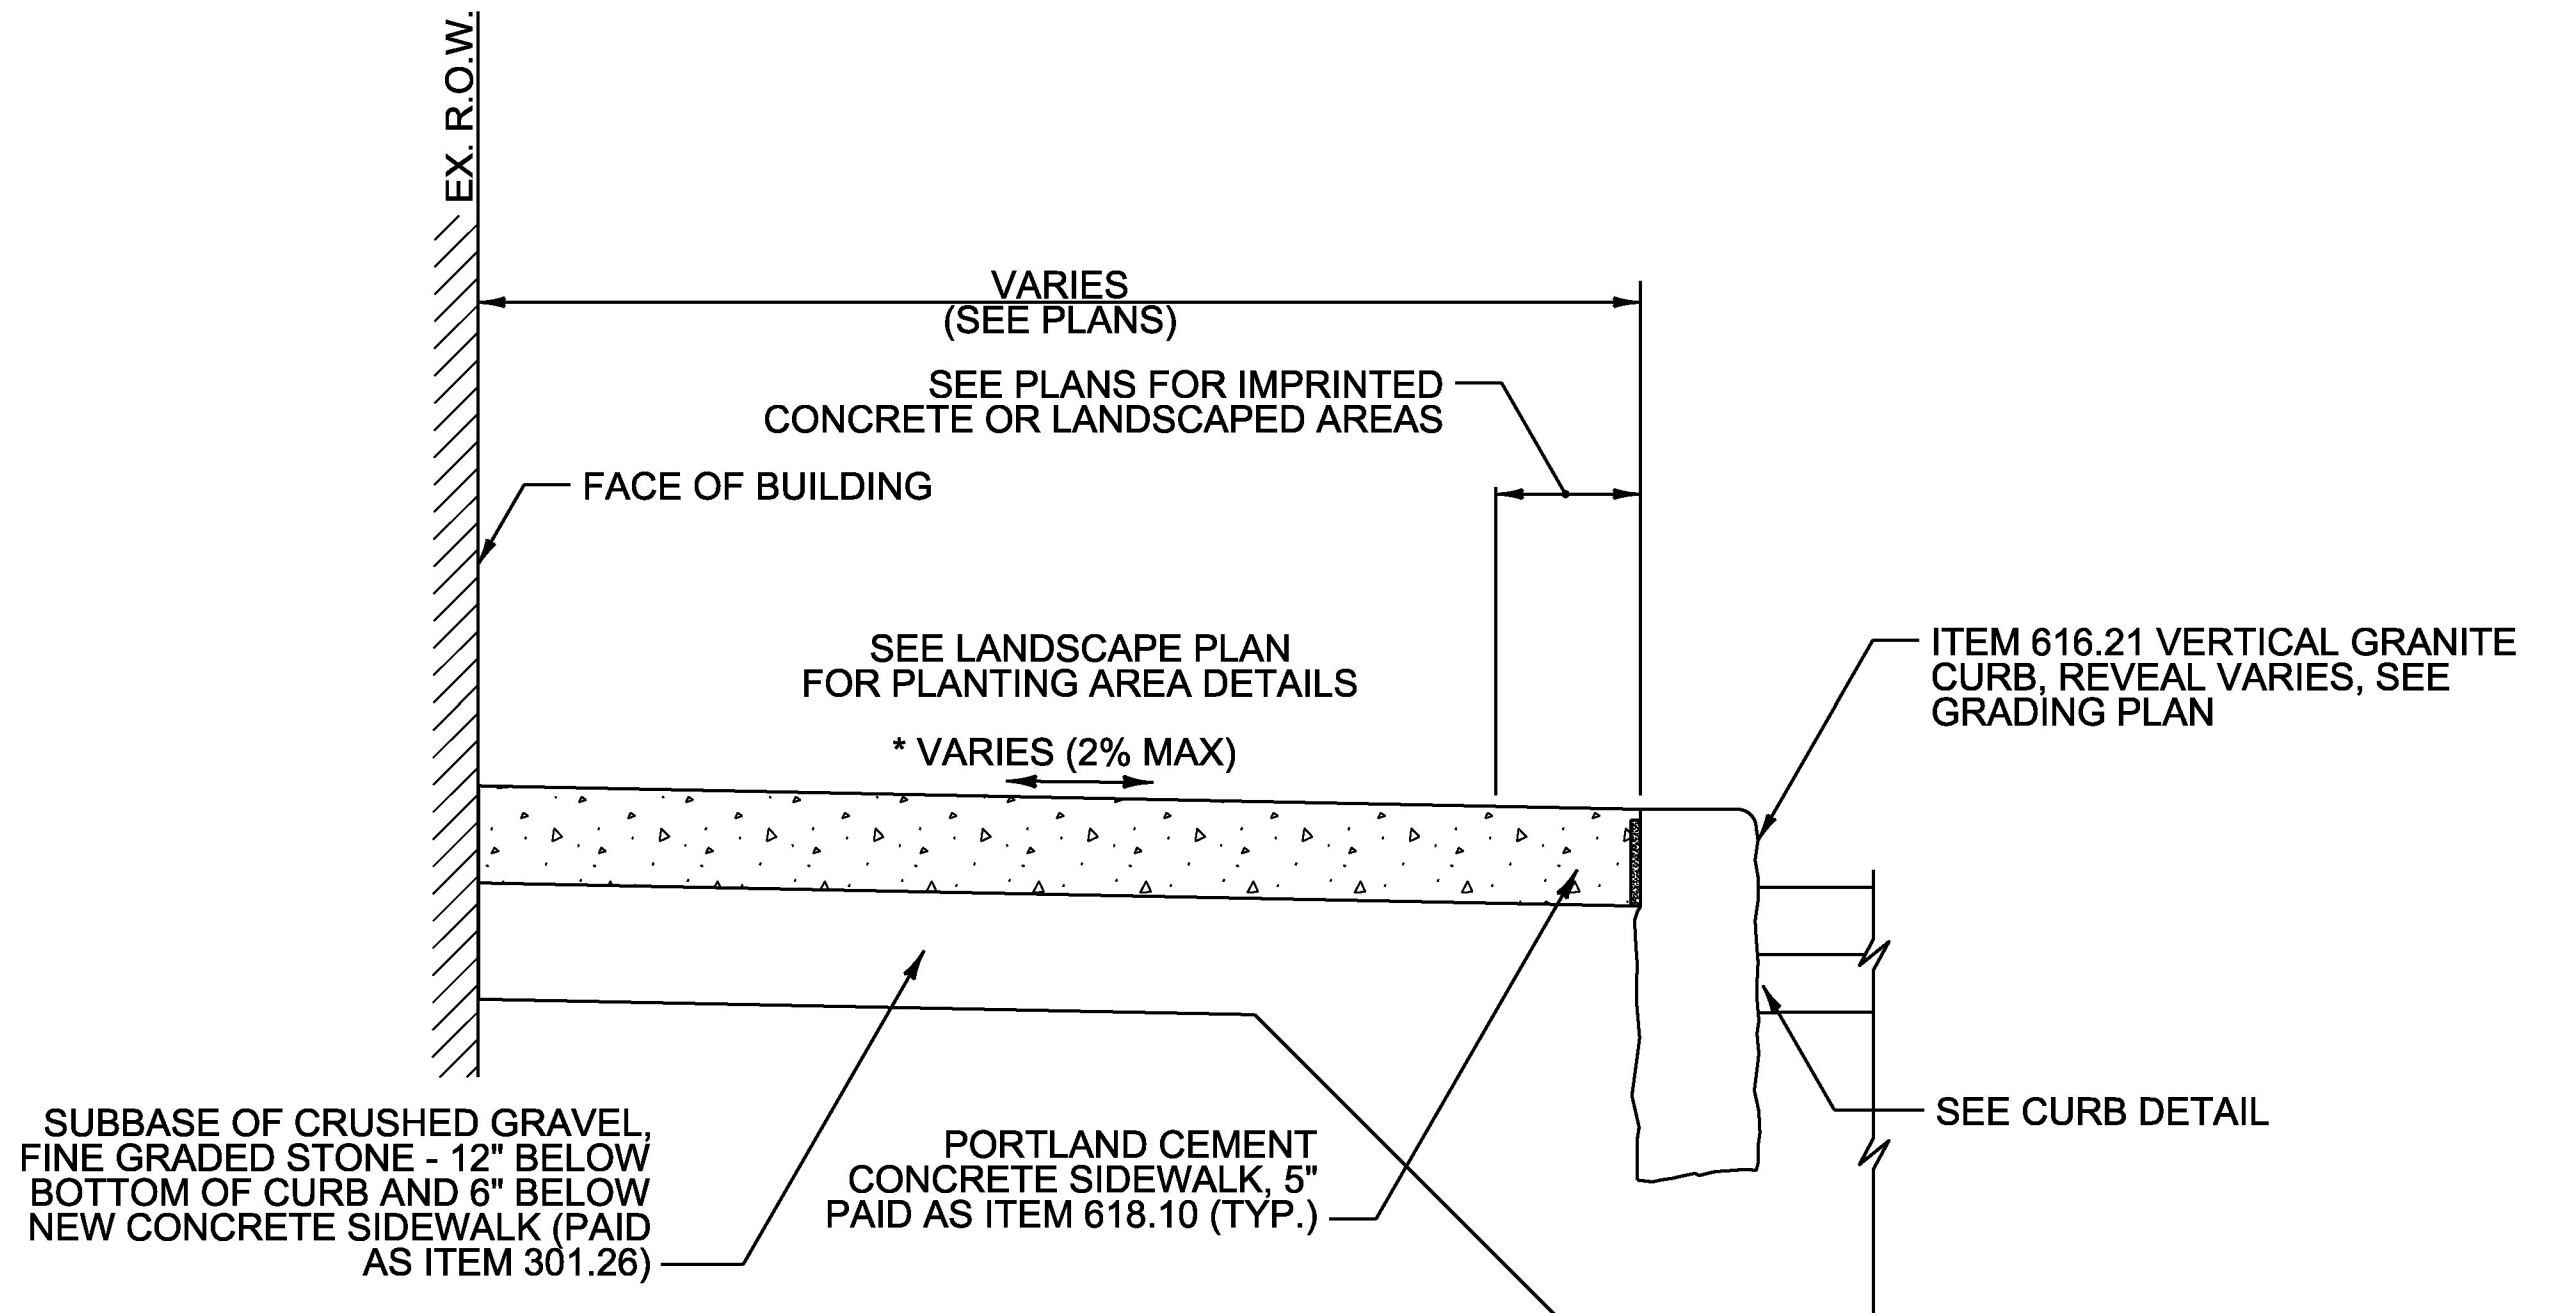

SOUTHEAST QUADRANT
NOT TO SCALE
* NOT TO EXCEED 2%, SEE GRADING PLAN

PROJECT NAME: BRISTOL	
PROJECT NUMBER: HES 021-1 (28)	
FILE NAME: z10b078frm.dgn	PLOT DATE: 4/29/2014
PROJECT LEADER: T. LUTHER	DRAWN BY: P. ARMATA
DESIGNED BY: T. LUTHER	CHECKED BY: G. EDWARDS
DETAIL SHEET 2	SHEET 5 OF 29

